


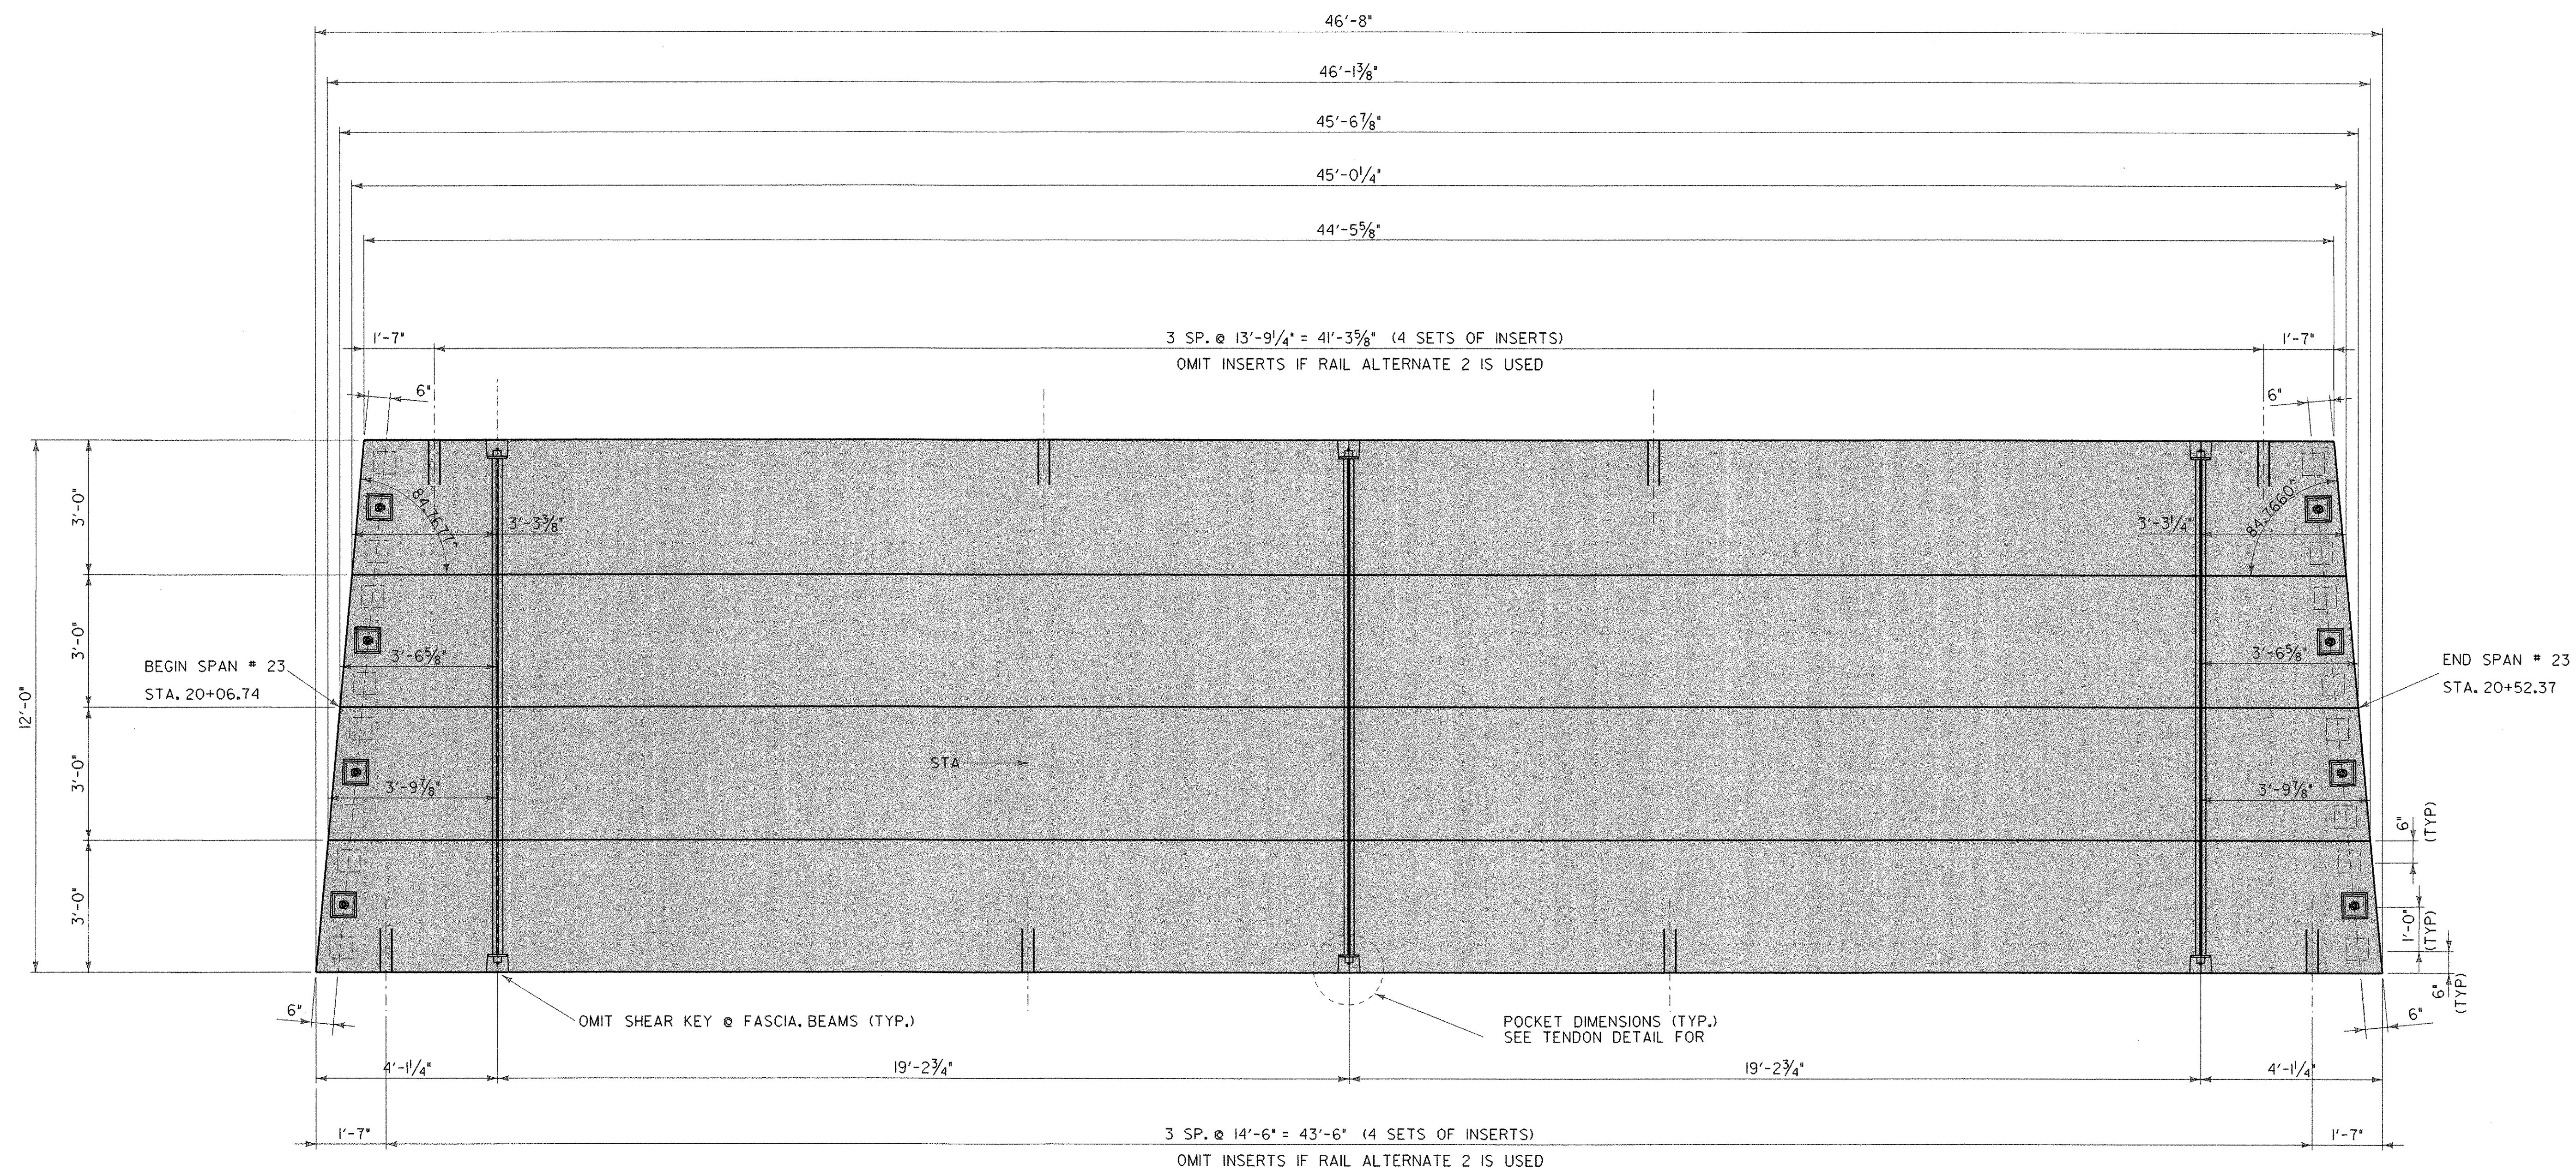

PRESTRESSED SLAB LAYOUT SPAN 23

SCALE 1/2" = 1'-0"

THE TOPS OF THE PRESTRESSED SLABS SHALL BE SCREEDED AND GIVEN A BROOMED OR WIRE BROOM FINISH.
THE GROOVES SHALL BE IN THE TRANSVERSE DIRECTION AND PENETRATE THE SURFACE APPROXIMATELY 1/4"

SLAB DETAILS SPANS 23

PROJECT NAME:	COLCHESTER
PROJECT NUMBER:	STP Bike(48)
FILE NAME:	str5/03f038/sf038pst+det.dgn
PROJECT LEADER:	C. KELLER
DESIGNED BY:	J. GEORGE
CHECKED BY:	M.E.M.
	SHEET 51 OF 87