


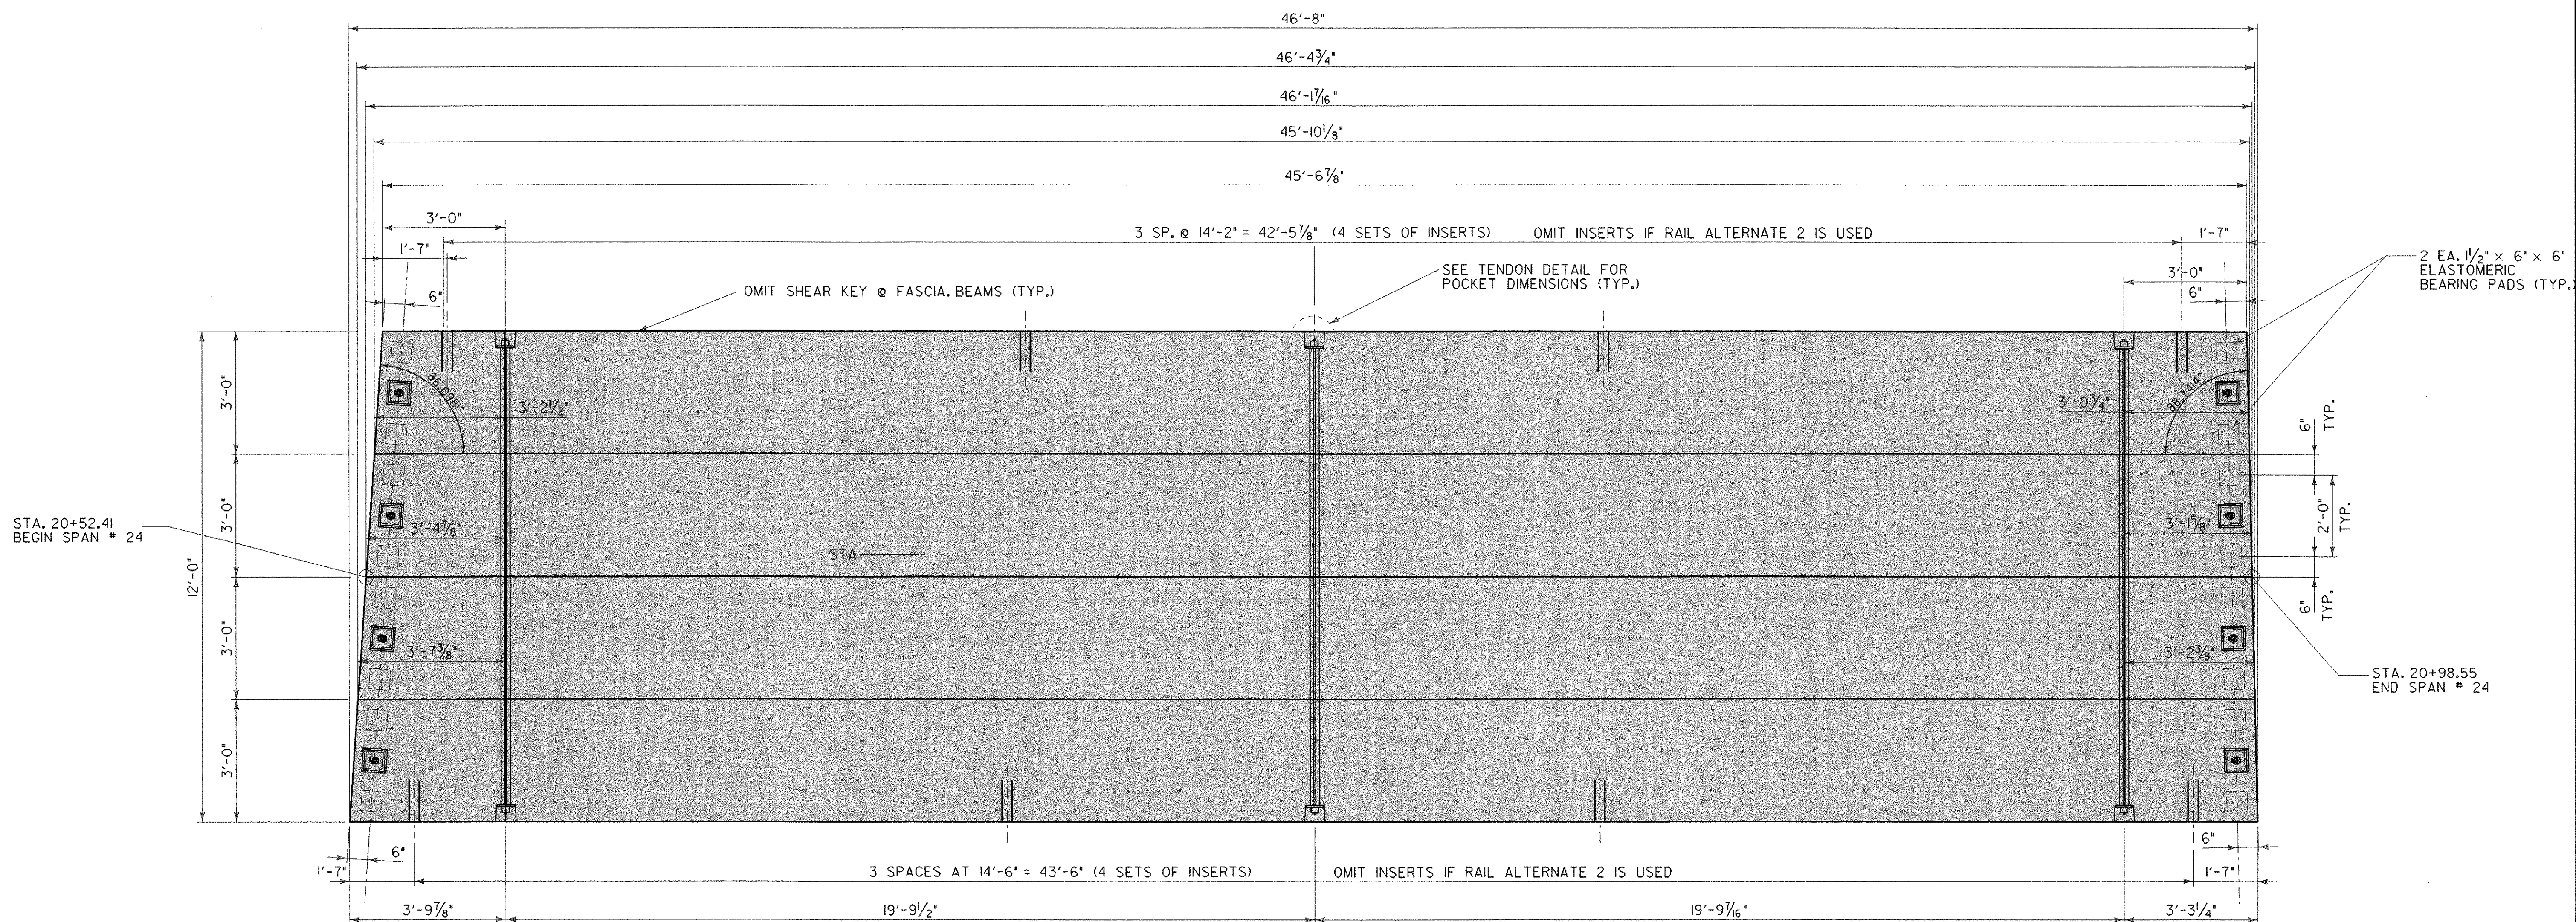

PRESTRESSED SLAB LAYOUT SPAN 24

SCALE 1/2" = 1'-0"

SLAB DETAILS SPAN 24

THE TOPS OF THE PRESTRESSED SLABS SHALL BE SCREEDED AND GIVEN A BROOMED OR WIRE BROOM FINISH.
THE GROOVES SHALL BE IN THE TRANSVERSE DIRECTION AND PENETRATE THE SURFACE APPROXIMATELY 1/4"

PROJECT NAME:	COLCHESTER
PROJECT NUMBER:	STP Bike(48)
FILE NAME:	/str5/03f038/sf038pstdet.dgn
PROJECT LEADER:	C. KELLER
DESIGNED BY:	J. GEORGE
CHECKED BY:	M.E.M.
SHEET	52 OF 87