



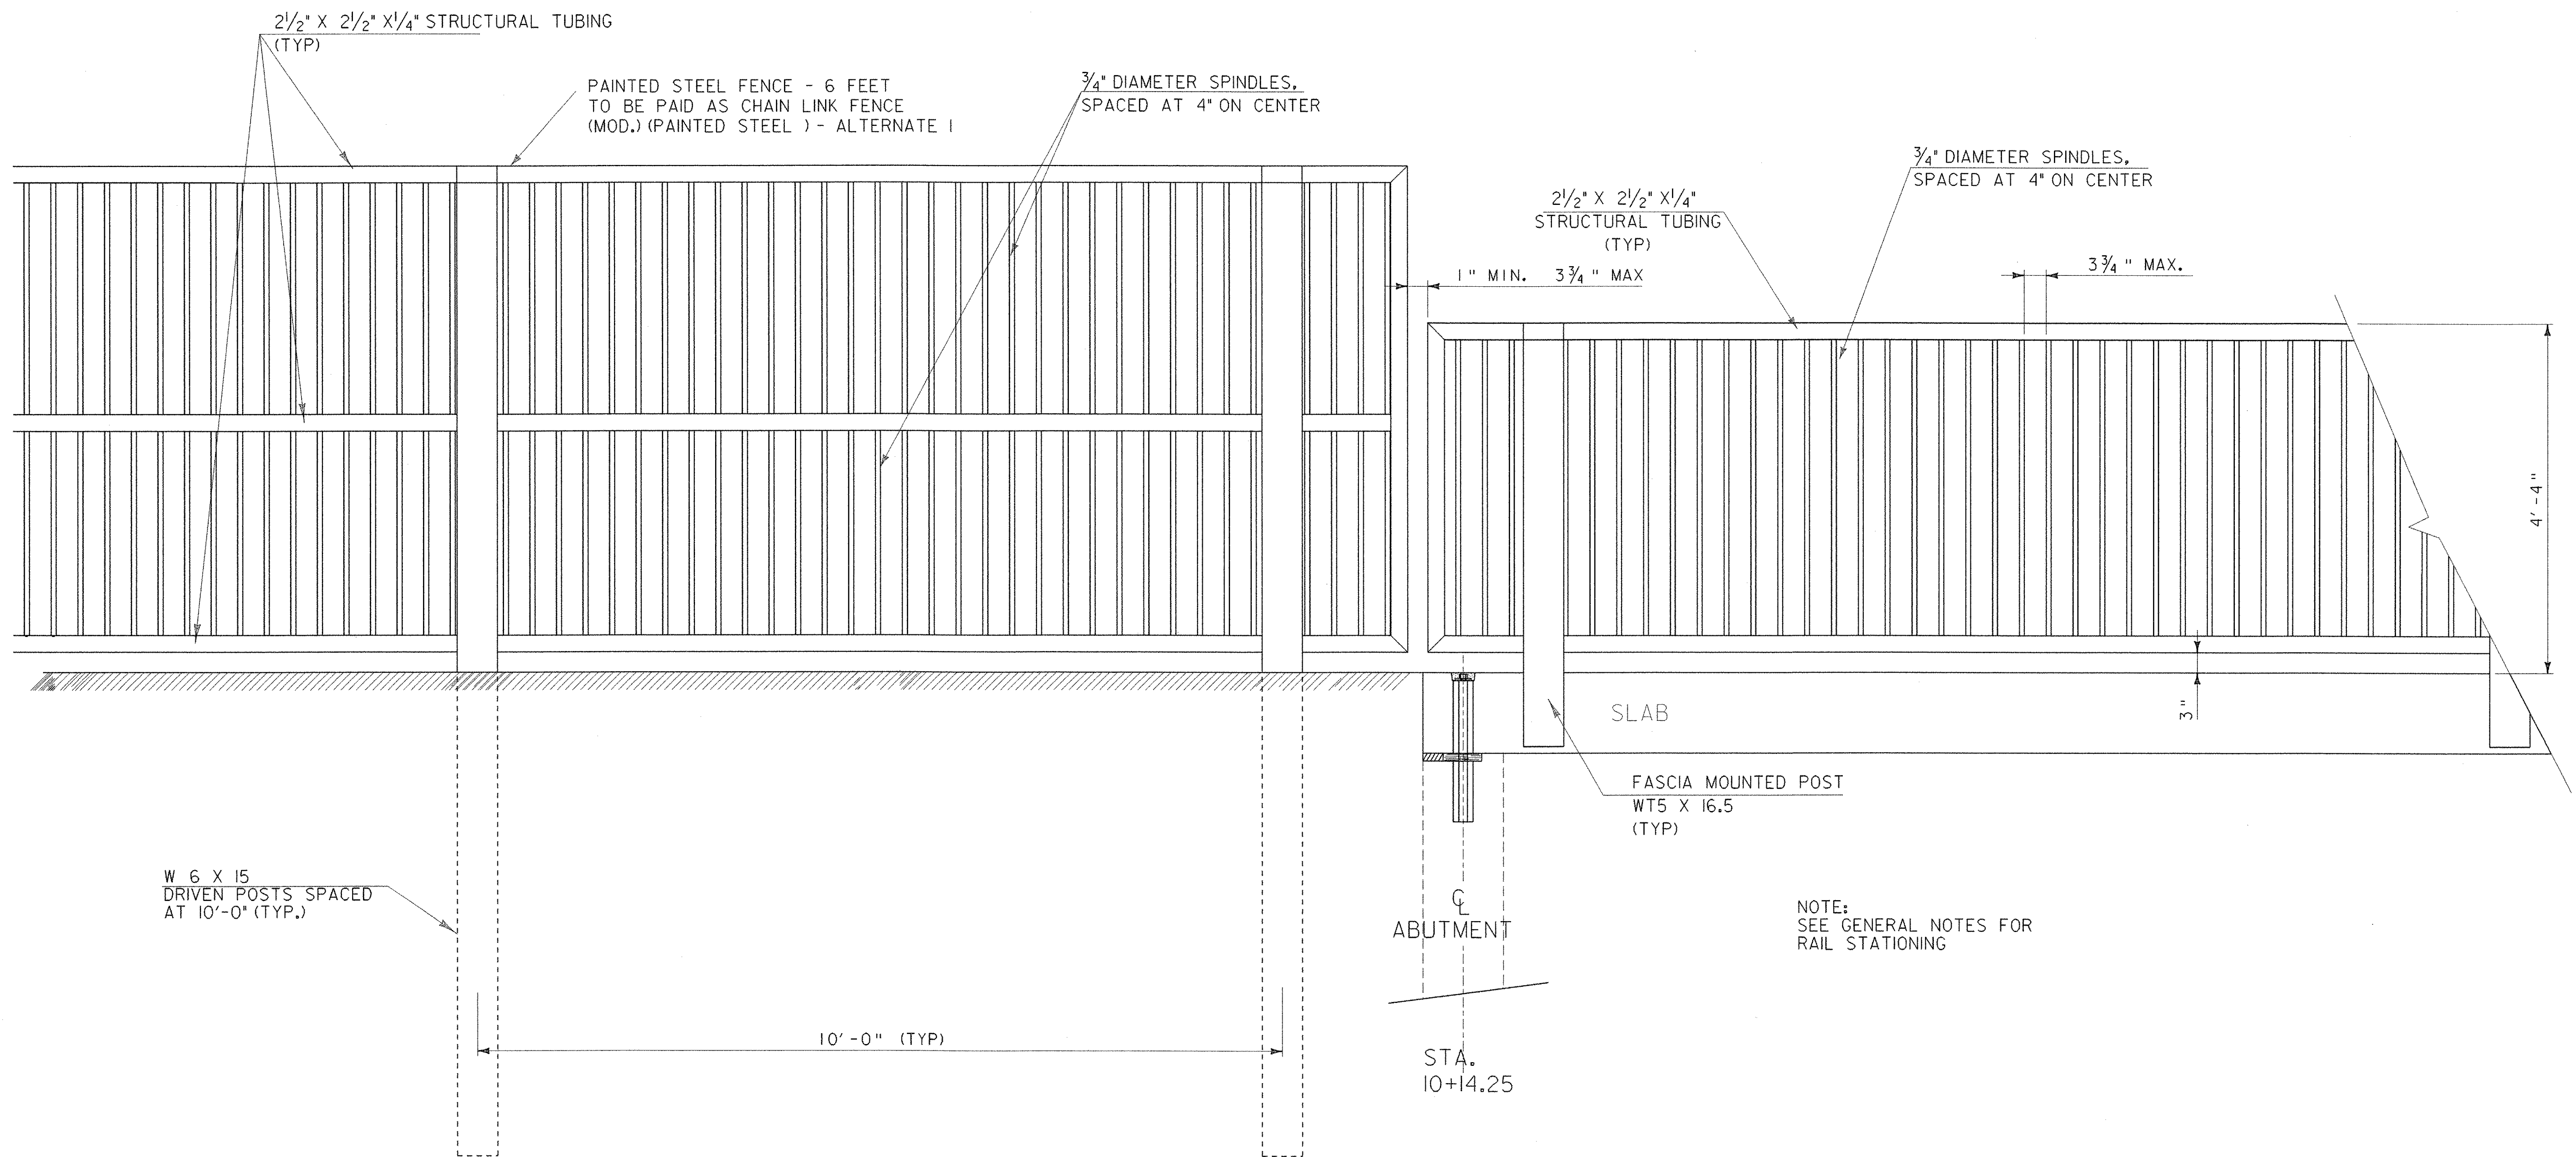

RAIL ELEVATION @ STA 10+14.25

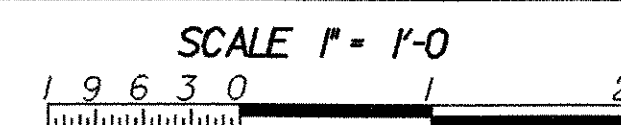

RAIL DETAILS ALTERNATE 1

PROJECT NAME: COLCHESTER	PLOT DATE: 05-AUG-2003
PROJECT NUMBER: STP BIKE(48)	DRAWN BY: J. GEORGE
FILE NAME: /str5/03f038/sf038bdr.dgn	CHECKED BY: M.E.M.
PROJECT LEADER: C. KELLER	SHEET 55 OF 87
DESIGNED BY: J. GEORGE	
sf038rail3.i	