


SIDE ELEVATION


BACK ELEVATION

SECTION  
DRIVEN POST MOUNTED FENCE

SCALE 1 1/2" = 1'-0"

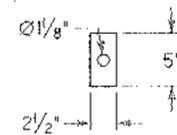

GALV. STEEL PLATE WASHER  
FOR 1/8" x 2"  
SLOTTED HOLE TYP.

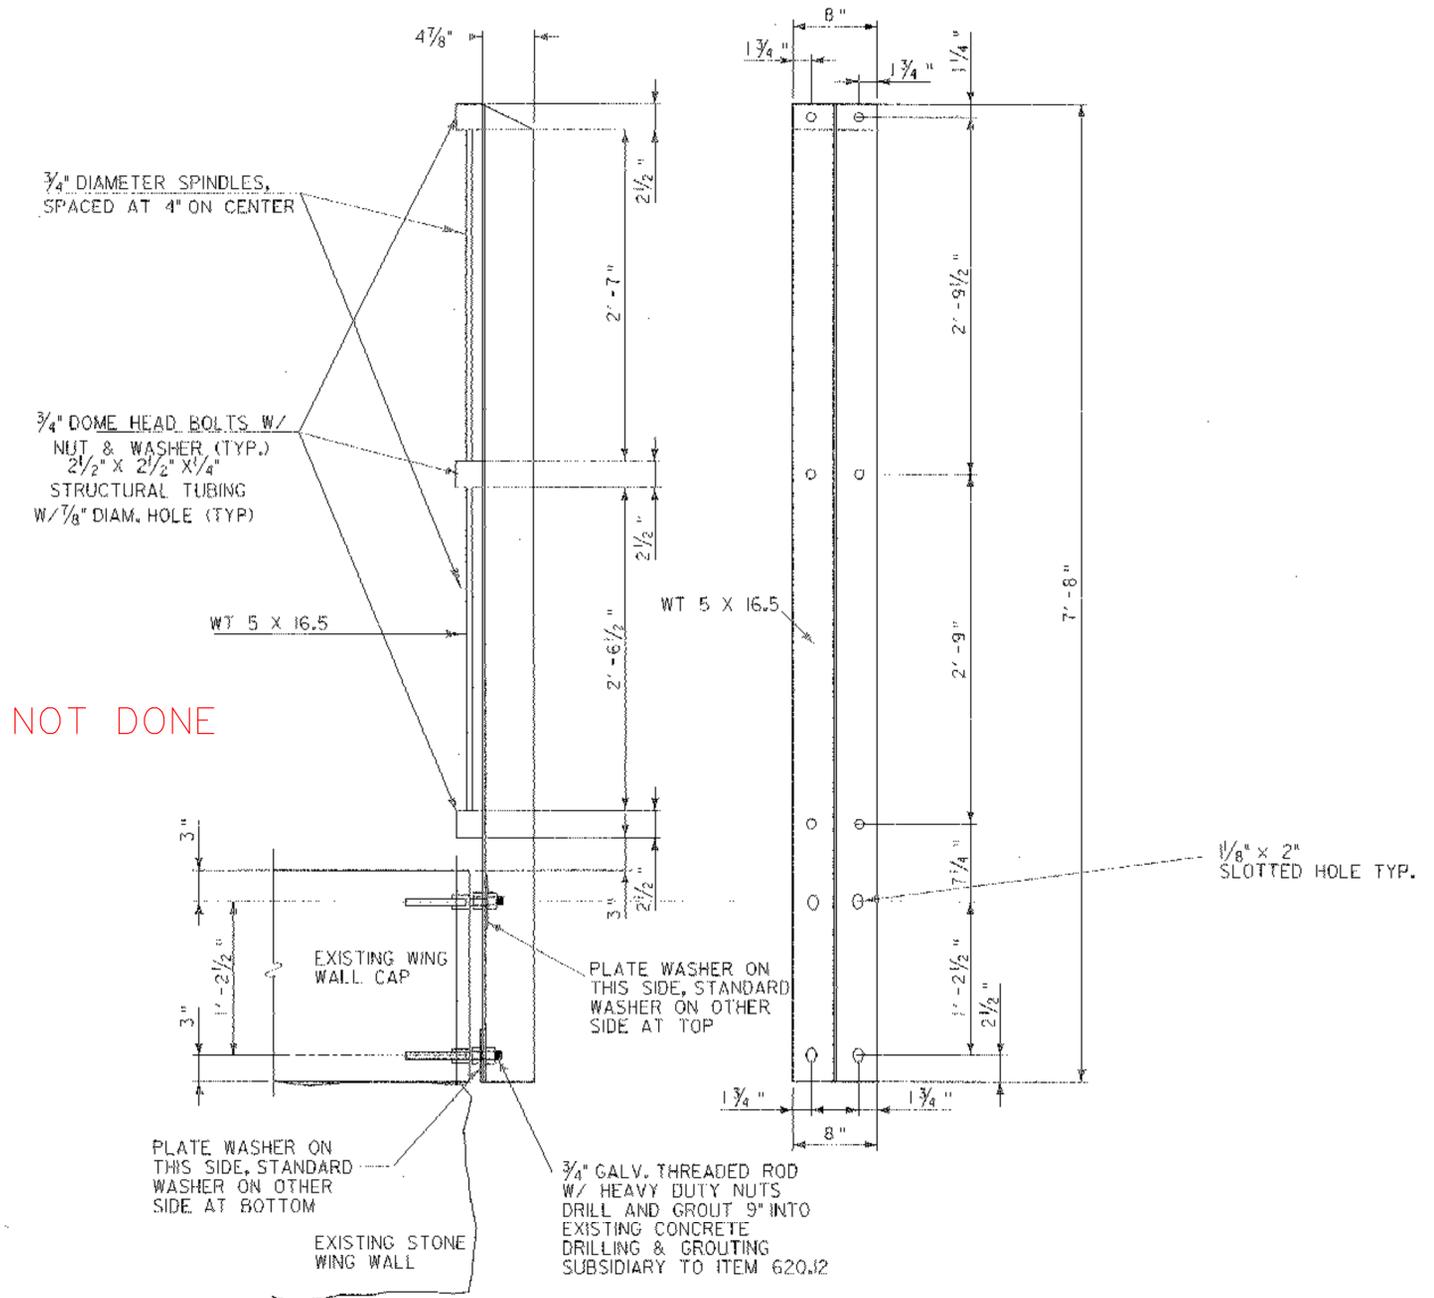

NOT DONE

SECTION  
FASCIA MOUNTED FENCE

SCALE 1 1/2" = 1'-0"

**FENCE DETAILS**  
**ALTERNATE 1**

PROJECT NAME: COLCHESTER	PLOT DATE: 05-AUG-2003
PROJECT NUMBER: STP BIKE(48)	DRAWN BY: J. GEORGE
FILE NAME: /str5/03f038/stf038bdr.dgn	CHECKED BY: M.E.M.
PROJECT LEADER: C. KELLER	SHEET 56 OF 87
DESIGNED BY: J. GEORGE	