


END BRIDGE #3
STA 8+76

1" MIN. 3" MAX

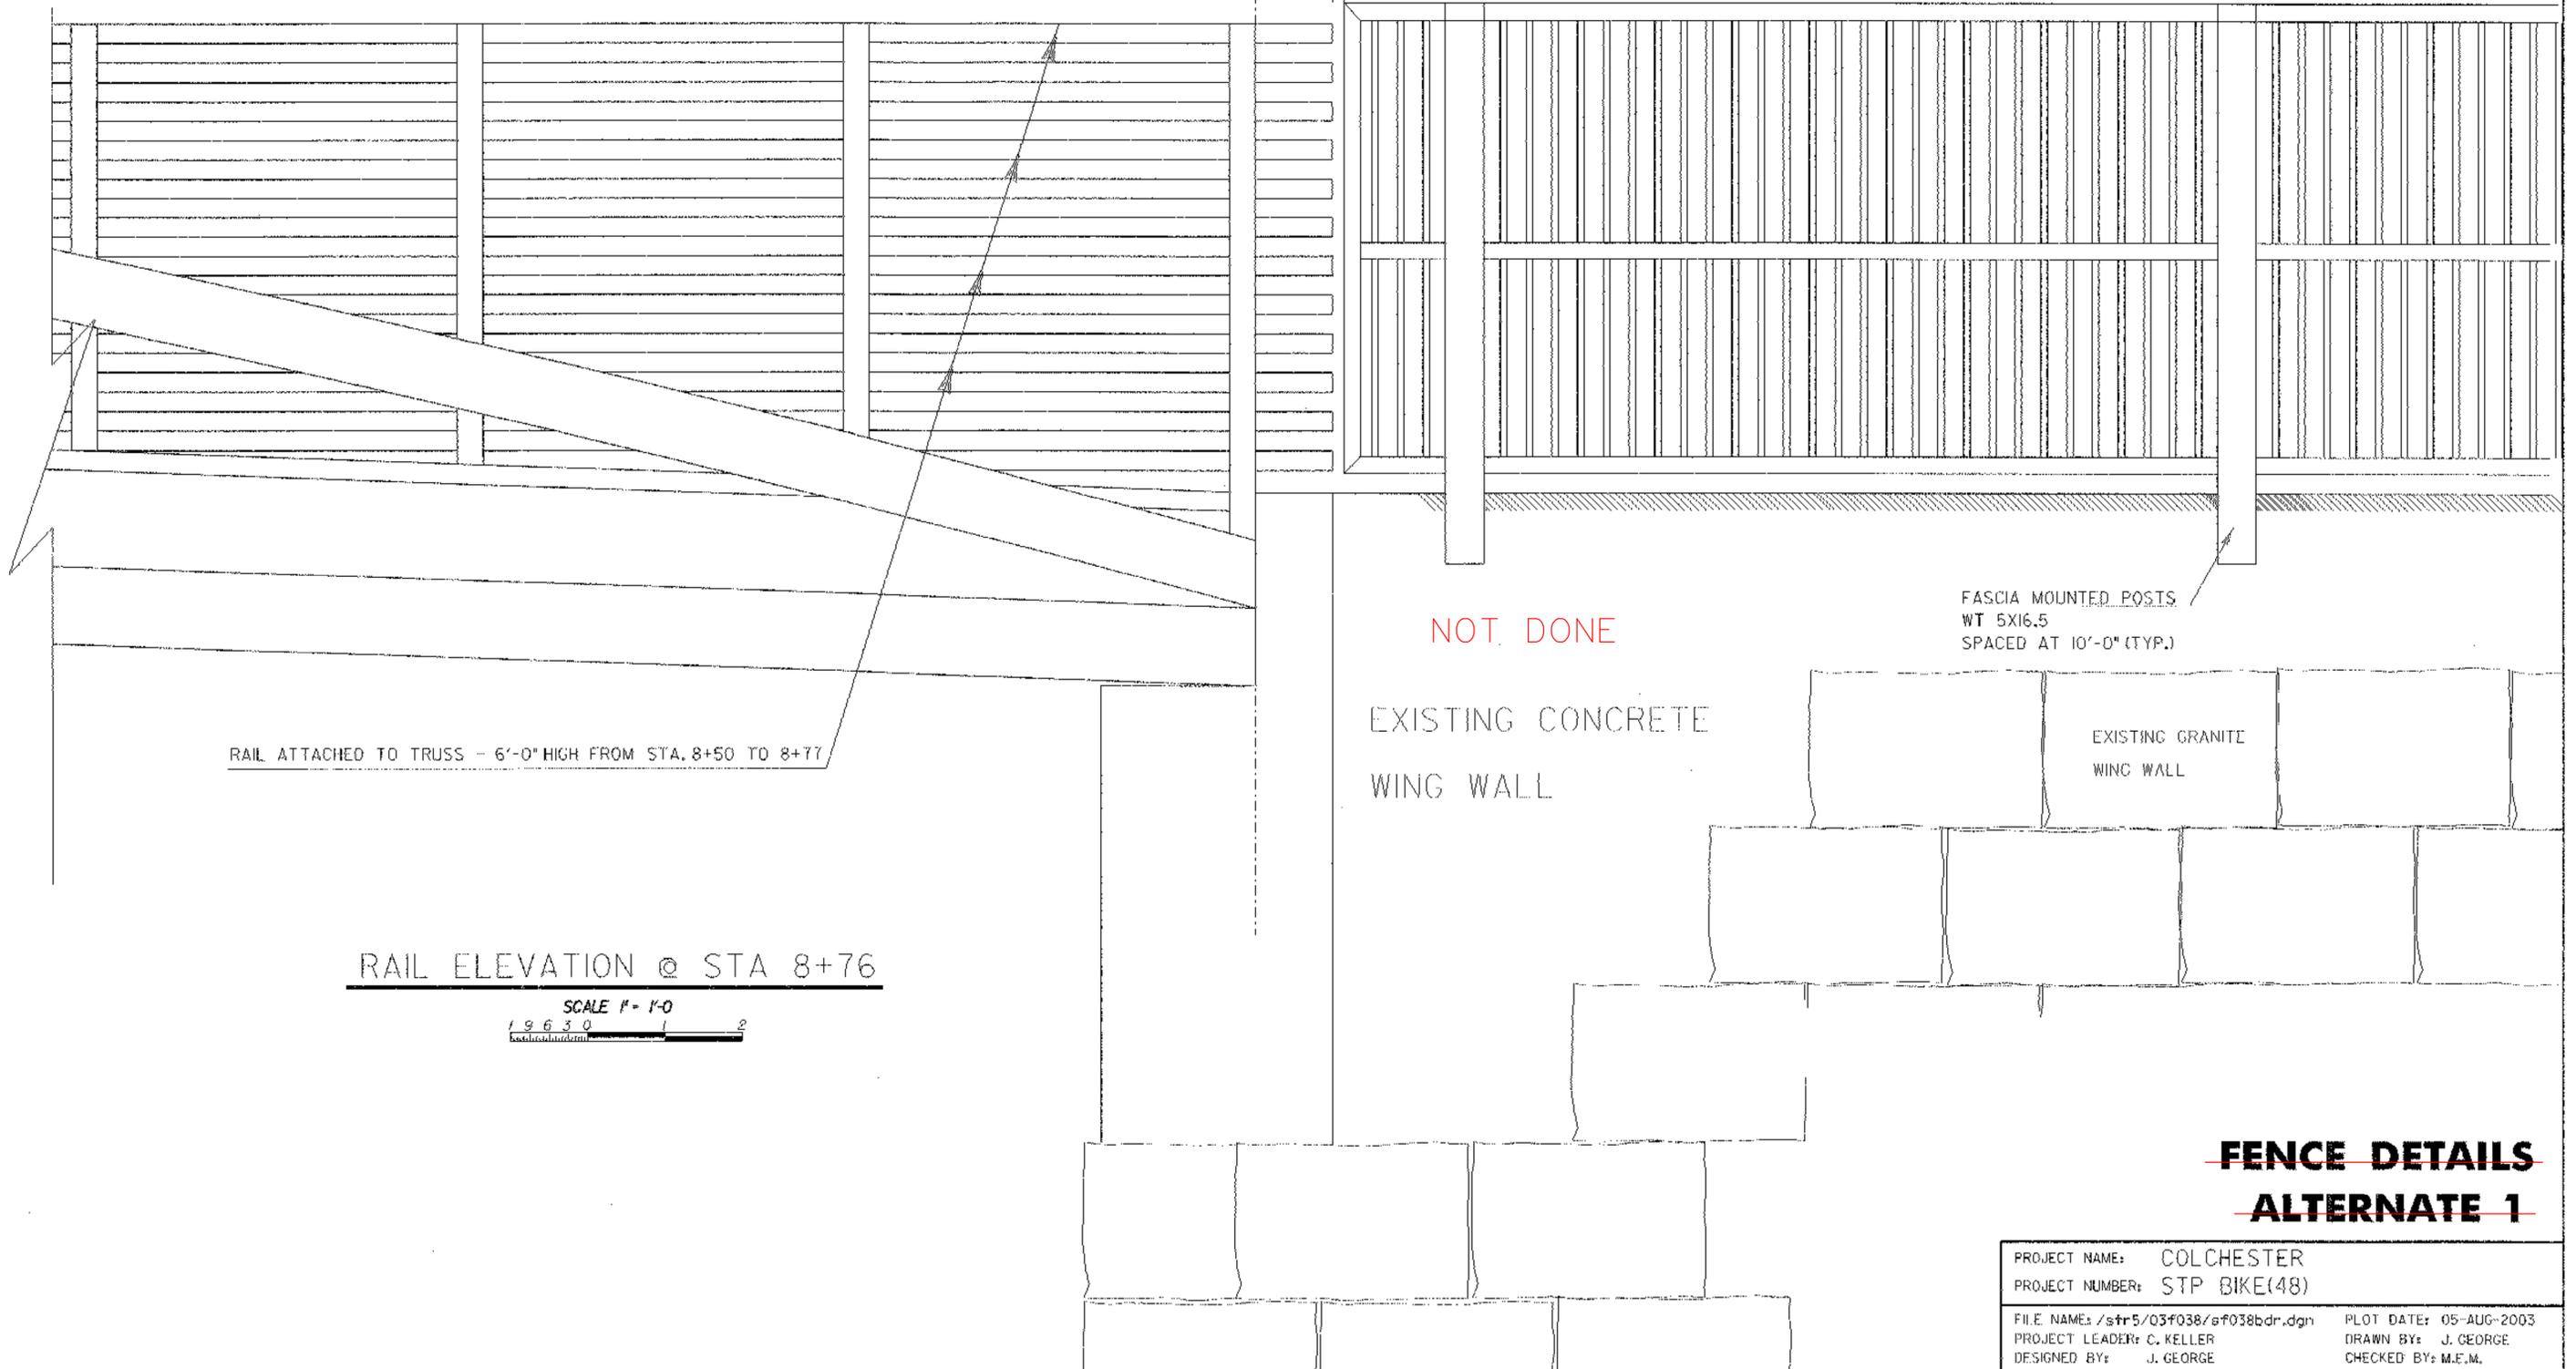

RAIL ATTACHED TO TRUSS - 6'-0" HIGH FROM STA. 8+50 TO 8+77

NOT DONE

FASCIA MOUNTED POSTS
WT 5X16.5
SPACED AT 10'-0" (TYP.)

EXISTING CONCRETE
WING WALL

EXISTING GRANITE
WING WALL

RAIL ELEVATION @ STA 8+76

SCALE 1" = 1'-0"
1 9 6 3 0 2

~~FENCE DETAILS~~
~~ALTERNATE 1~~

PROJECT NAME: COLCHESTER	PLOT DATE: 05-AUG-2003
PROJECT NUMBER: STP BIKE(48)	DRAWN BY: J. GEORGE
FILE NAME: /sfr5/03f038/sf038bdr.dgn	CHECKED BY: M.E.M.
PROJECT LEADER: C. KELLER	SHEET 57 OF 87
DESIGNED BY: J. GEORGE	
sf038-r015.f	