


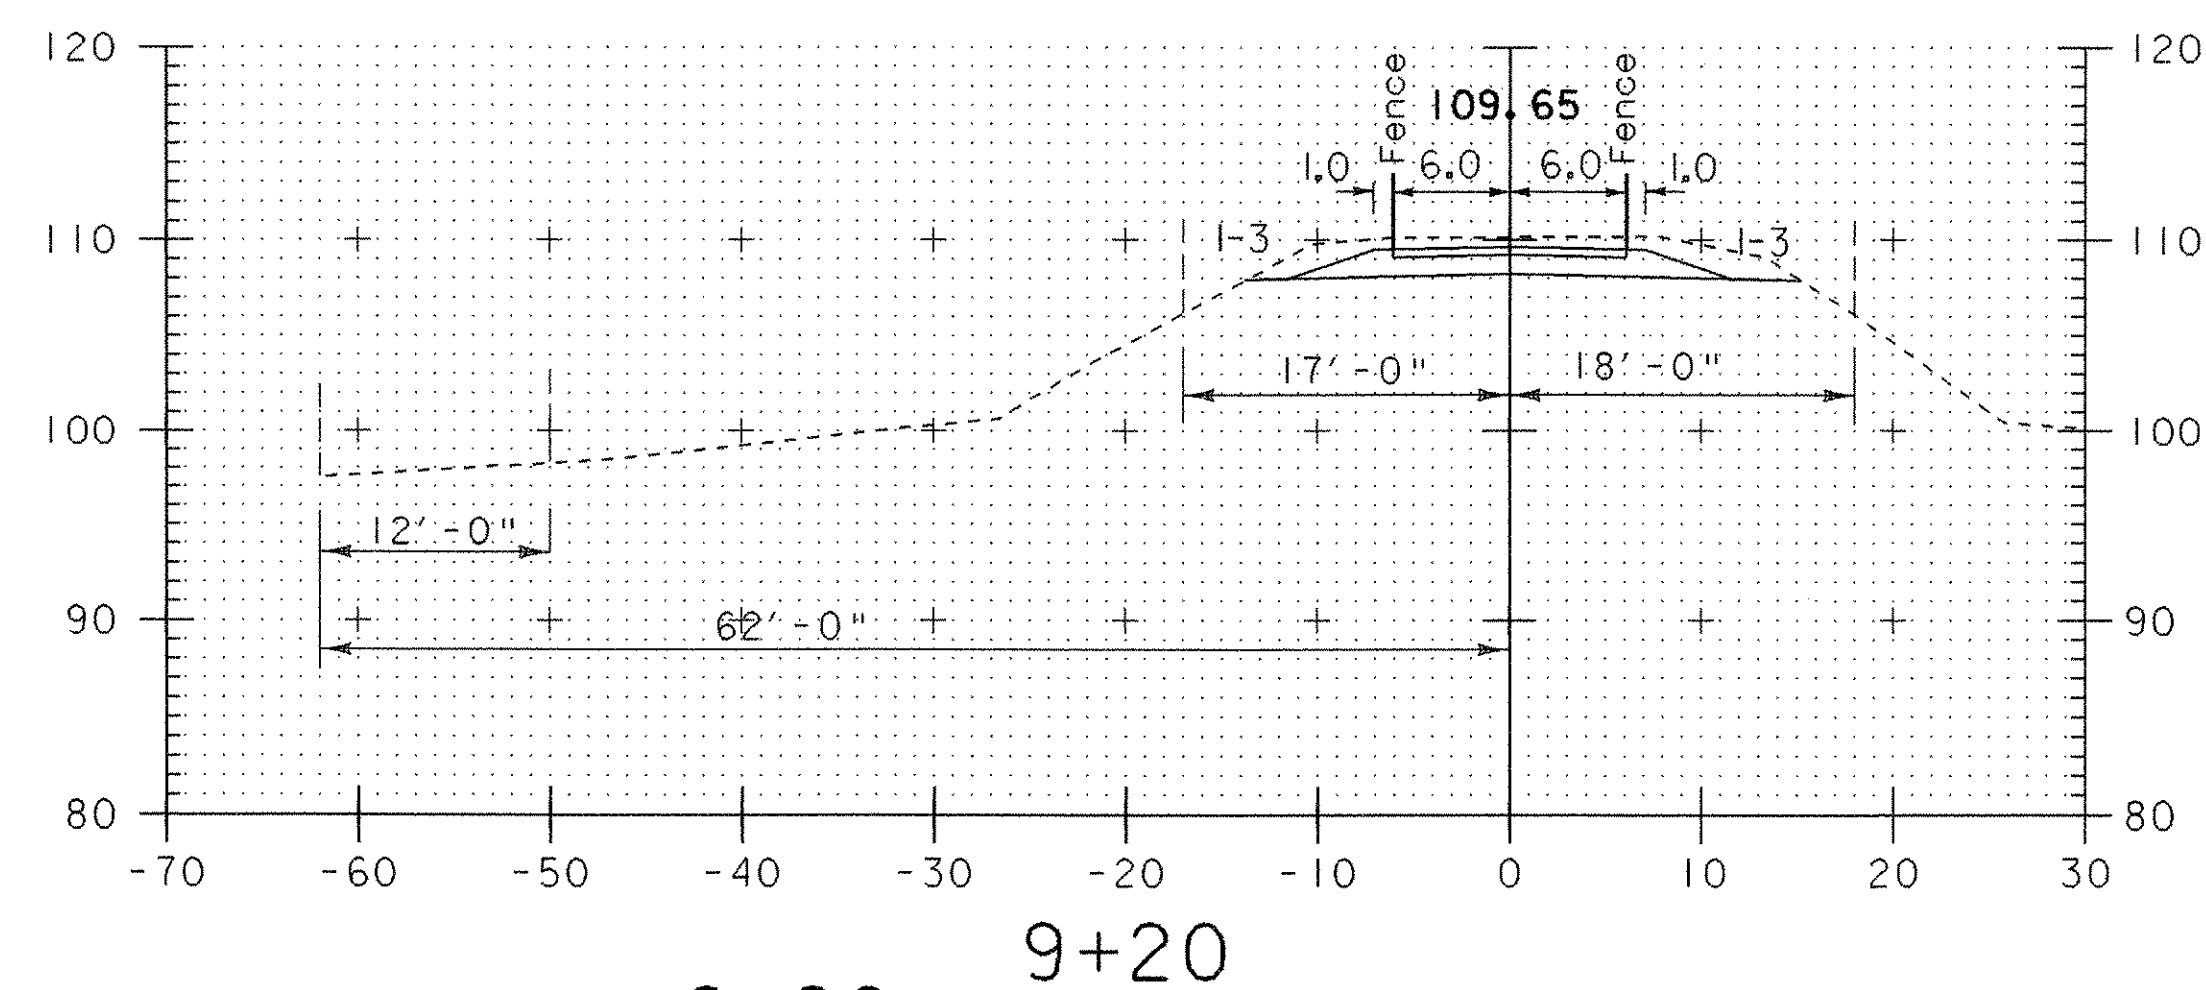
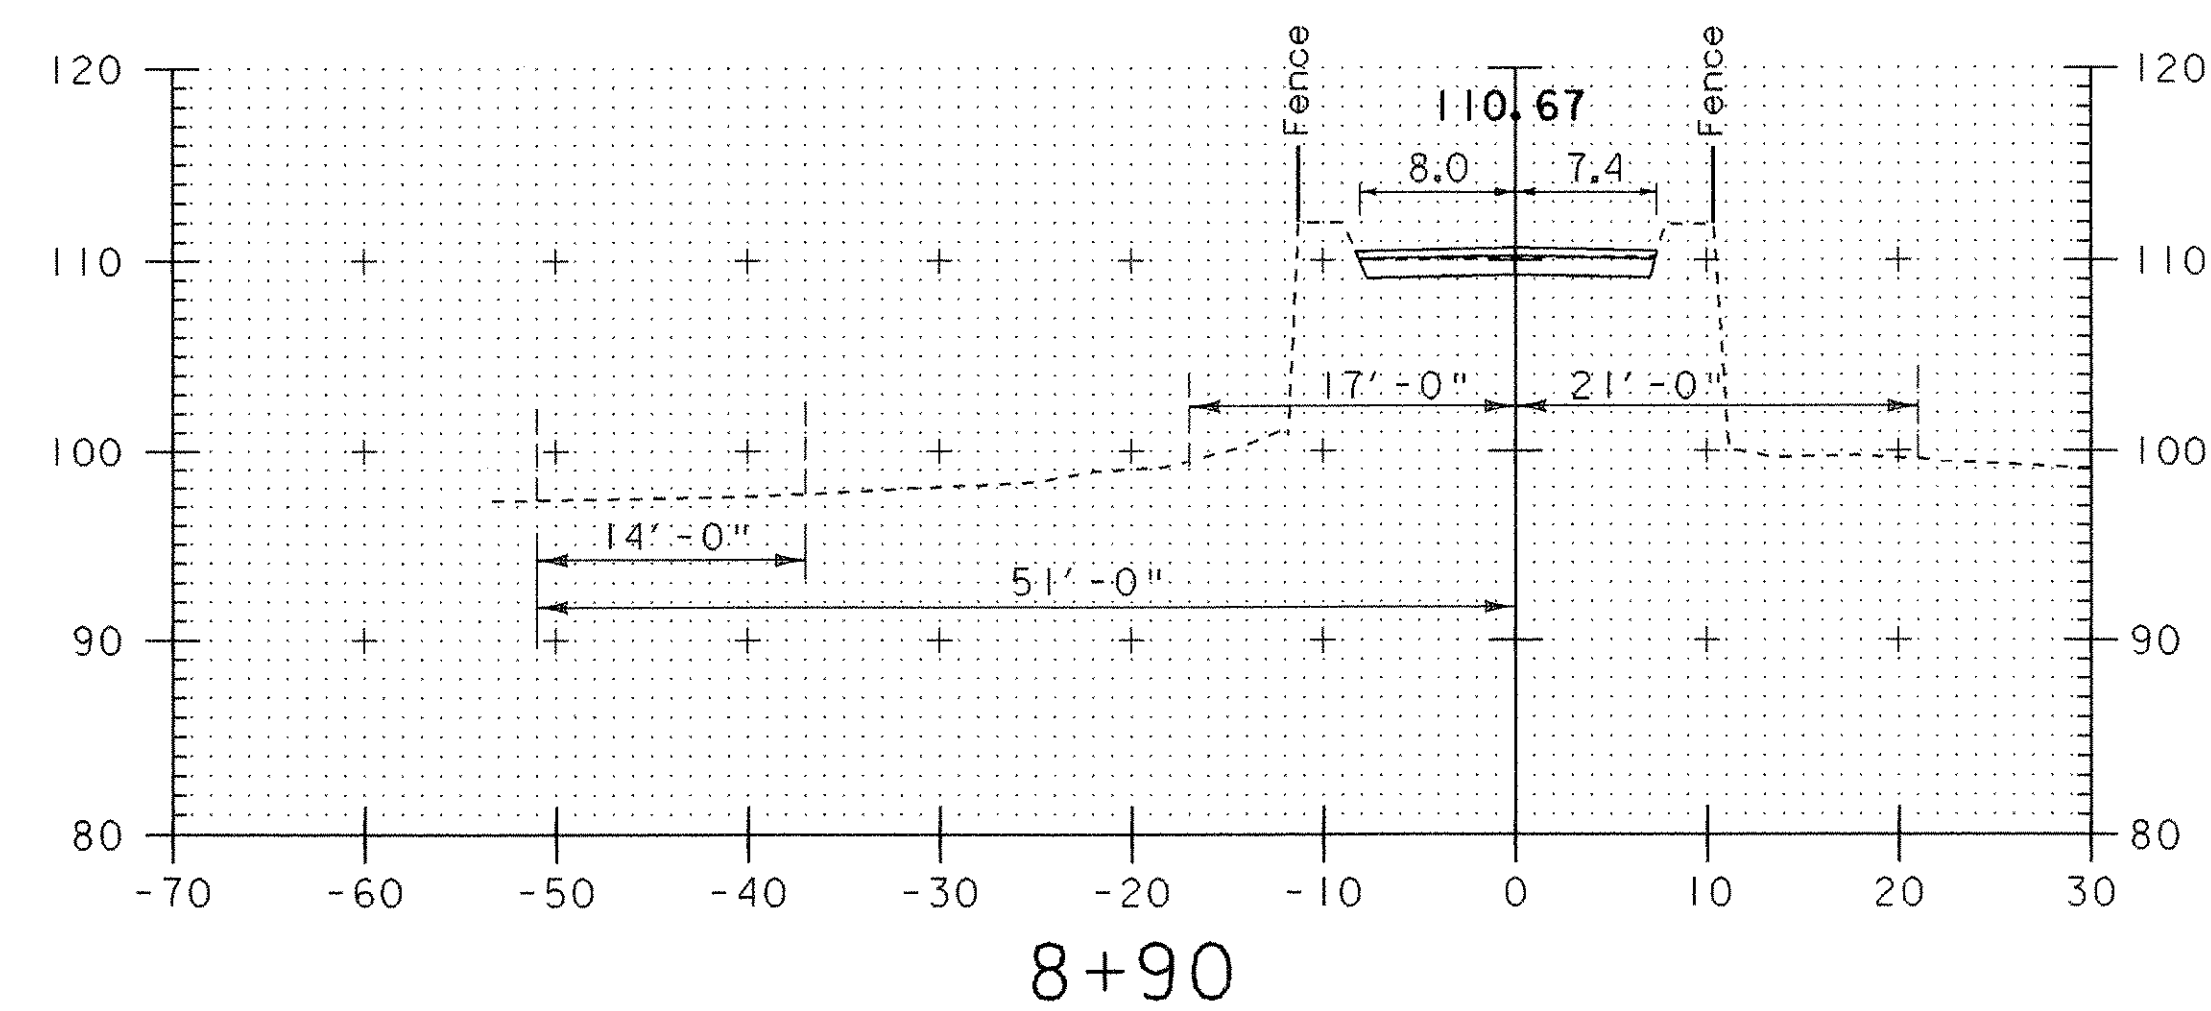
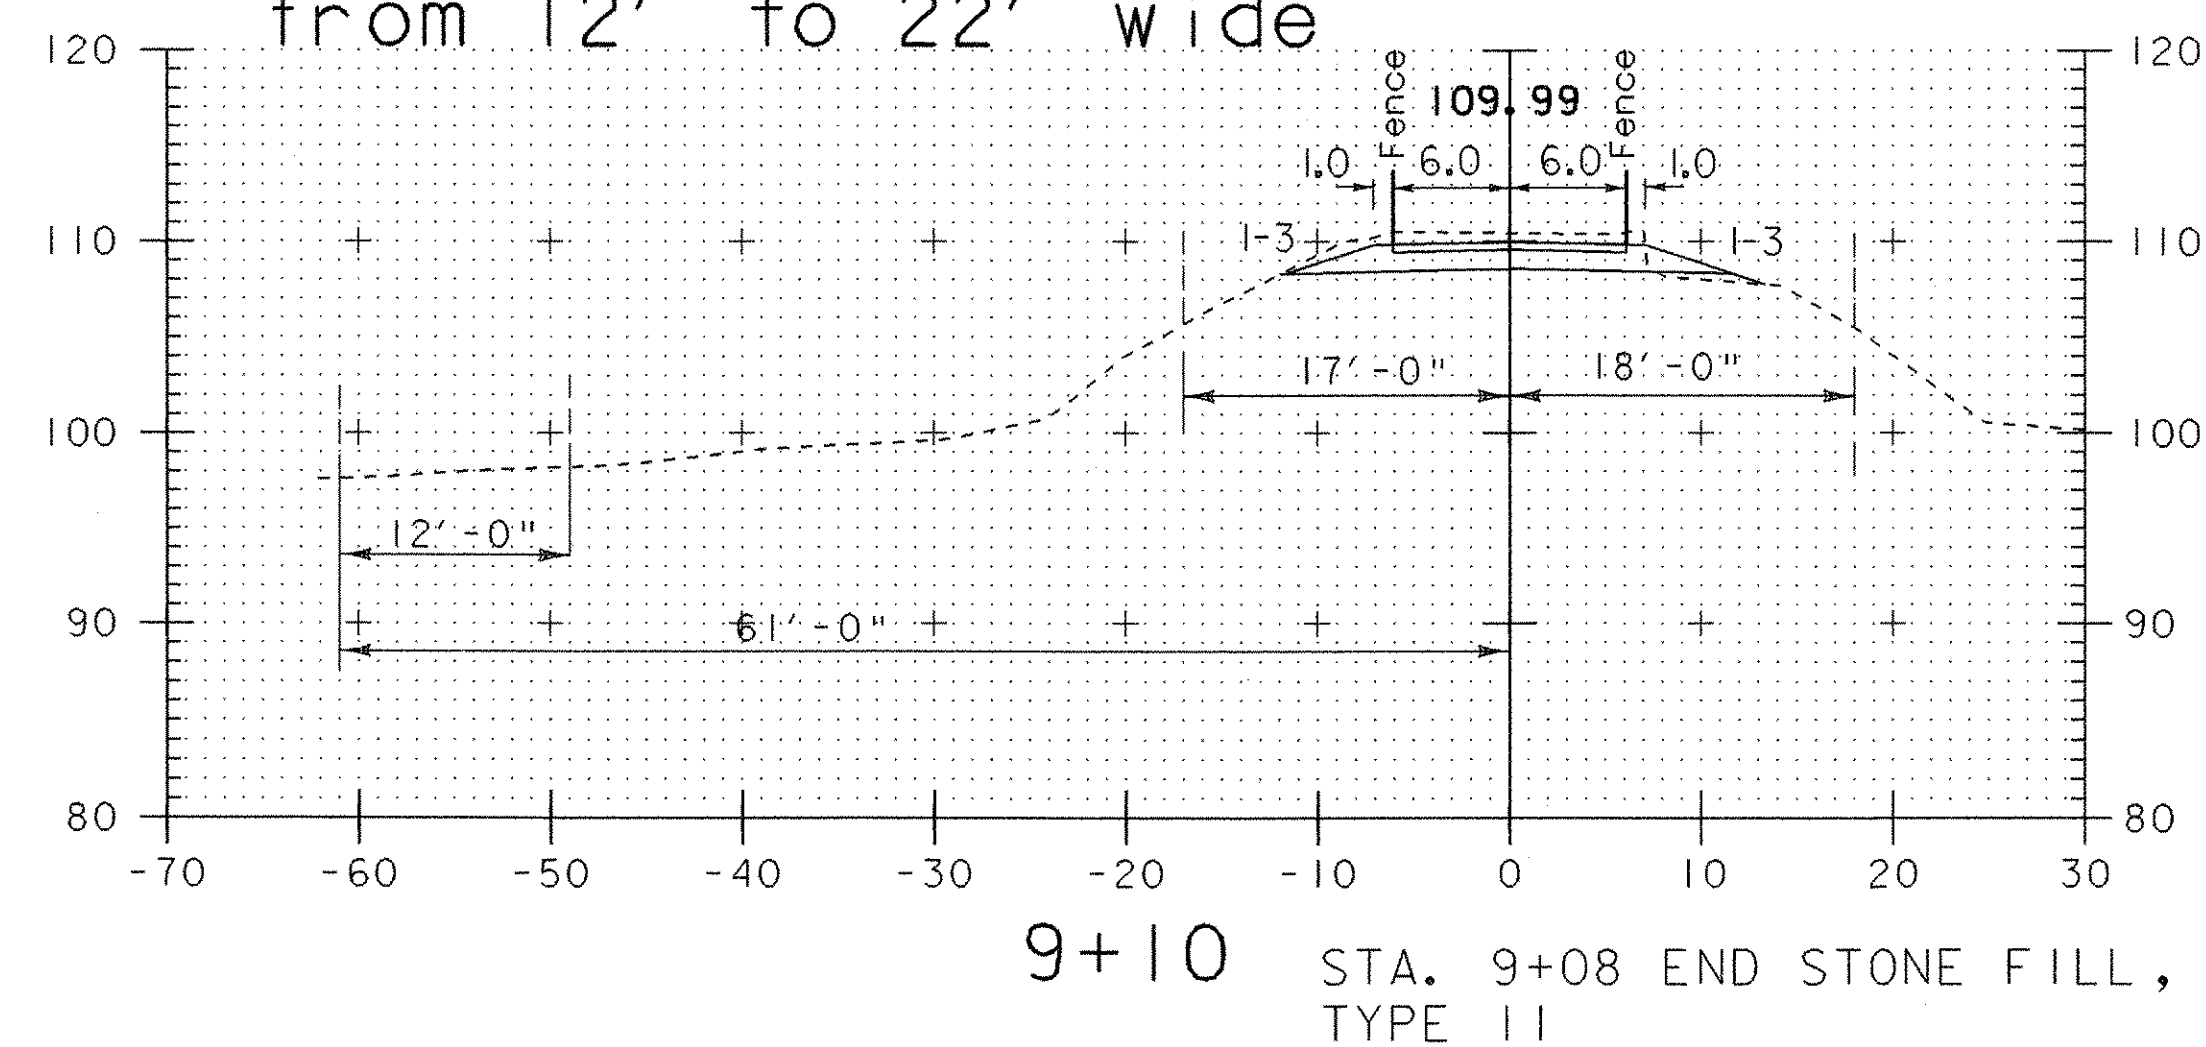


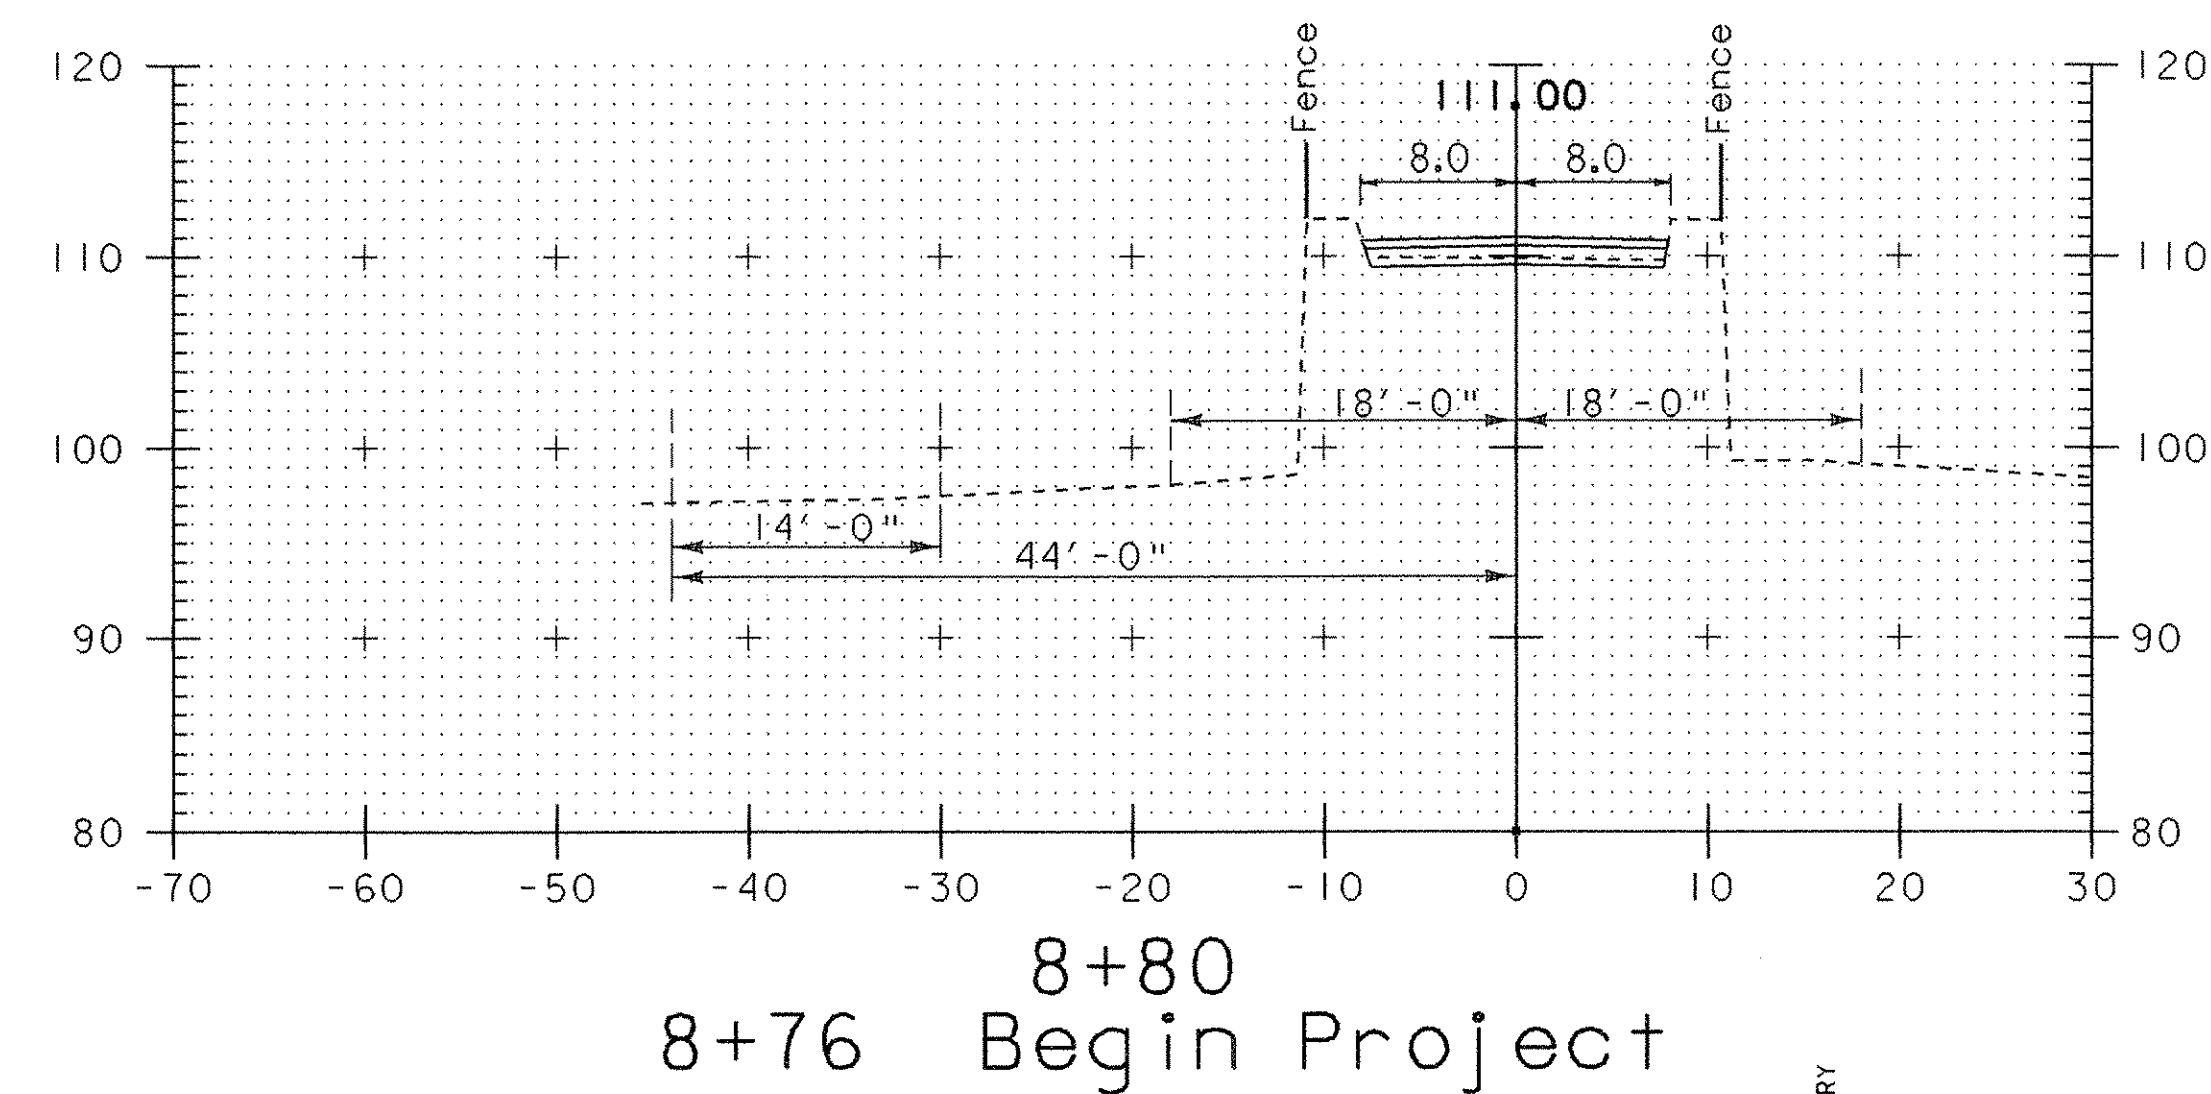

Begin Path Width Taper
from 12' to 22' wide

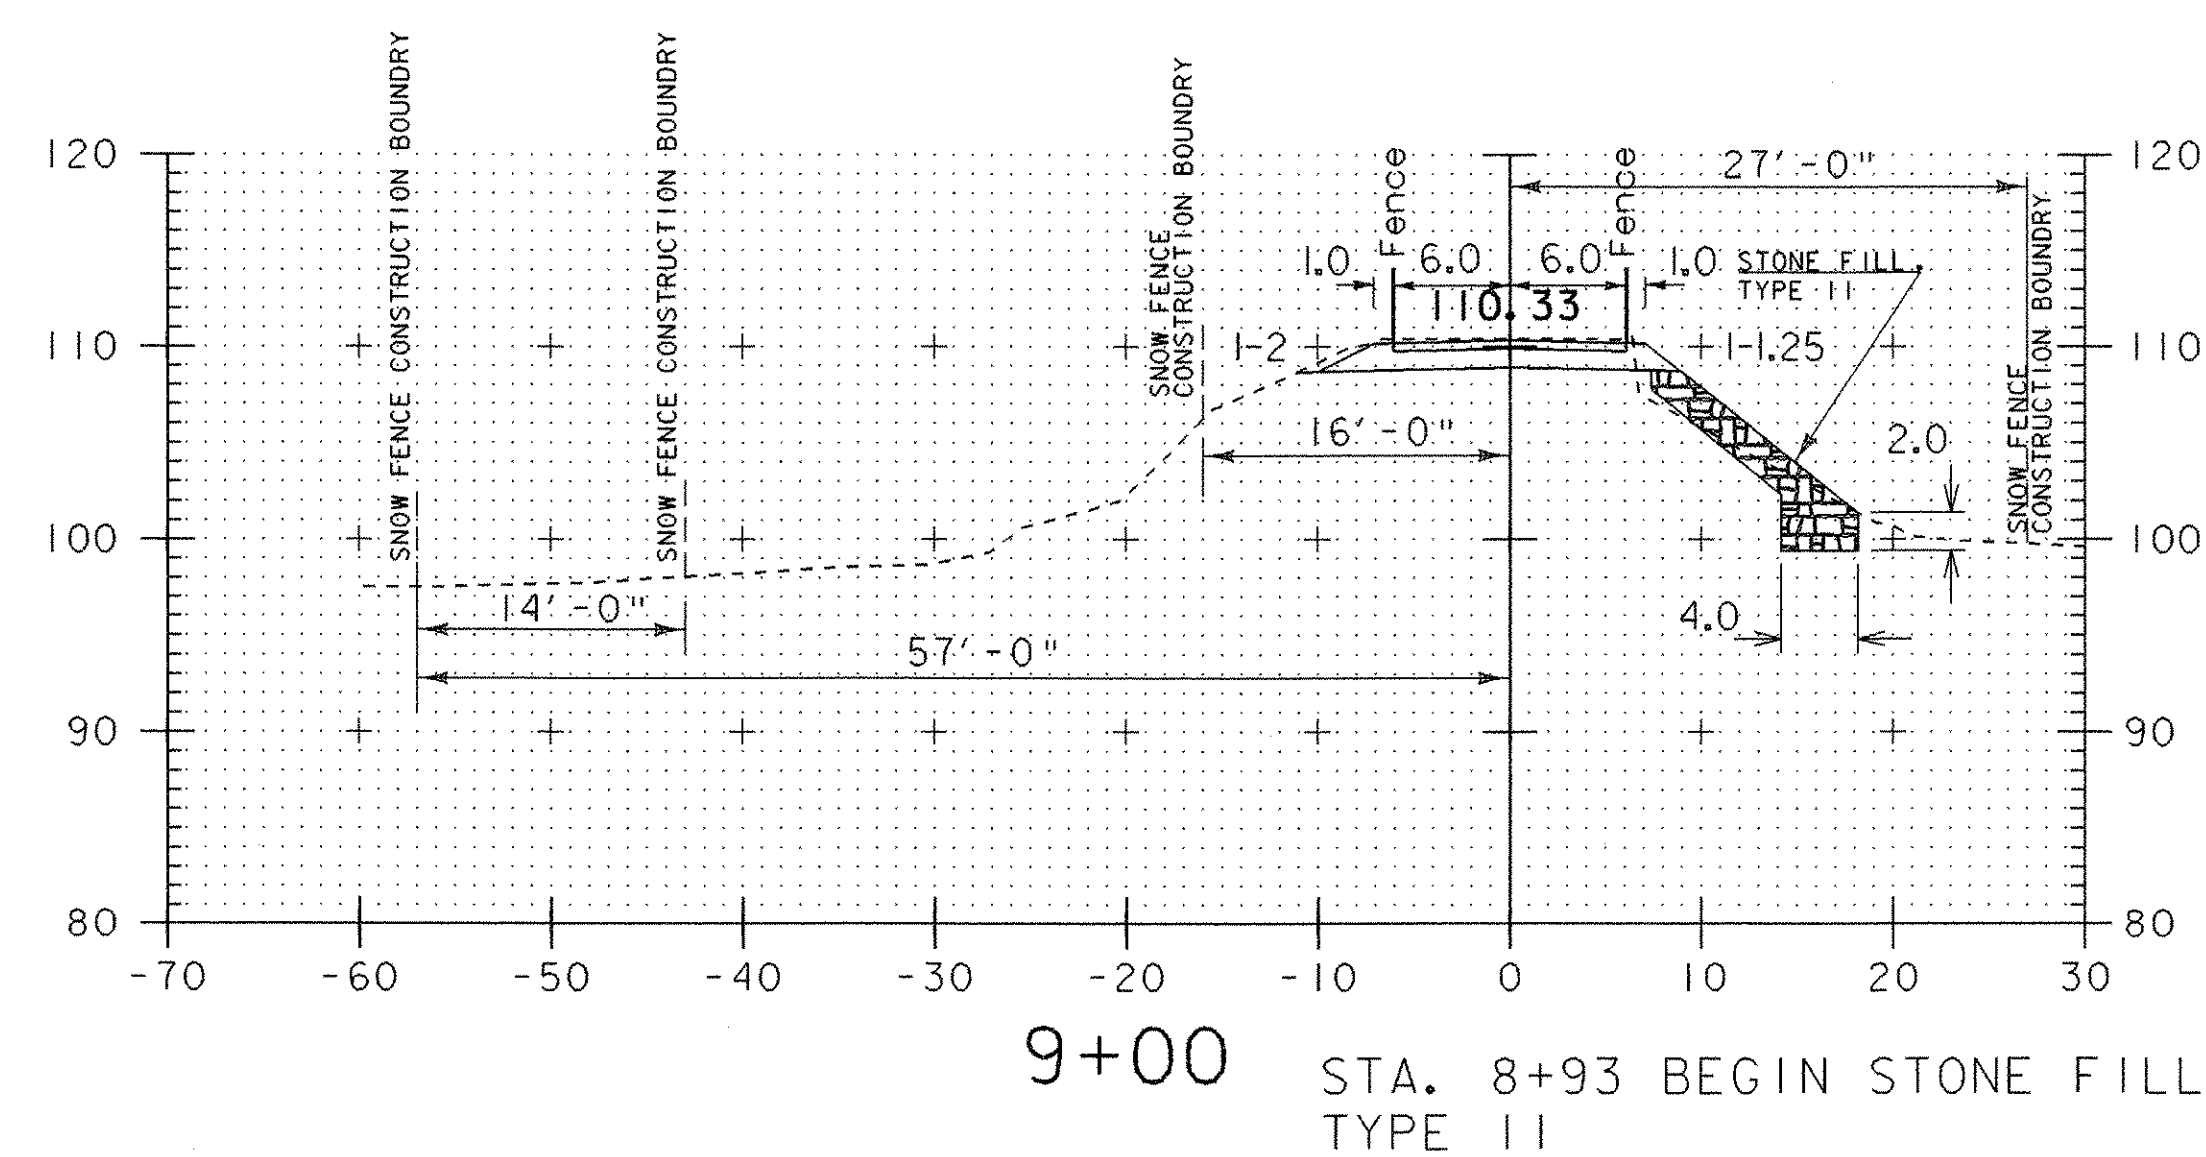

STA. 9+08 END STONE FILL,
TYPE II

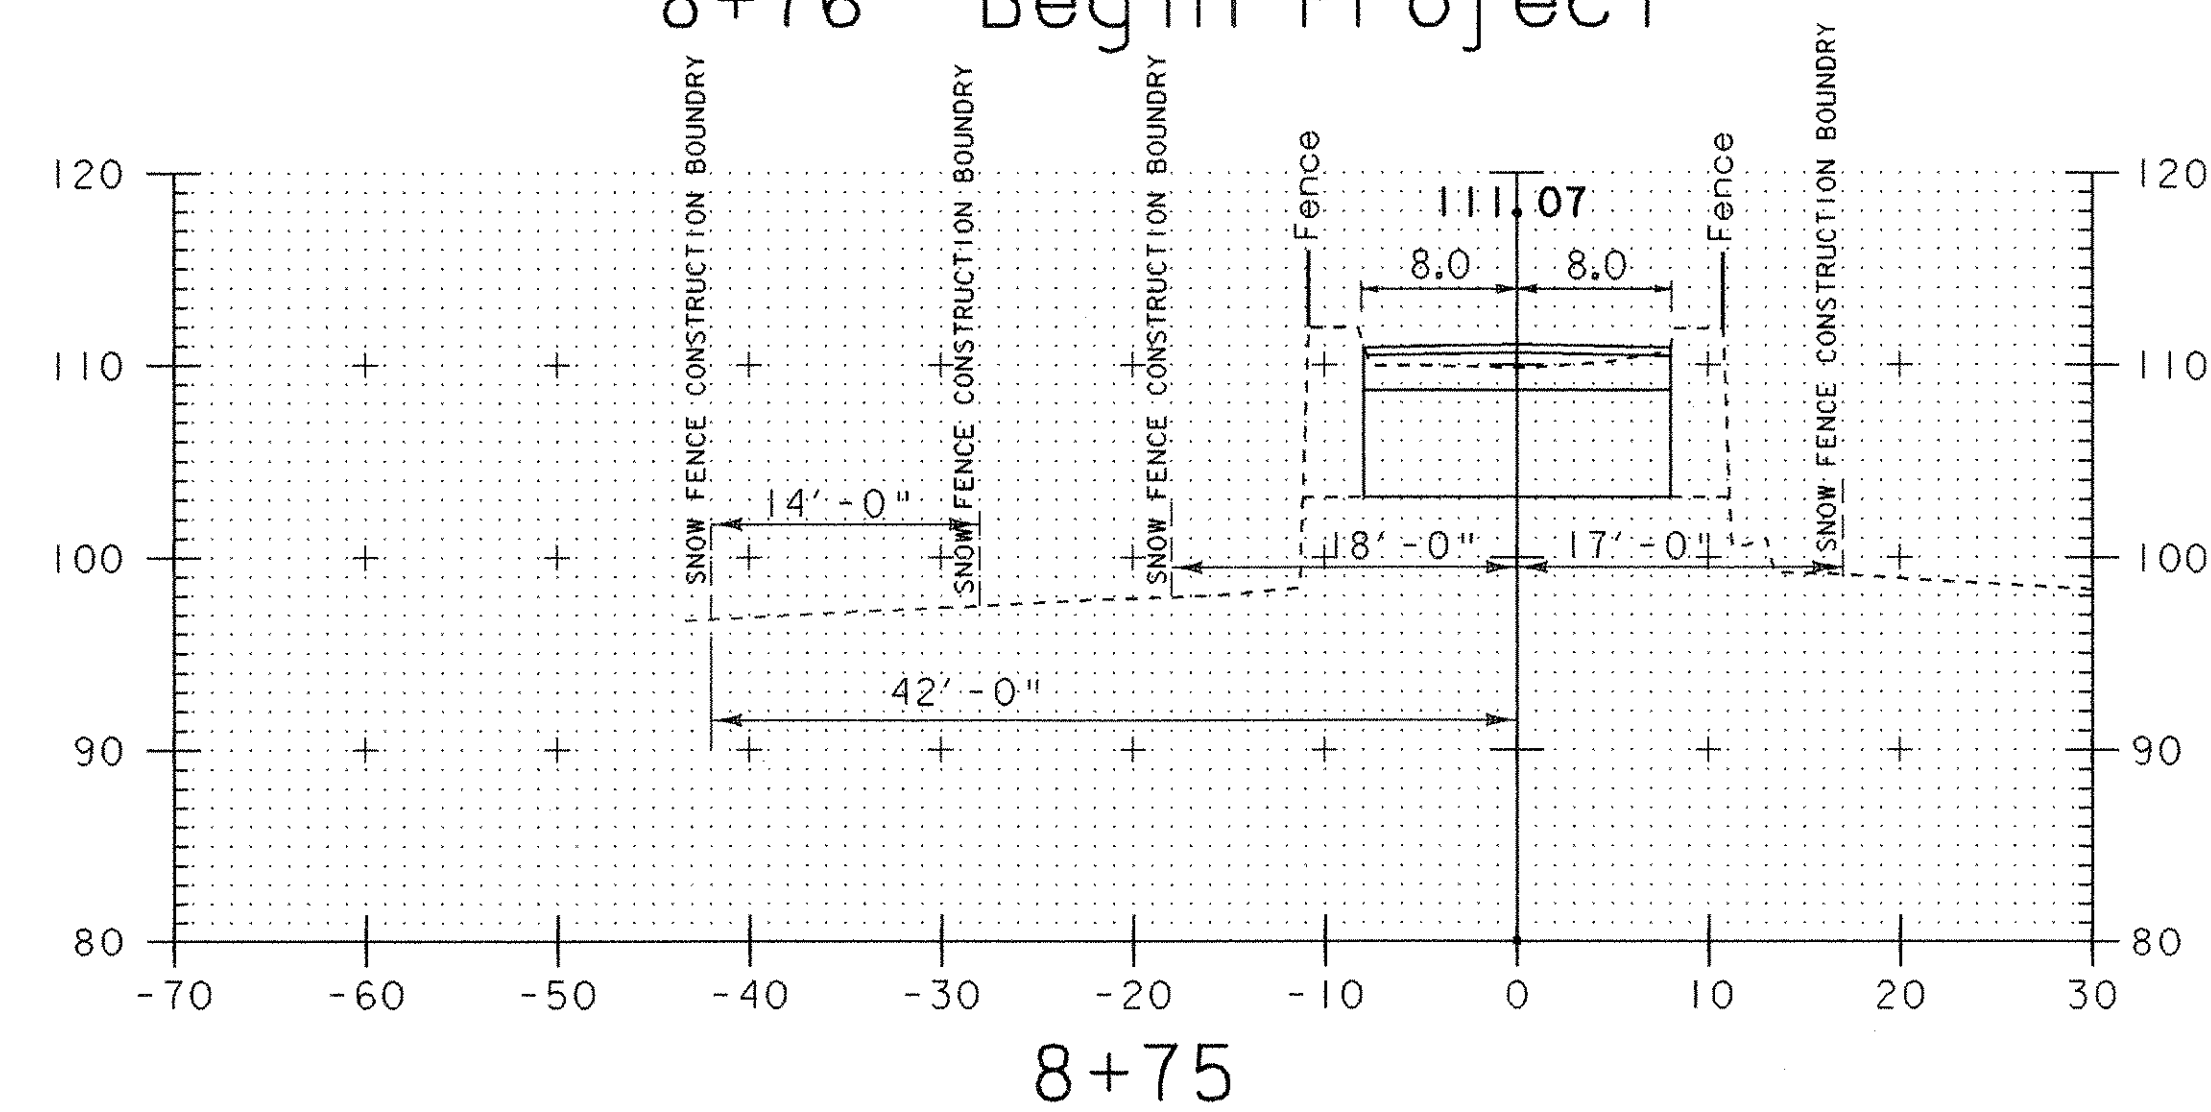

STA. 8+93 BEGIN STONE FILL,
TYPE II

CROSS SECTIONS 8+75 - 9+20

PROJECT NAME:	Colchester
PROJECT NUMBER:	STP Bike(48)
FILE NAME:\str5\03f038\s038xsl.dgn	PLOT DATE: 05-AUG-2003
PROJECT LEADER: C. Keller	DRAWN BY: G. Shangraw
DESIGNED BY: G. Shangraw	CHECKED BY:
sf038xs2.1	SHEET 71 OF 87