




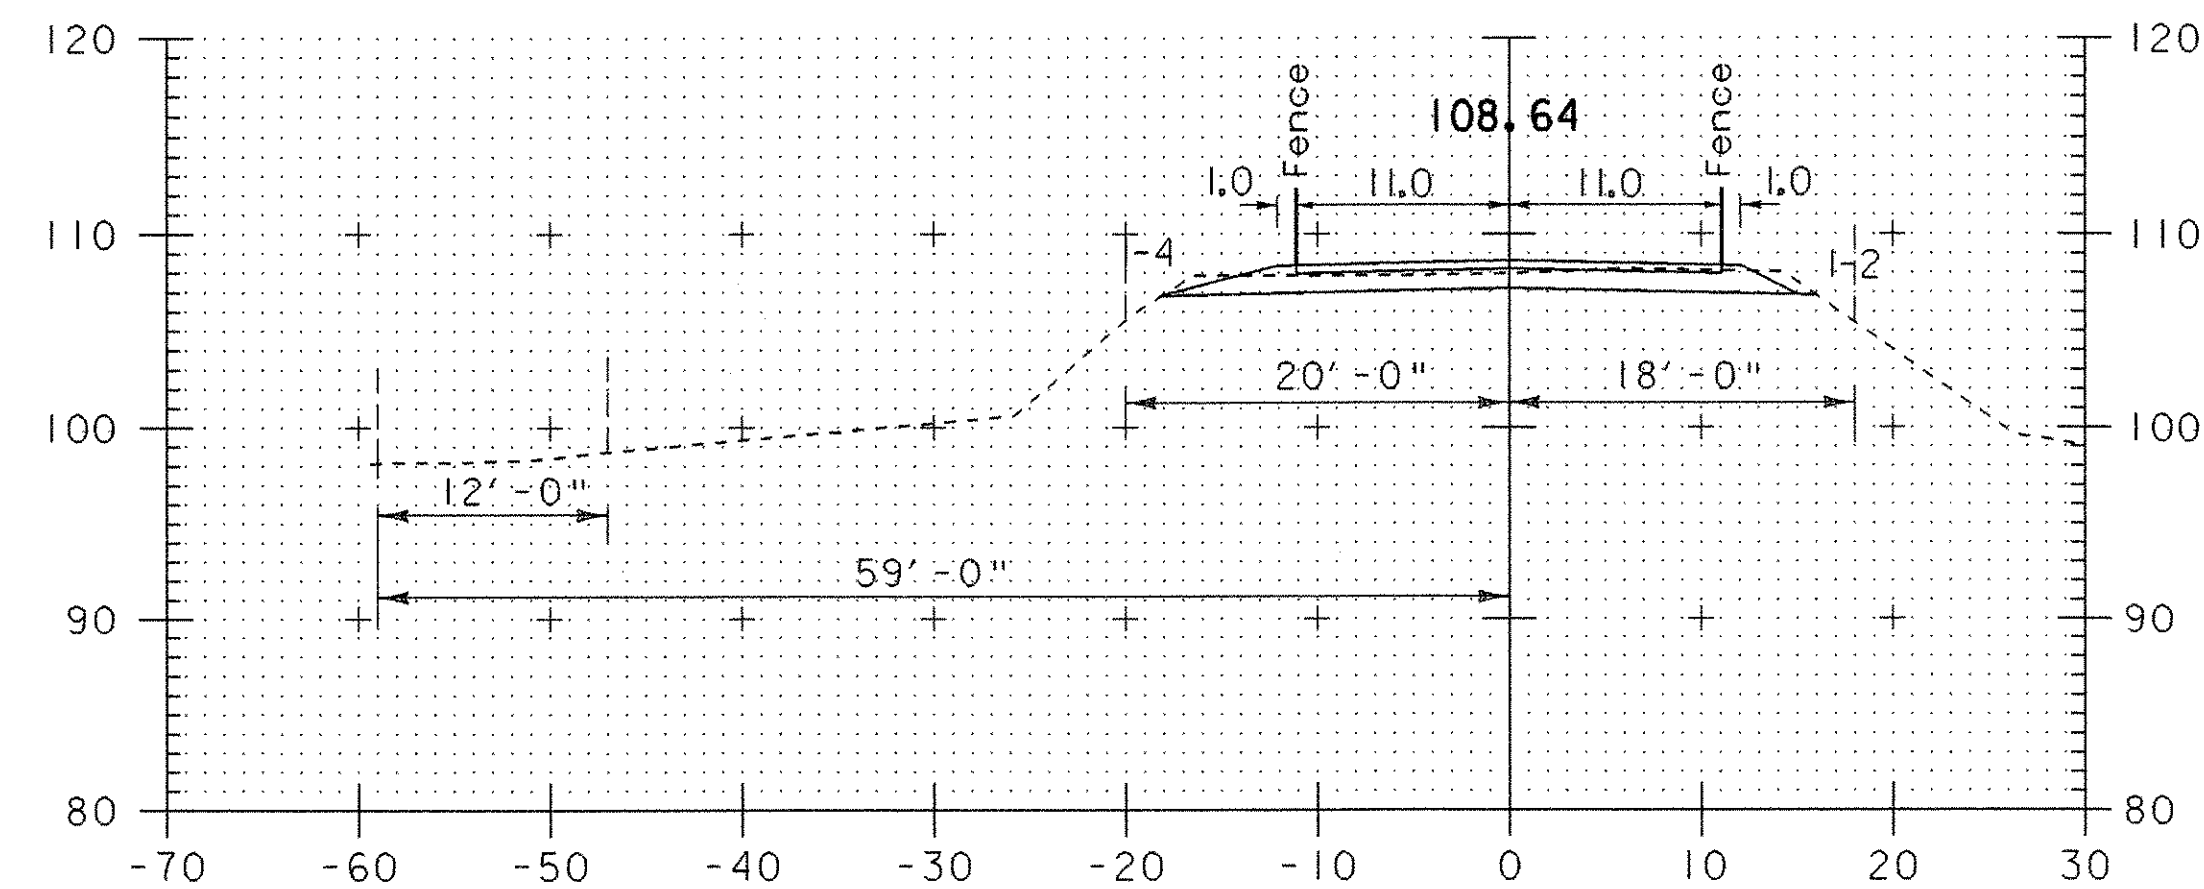


9+50 9+50
End 22' Wide Path
Begin Taper 22' to 12' wide

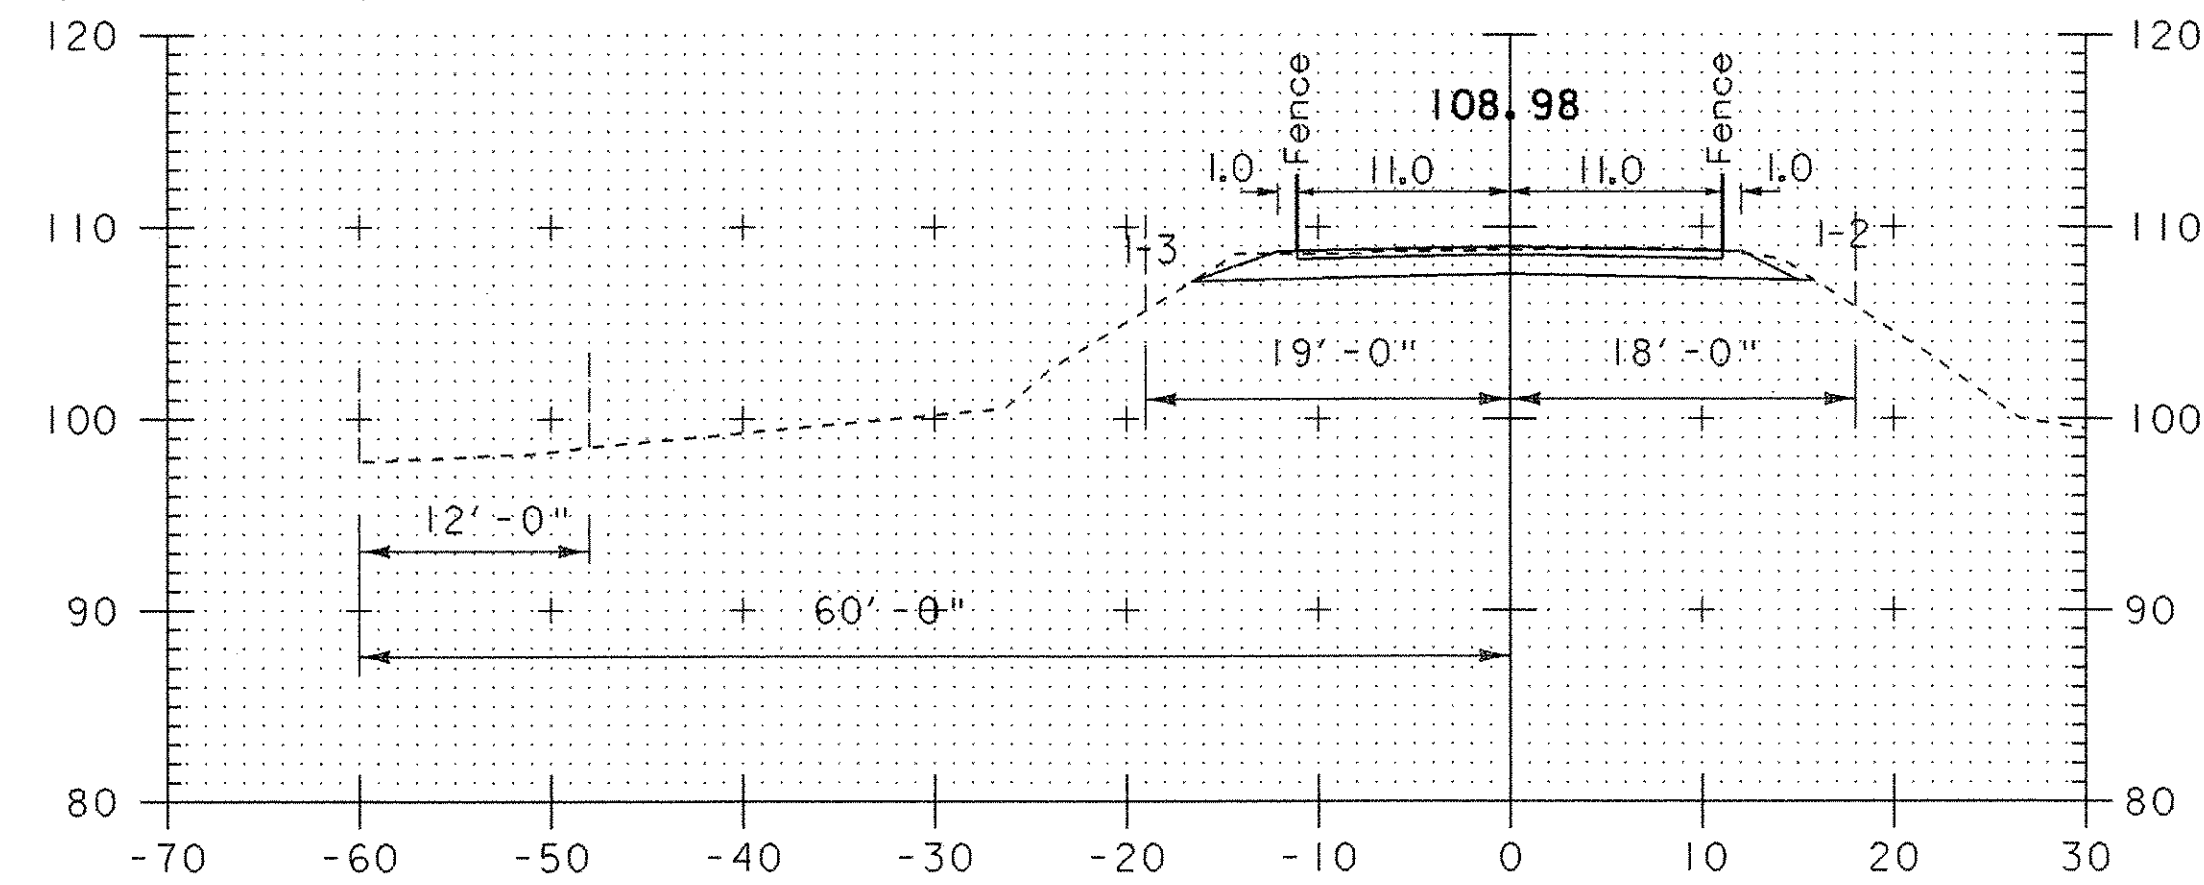


9+40

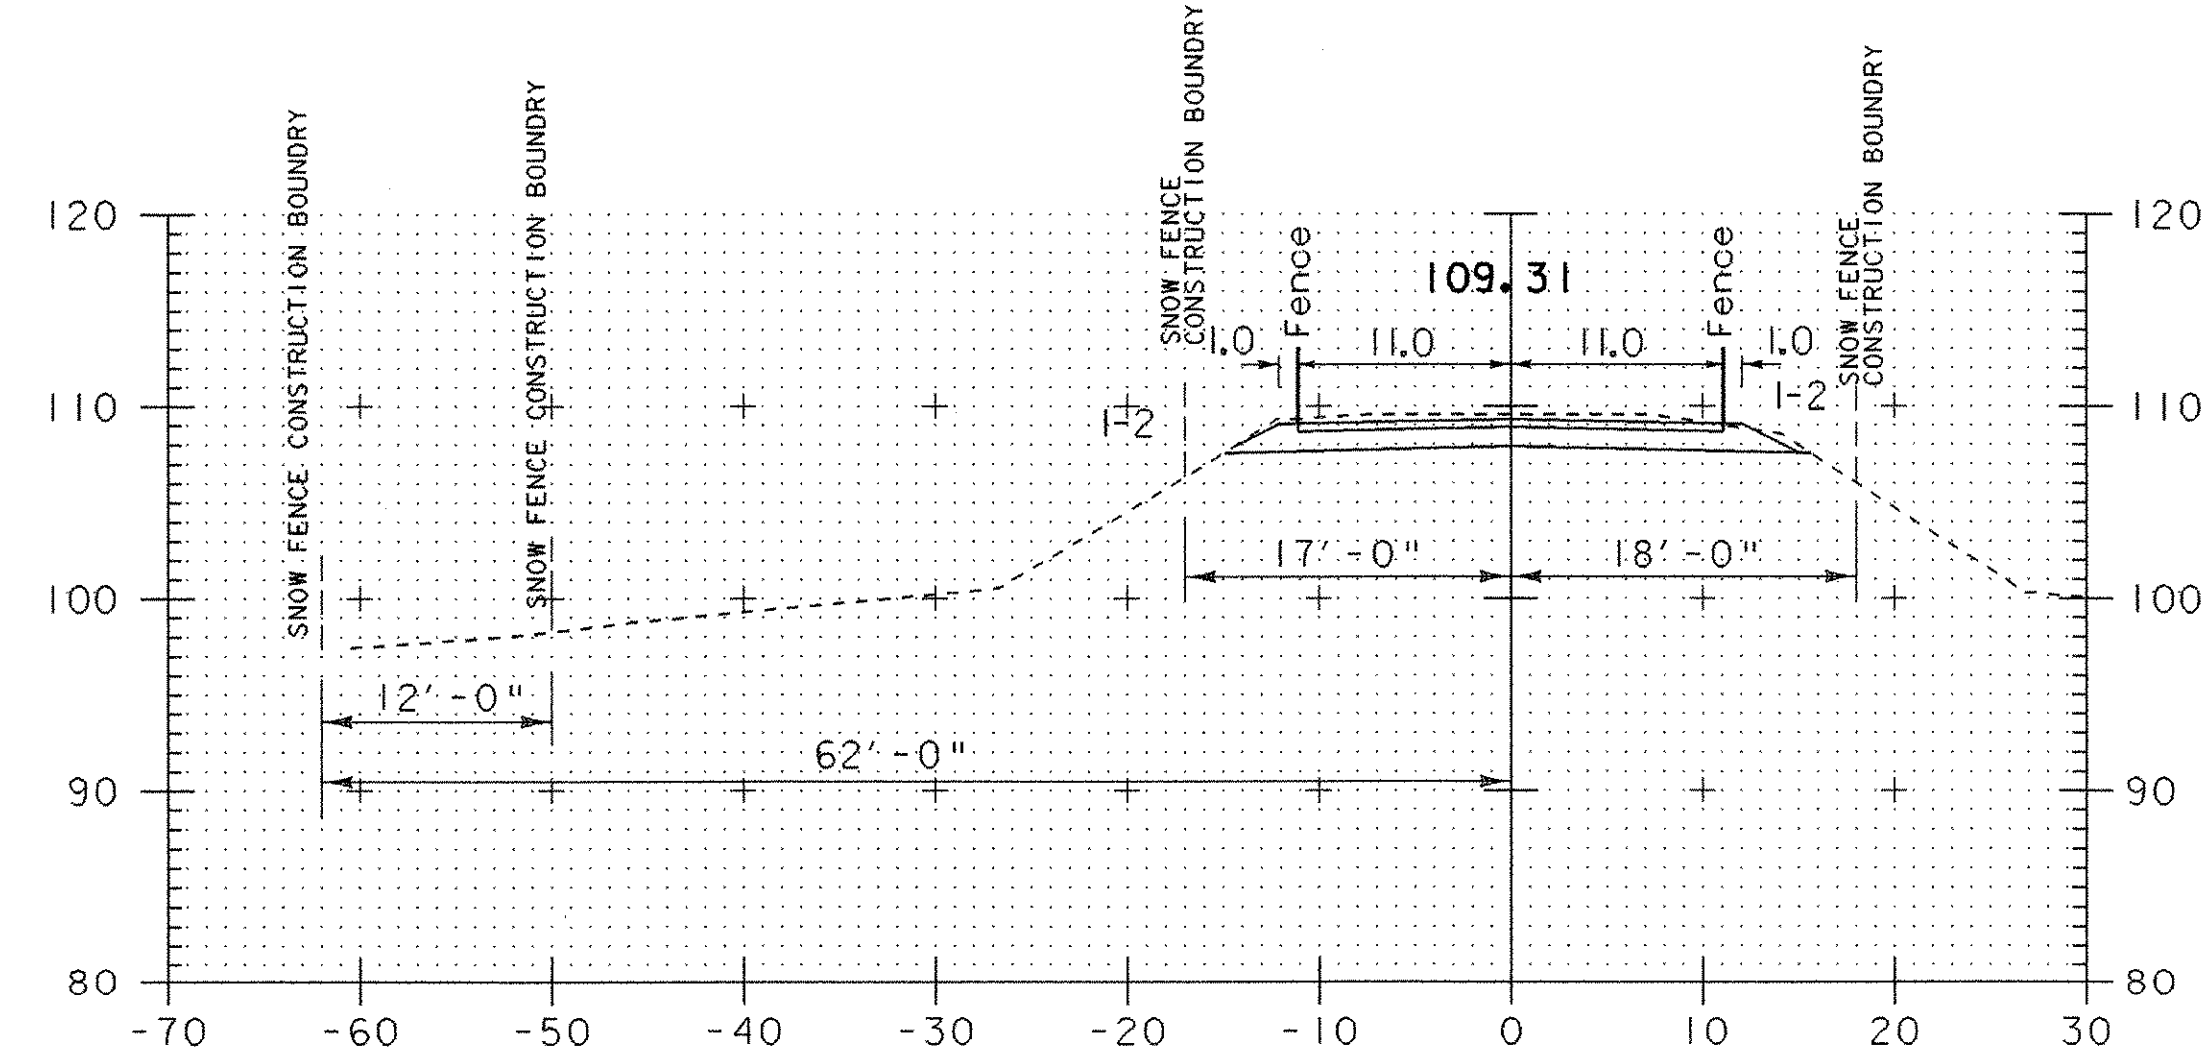


9+30

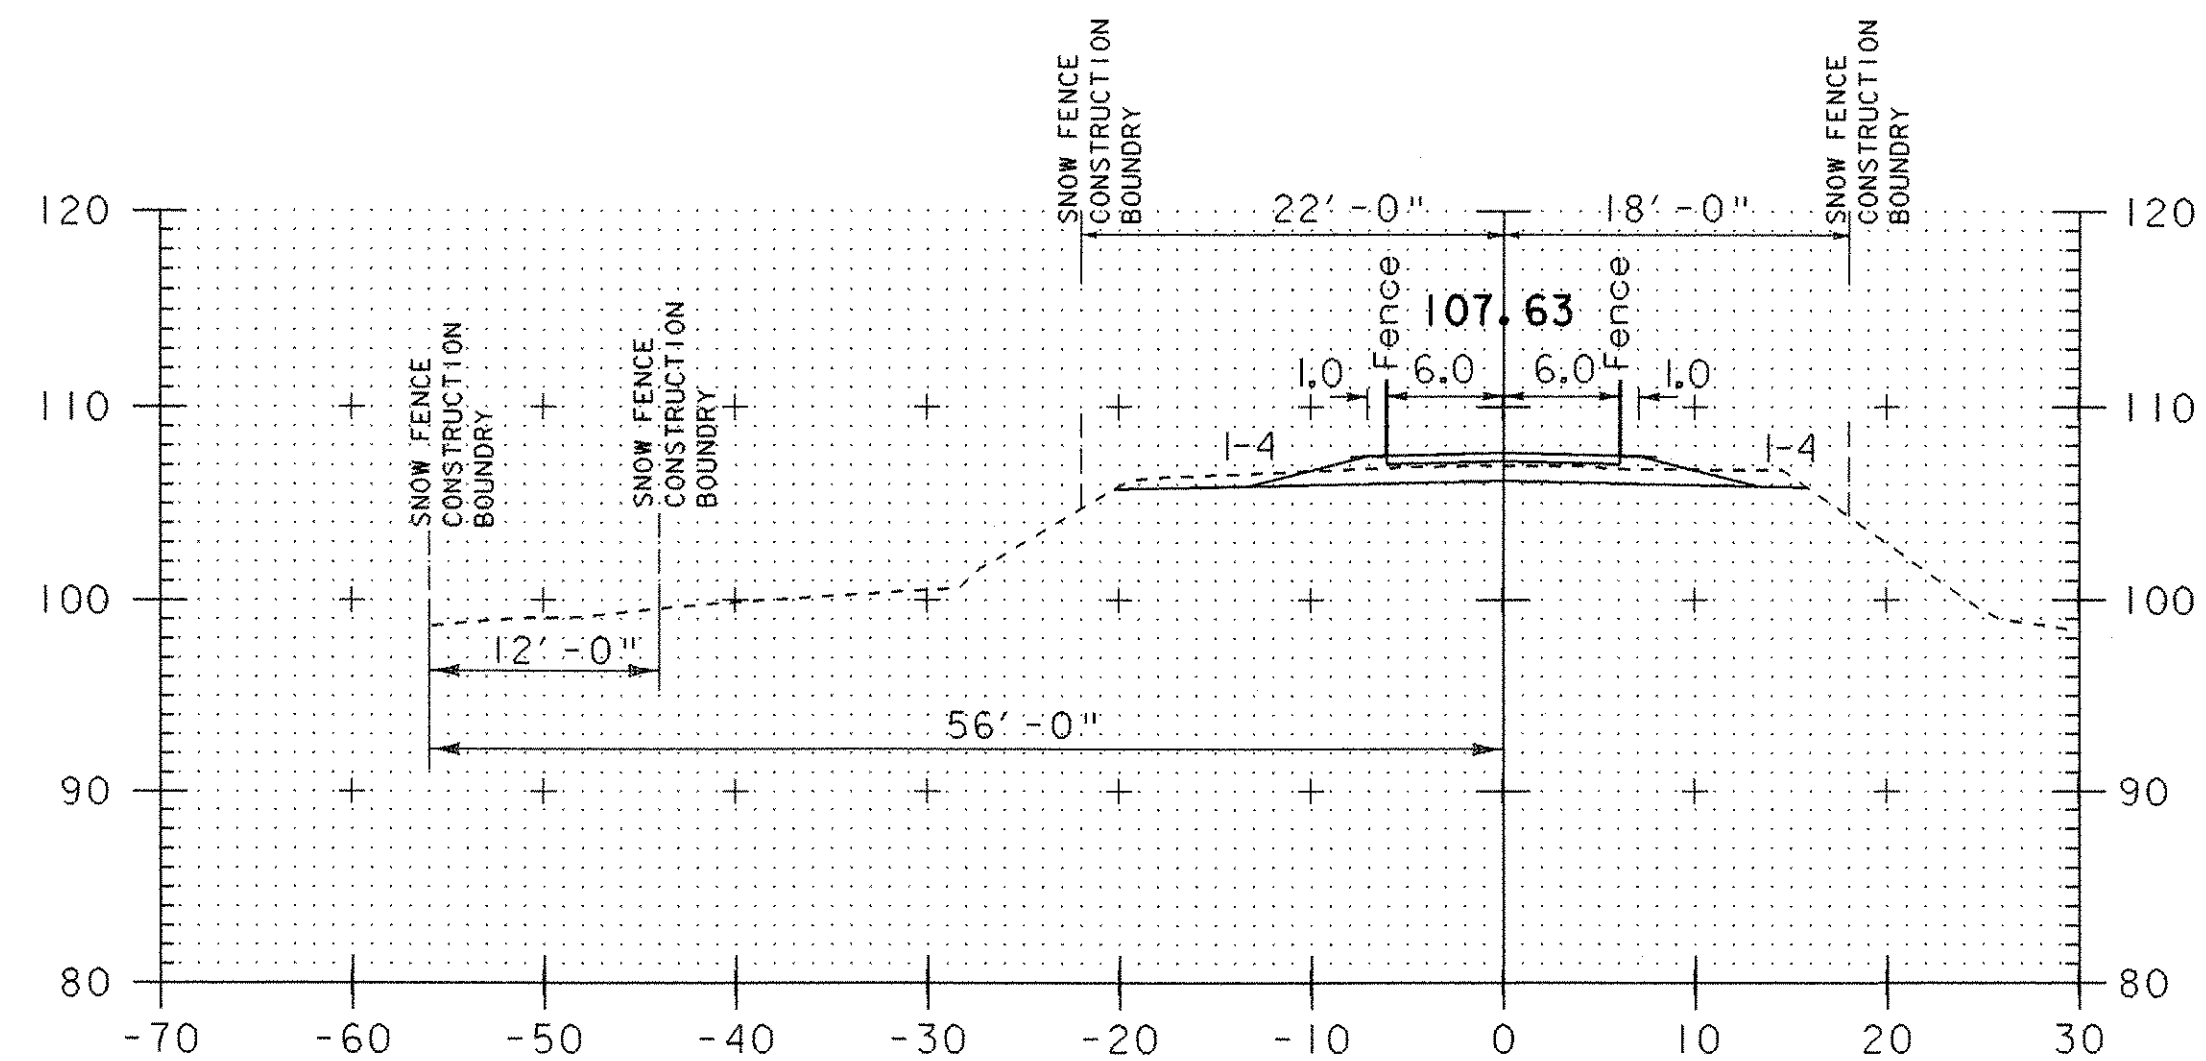

9+80

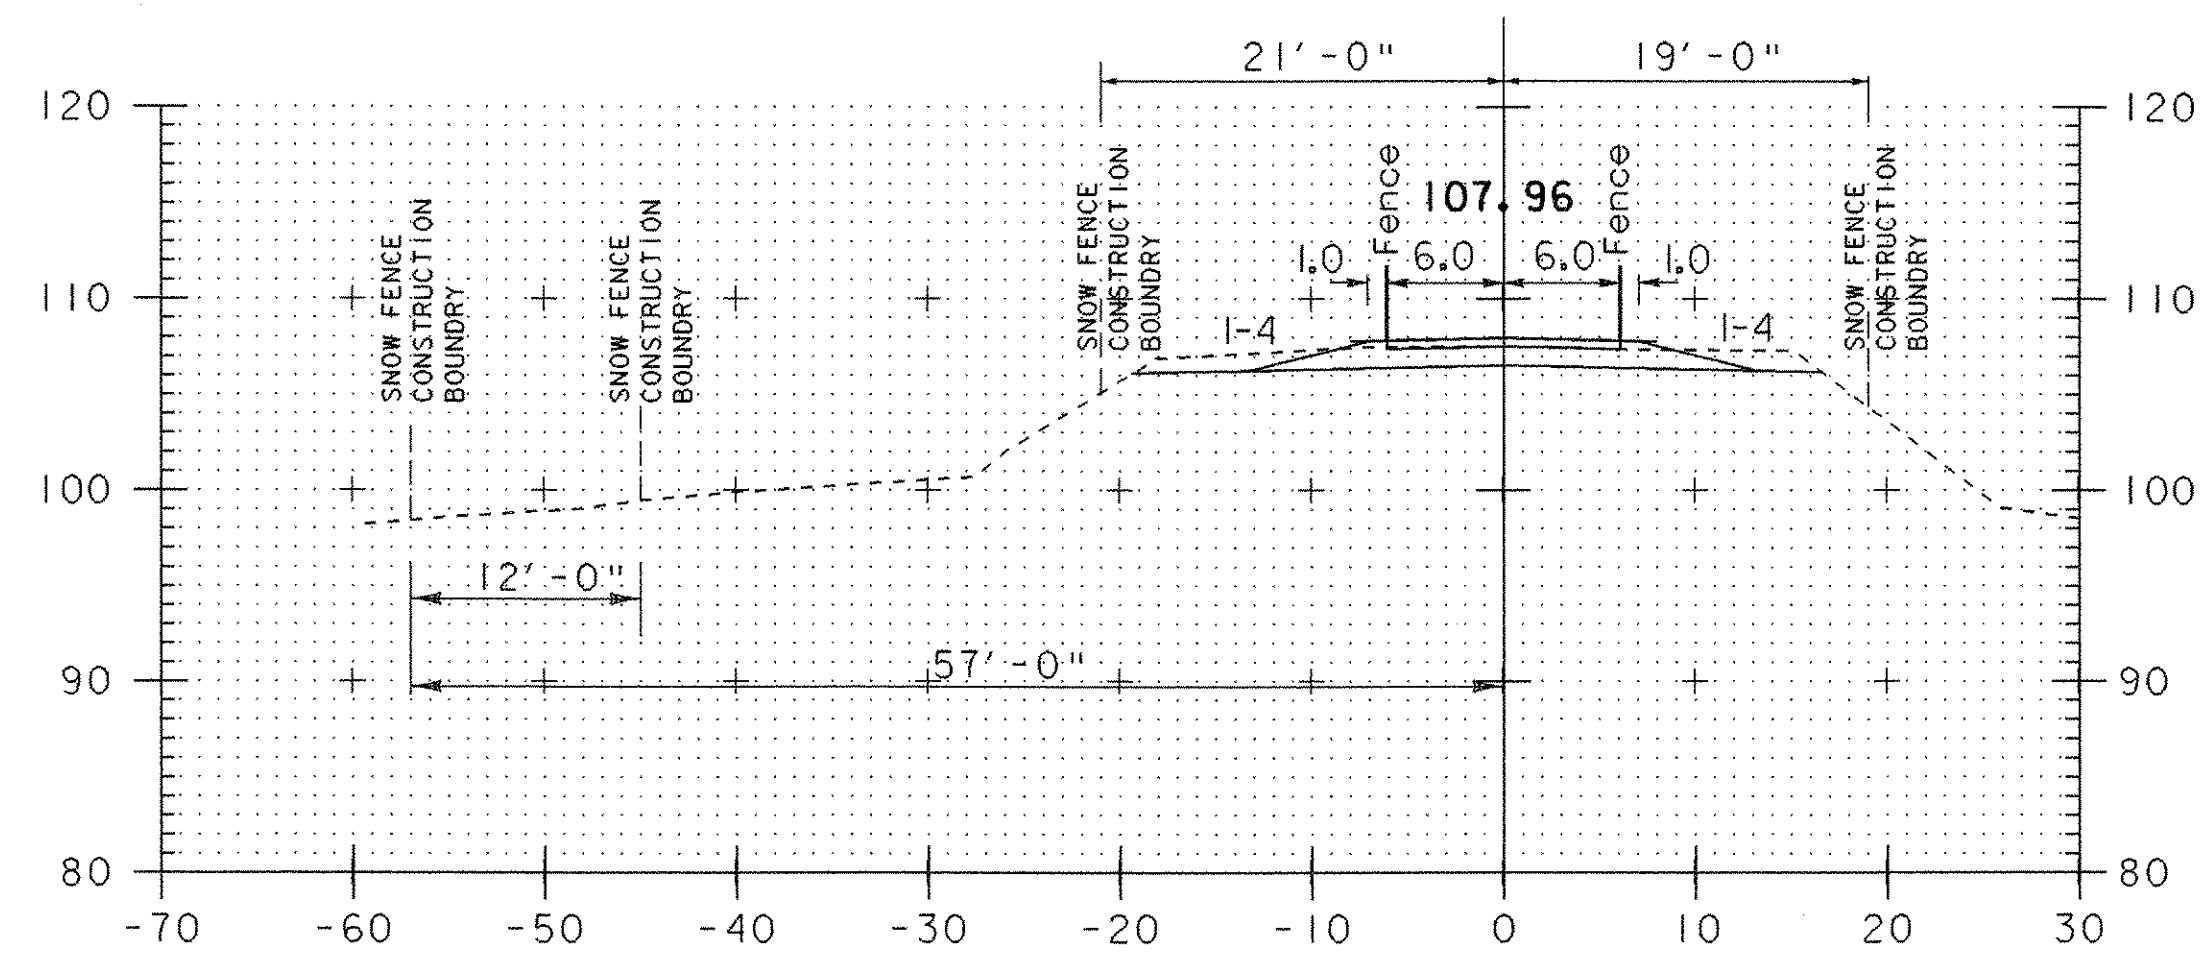

9+70

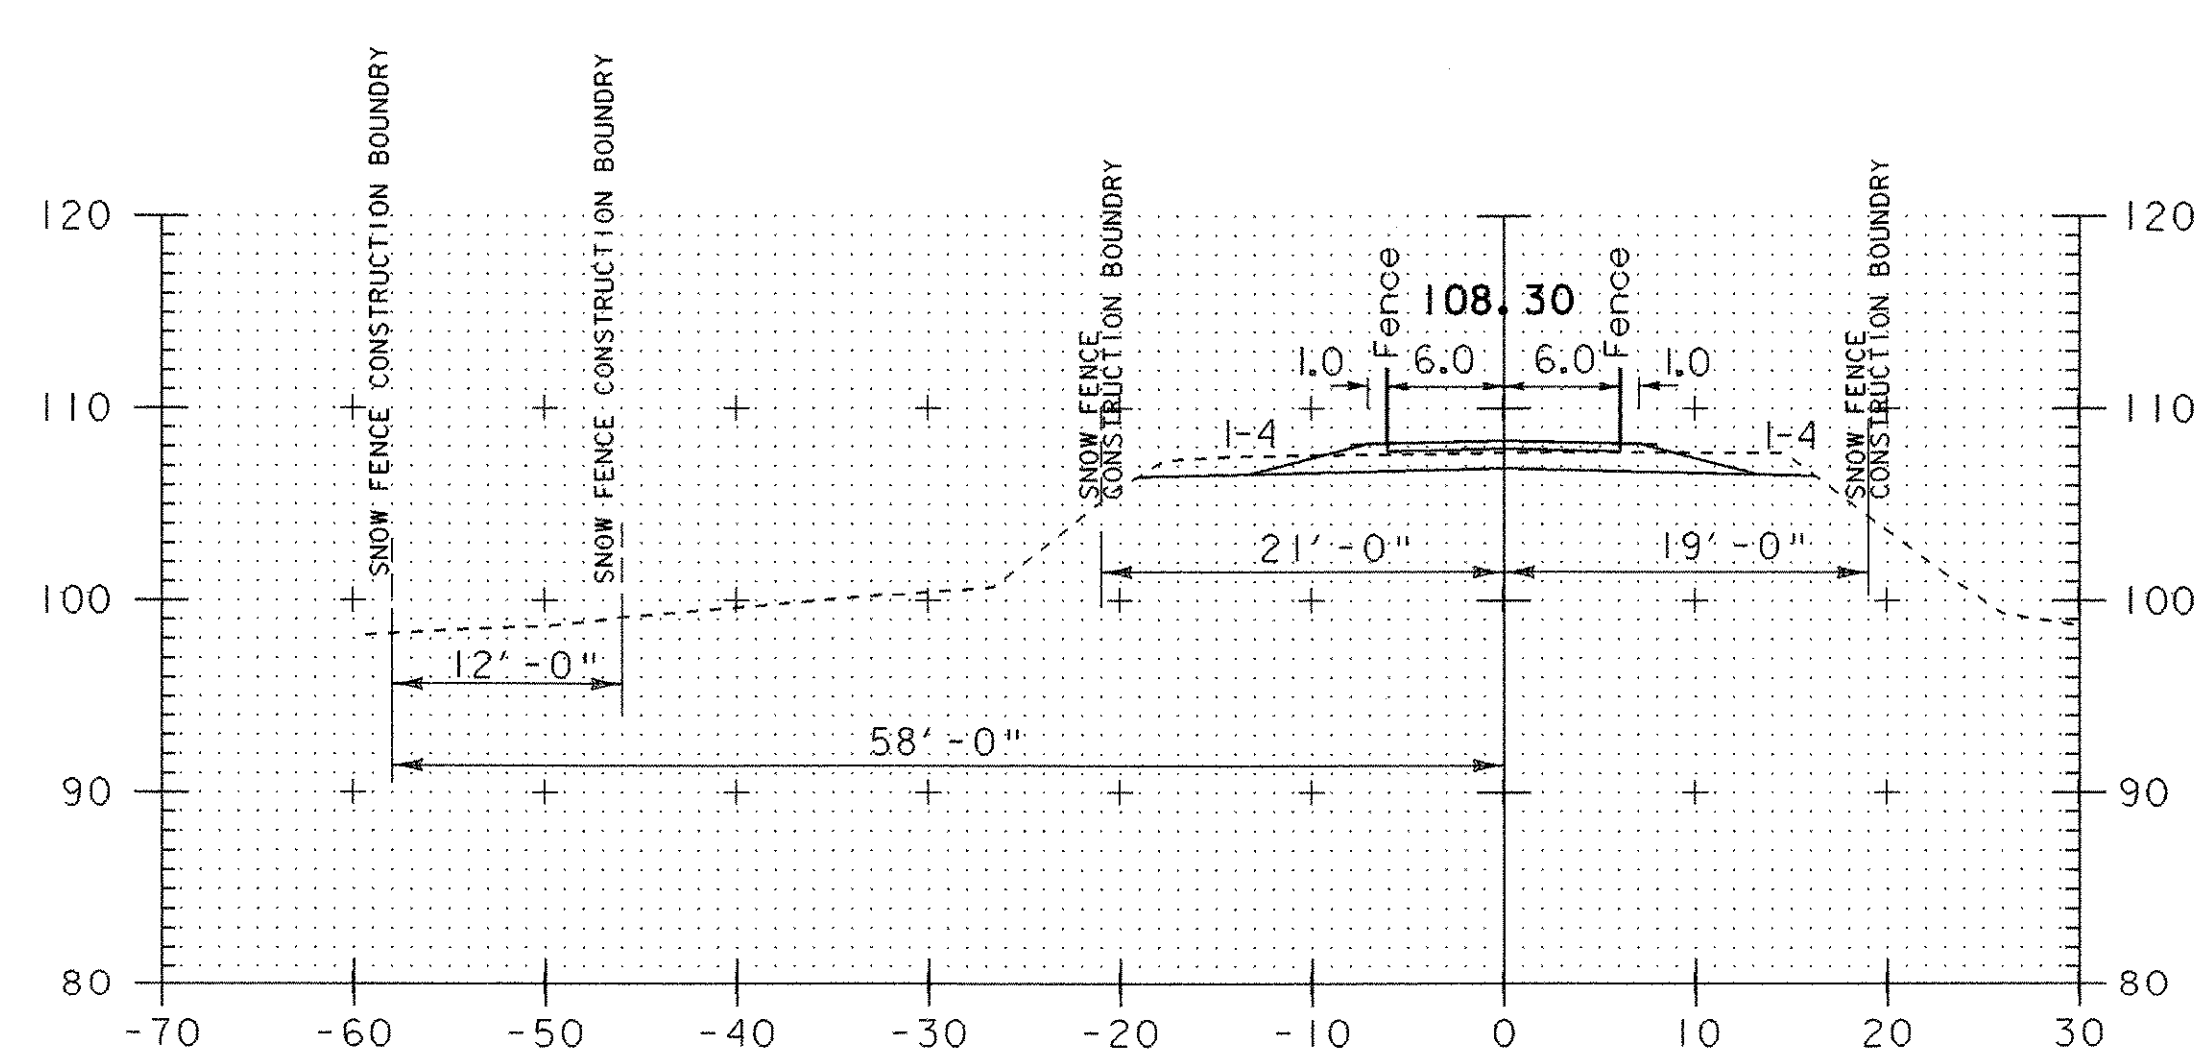

9+60 9+60
End Width Taper
Resume 12' Wide Path

CROSS SECTIONS 9+30 - 9+80

PROJECT NAME: Colchester
PROJECT NUMBER: STP Bike(48)

FILE NAME: str5/03f038/sf038xsl.dgn PLOT DATE: 05-AUG-2003
PROJECT LEADER: C. Keller DRAWN BY: G. Shangraw
DESIGNED BY: G. Shangraw CHECKED BY:
sf038xsl3.1 SHEET 72 OF 87