
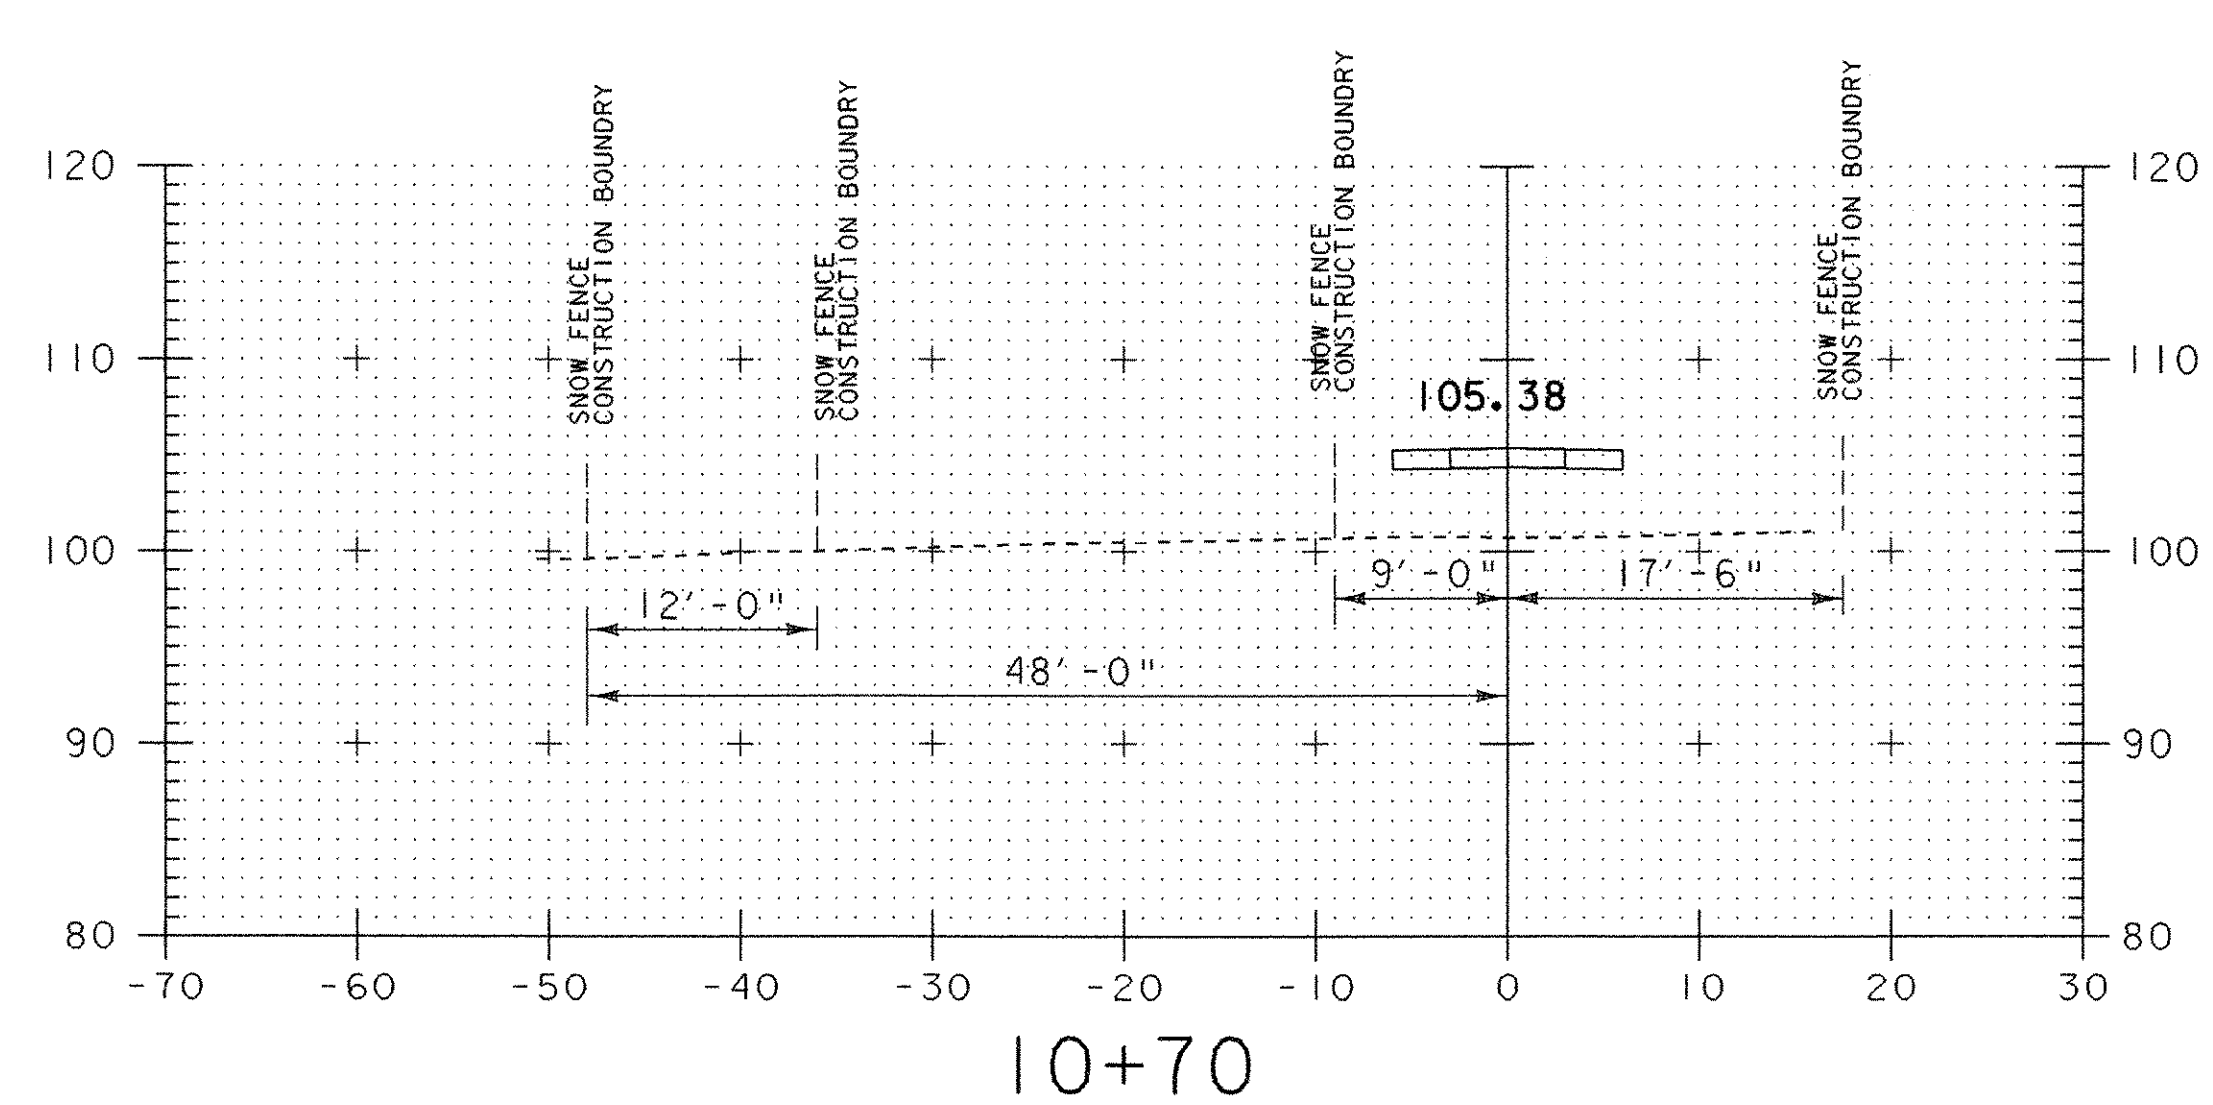
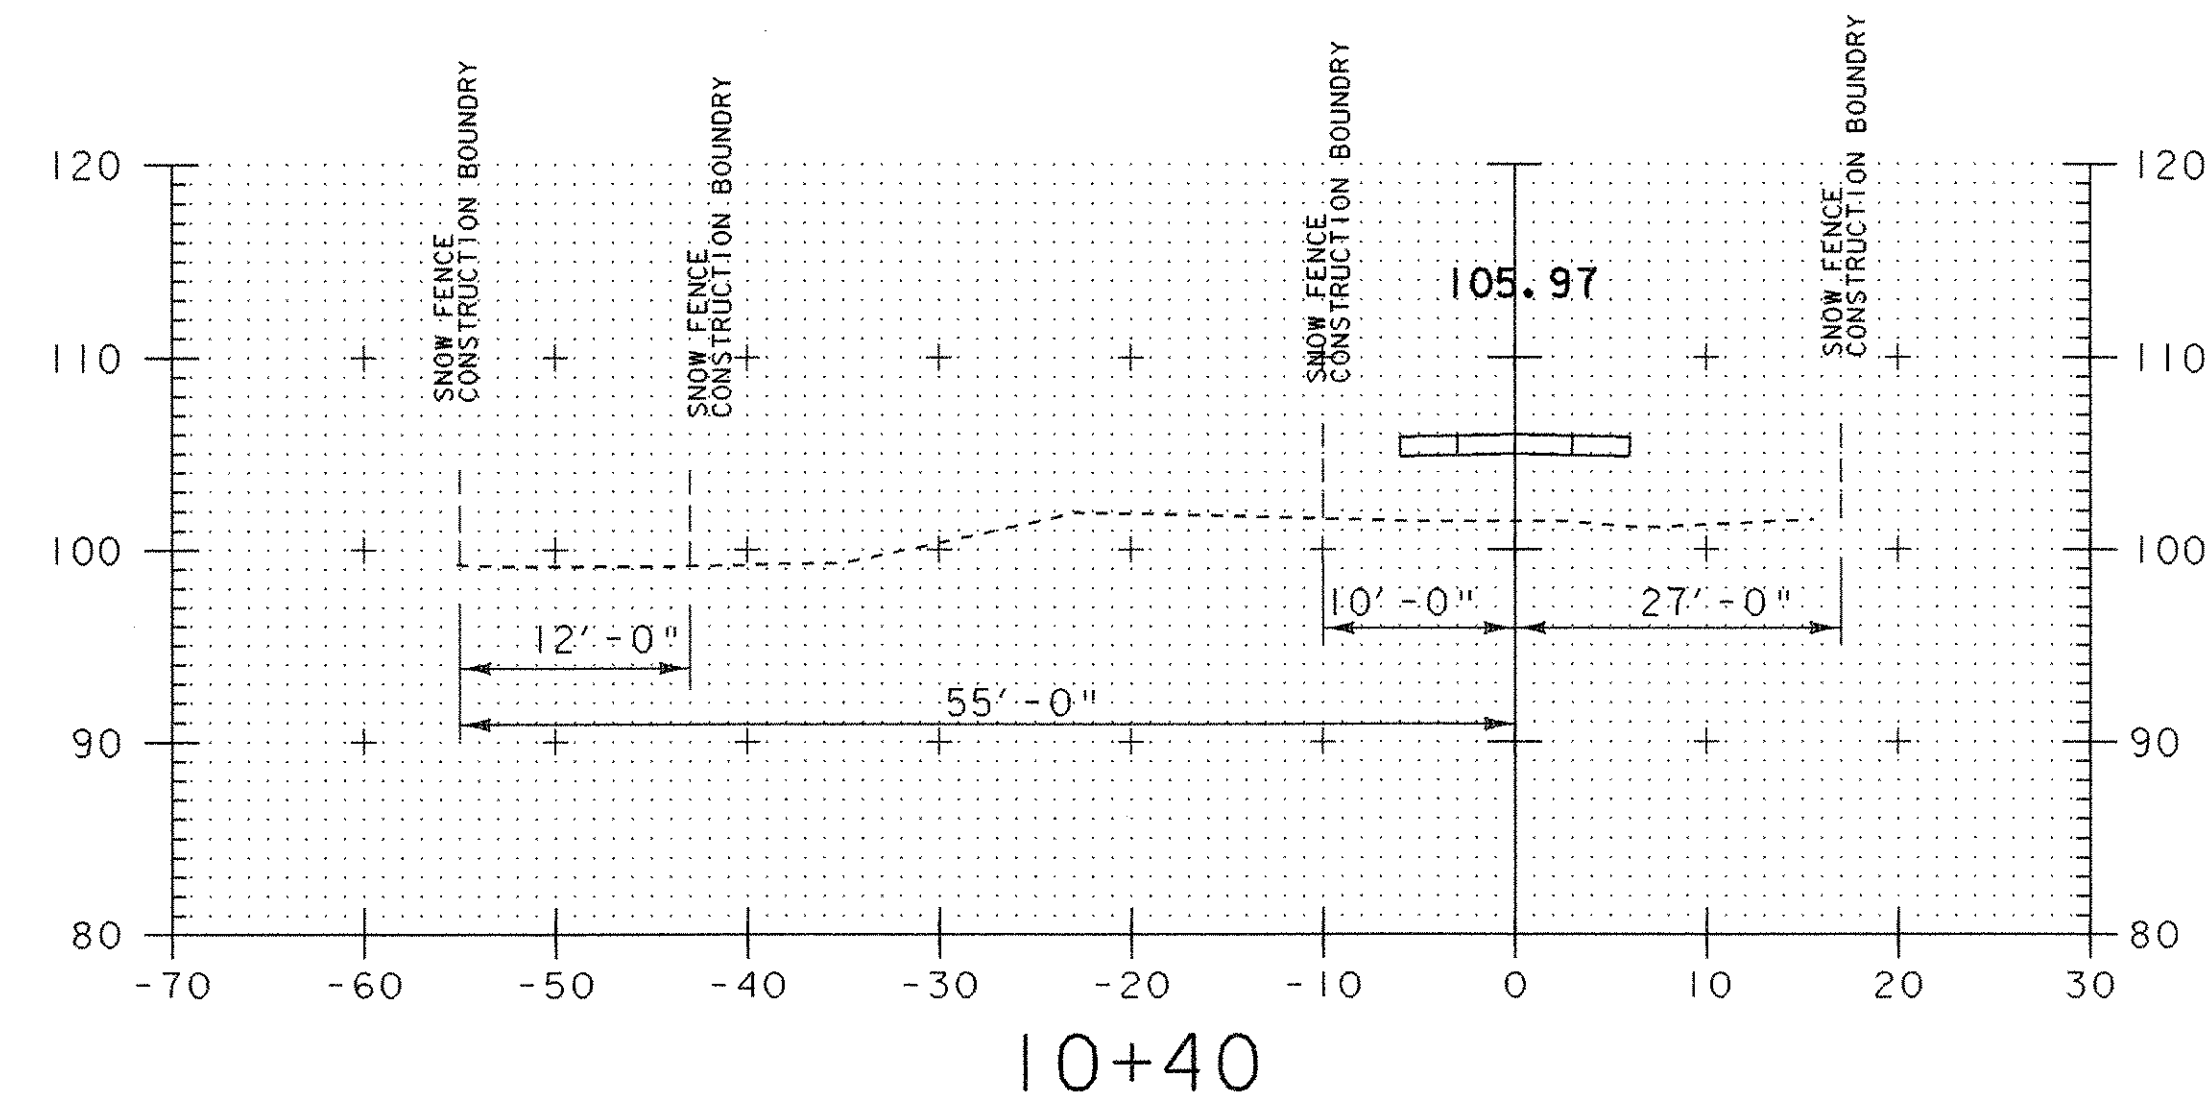
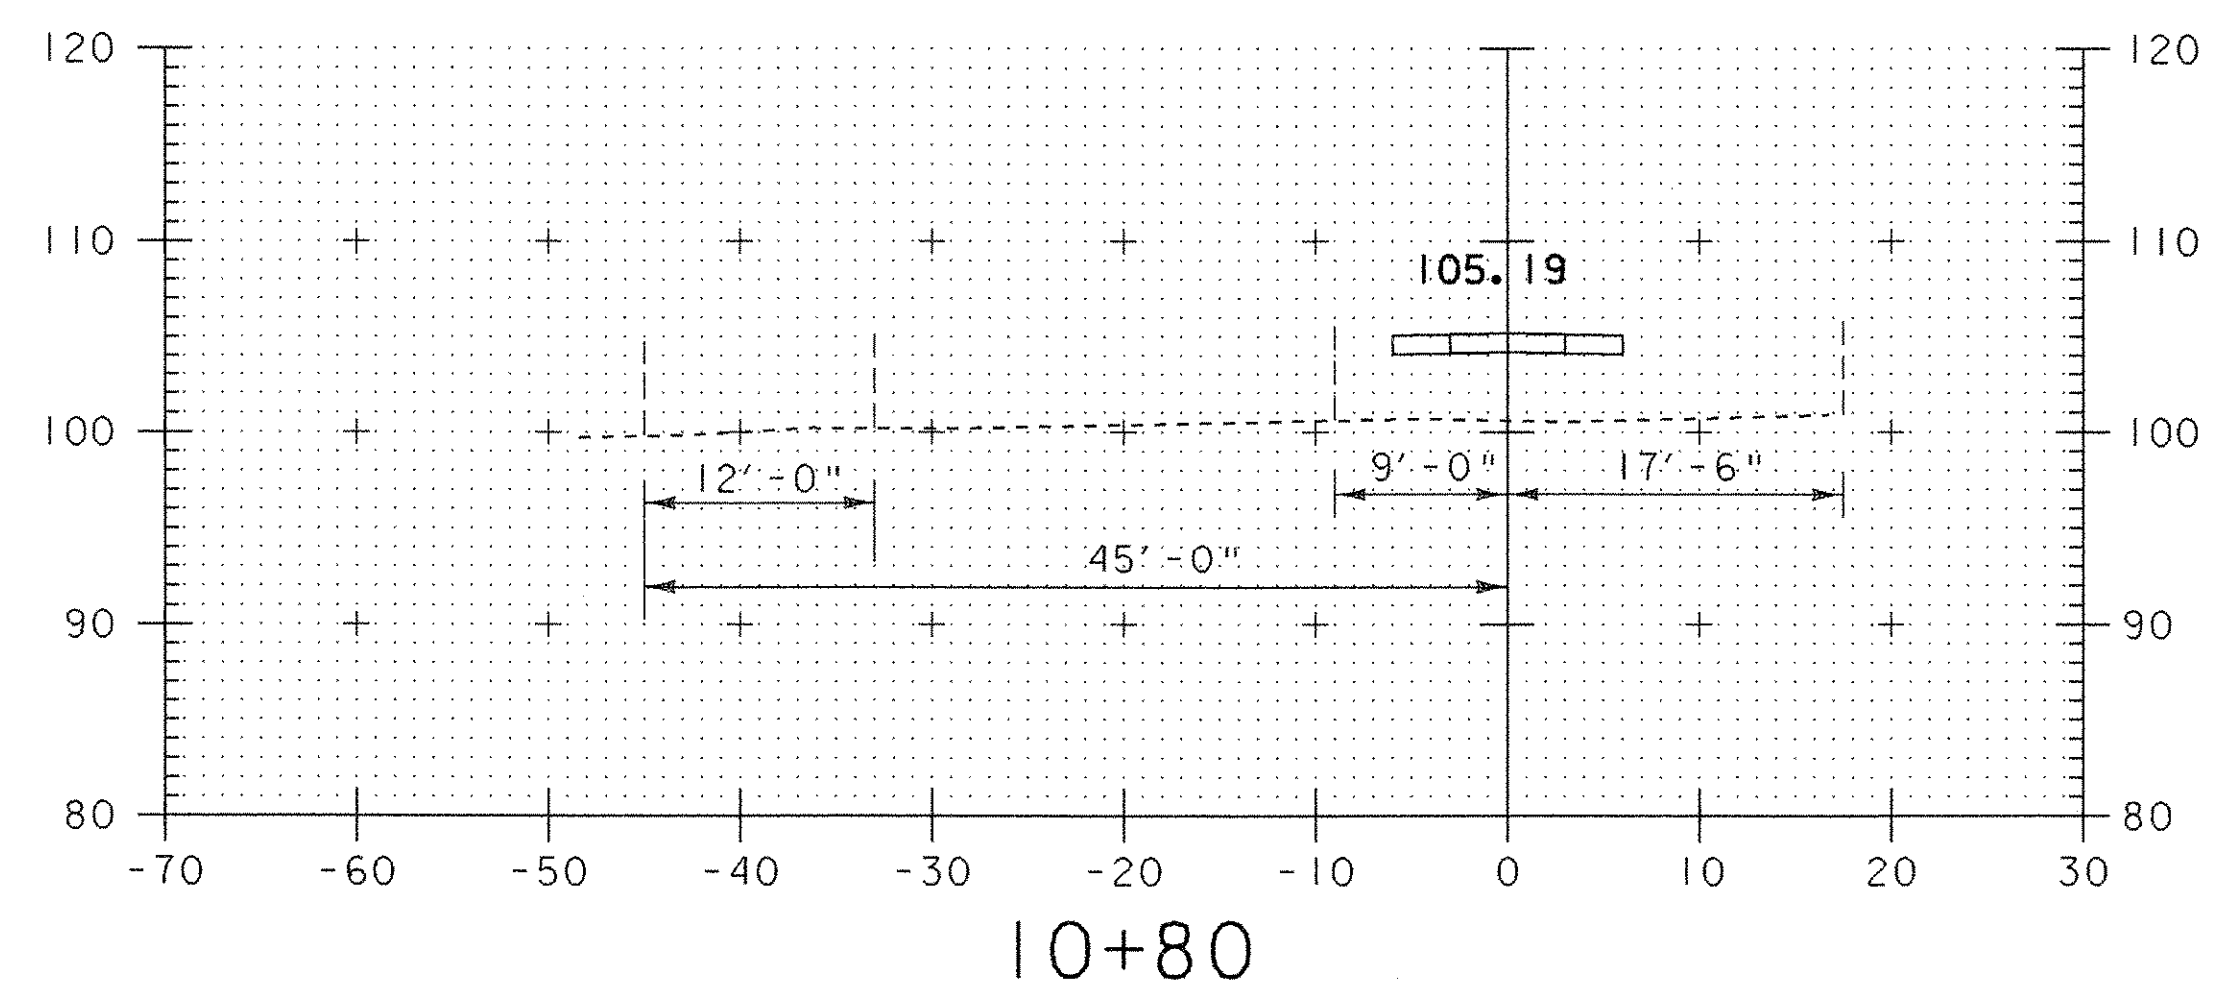
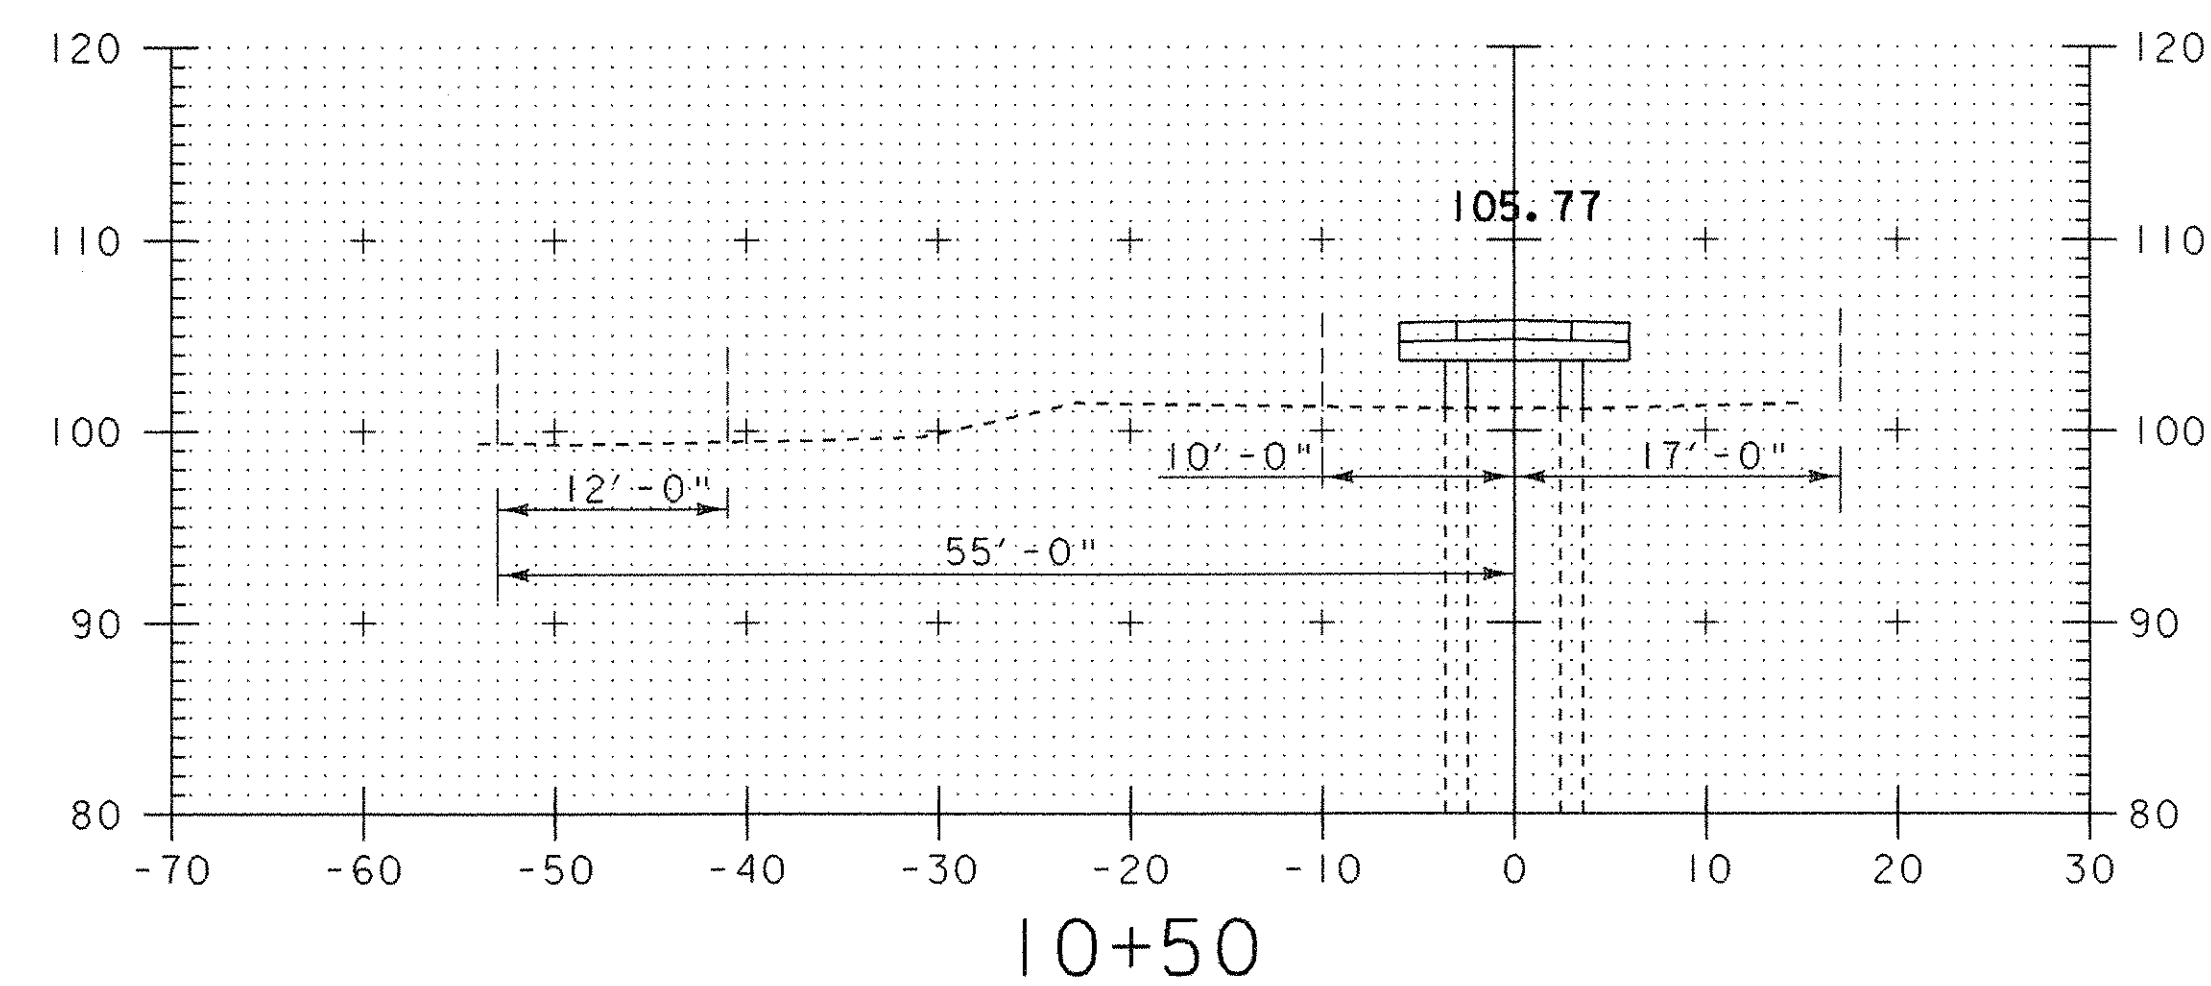
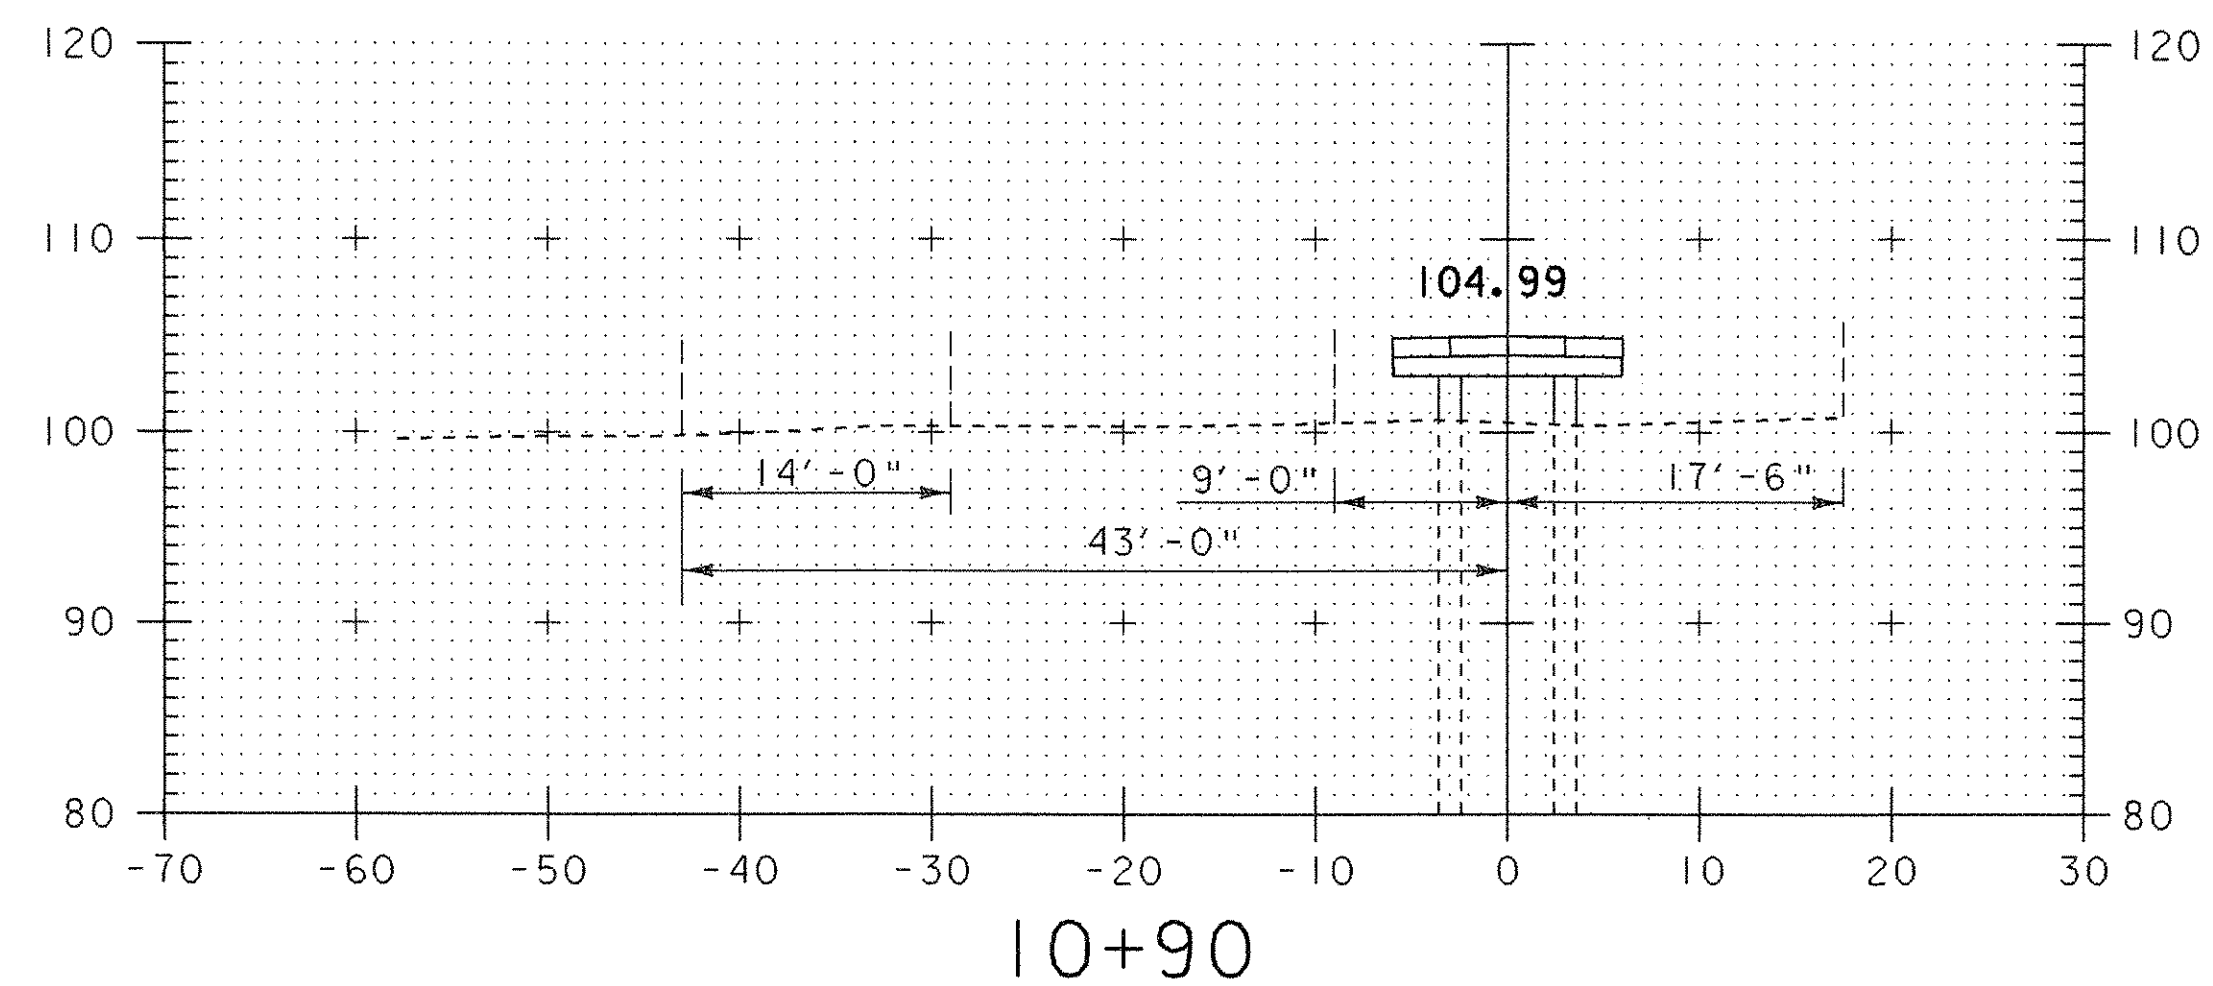


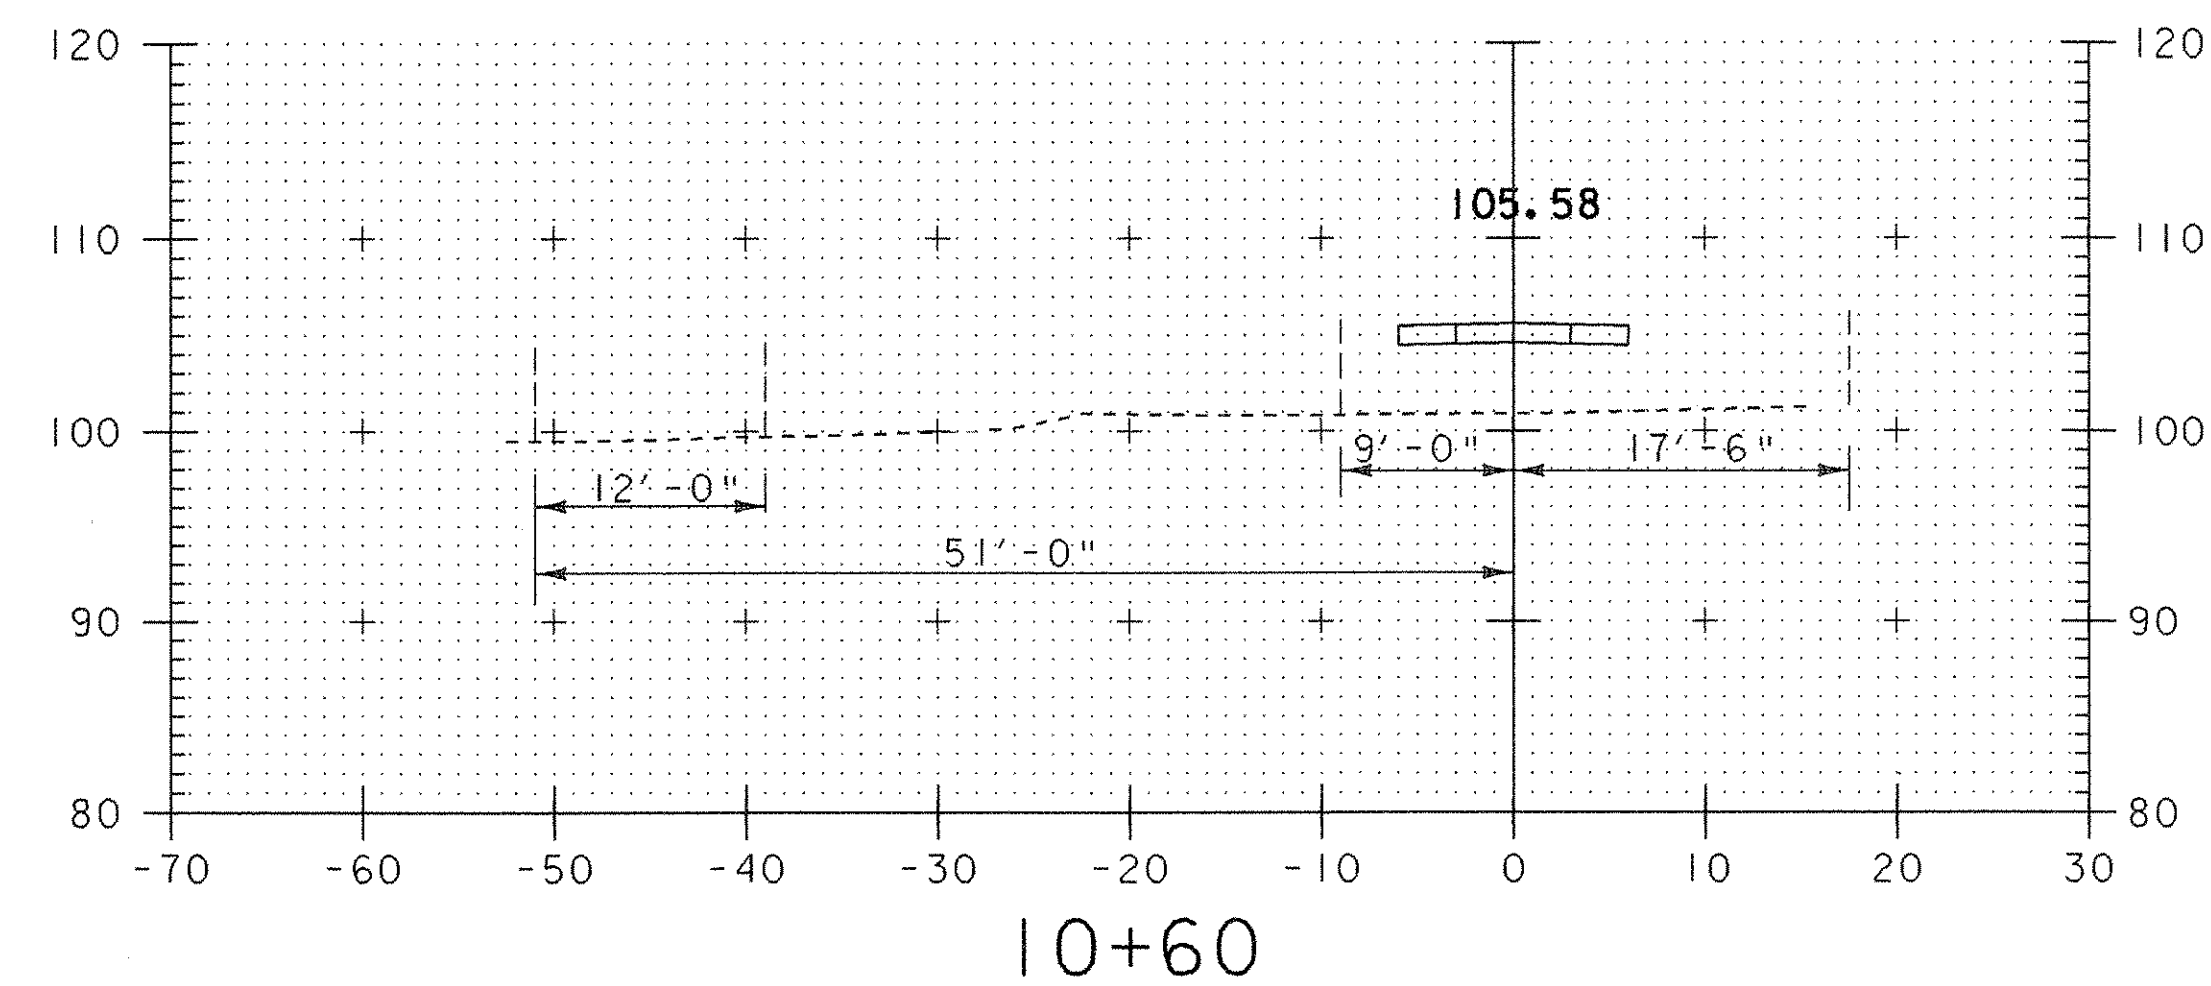

## CROSS SECTIONS 10+40 - 10+90

|                                     |                        |
|-------------------------------------|------------------------|
| PROJECT NAME:                       | Colchester             |
| PROJECT NUMBER:                     | STP Bike(48)           |
| FILE NAME: str5/03f038/sf038xsl.dgn | PLOT DATE: 05-AUG-2003 |
| PROJECT LEADER: C. Keller           | DRAWN BY: G. Shangraw  |
| DESIGNED BY: G. Shangraw            | CHECKED BY:            |
| sf038xs5.i                          | SHEET 74 OF 87         |