
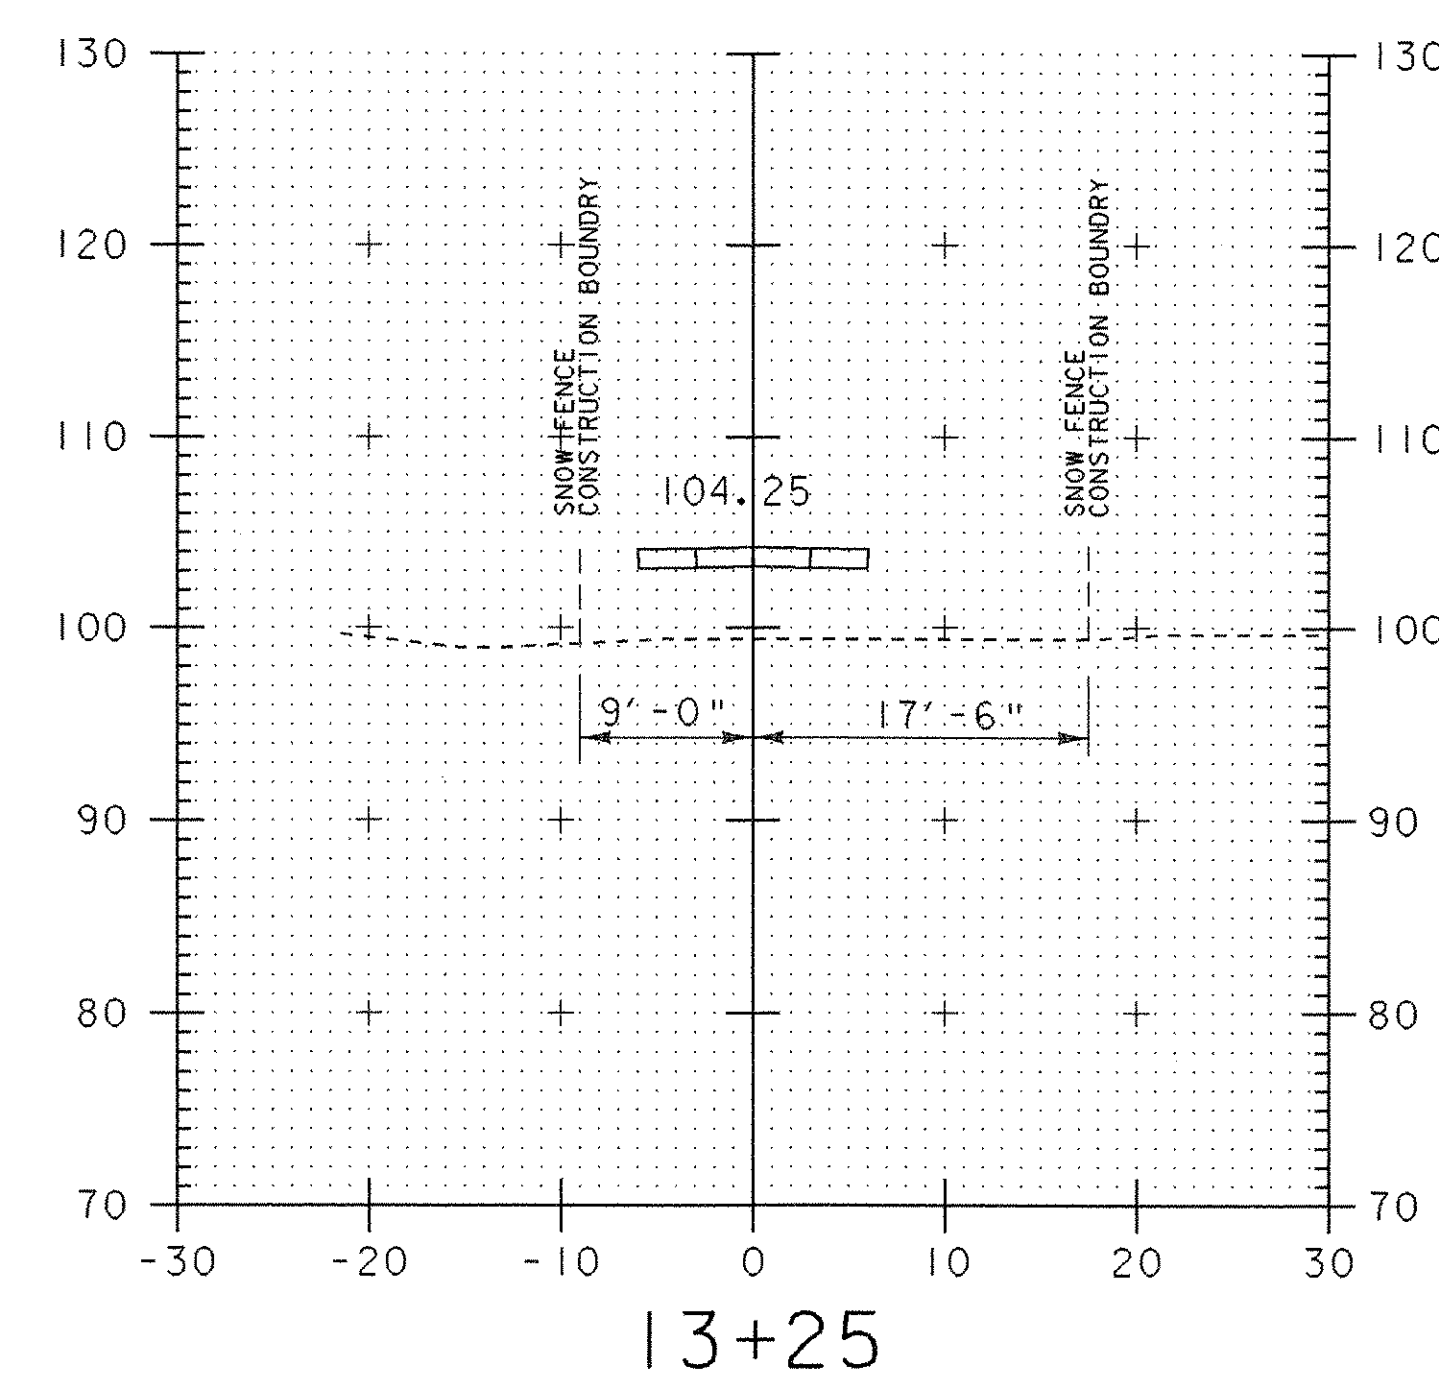
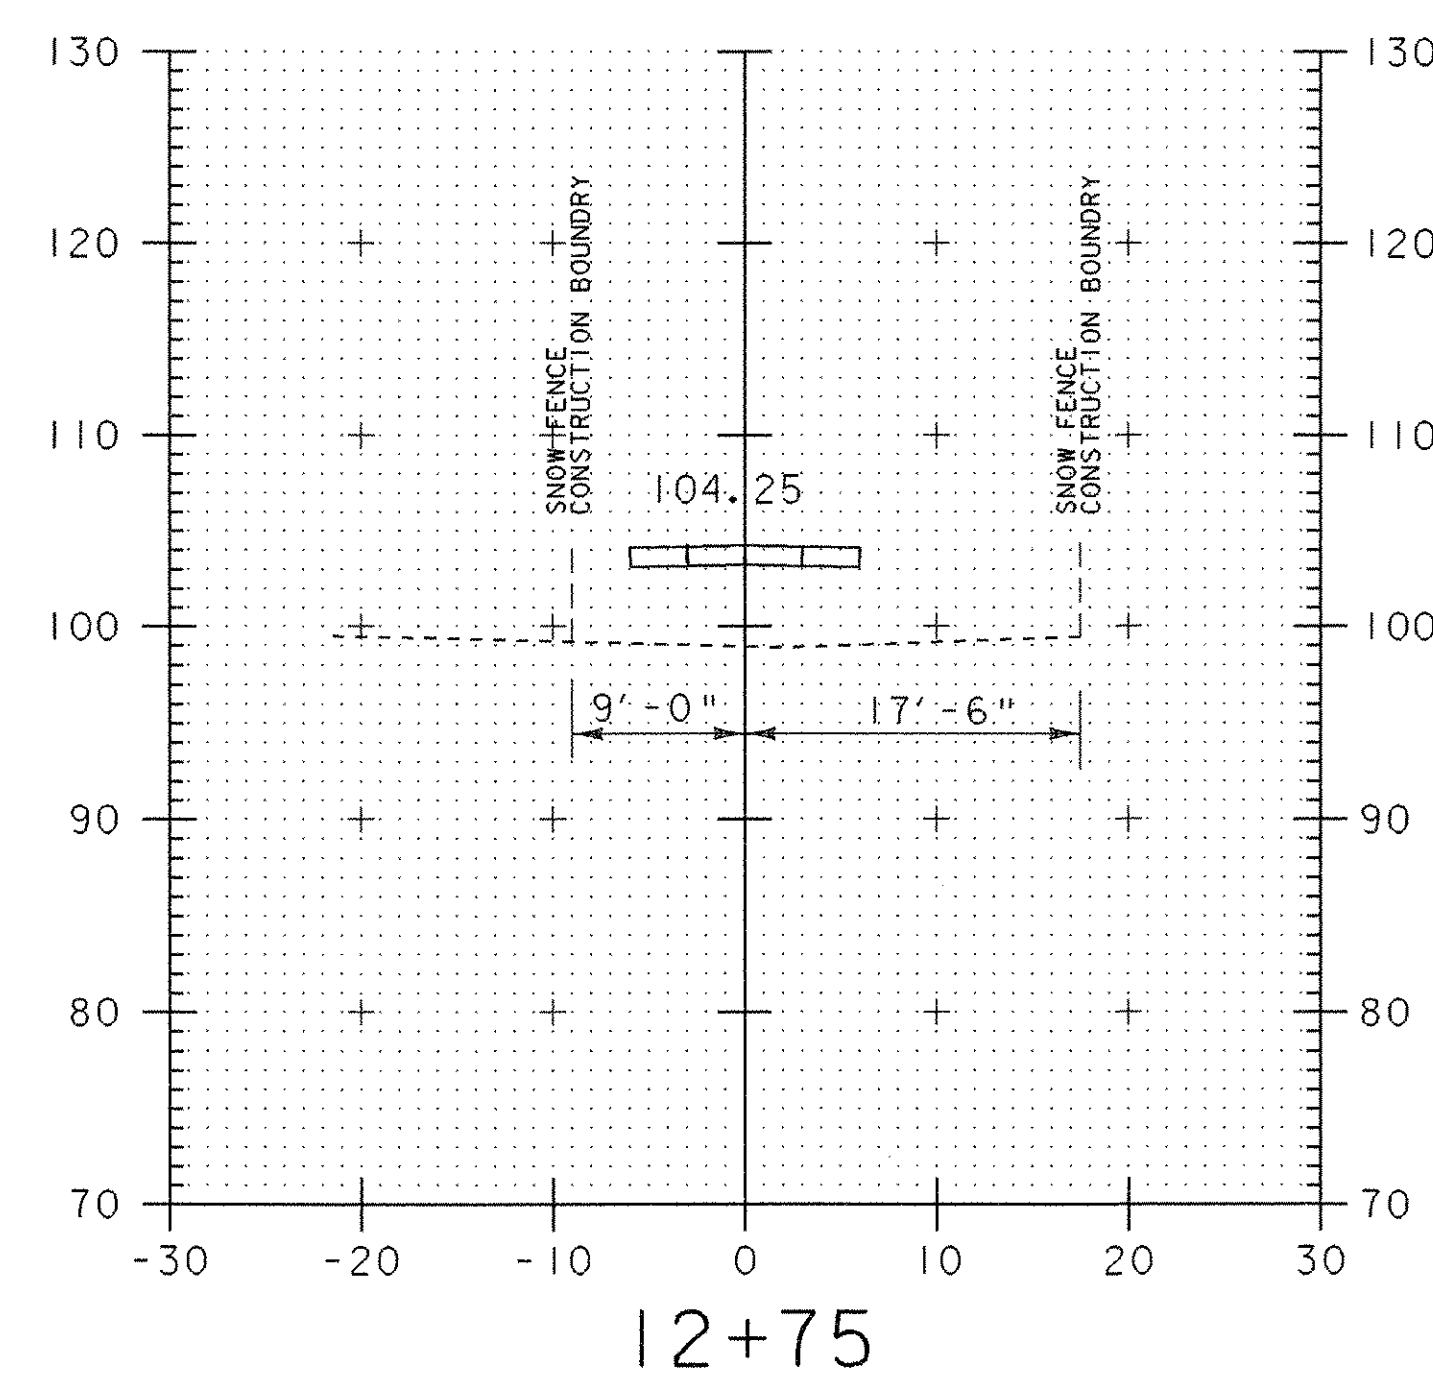
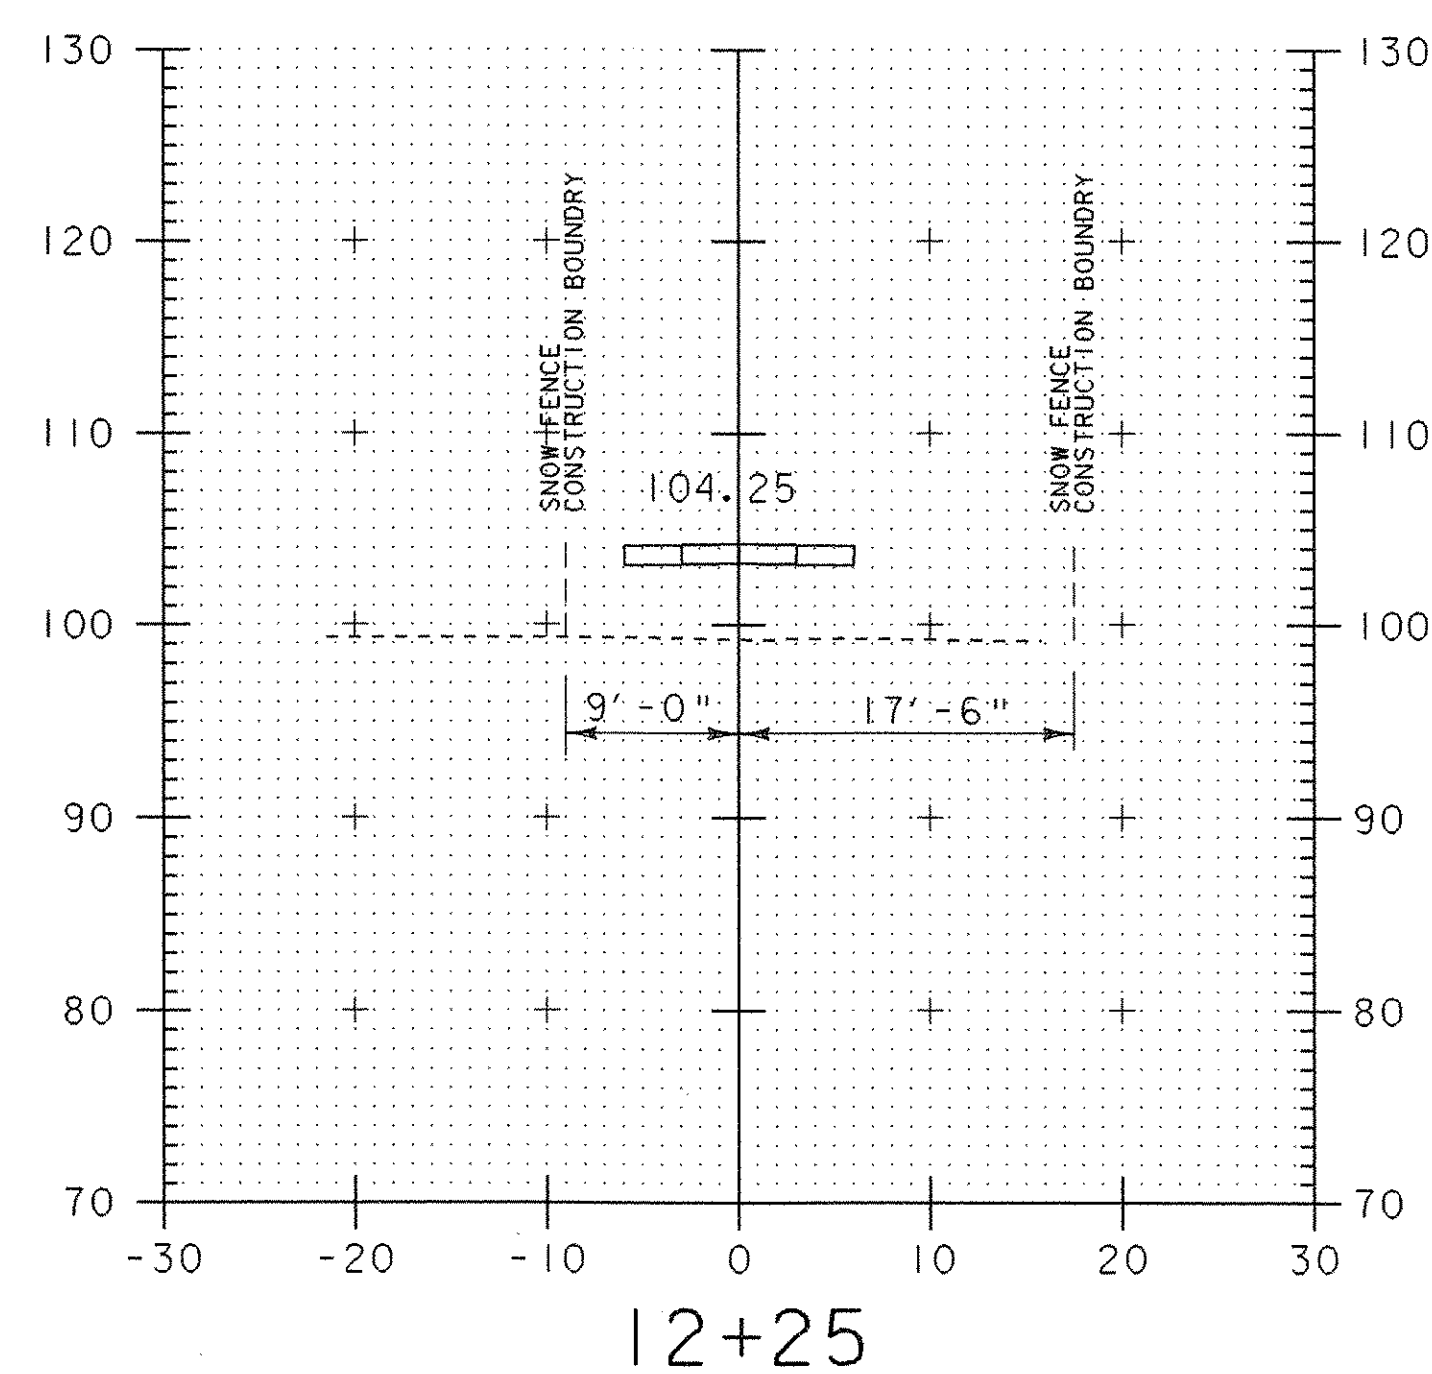
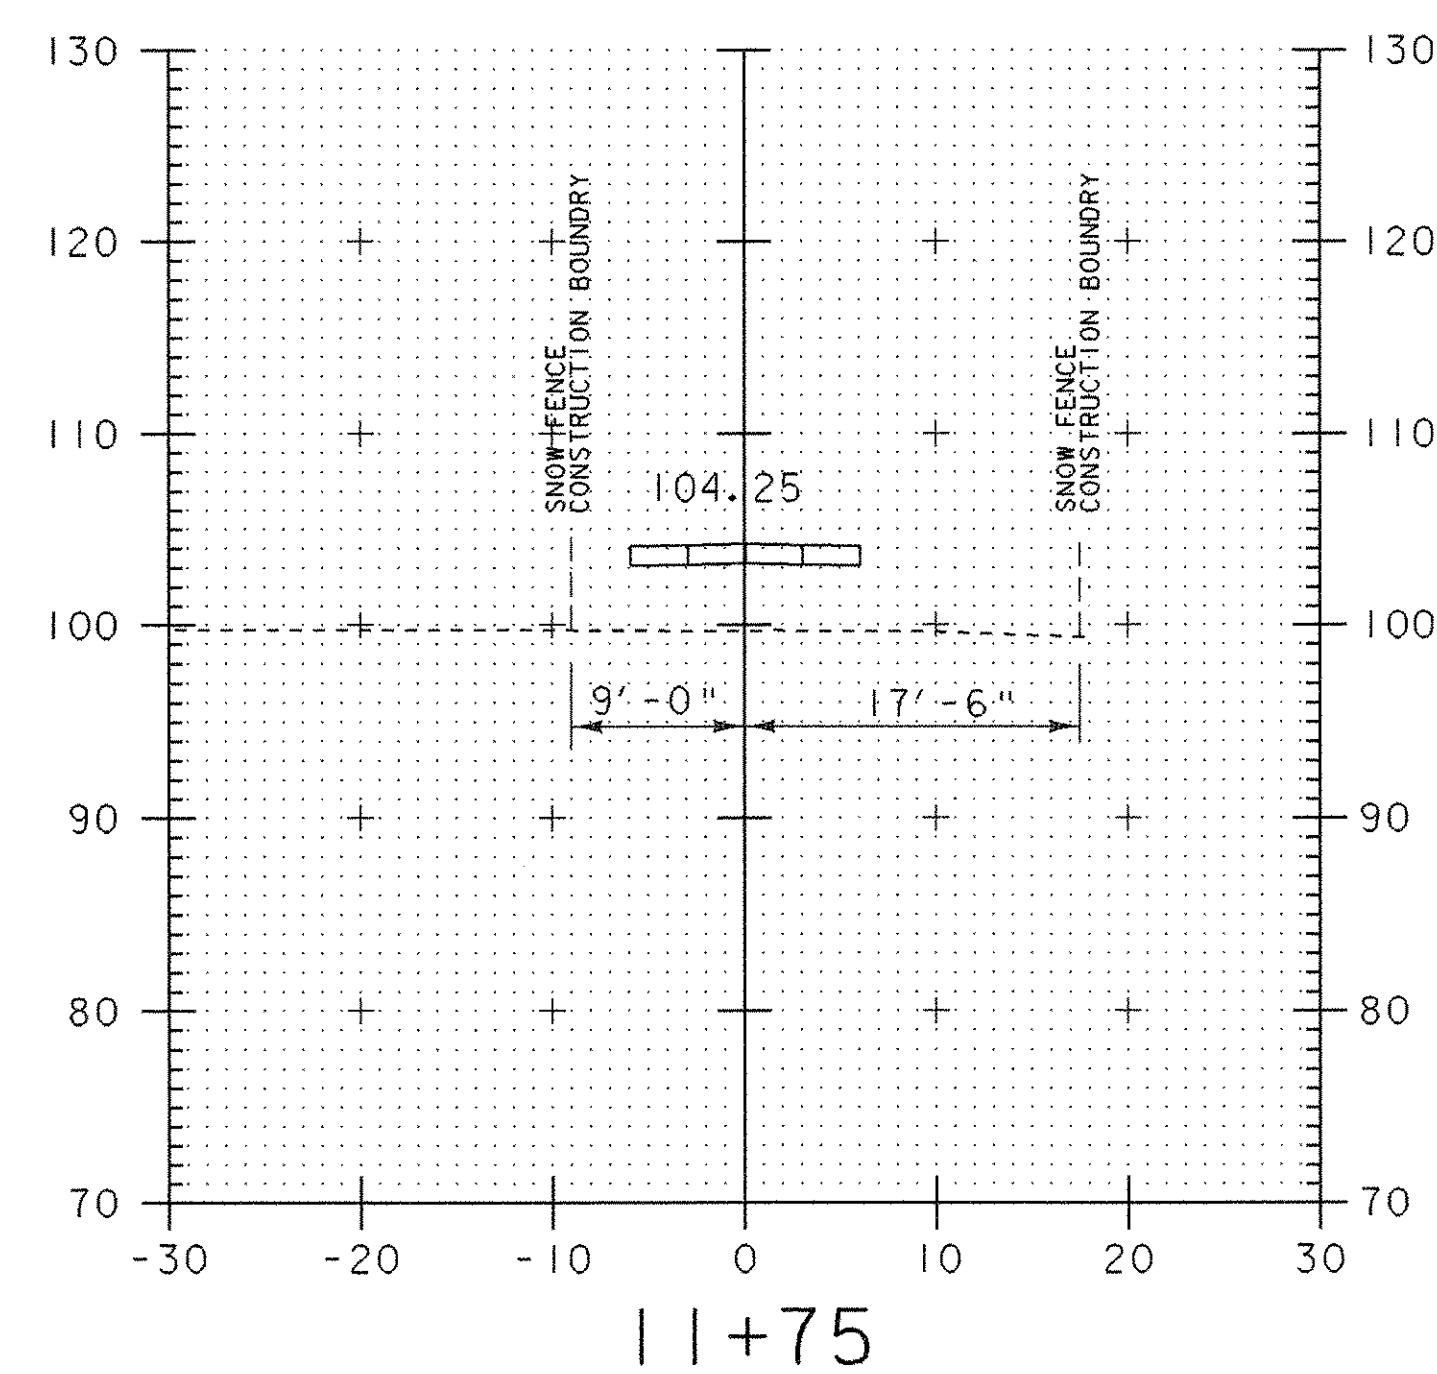
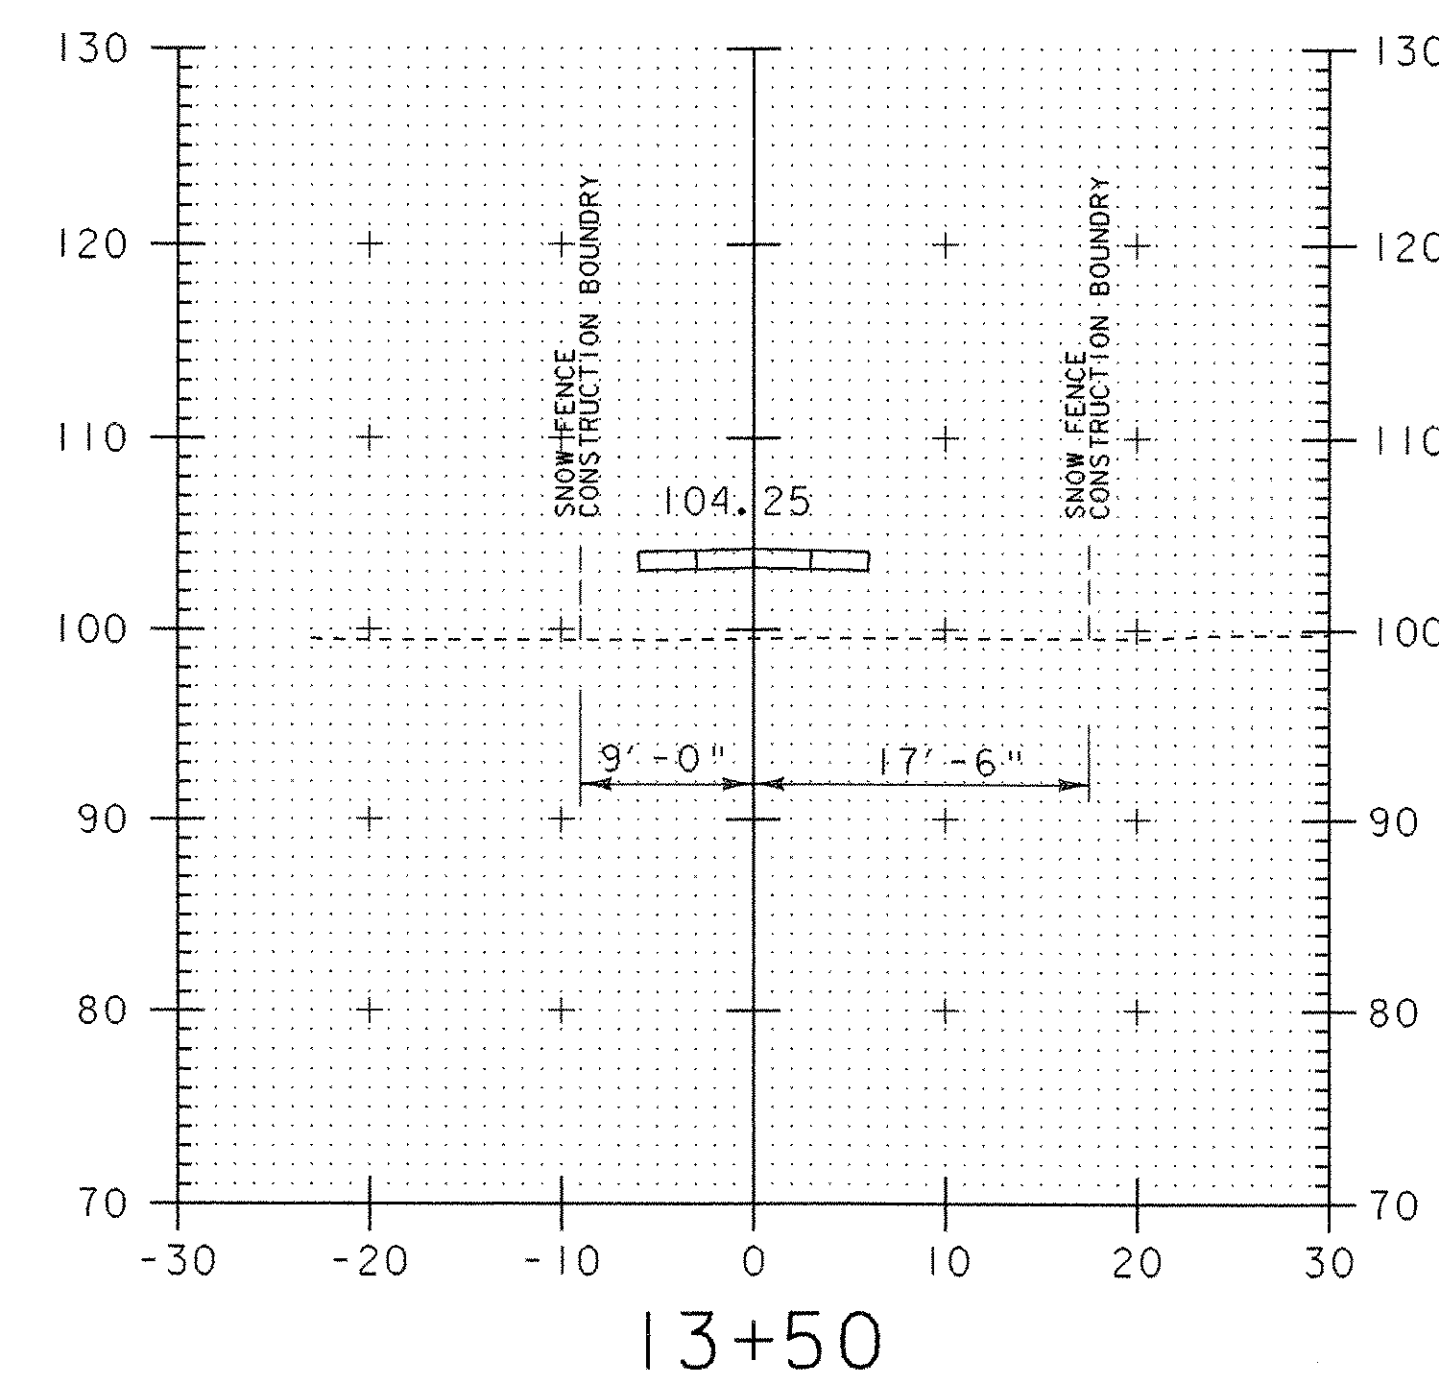
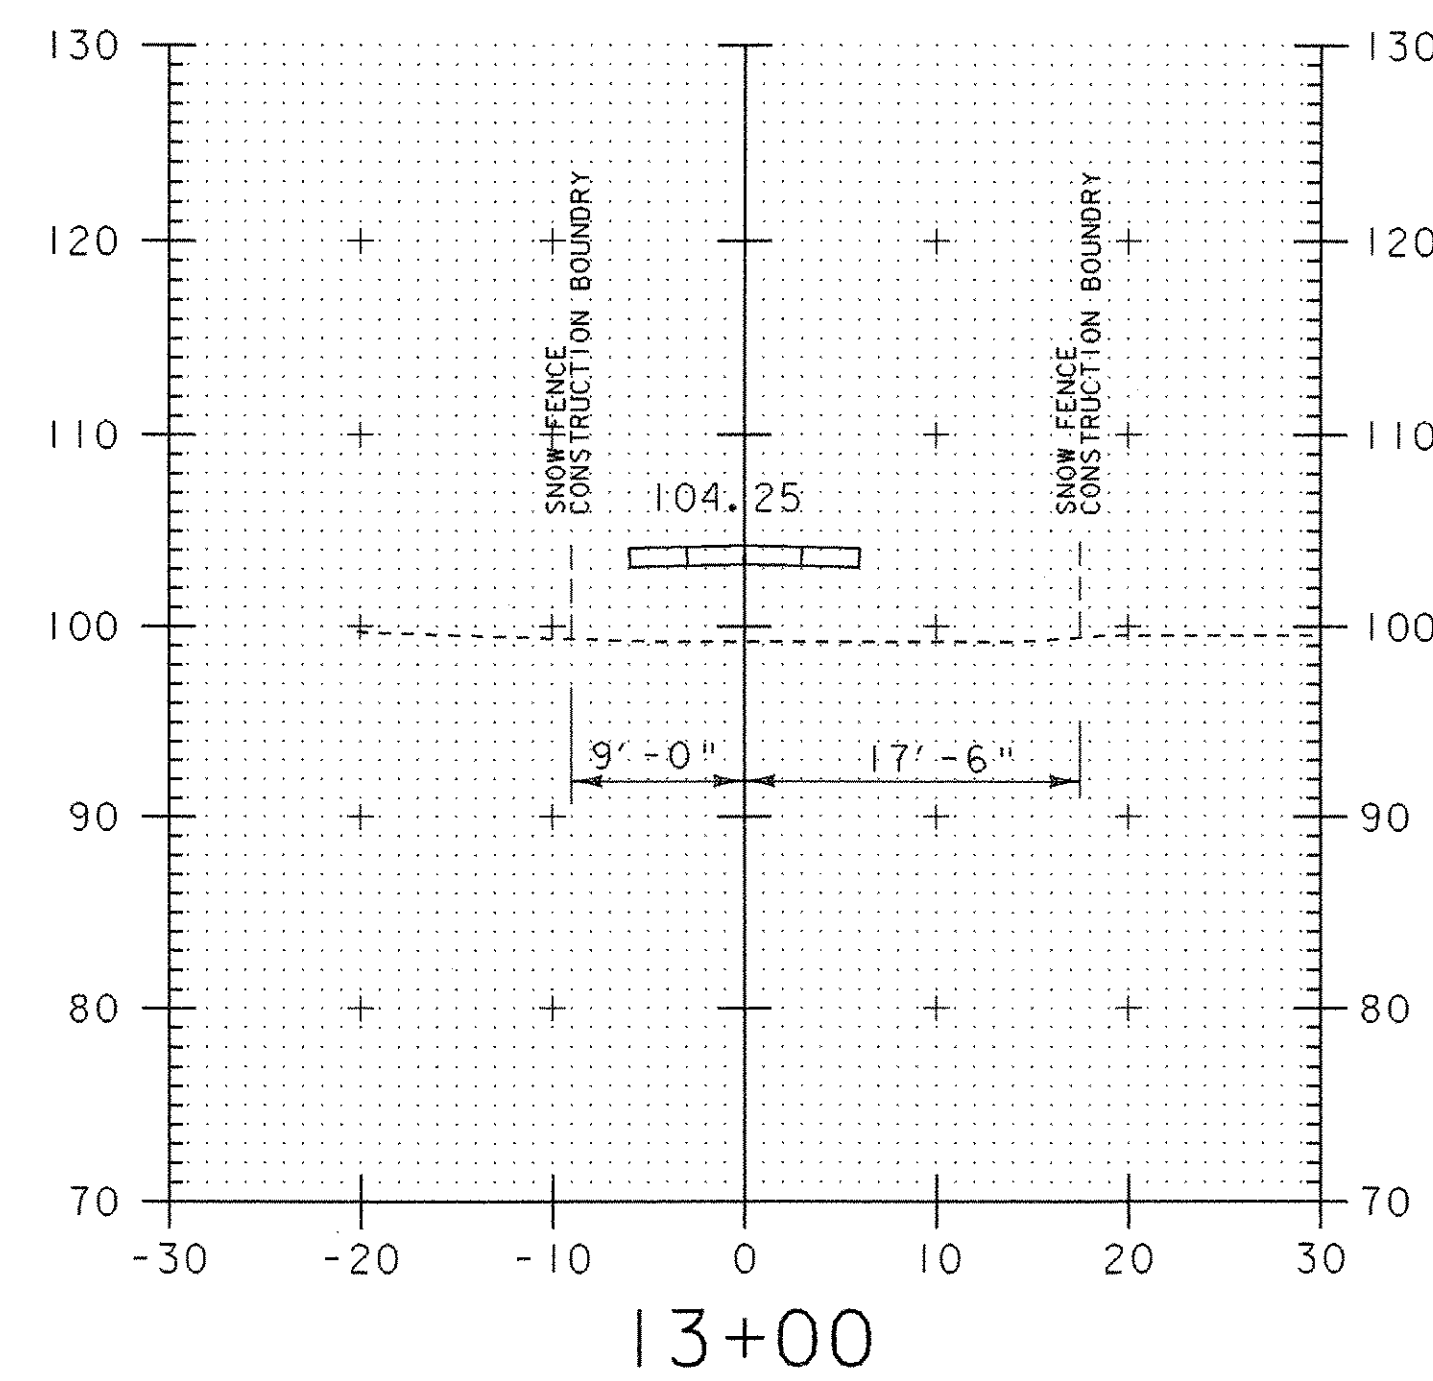
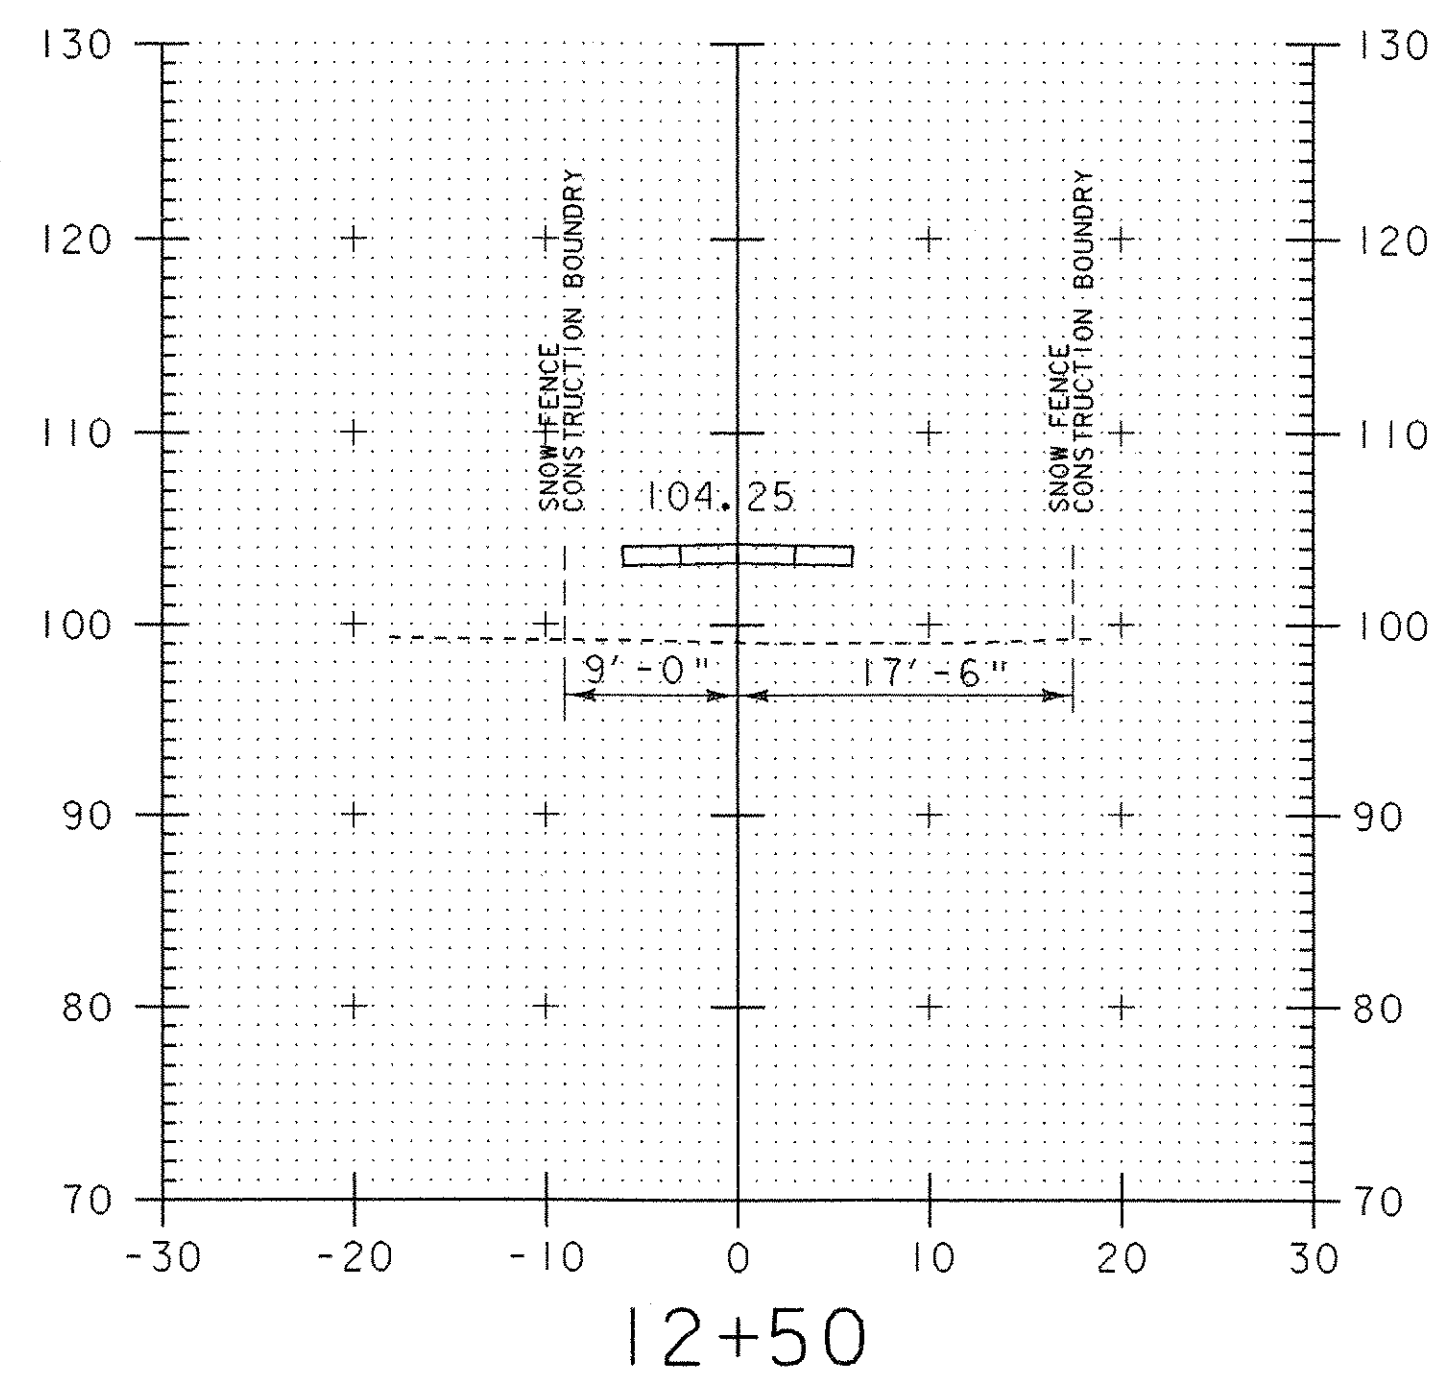


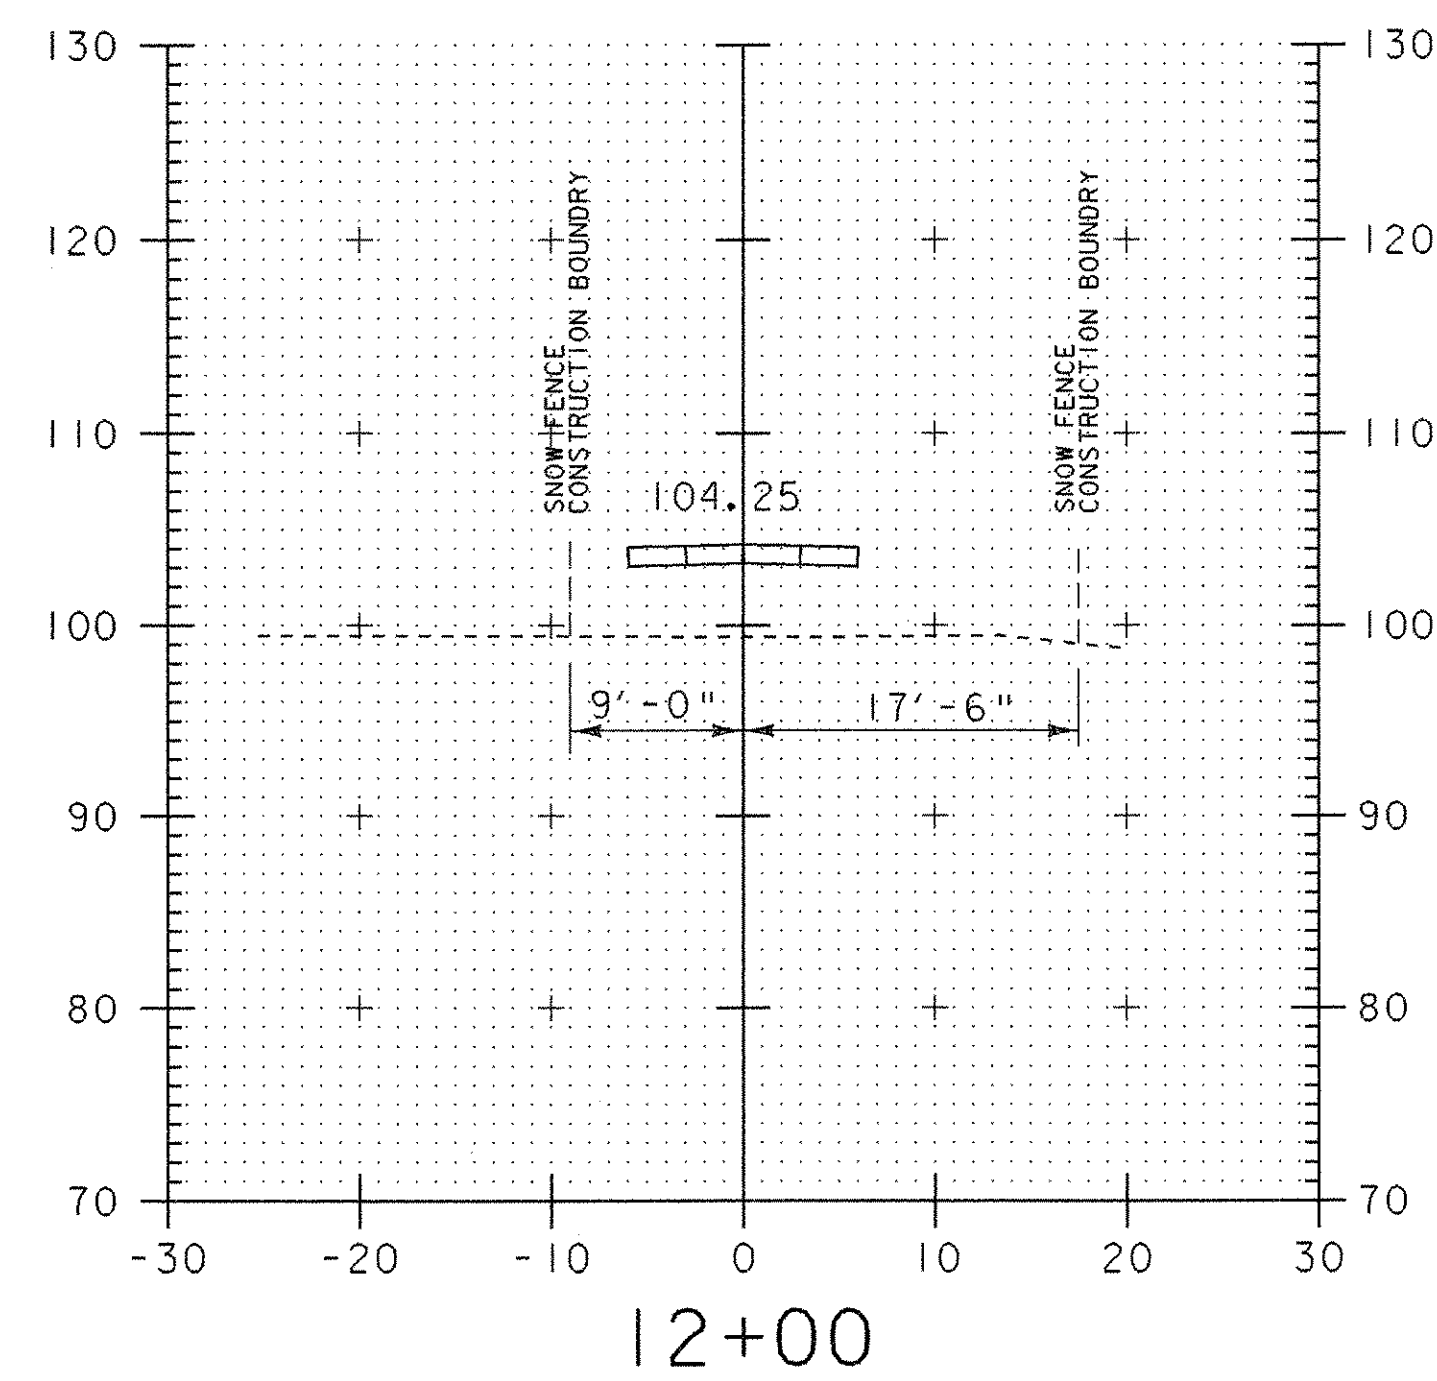

CROSS SECTIONS 11+75 - 13+50

PROJECT NAME:	Colchester
PROJECT NUMBER:	STP Bike(48)
FILE NAME: str5/03f038/sf038xsl.dgn	PLOT DATE: 05-AUG-2003
PROJECT LEADER: C. Keller	DRAWN BY: G. Shangraw
DESIGNED BY: G. Shangraw	CHECKED BY:
sf038xsl	SHEET 76 OF 87