
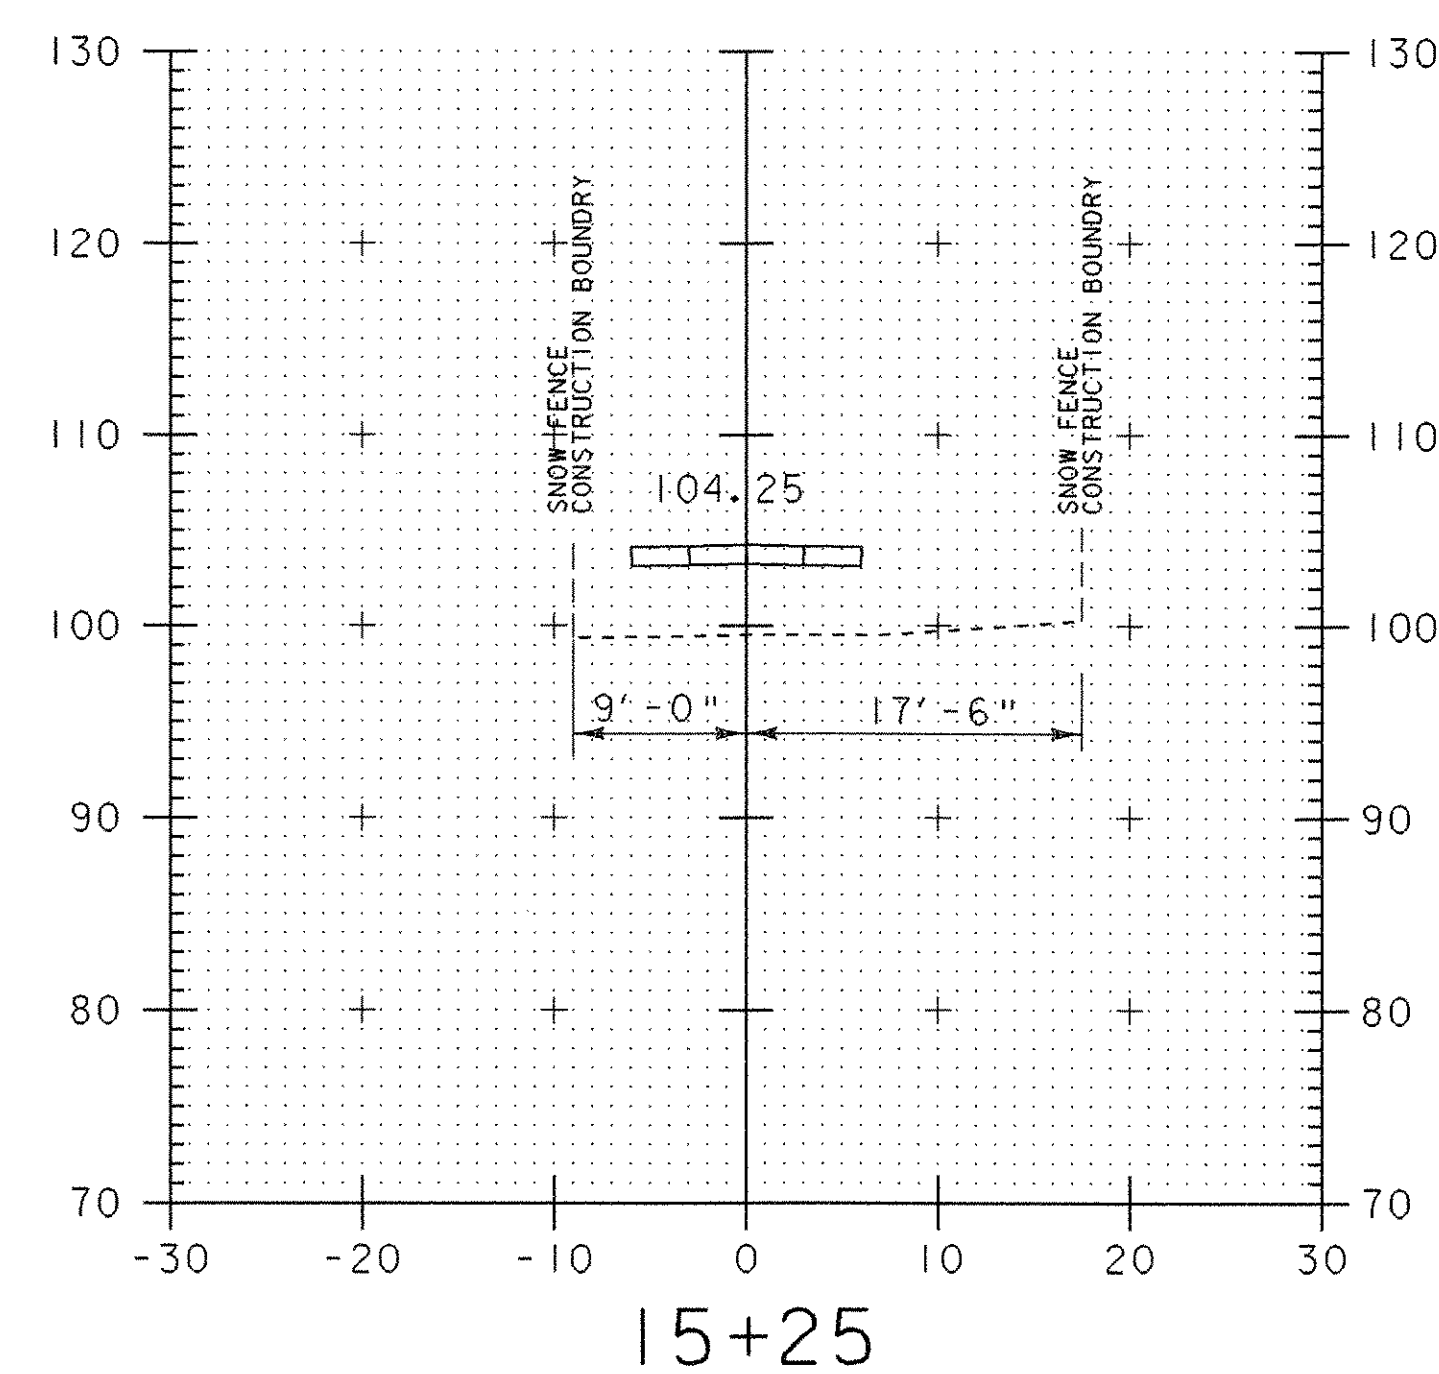
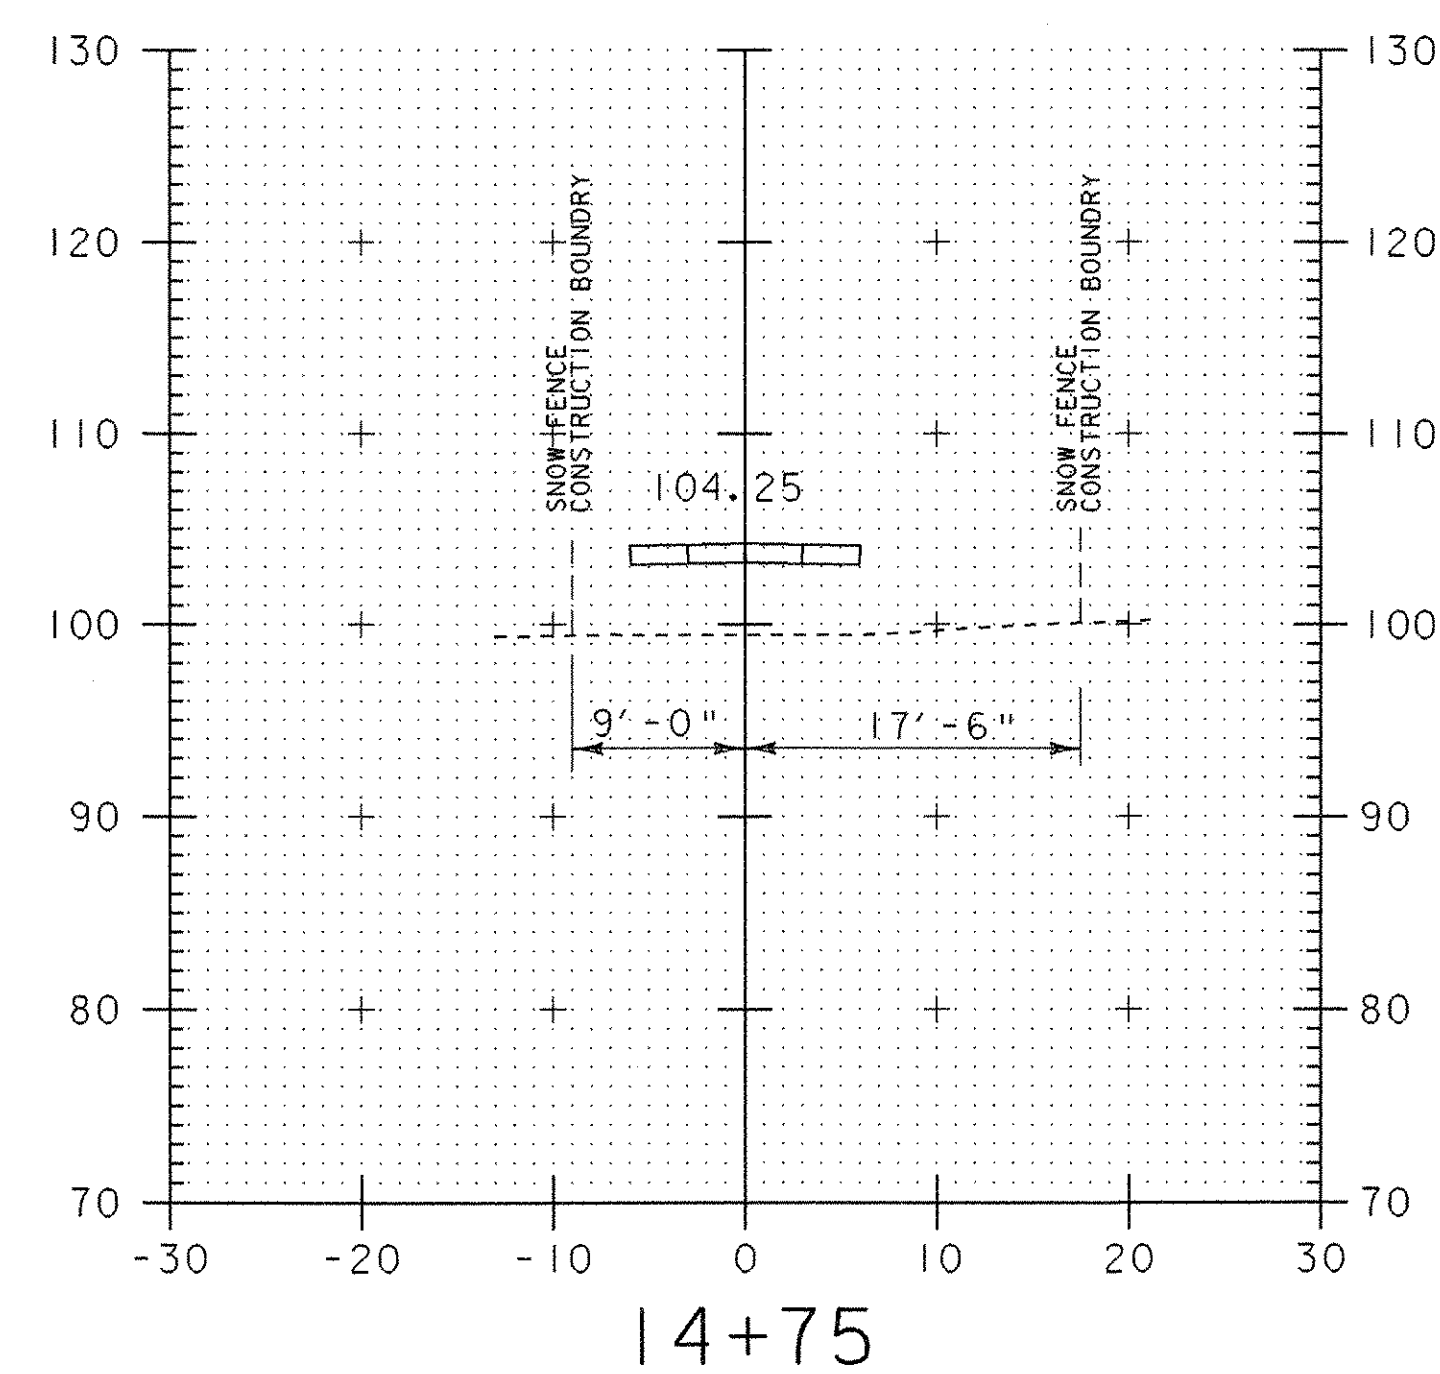
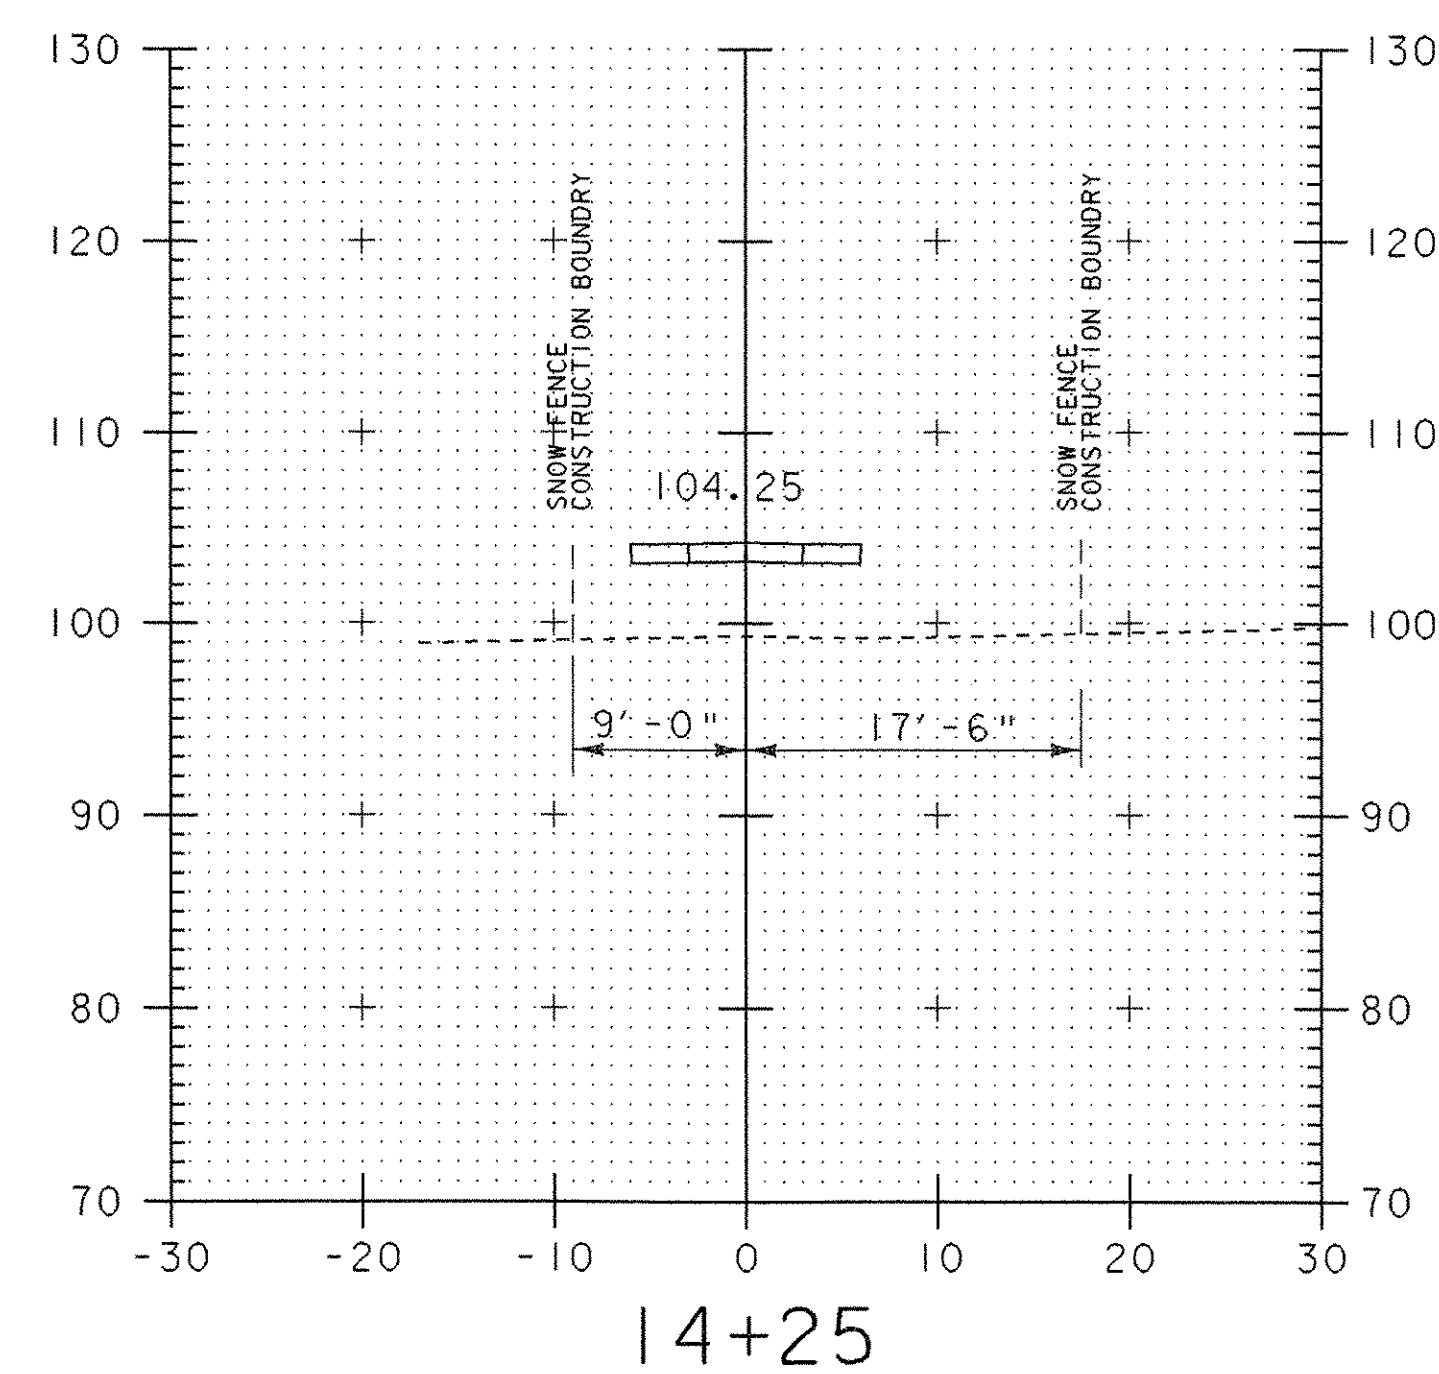
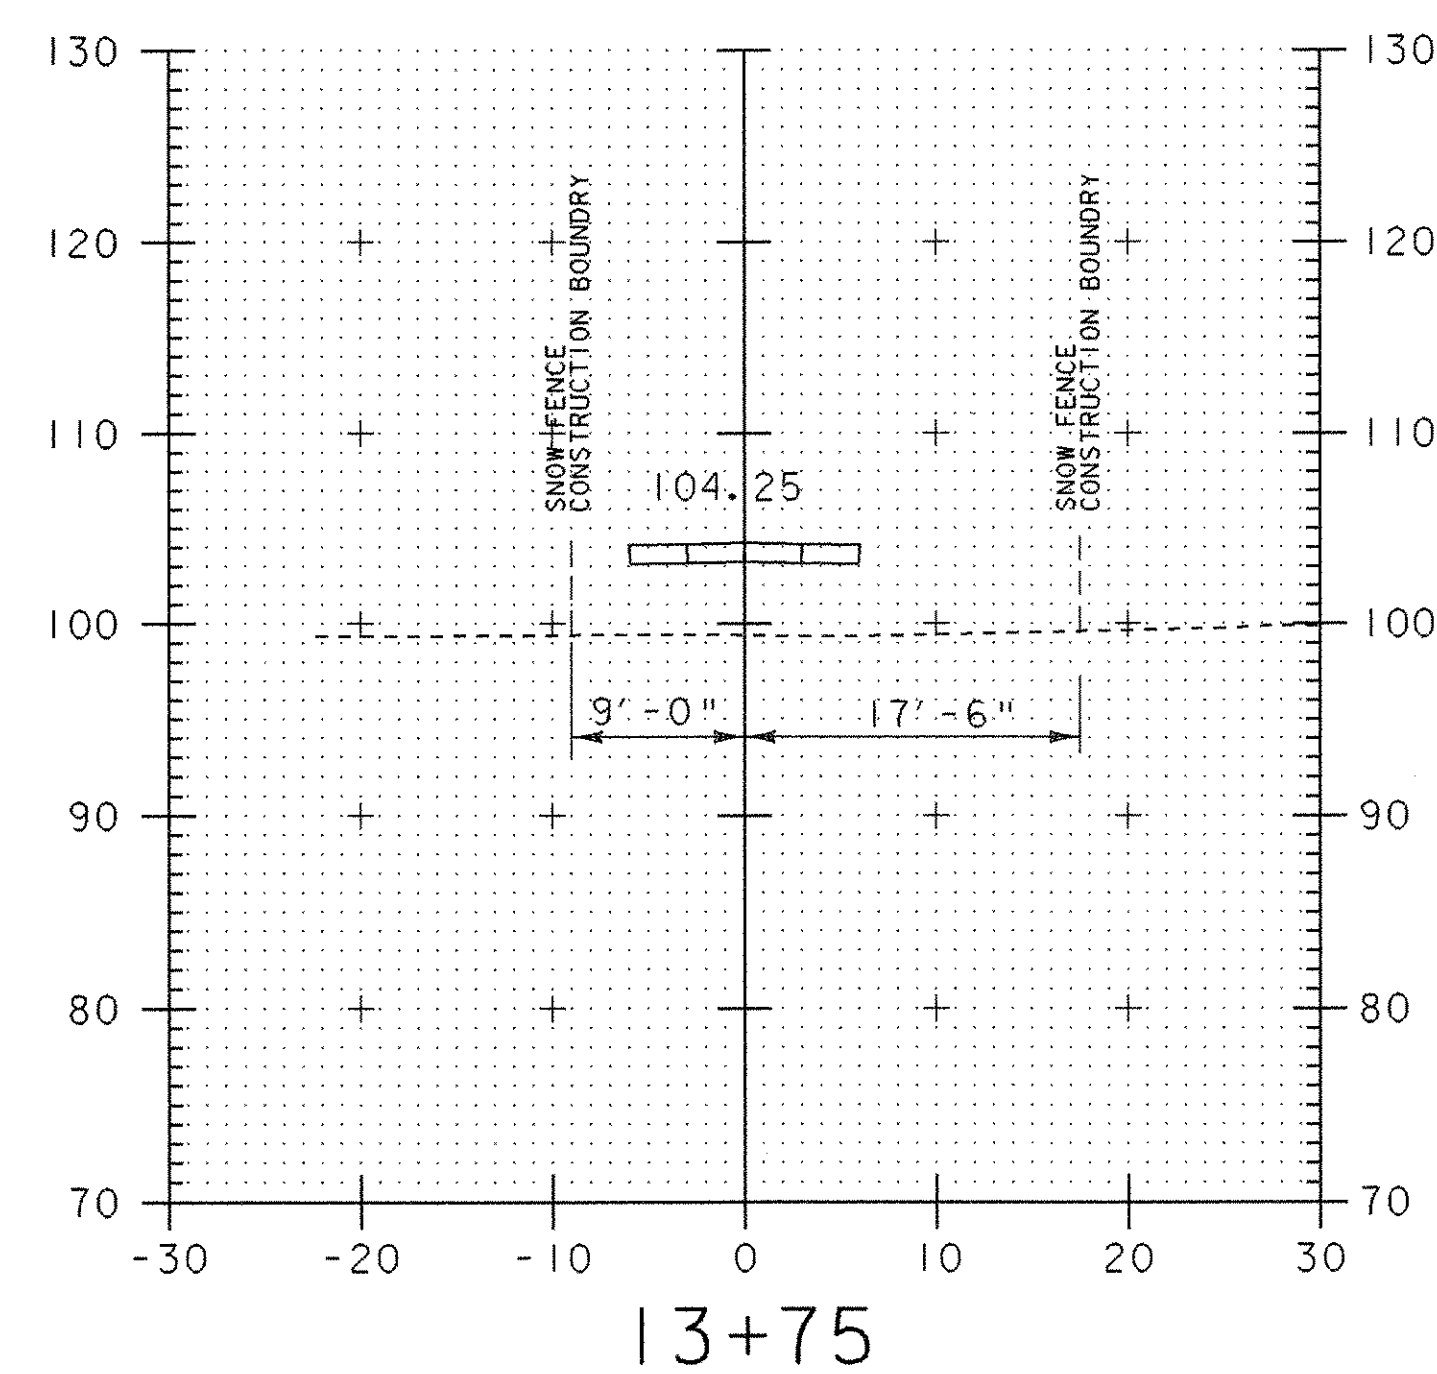
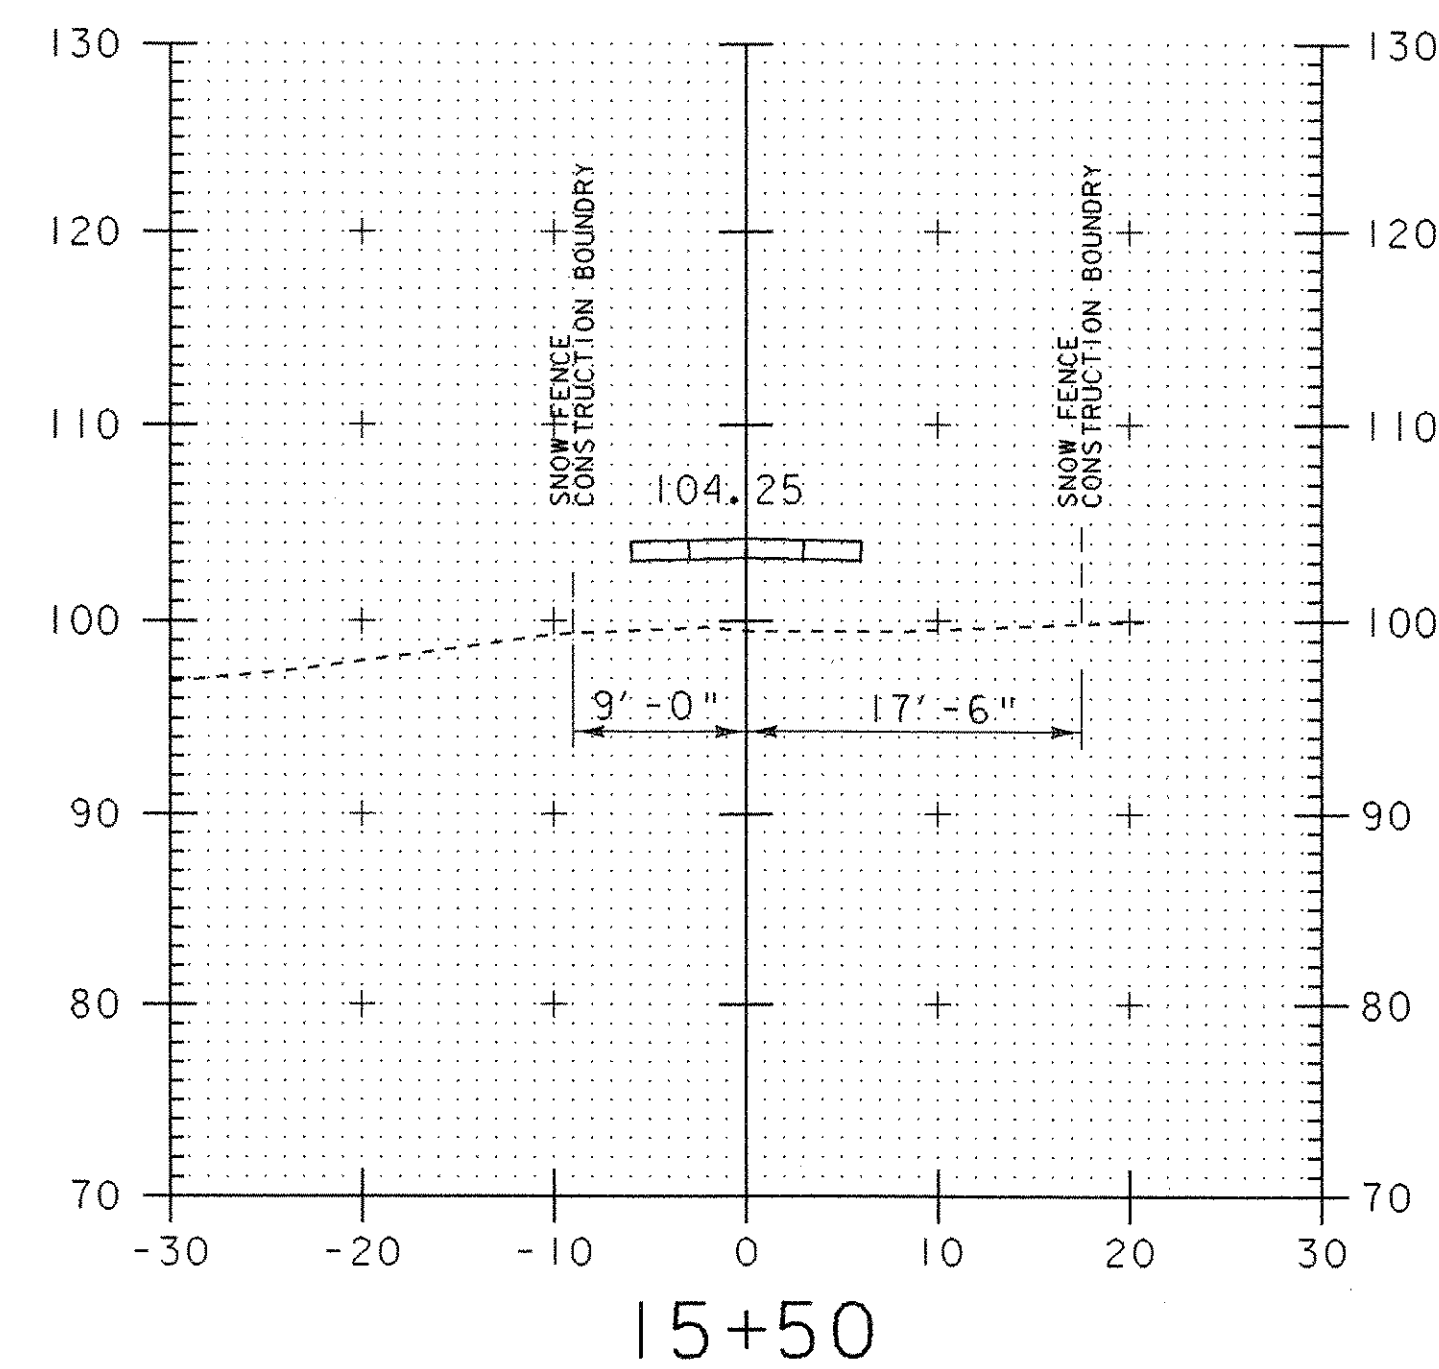
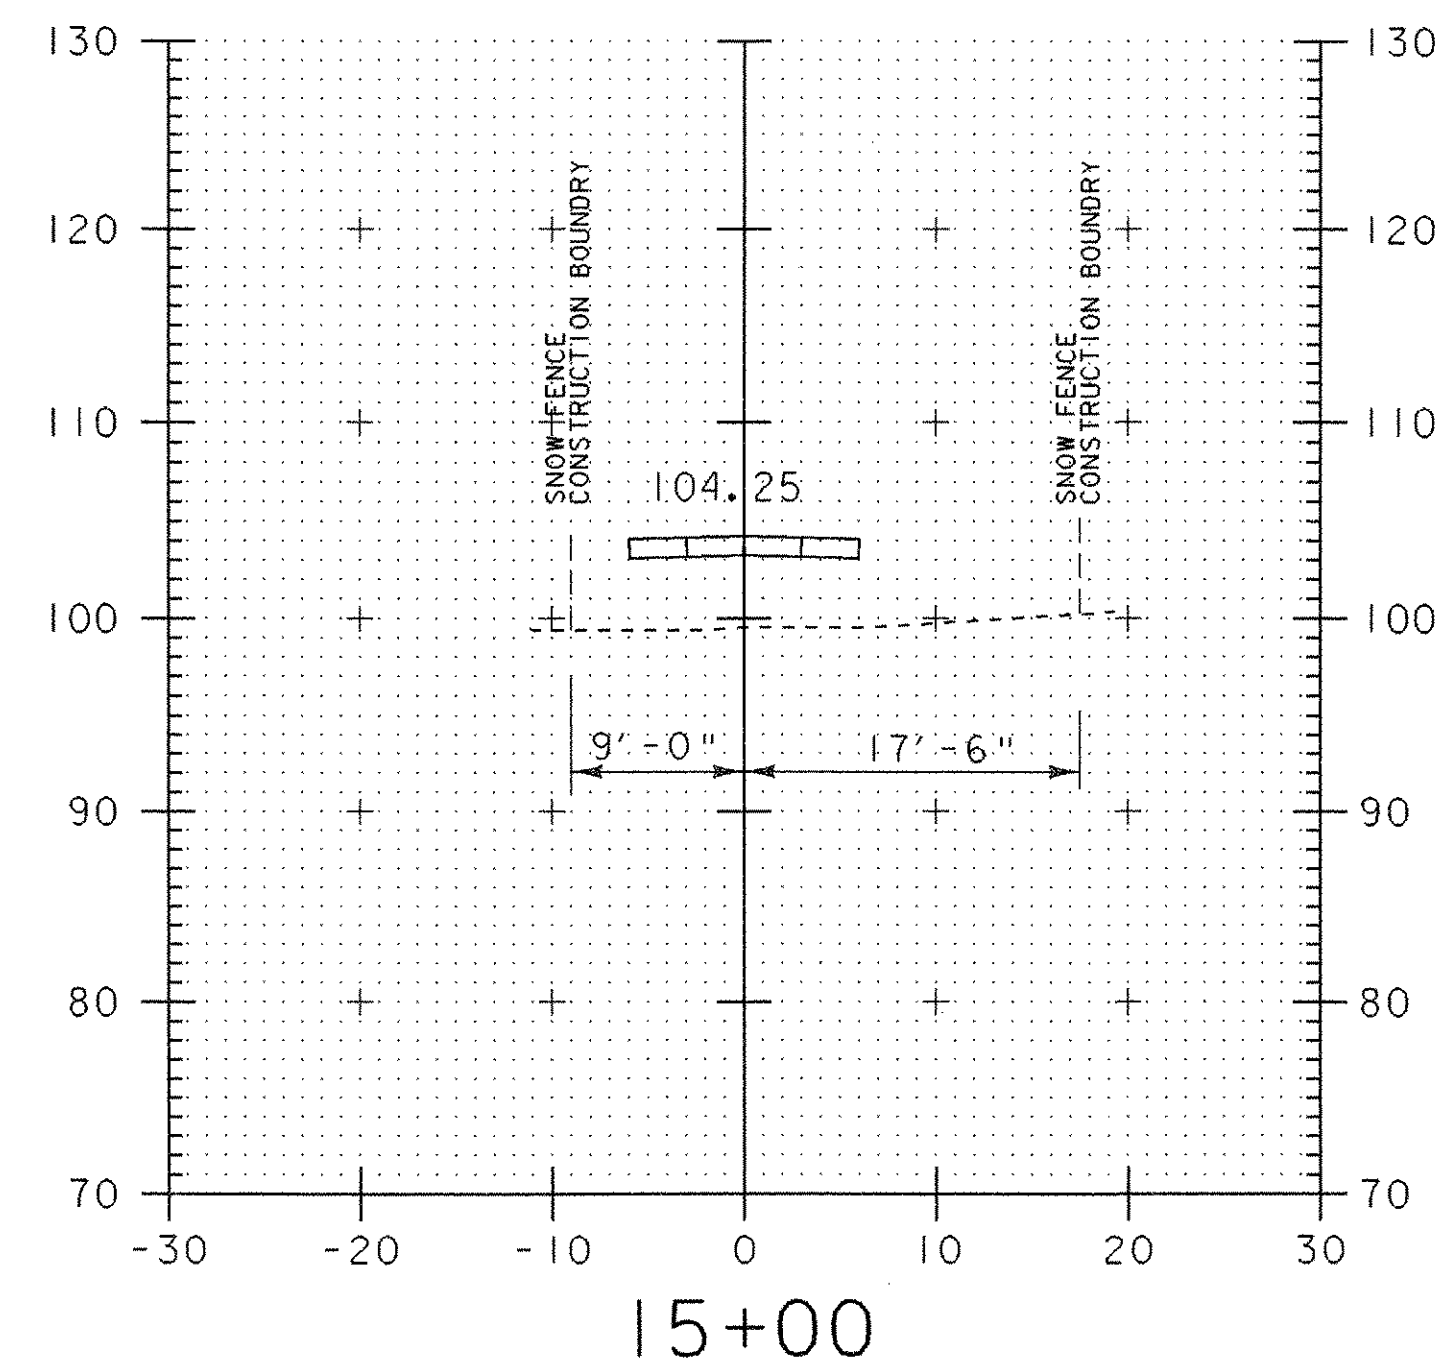
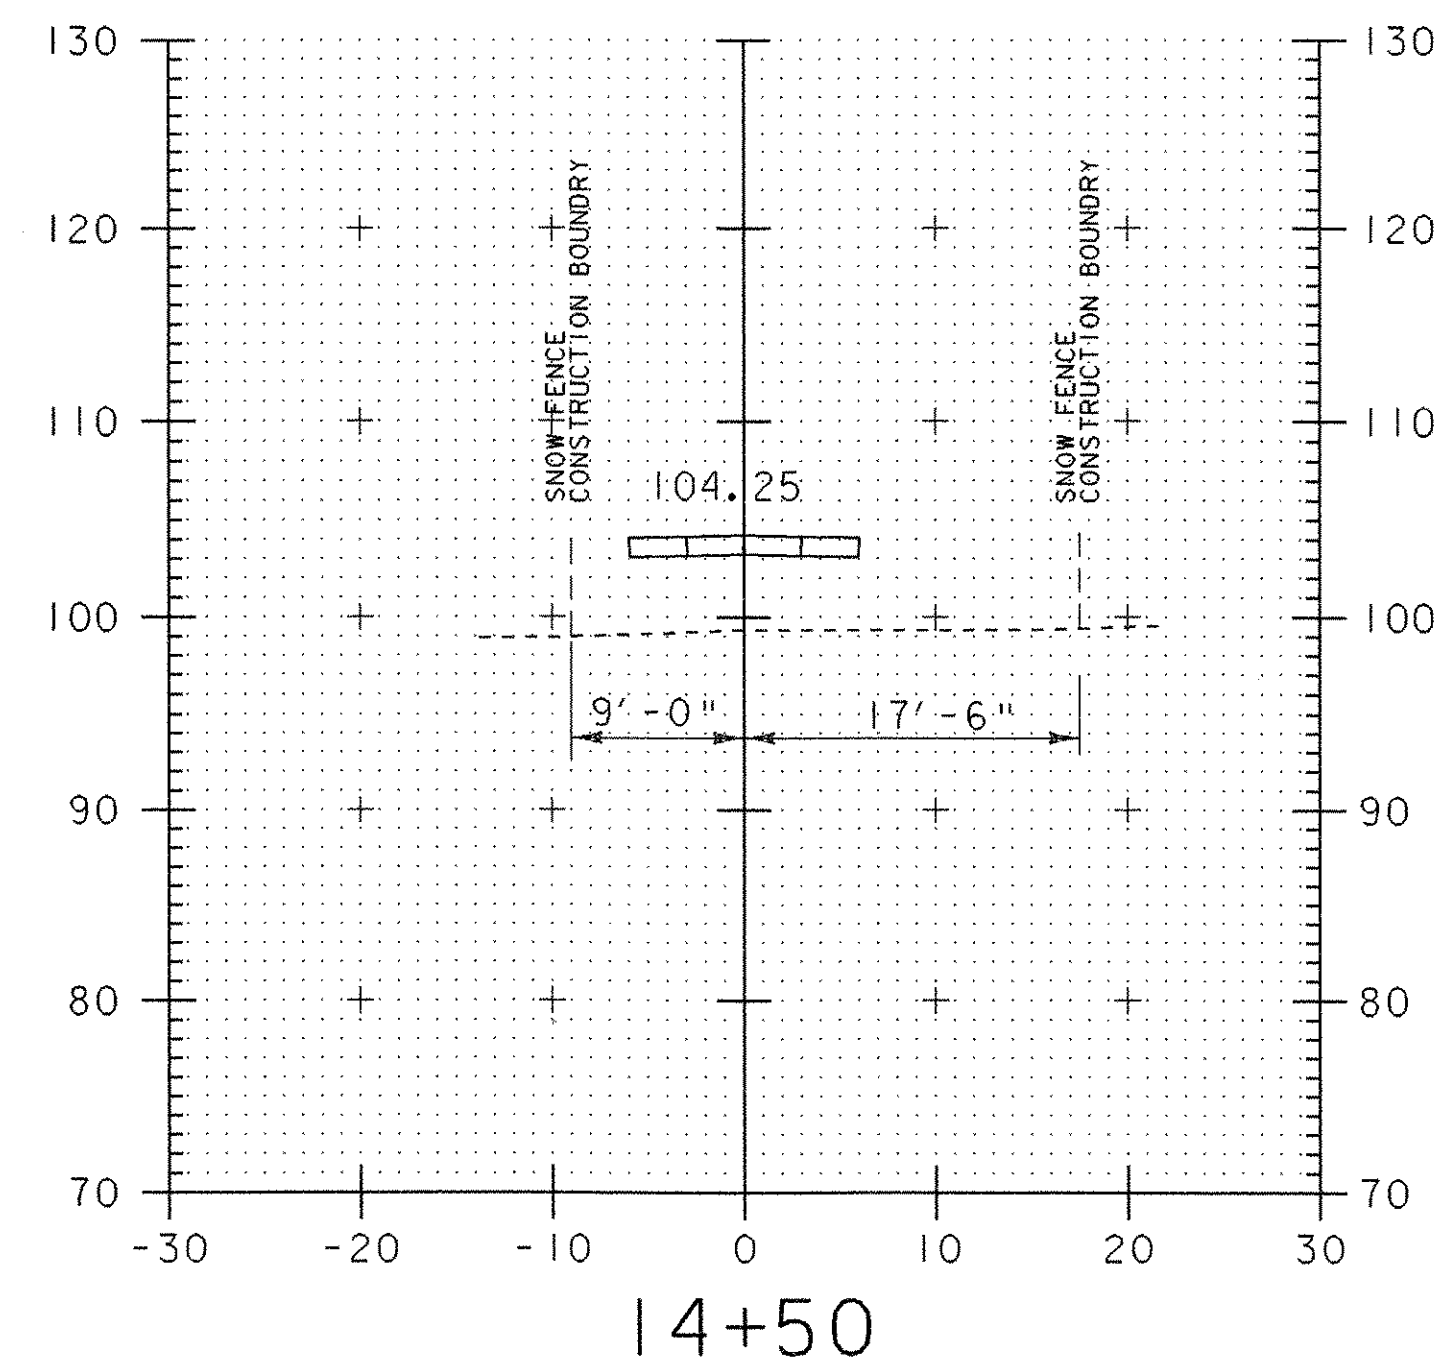


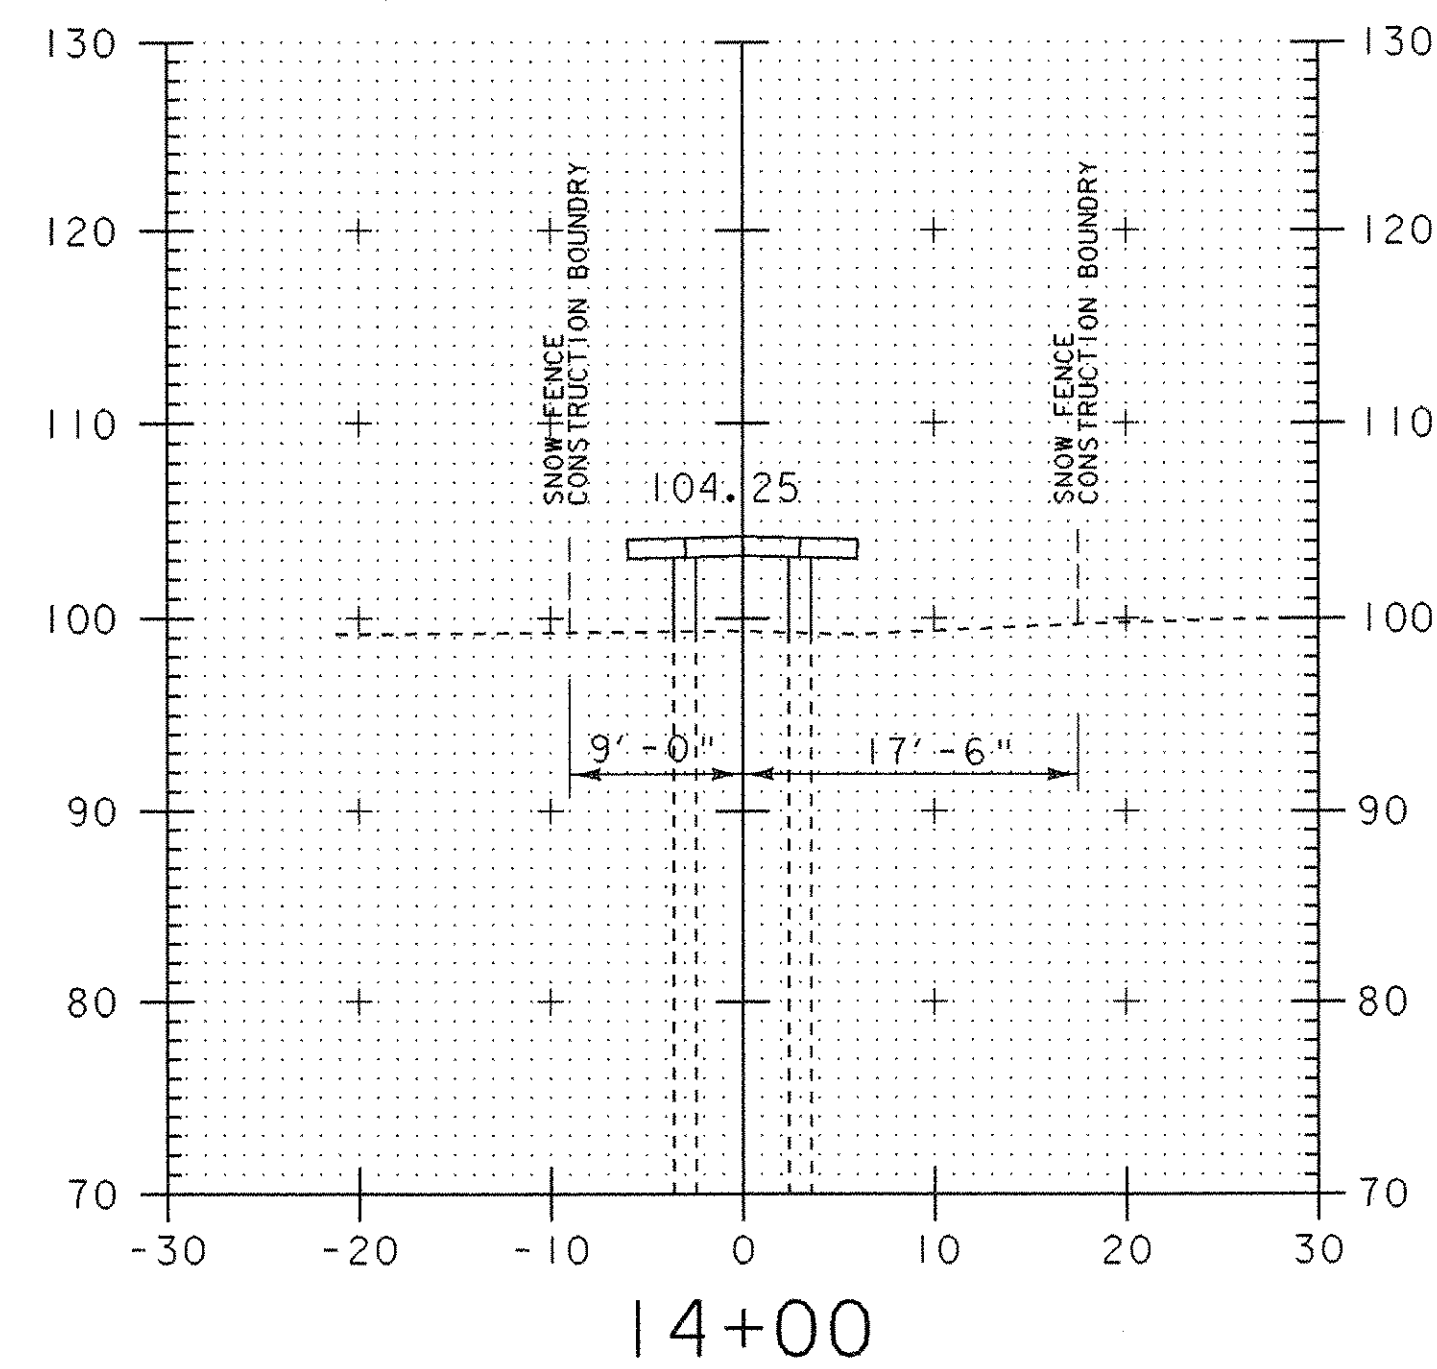

CROSS SECTIONS 13+75 - 15+50

PROJECT NAME:	Colchester
PROJECT NUMBER:	STP BIK(48)
FILE NAME: str5/03f038/sf038xsl.dgn	PLOT DATE: 05-AUG-2003
PROJECT LEADER: C. Keller	DRAWN BY: G. Shangraw
DESIGNED BY: G. Shangraw	CHECKED BY:
sf038xs8.i	SHEET 77 OF 87