




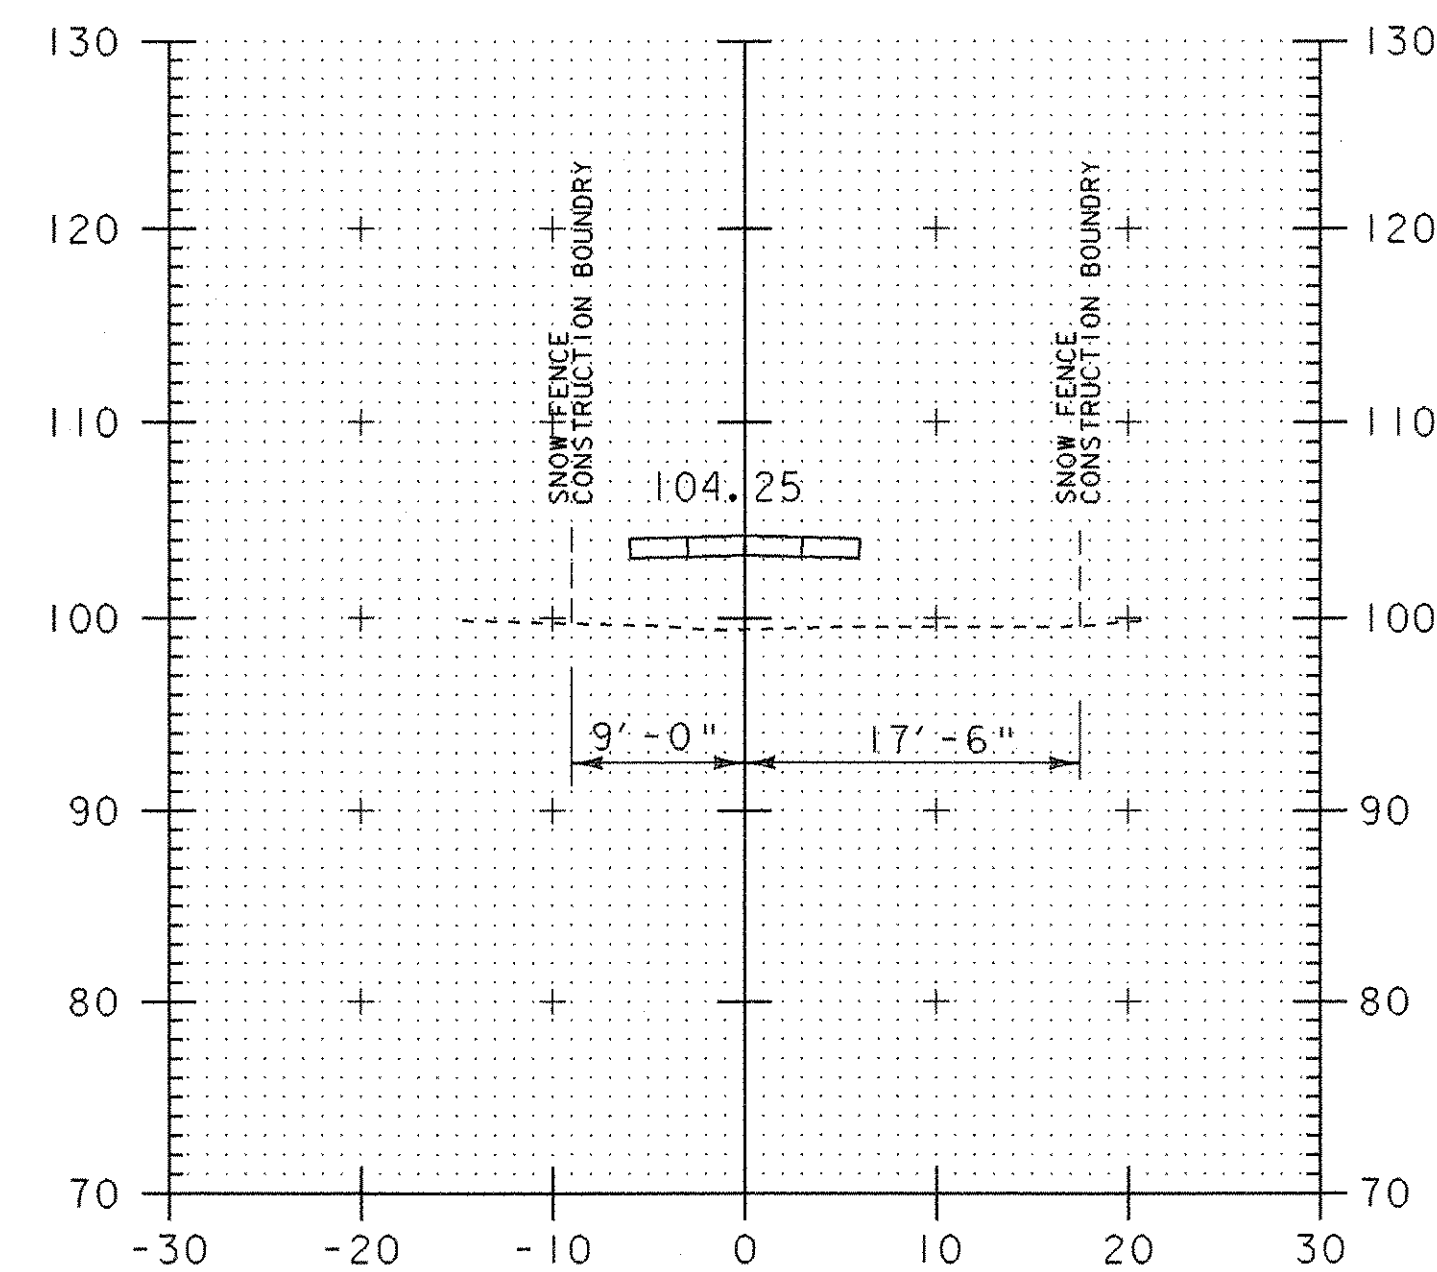


18+00

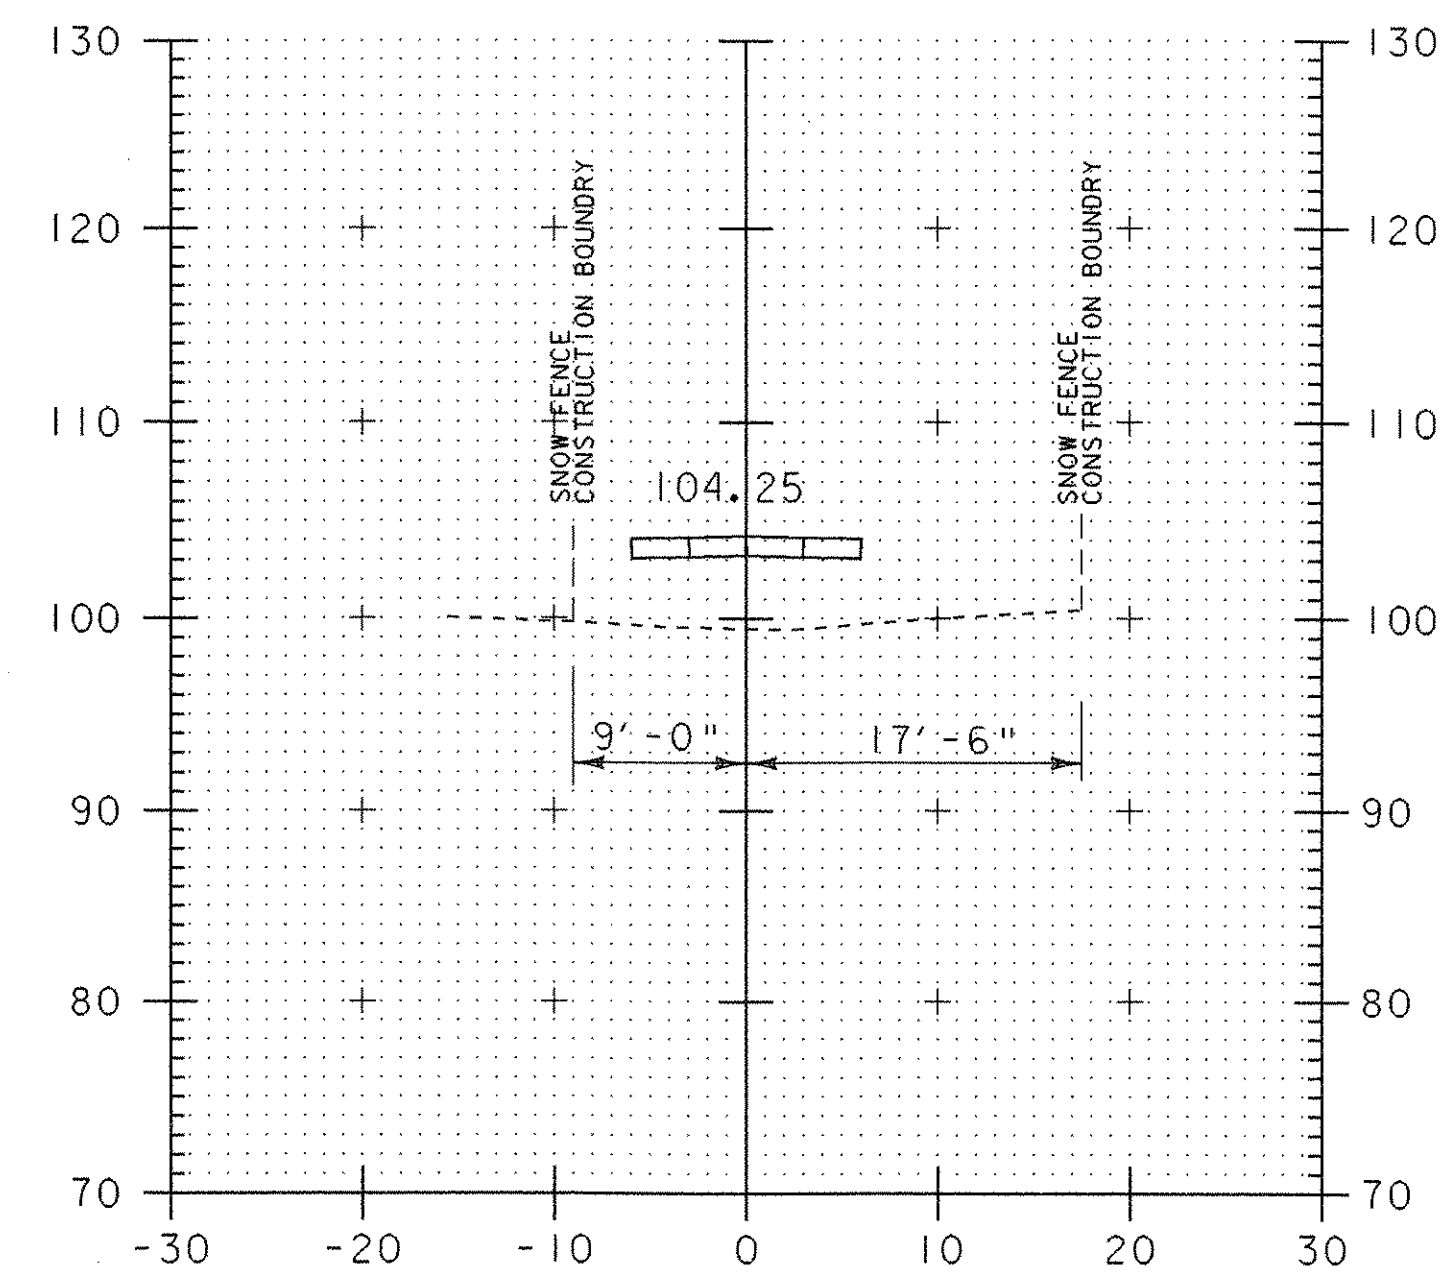


18+50

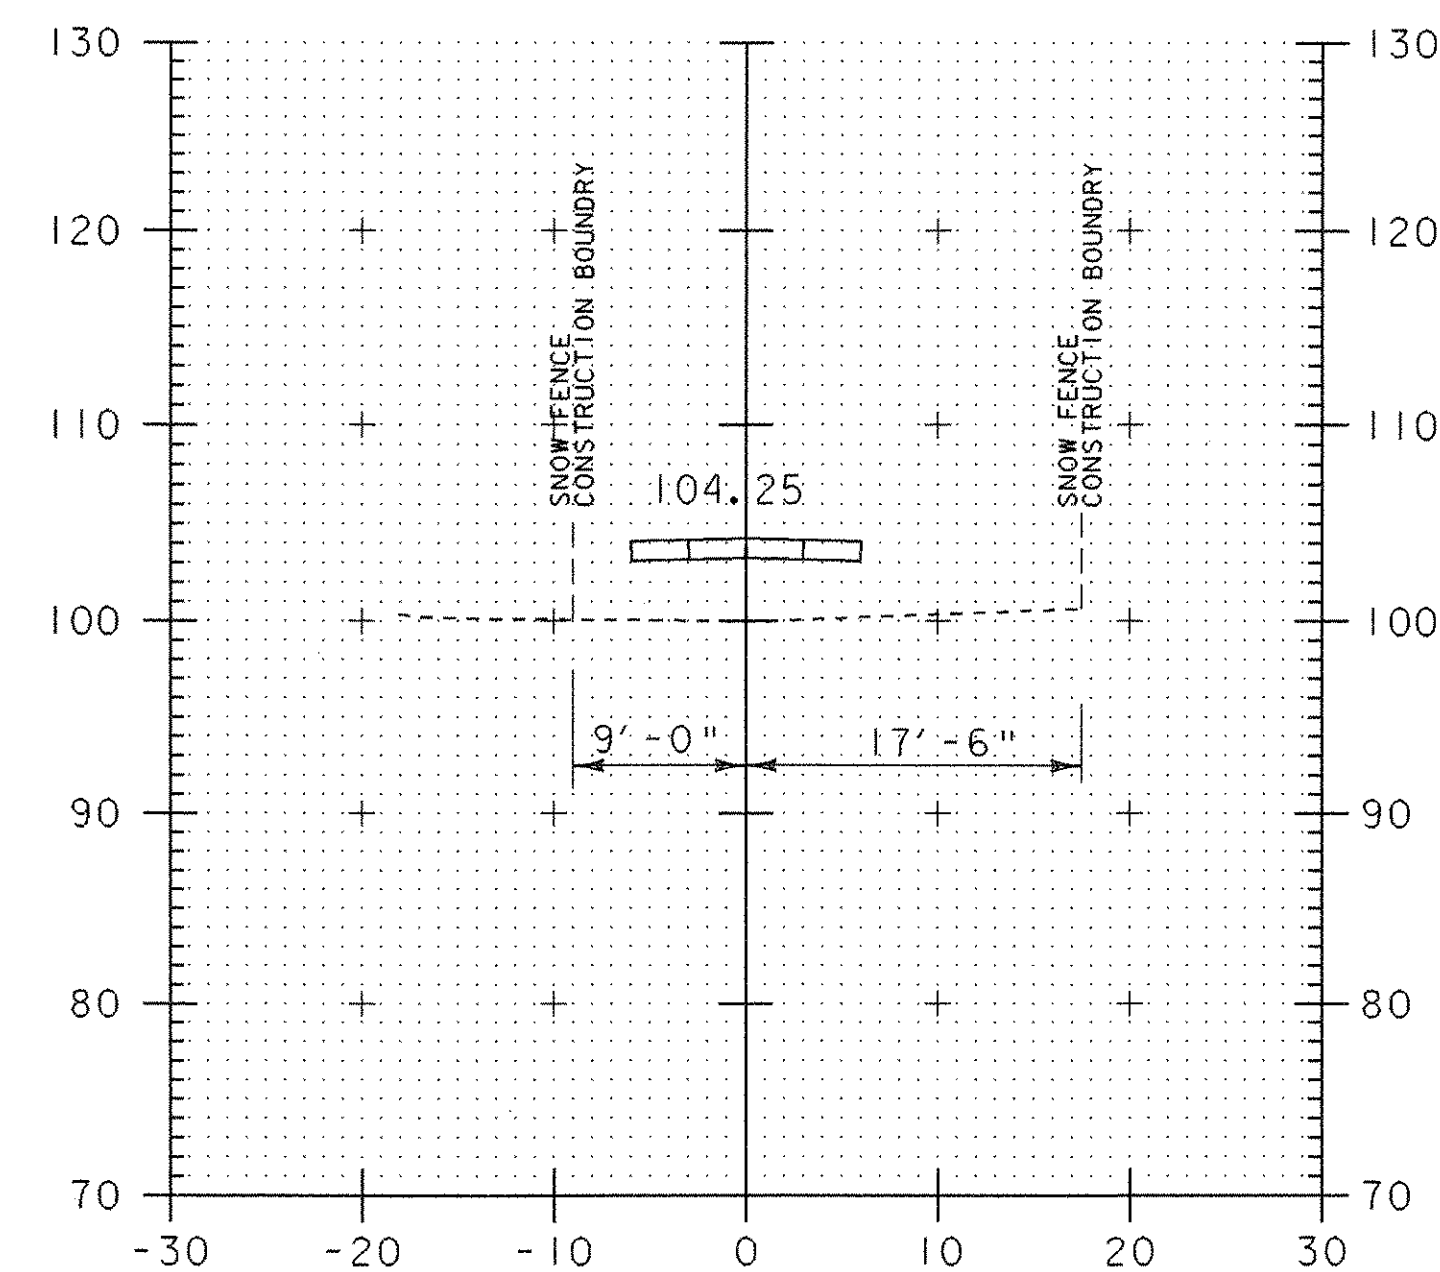


19+00

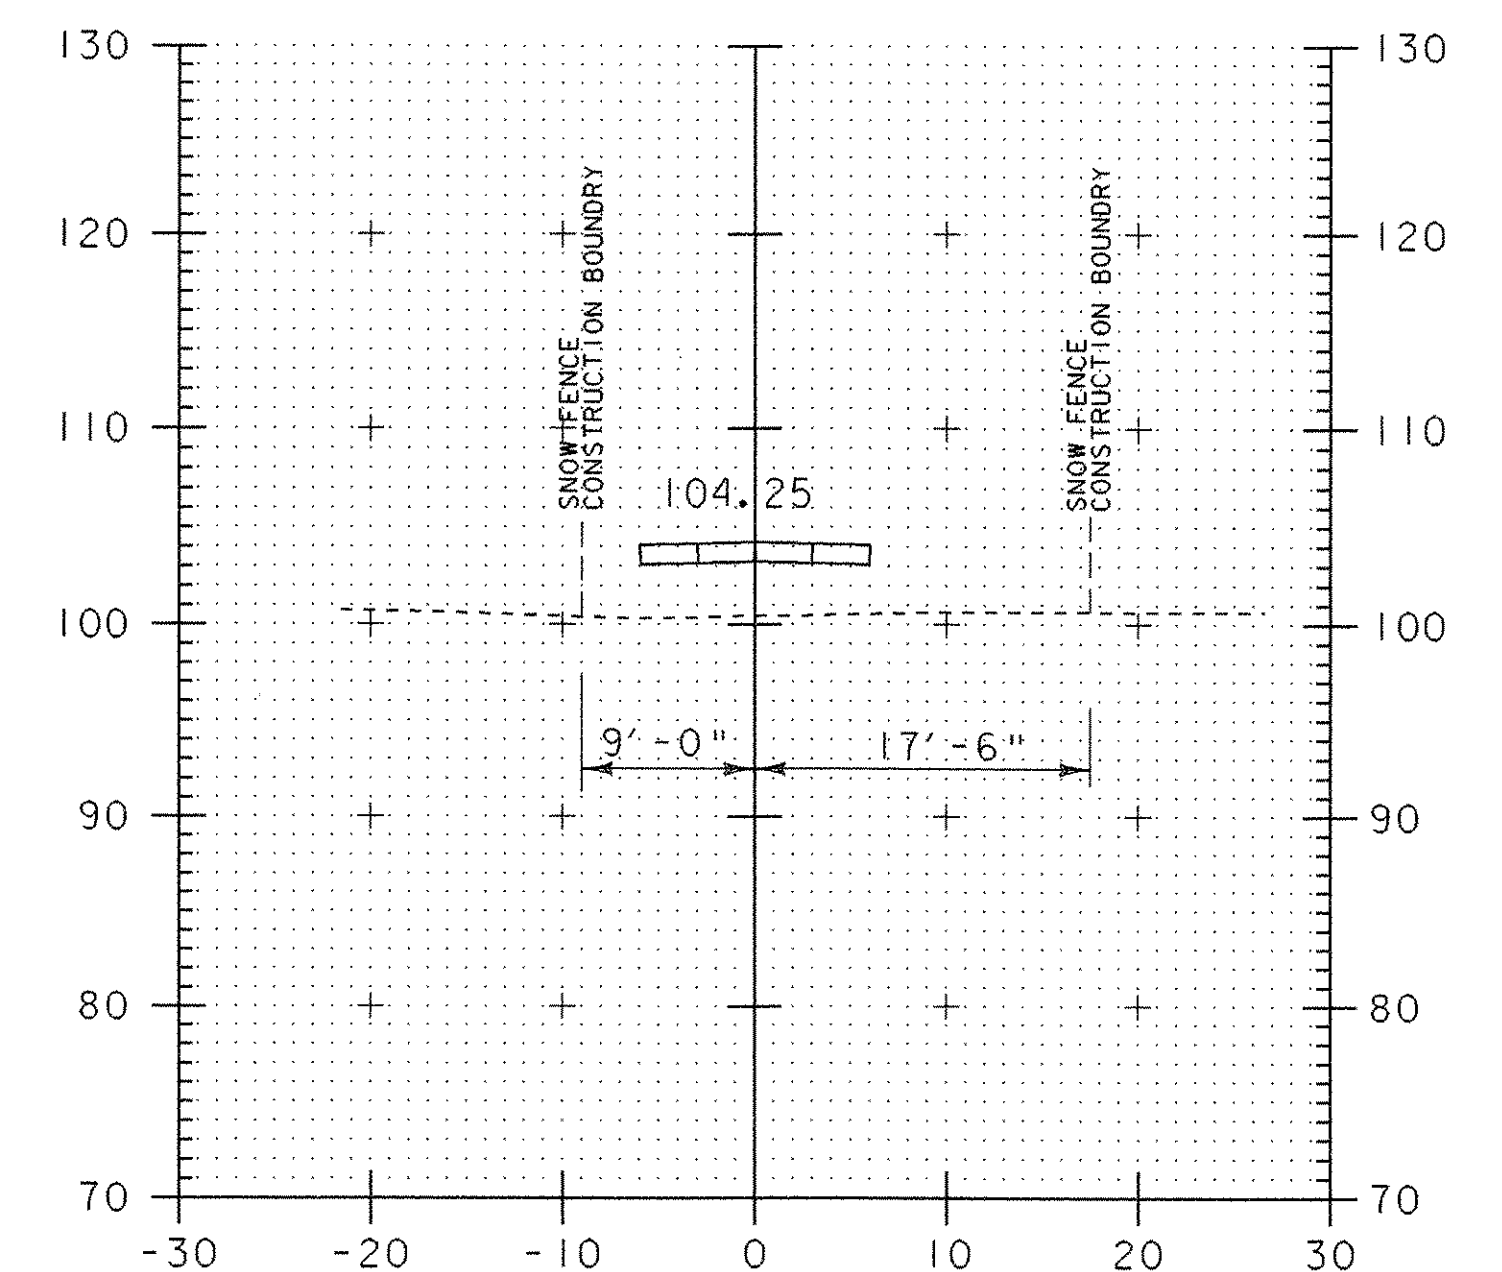


19+50

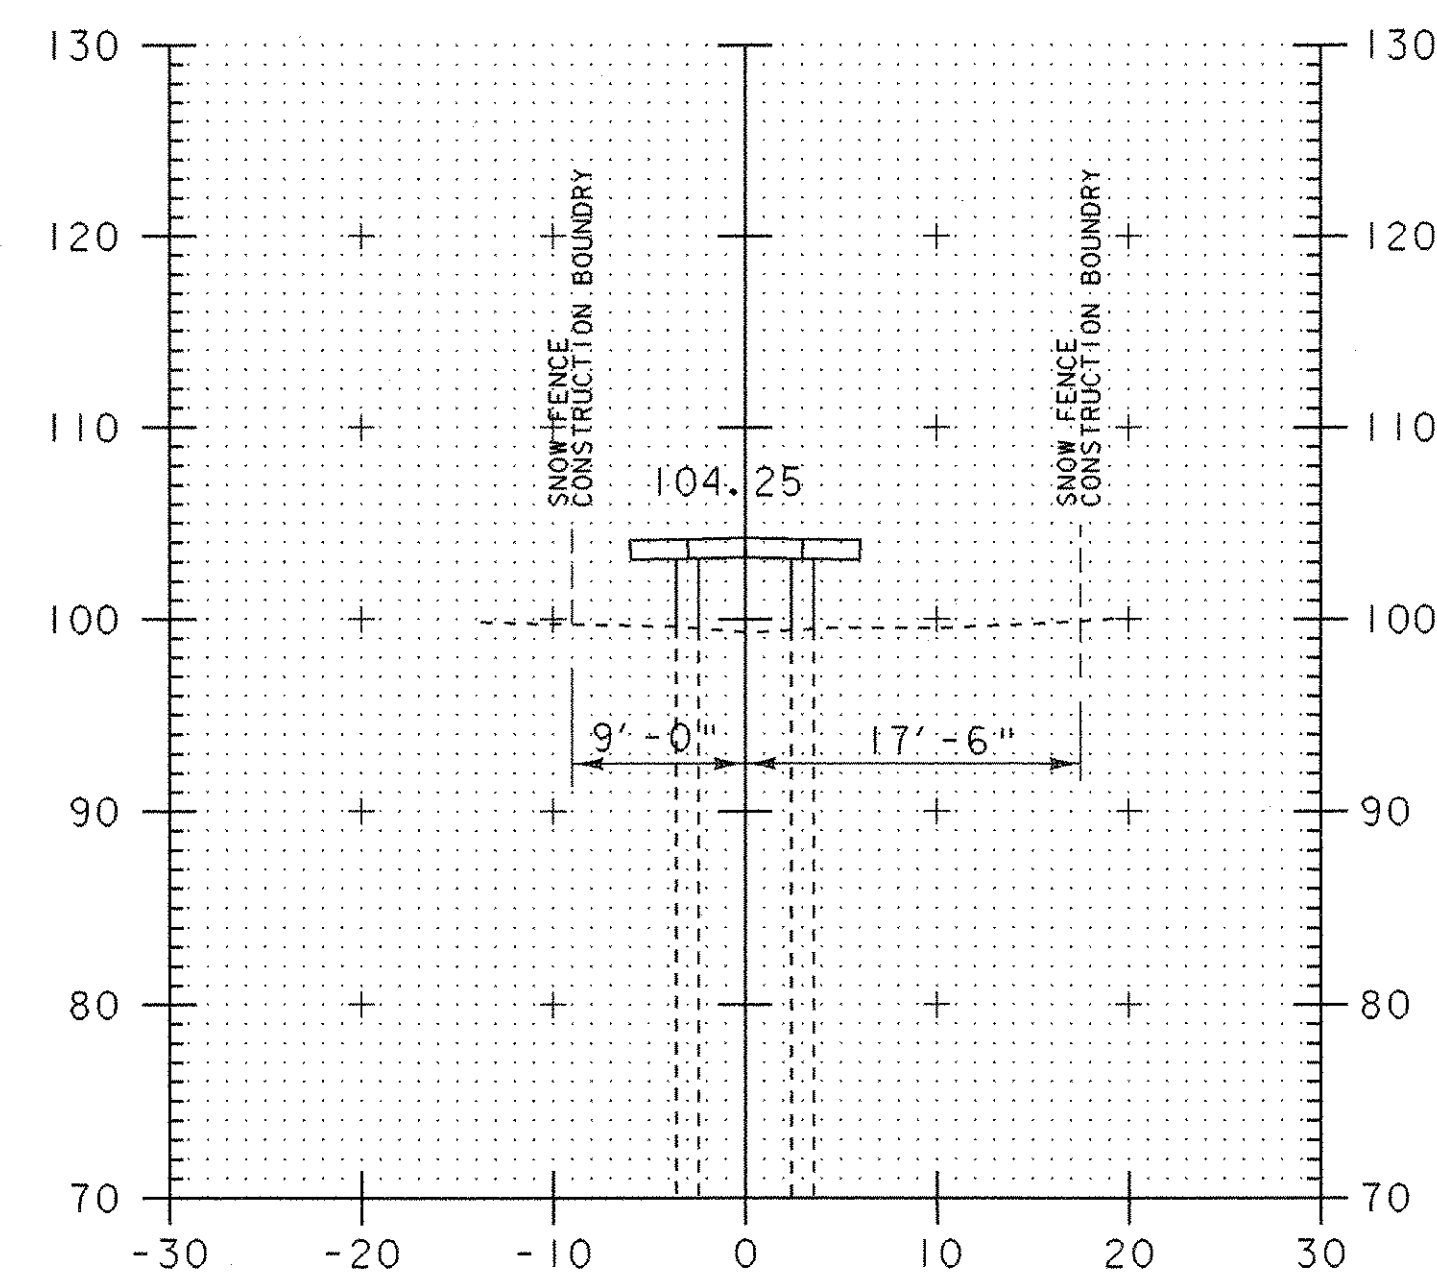


17+75

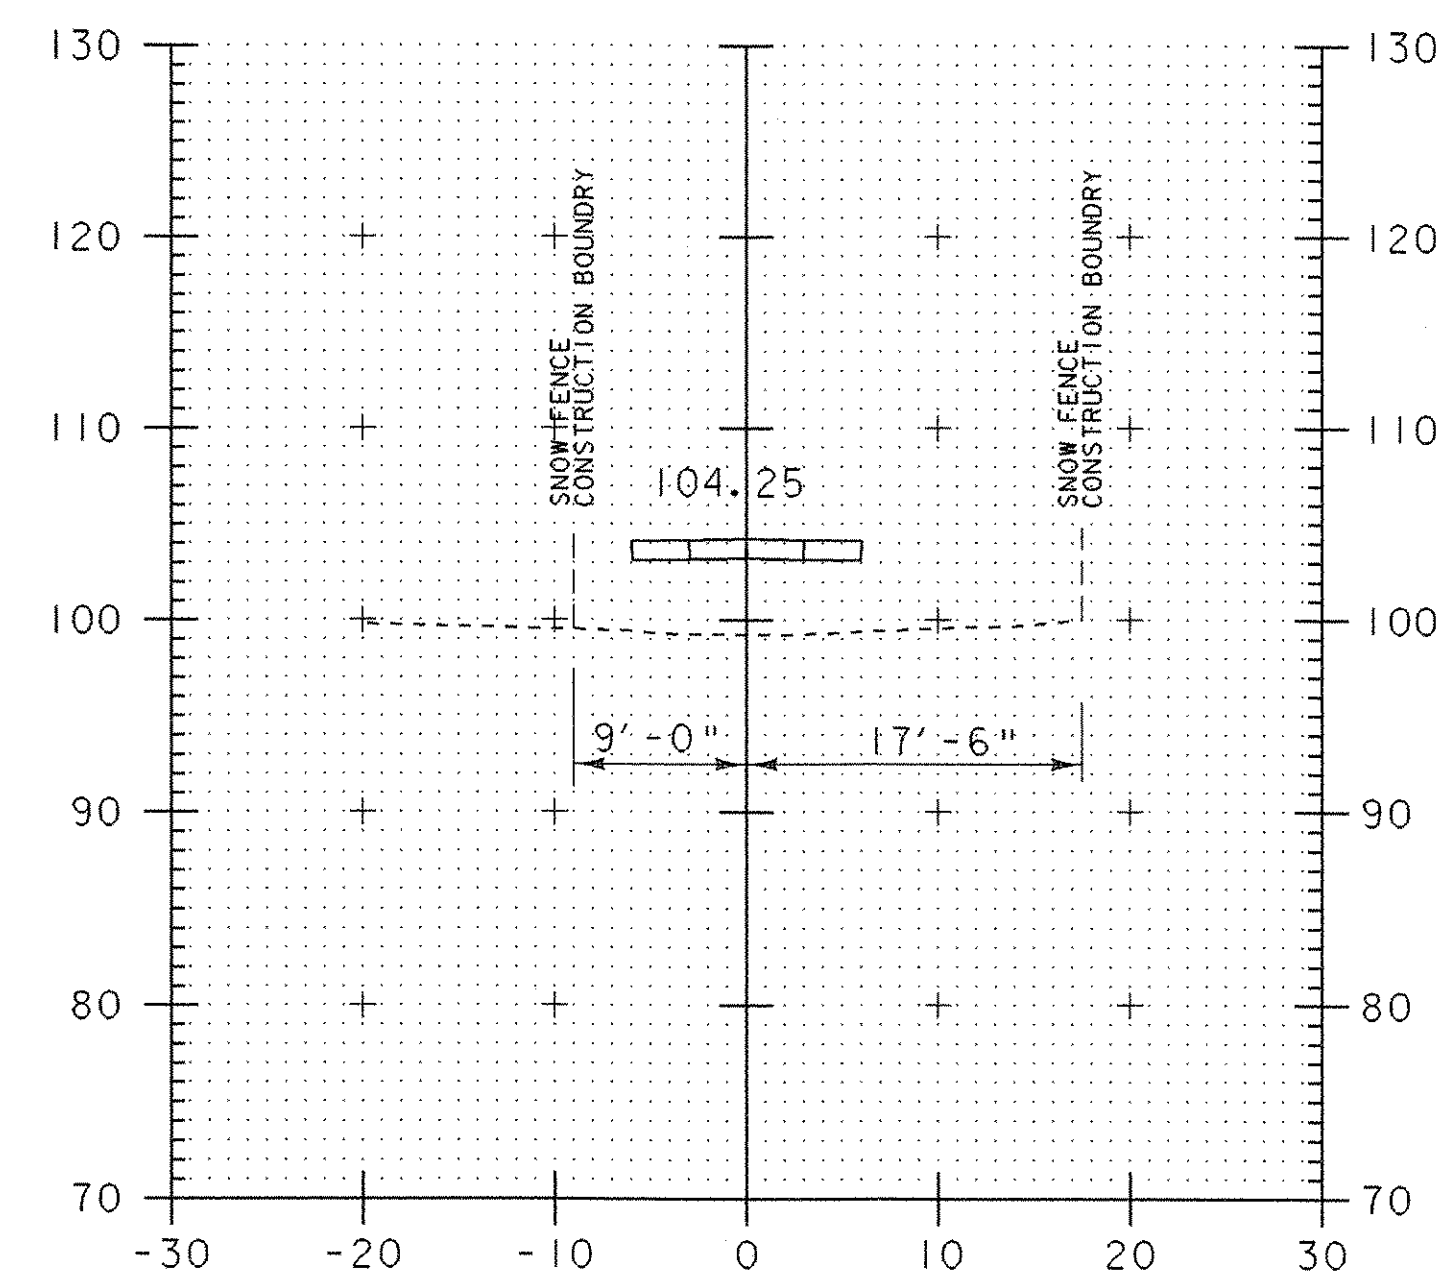

18+25

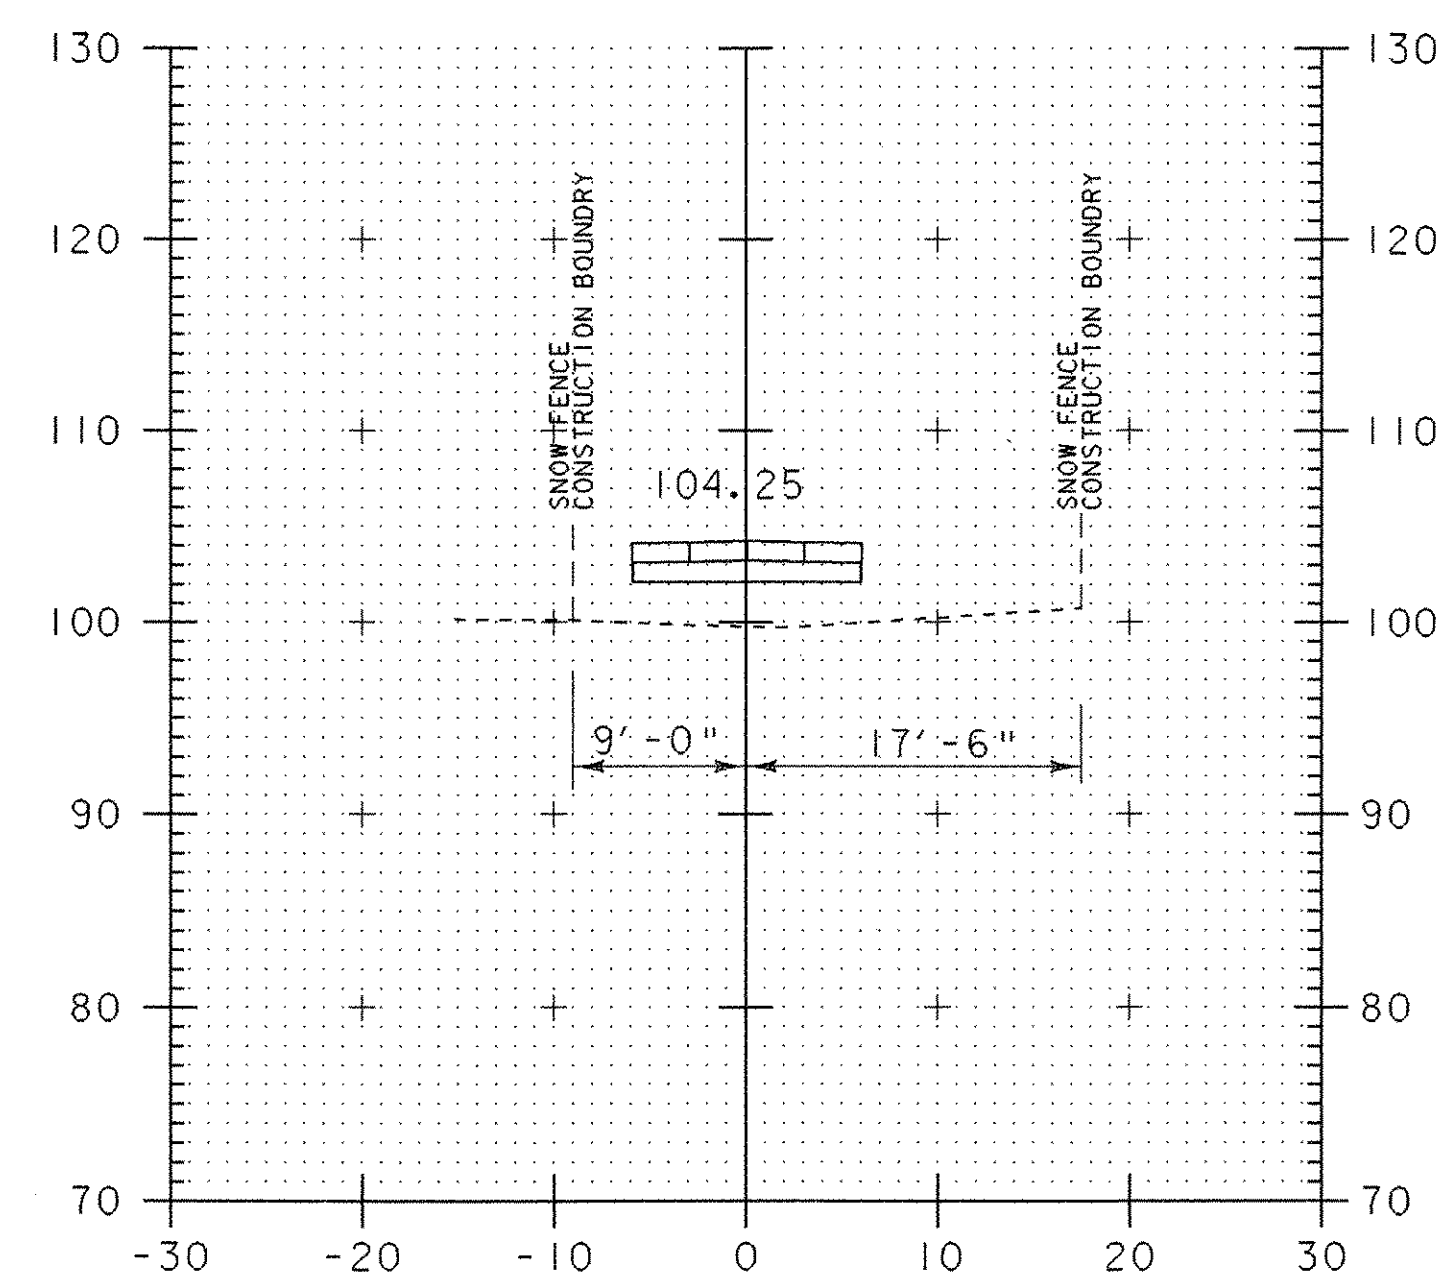

18+75

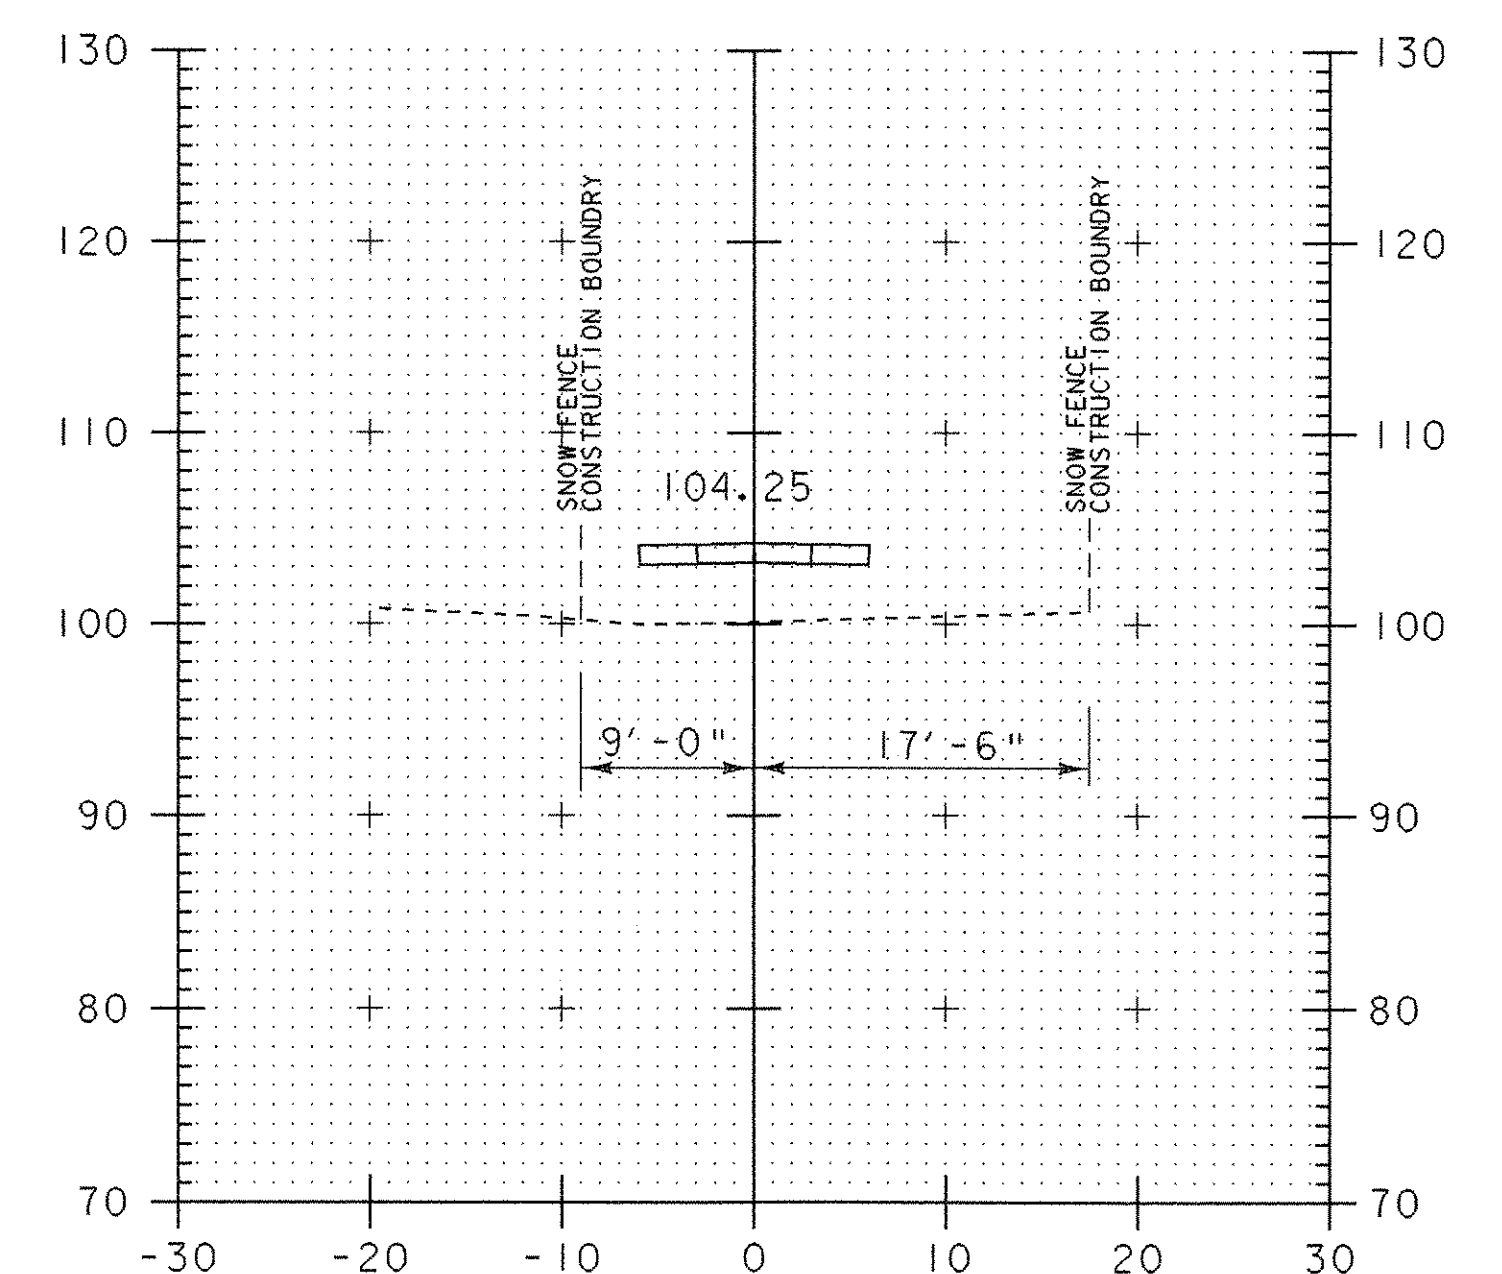

19+25

CROSS SECTIONS 17+75 - 19+50

PROJECT NAME:	Colchester
PROJECT NUMBER:	STP Bike(48)
FILE NAME: str5/03f038/sf038xsl.dgn	PLOT DATE: 05-AUG-2003
PROJECT LEADER: C. Keller	DRAWN BY: G. Shangraw
DESIGNED BY: G. Shangraw	CHECKED BY:
sf038xsl0.i	SHEET 79 OF 87