




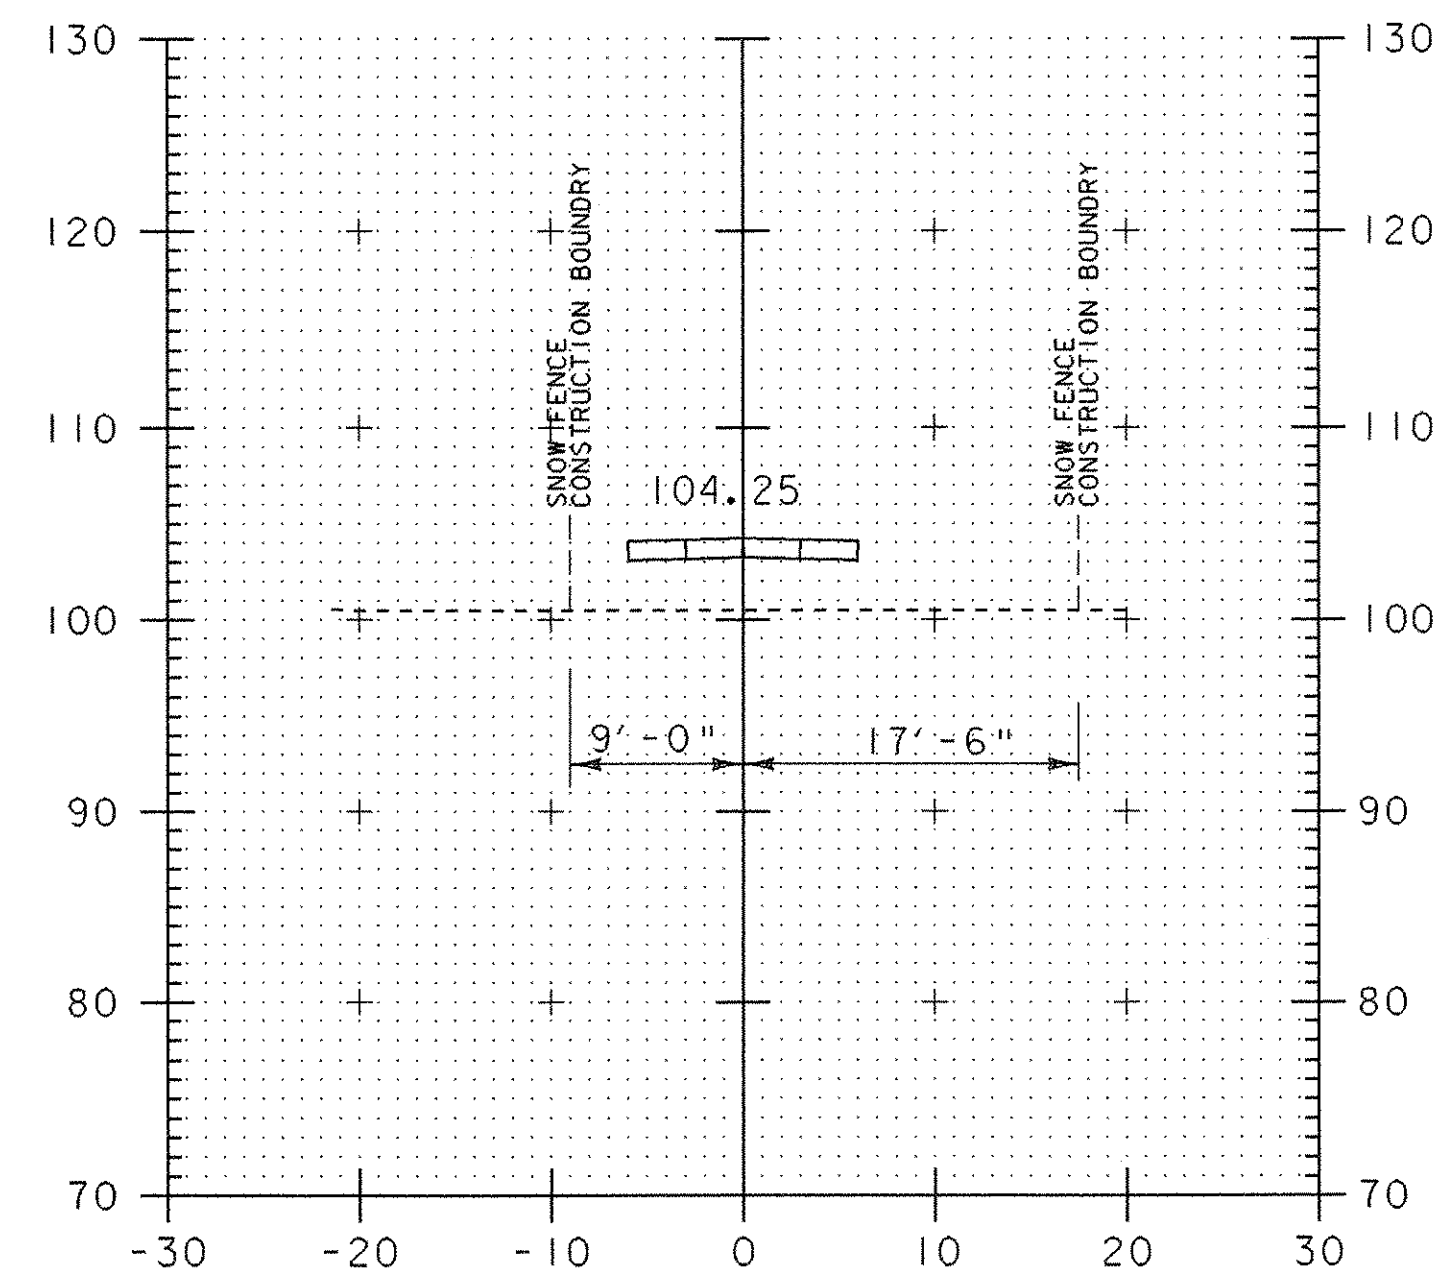


20+00

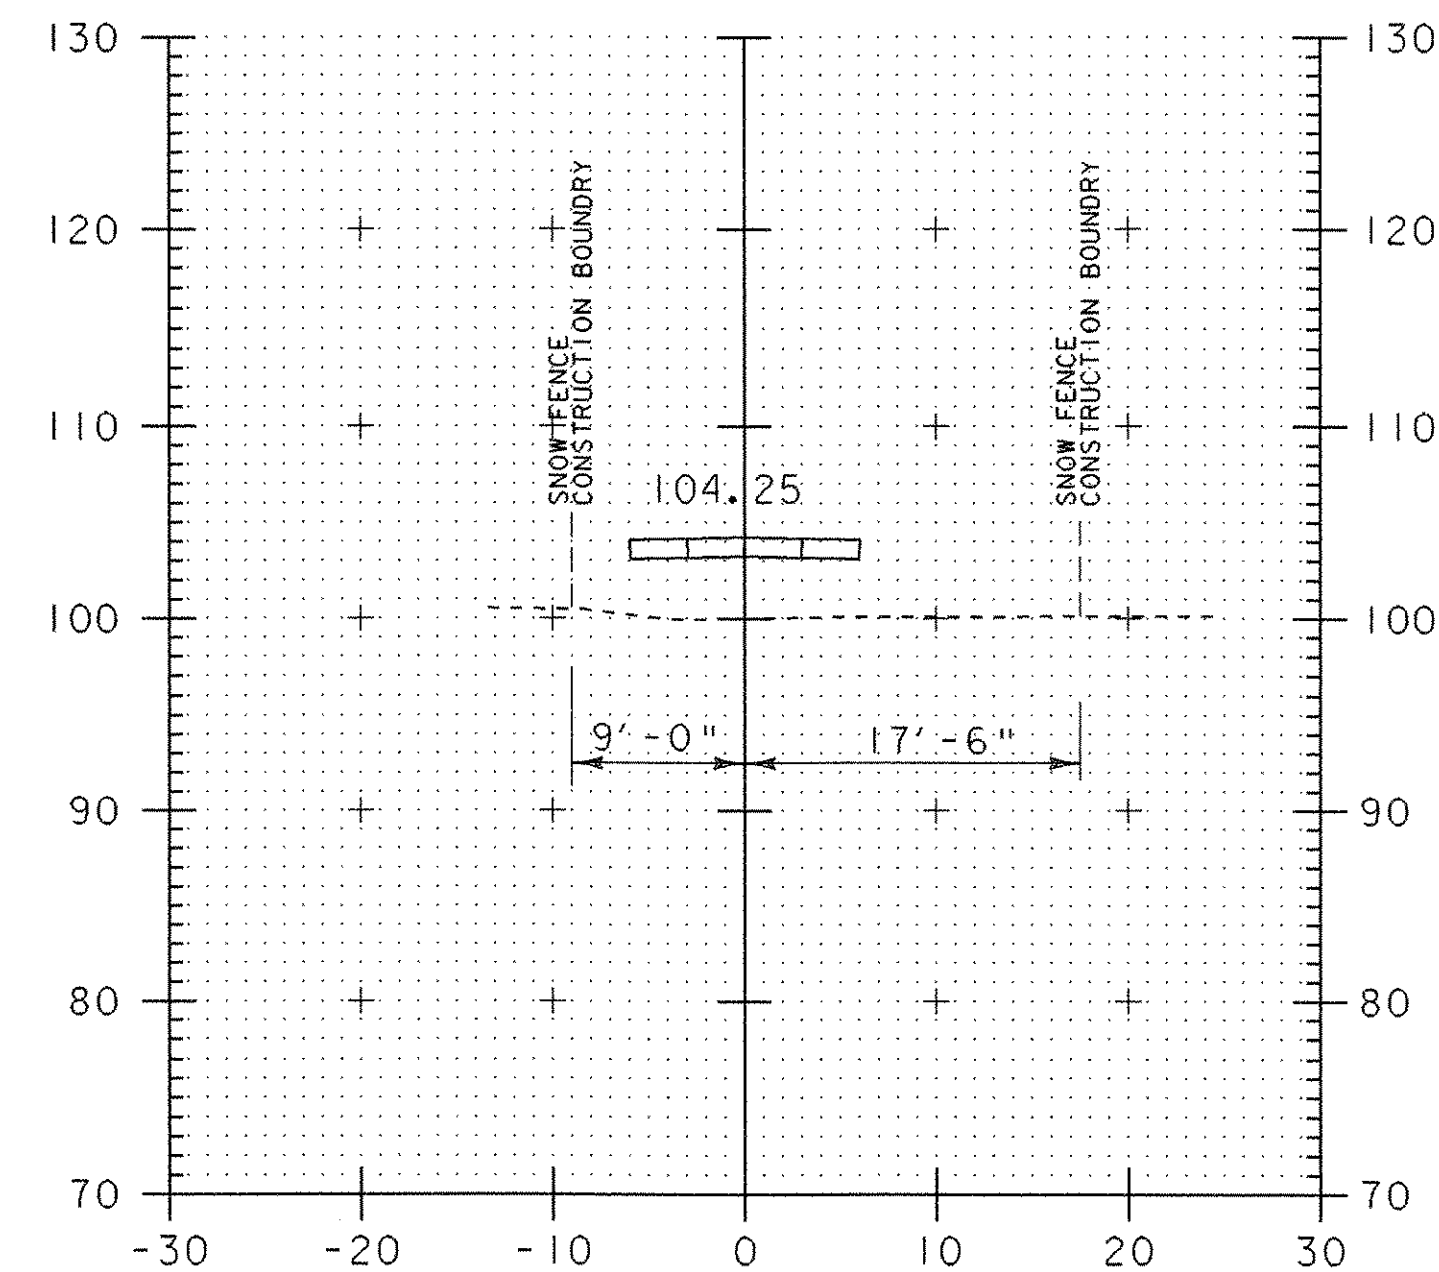


20+50

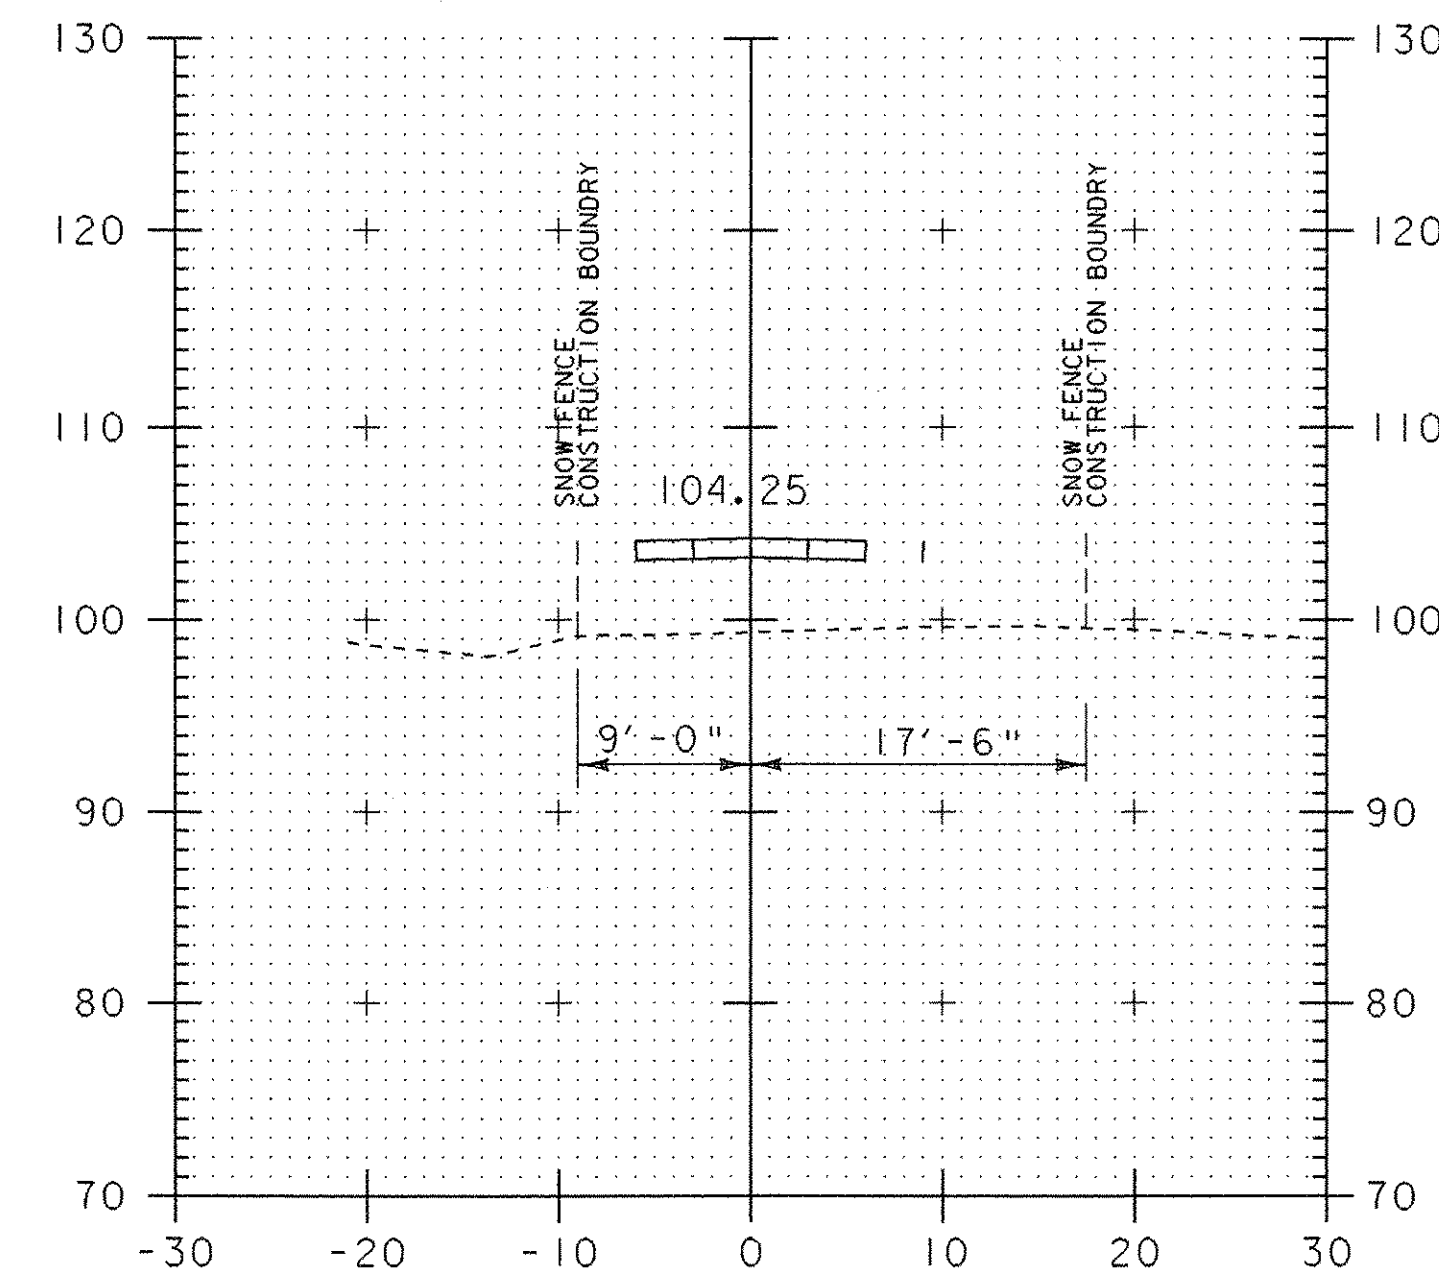


21+00

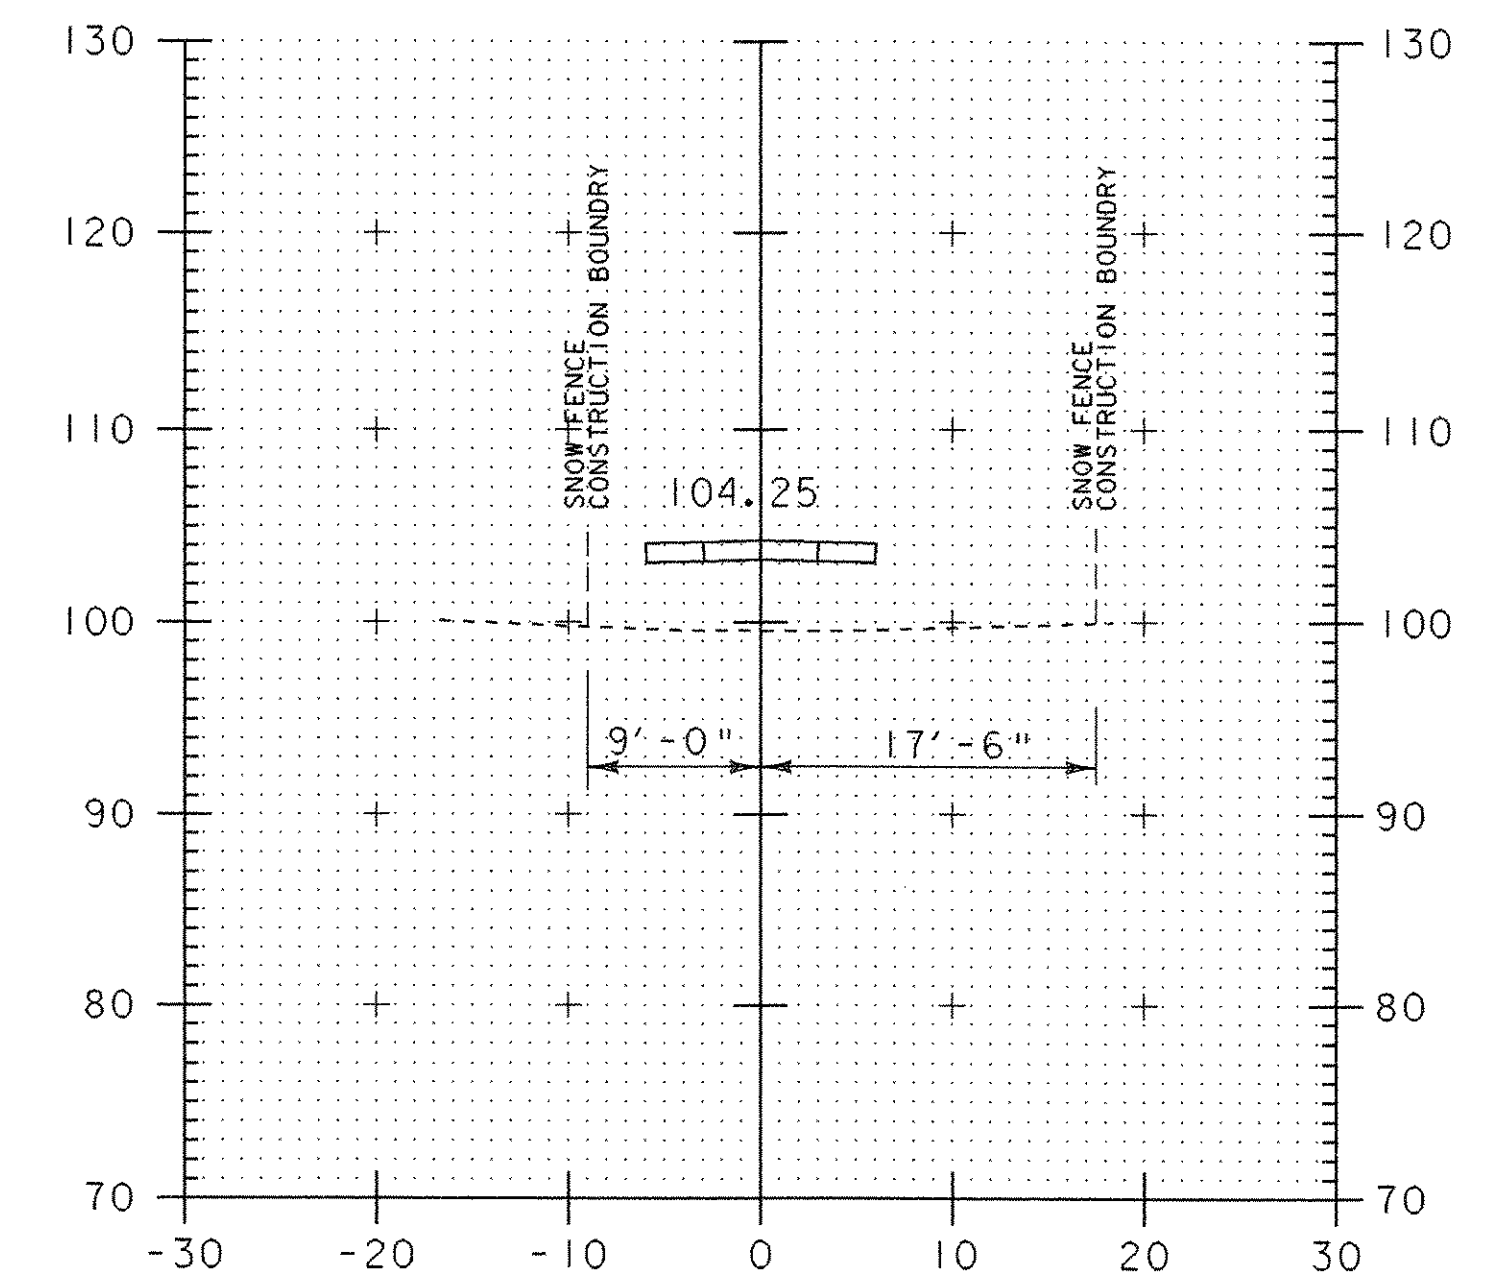


21+50

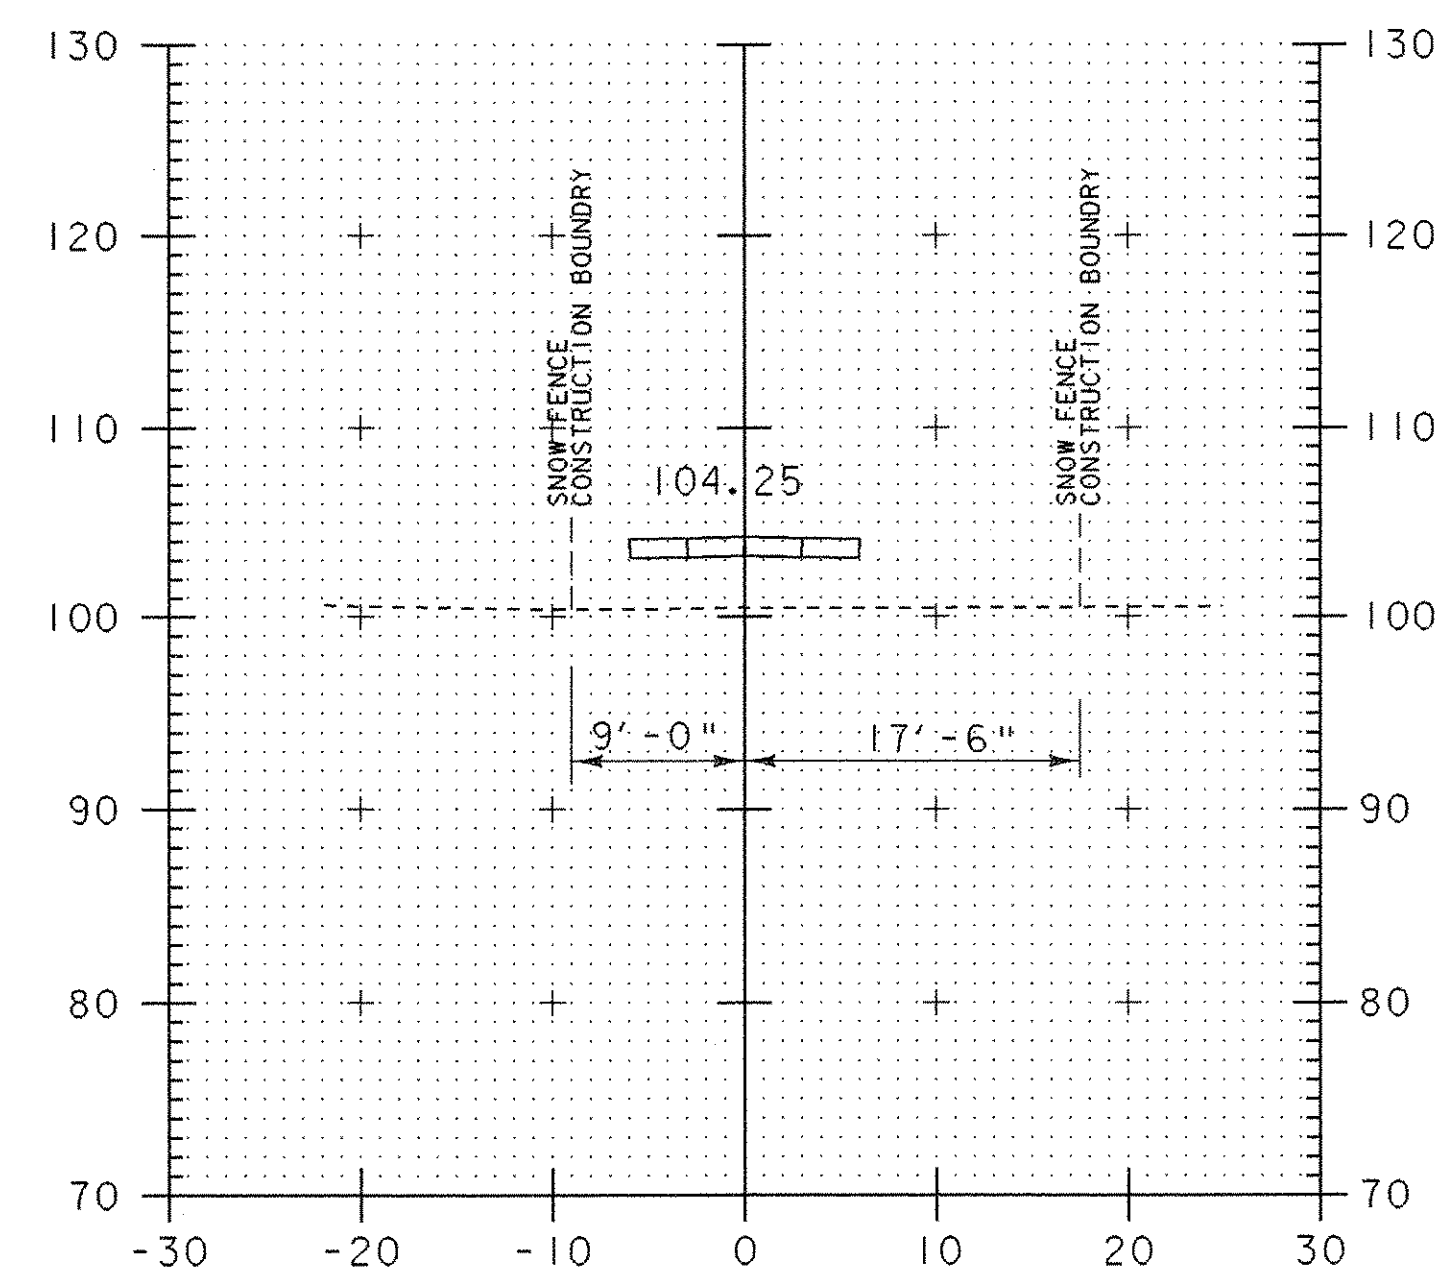


19+75

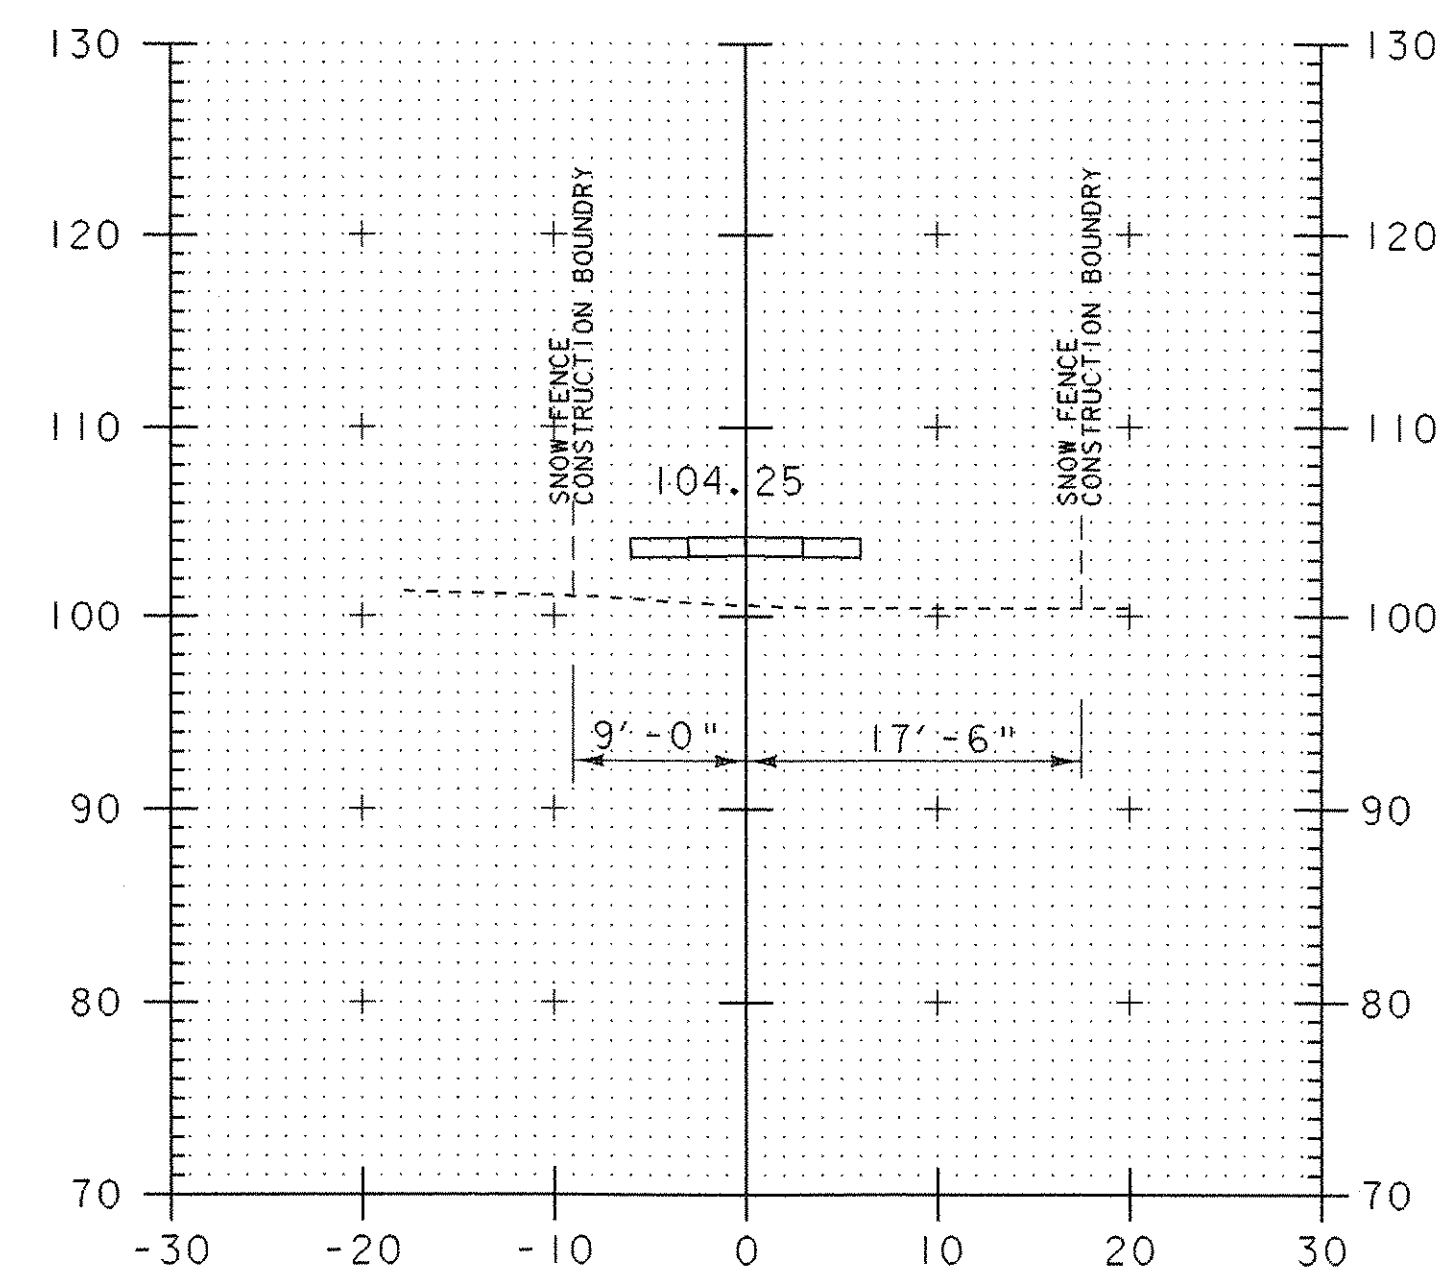

20+25

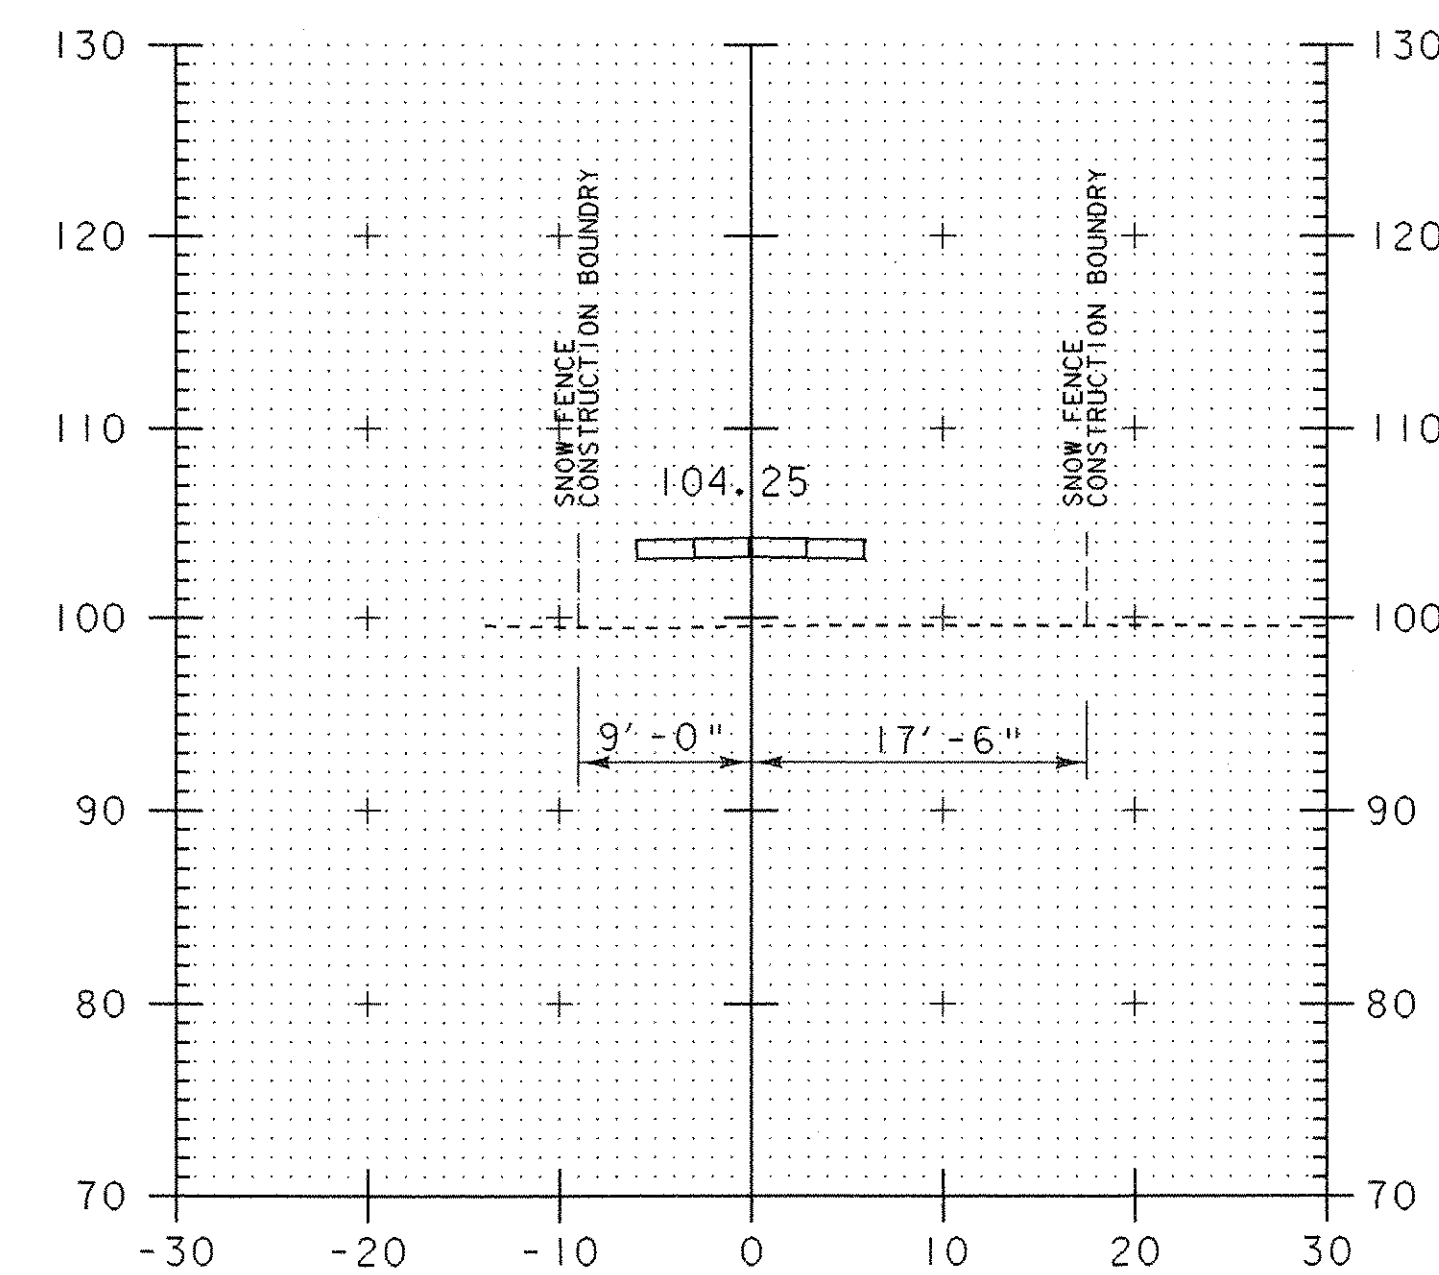

20+75

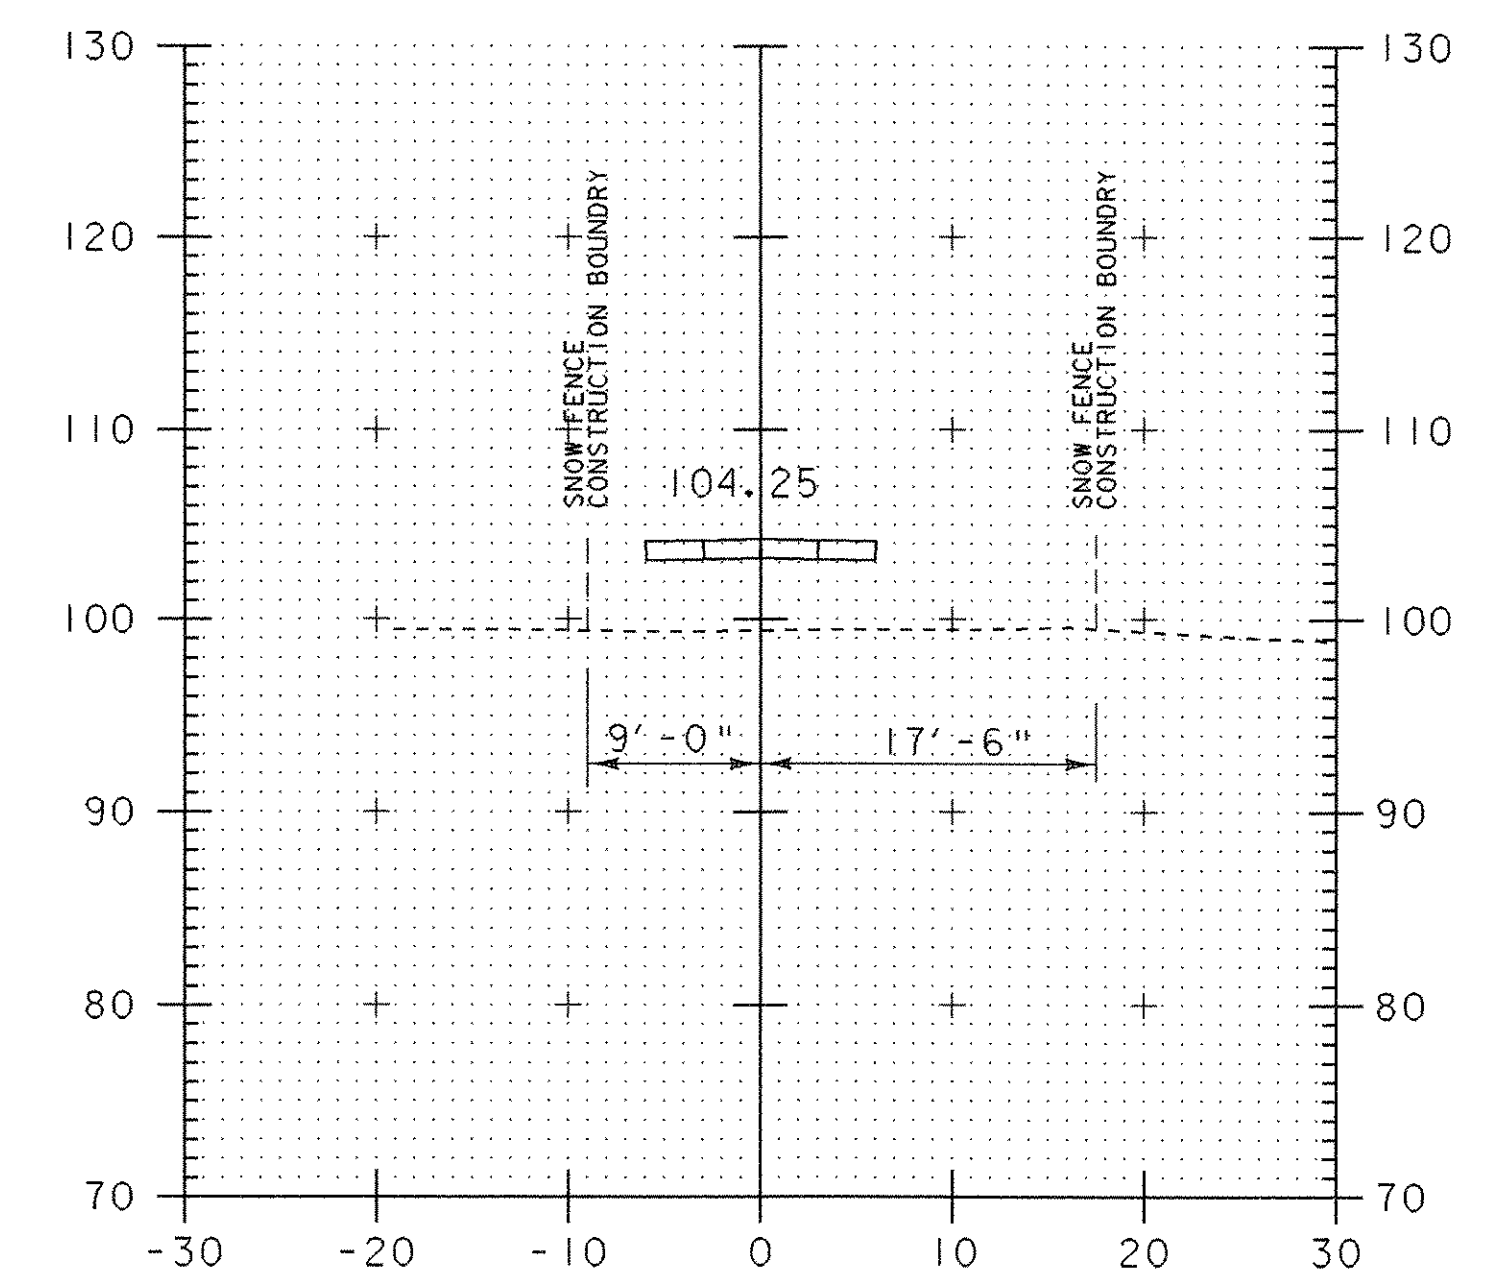

21+25

CROSS SECTIONS 19+75 - 21+50

PROJECT NAME:	Colchester
PROJECT NUMBER:	STP Bike(48)
FILE NAME: str5/03f038/sf038xsl.dgn	PLOT DATE: 05-AUG-2003
PROJECT LEADER: C. Keller	DRAWN BY: G. Shangraw
DESIGNED BY: G. Shangraw	CHECKED BY:
sf038xsl.i	SHEET 80 OF 87