




22+00

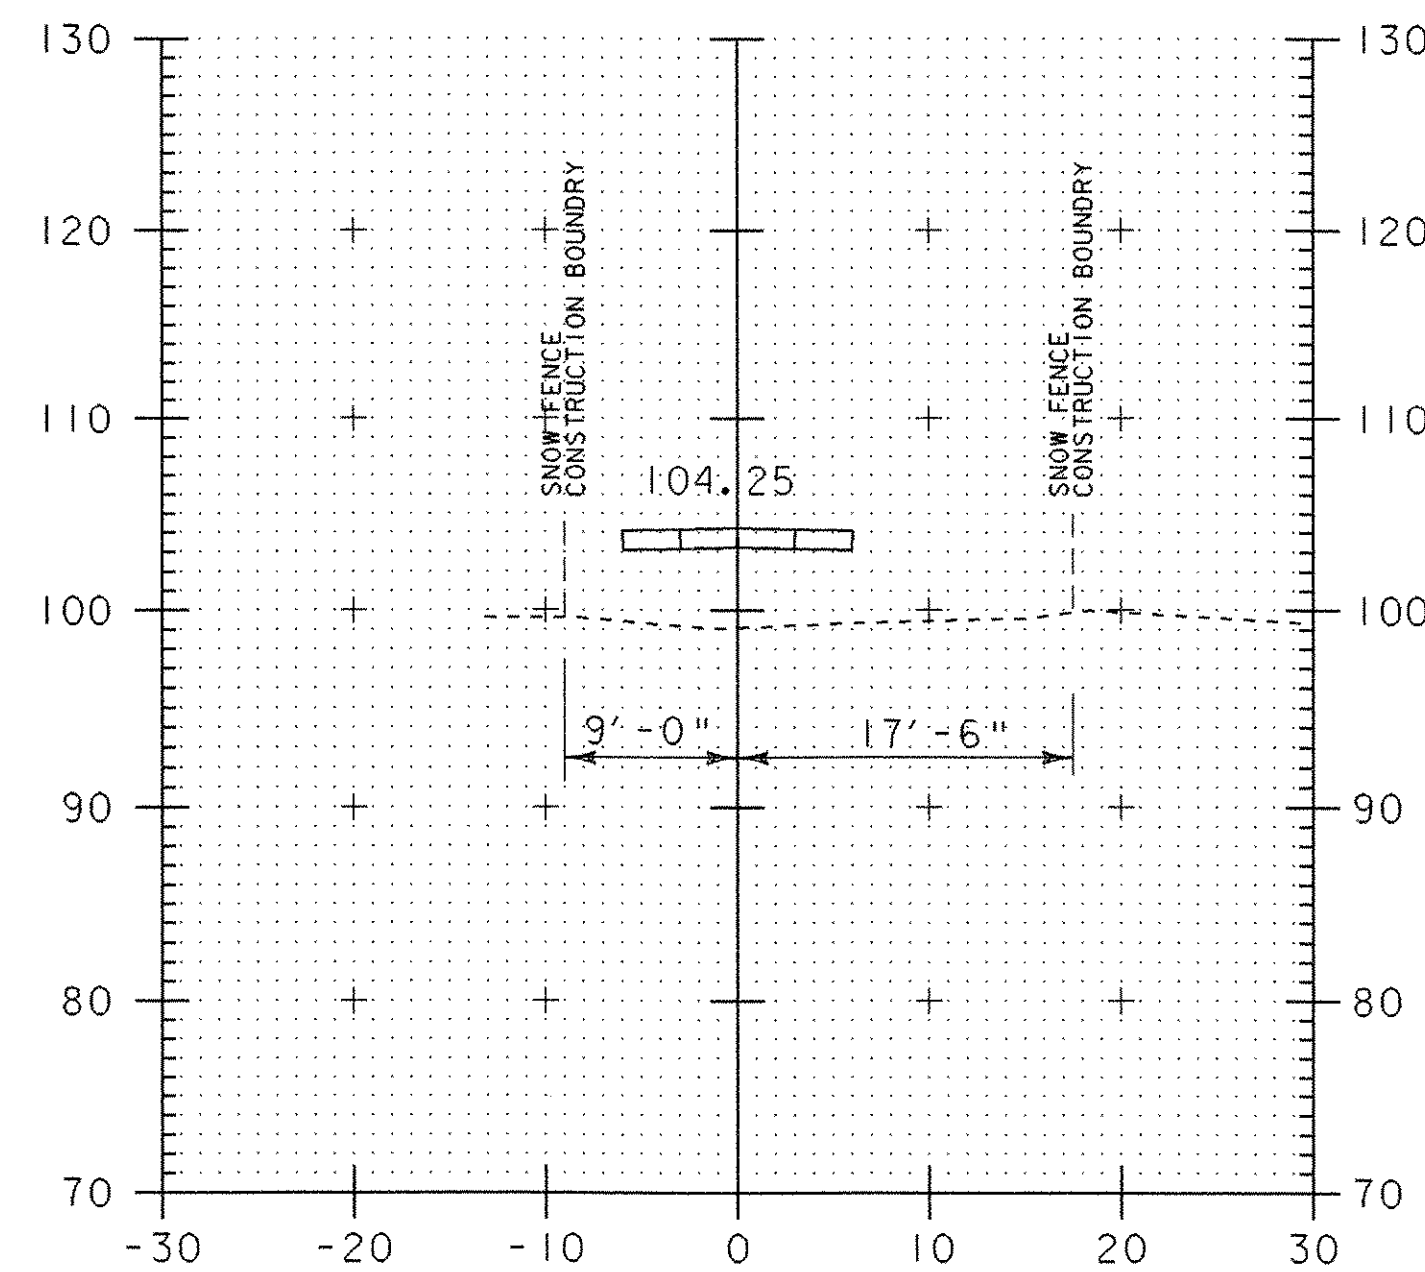


22+50

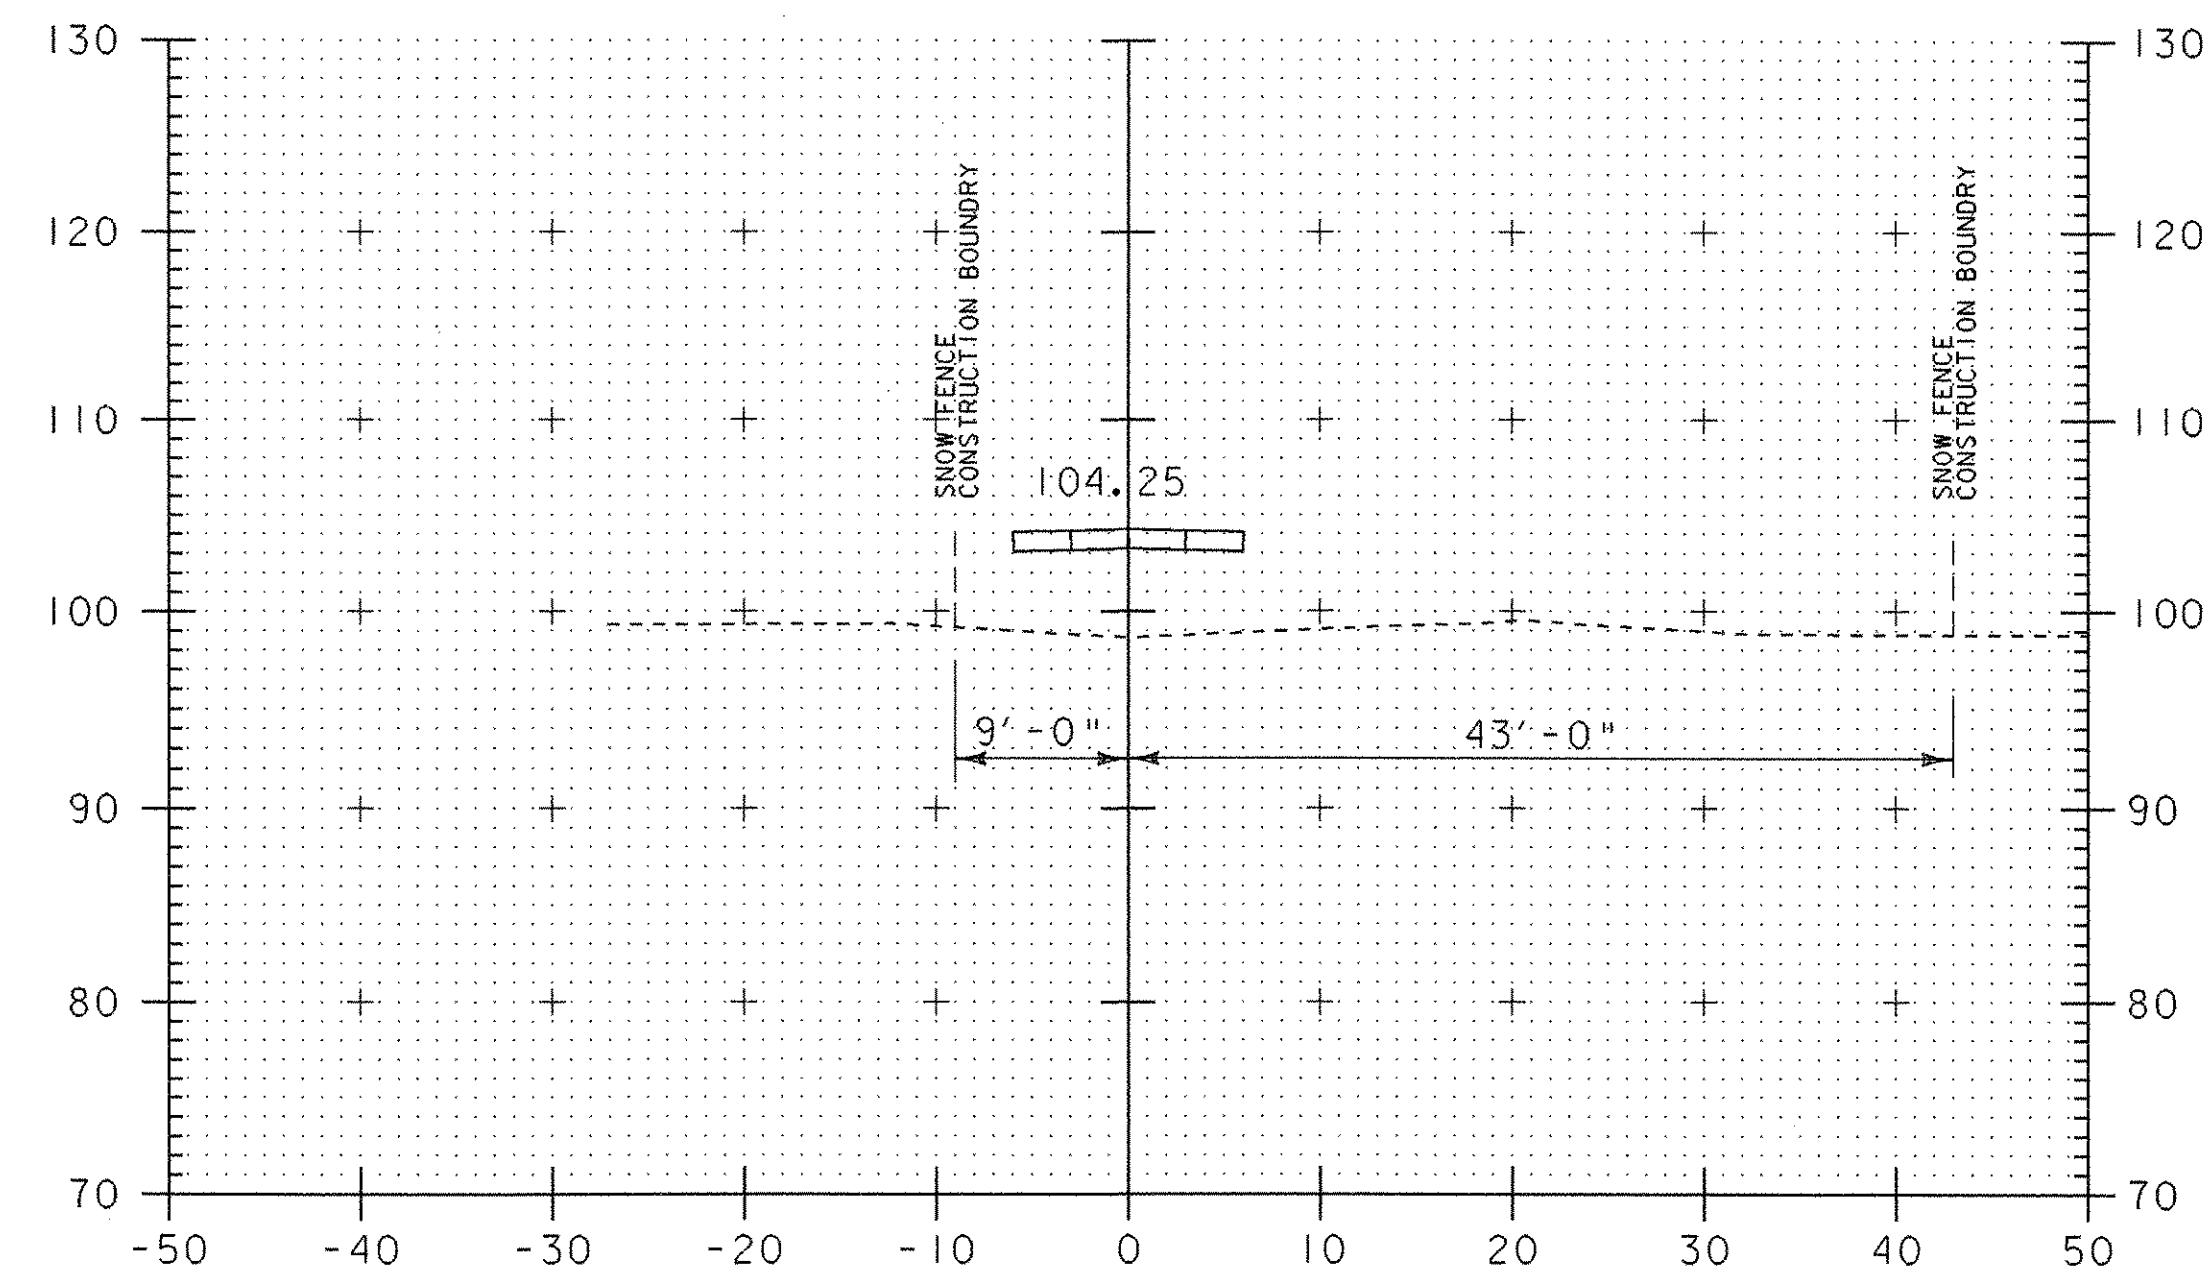


23+00

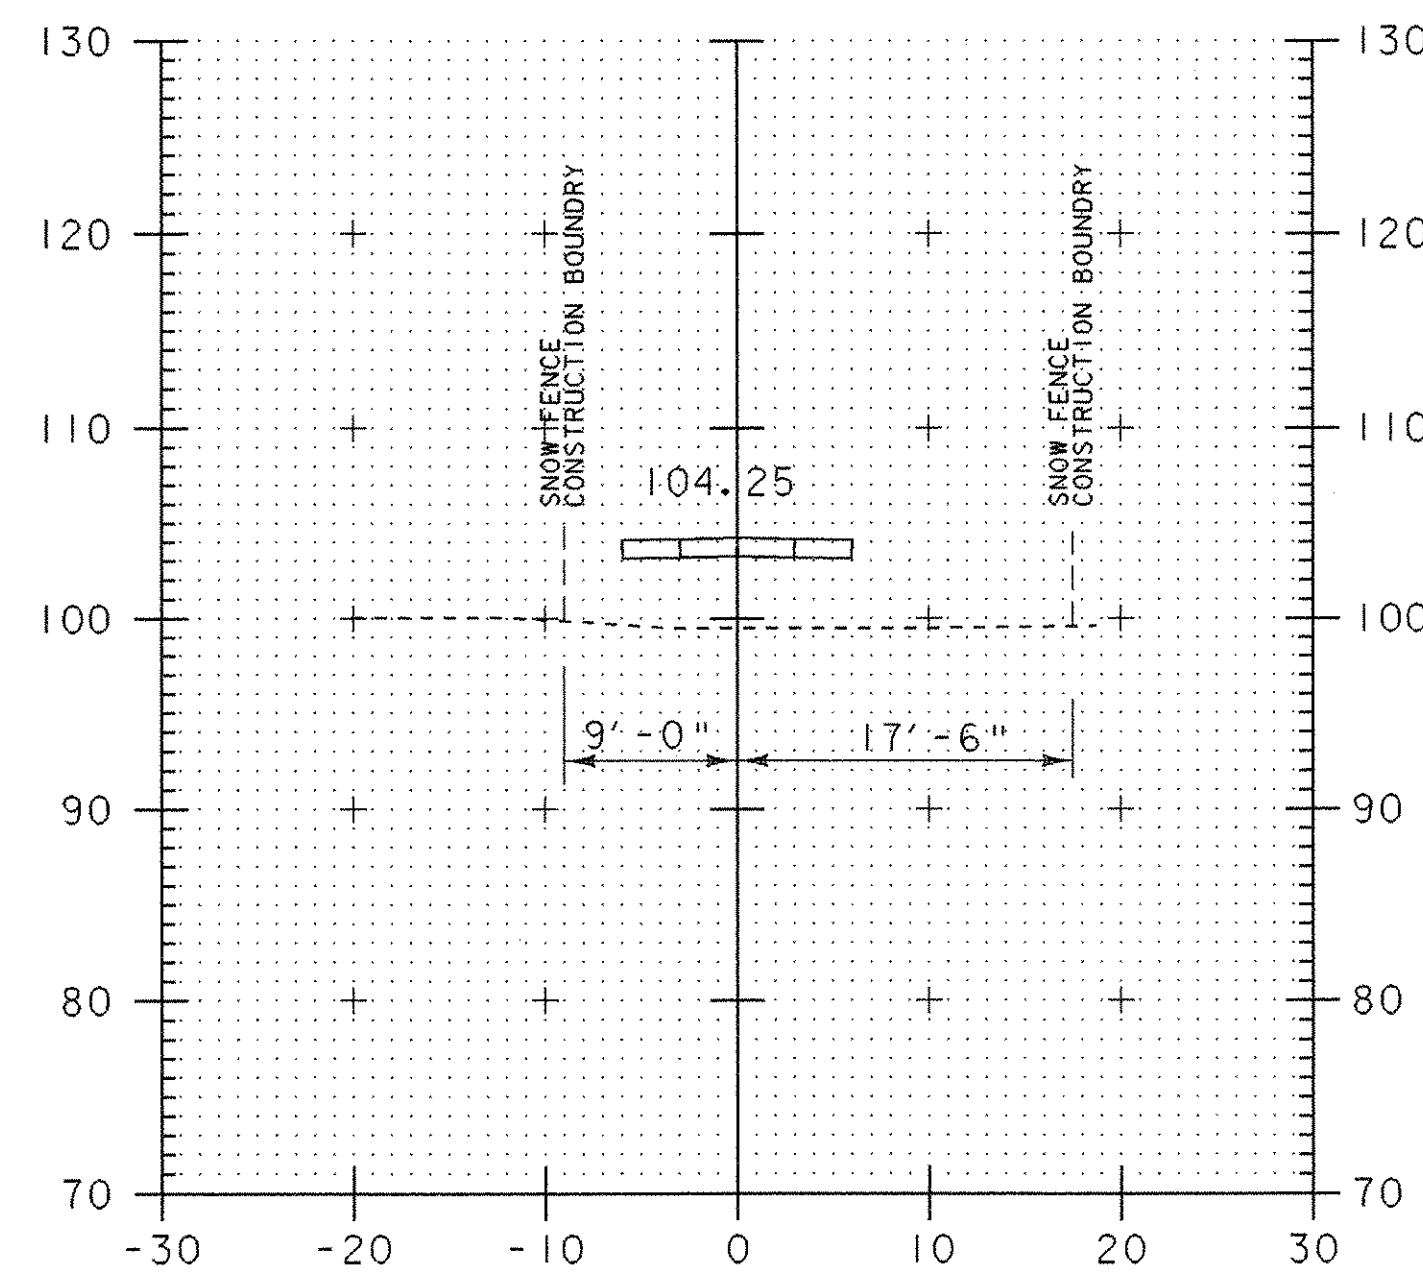

21+75

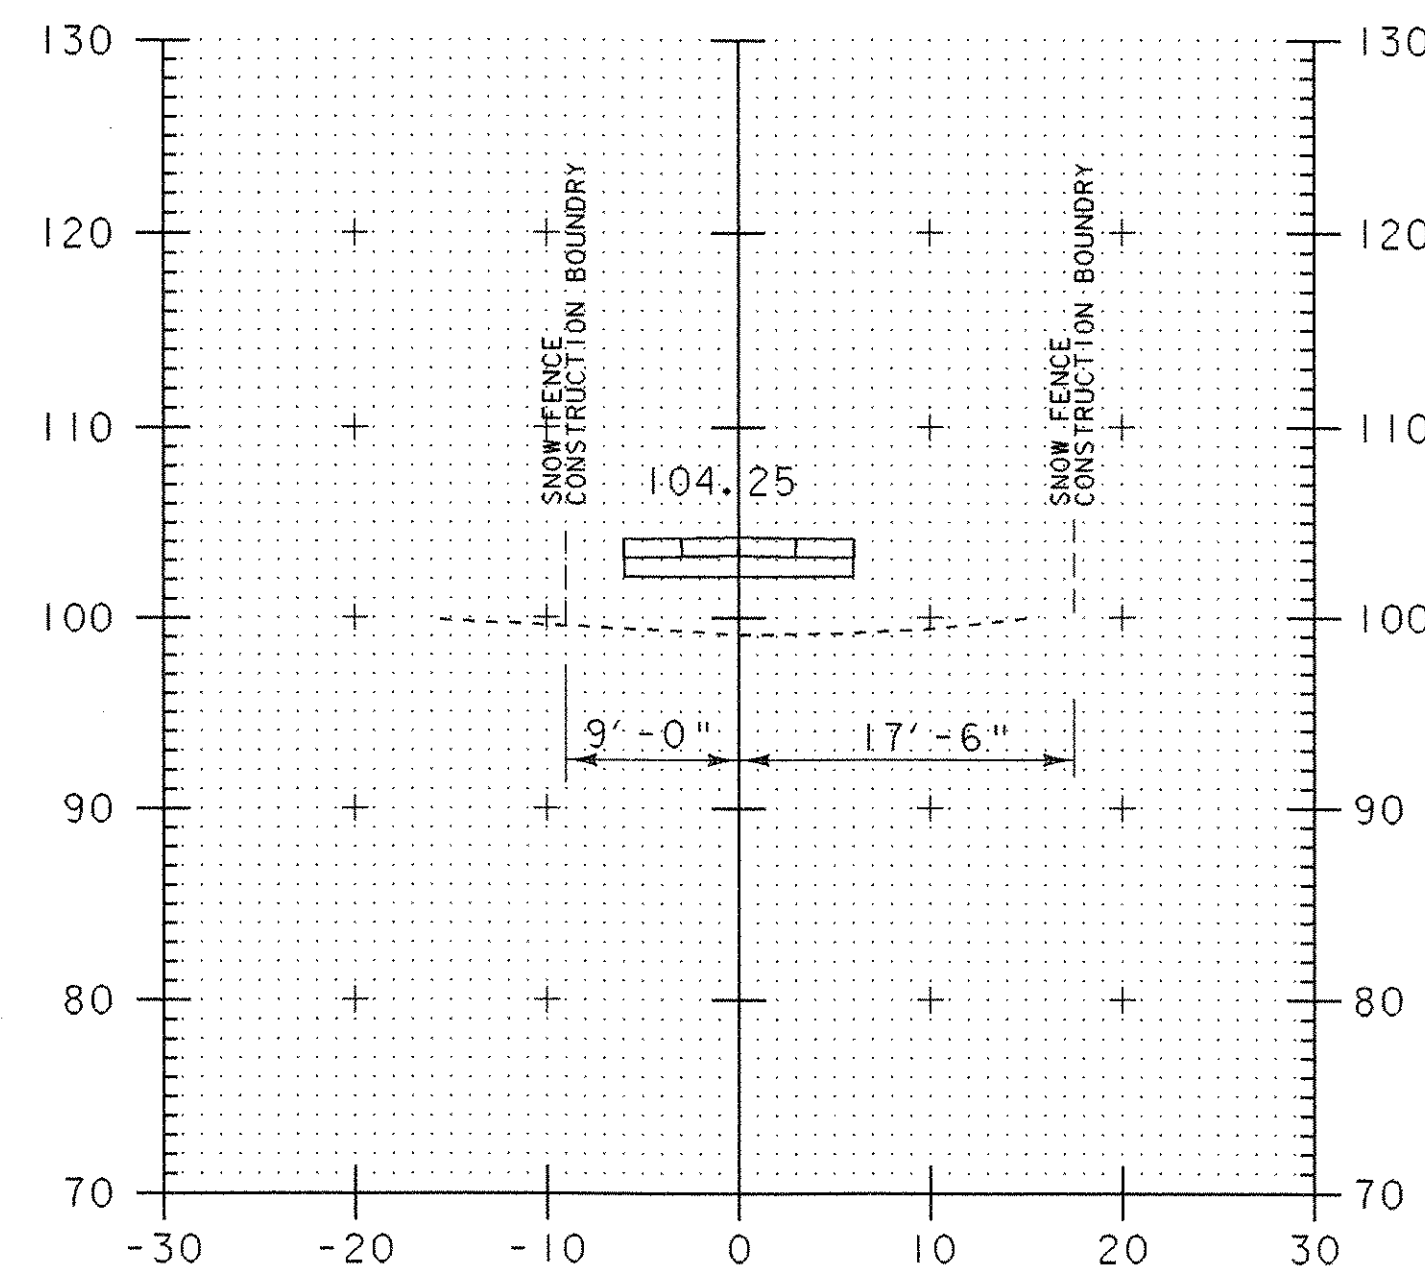

22+25

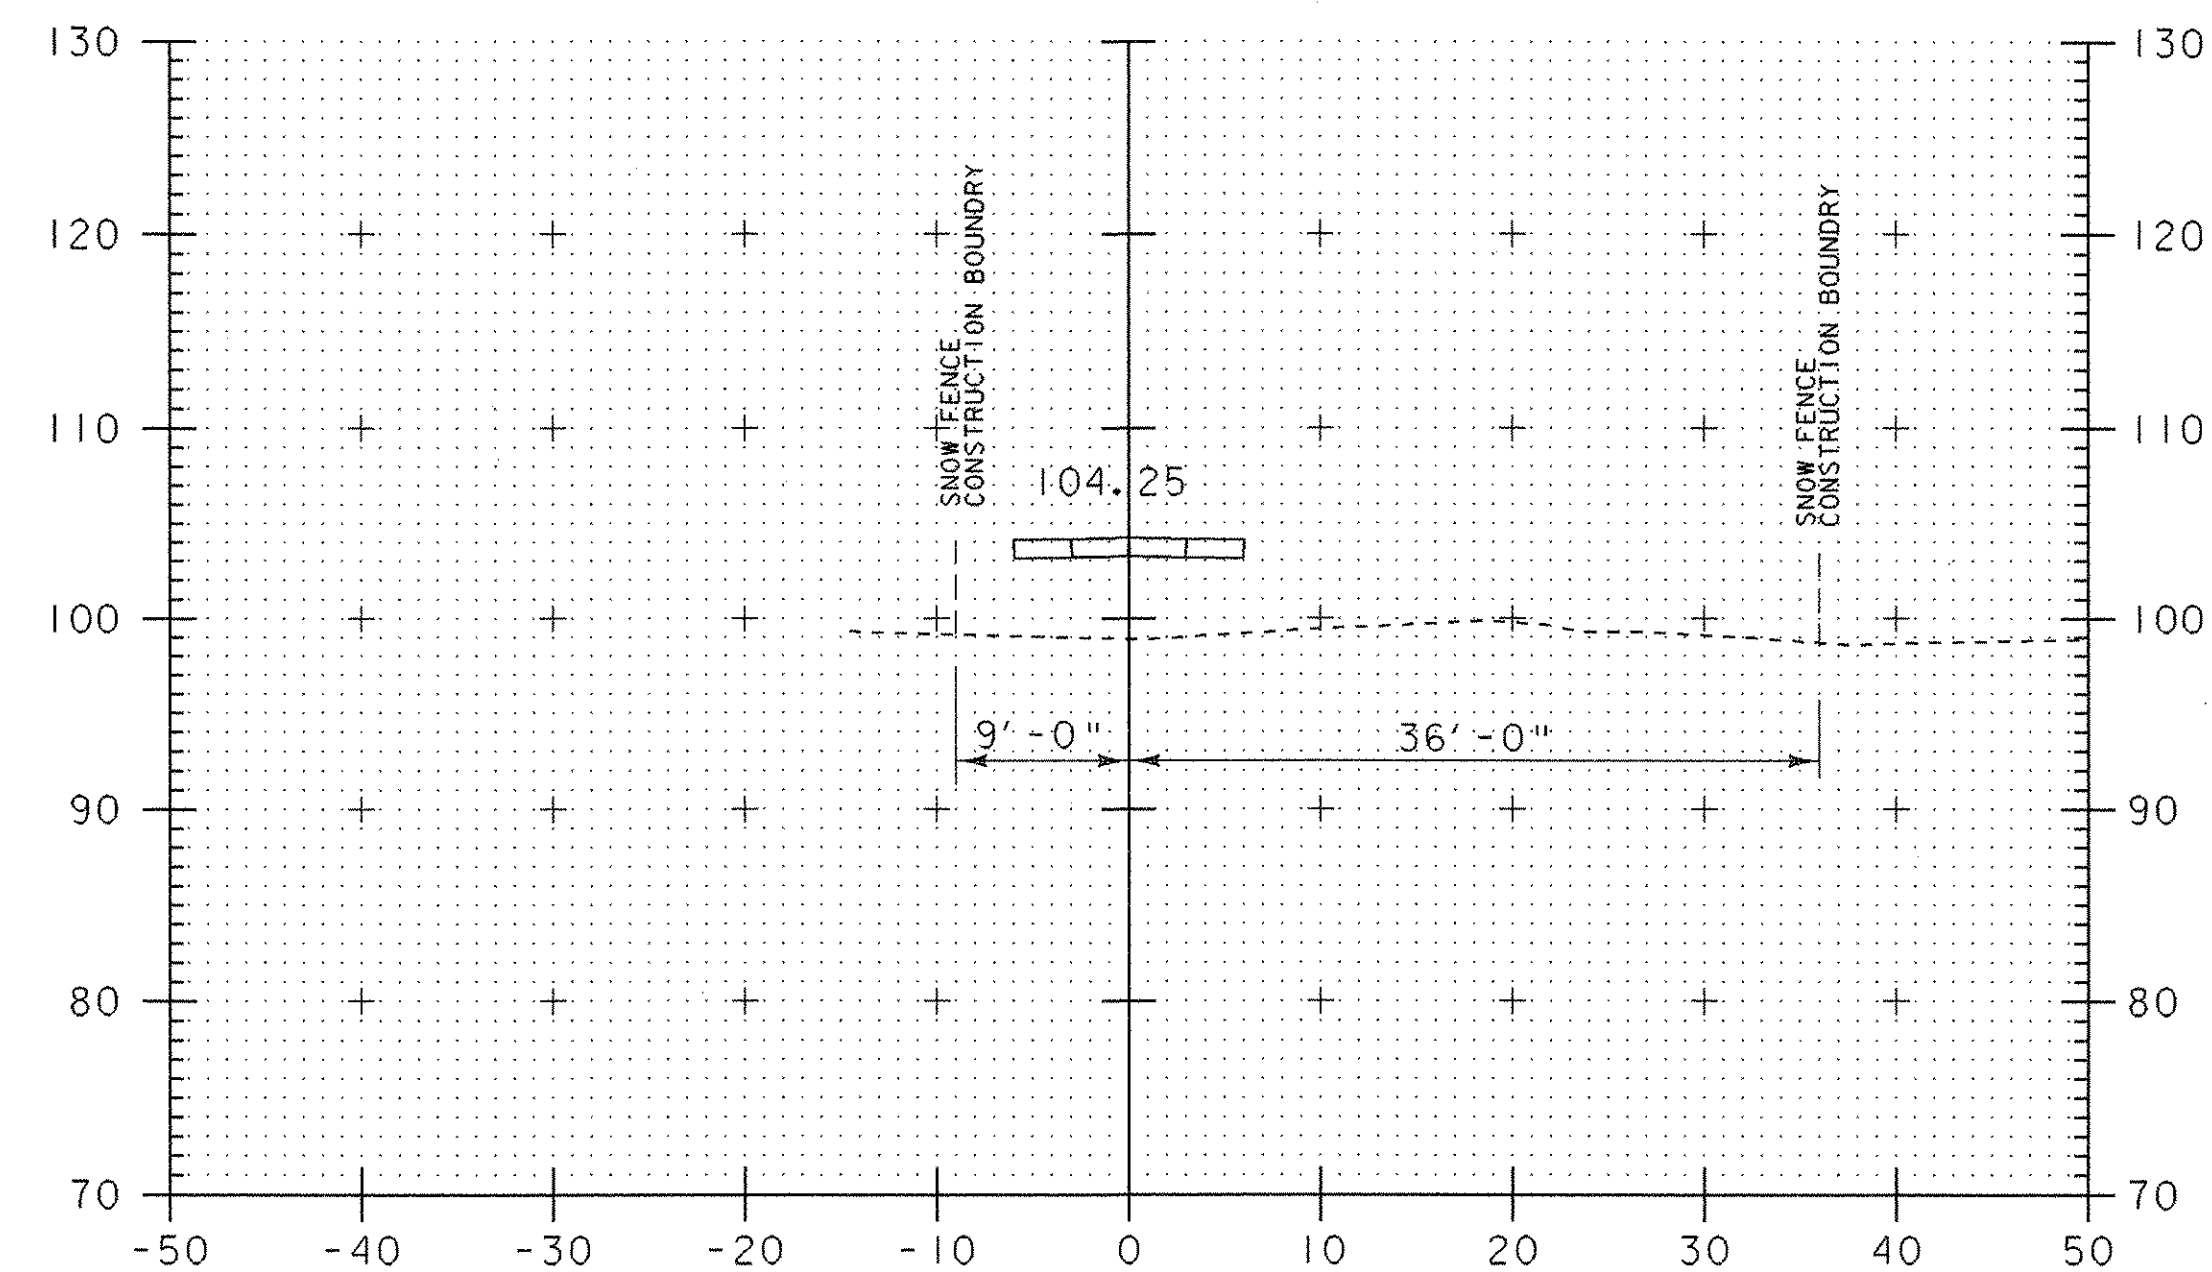

22+75

CROSS SECTIONS 21+75 - 23+00

PROJECT NAME:	Colchester
PROJECT NUMBER:	STP Bike(48)
FILE NAME:\str5\03f038\s038xsl.dgn	PLOT DATE: 03-SEP-2003
PROJECT LEADER: C. Keller	DRAWN BY: G. Shangraw
DESIGNED BY: G. Shangraw	CHECKED BY:
sf038xsl2.i	SHEET 81 OF 87