




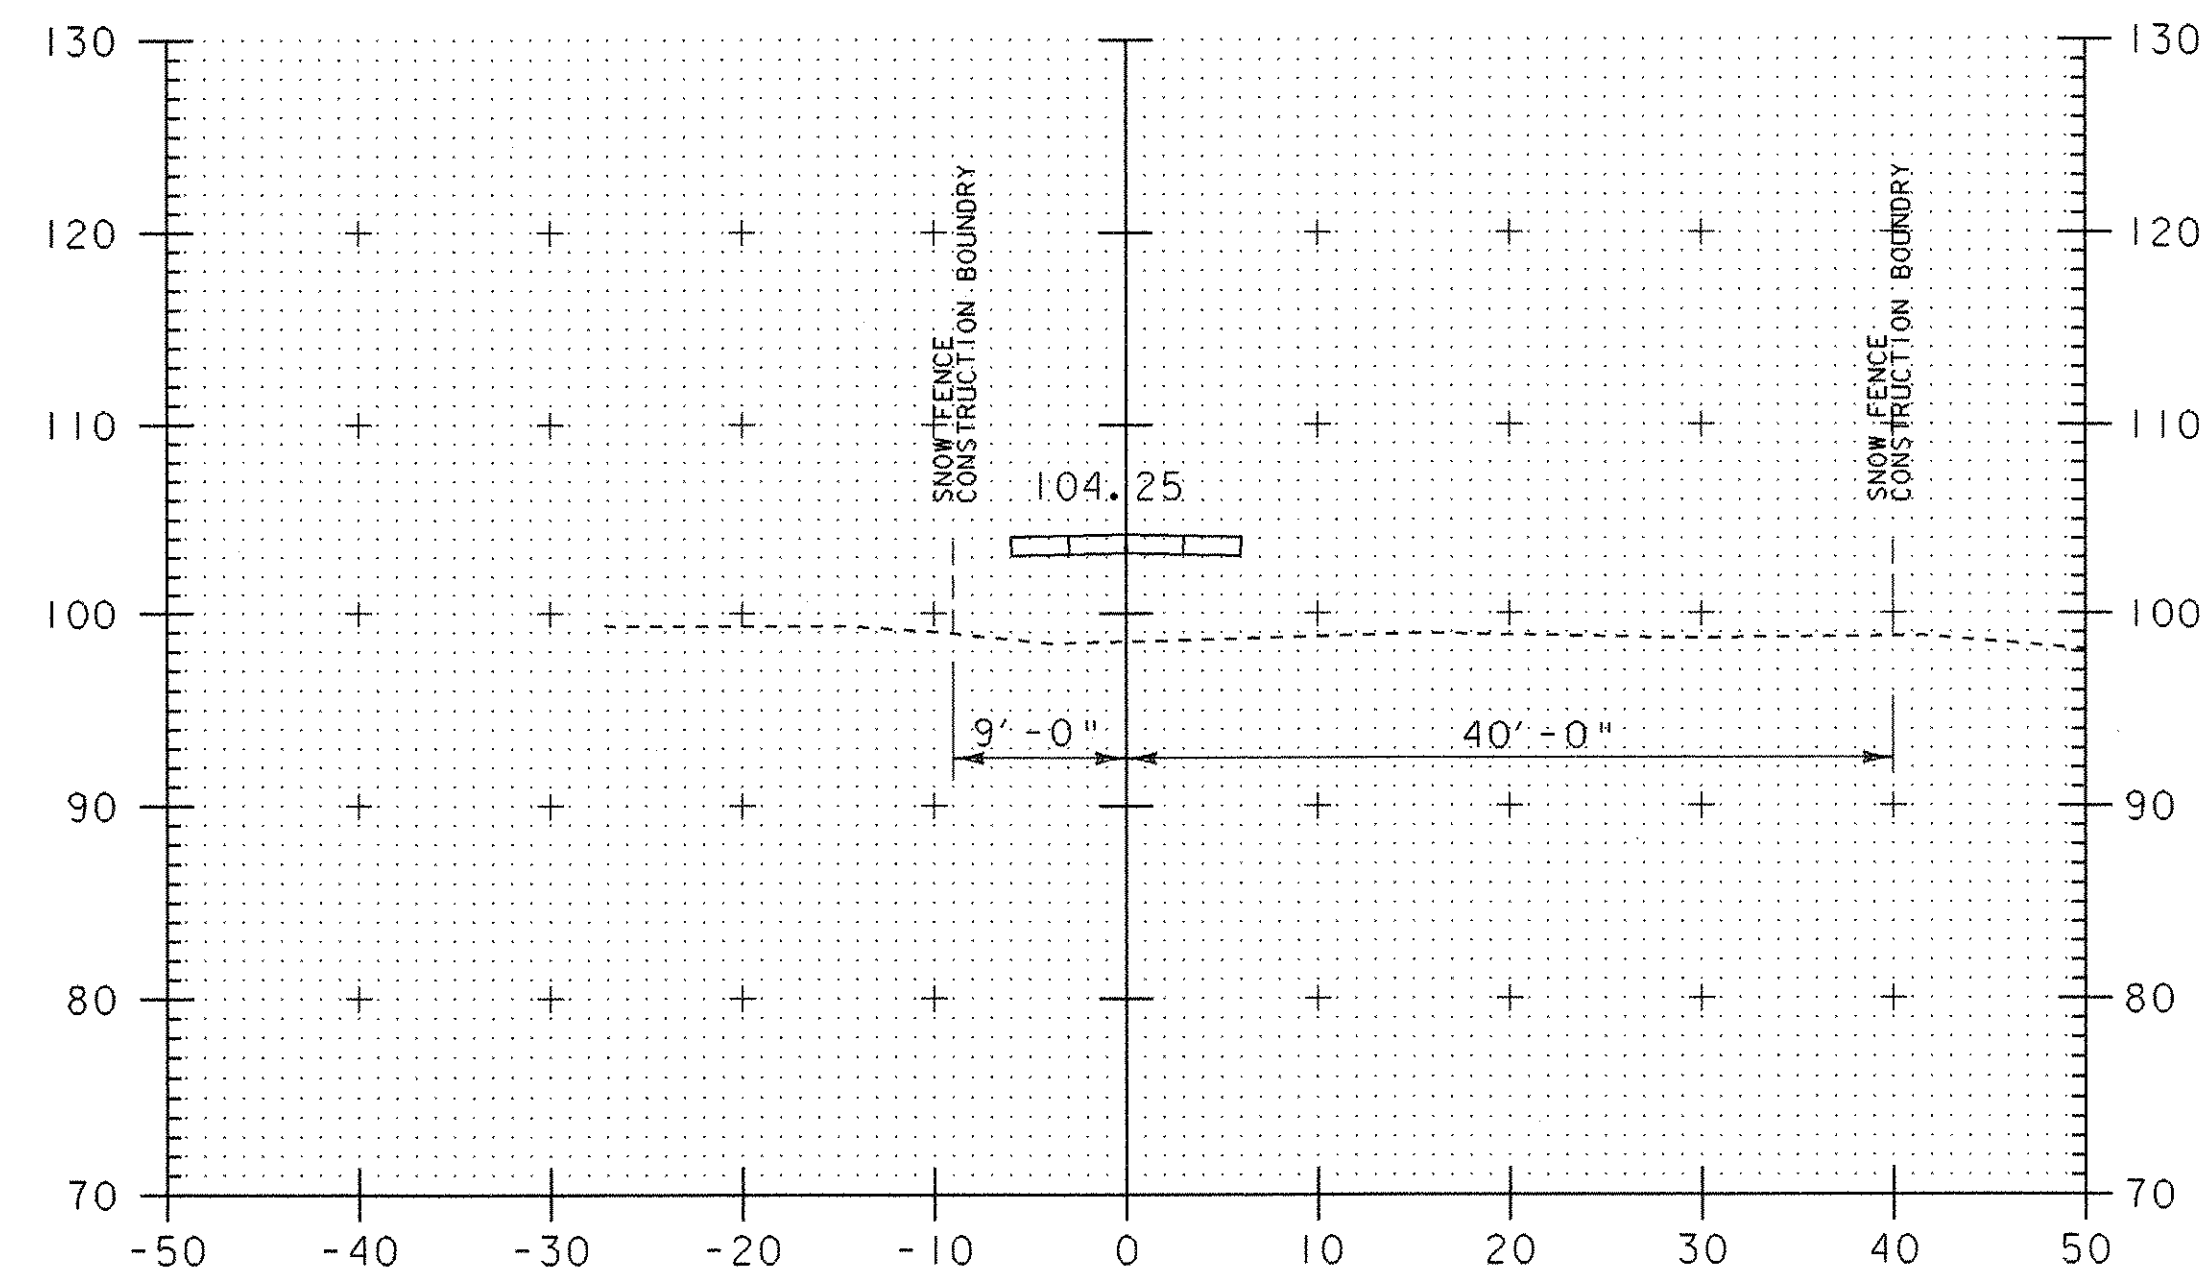


23+50

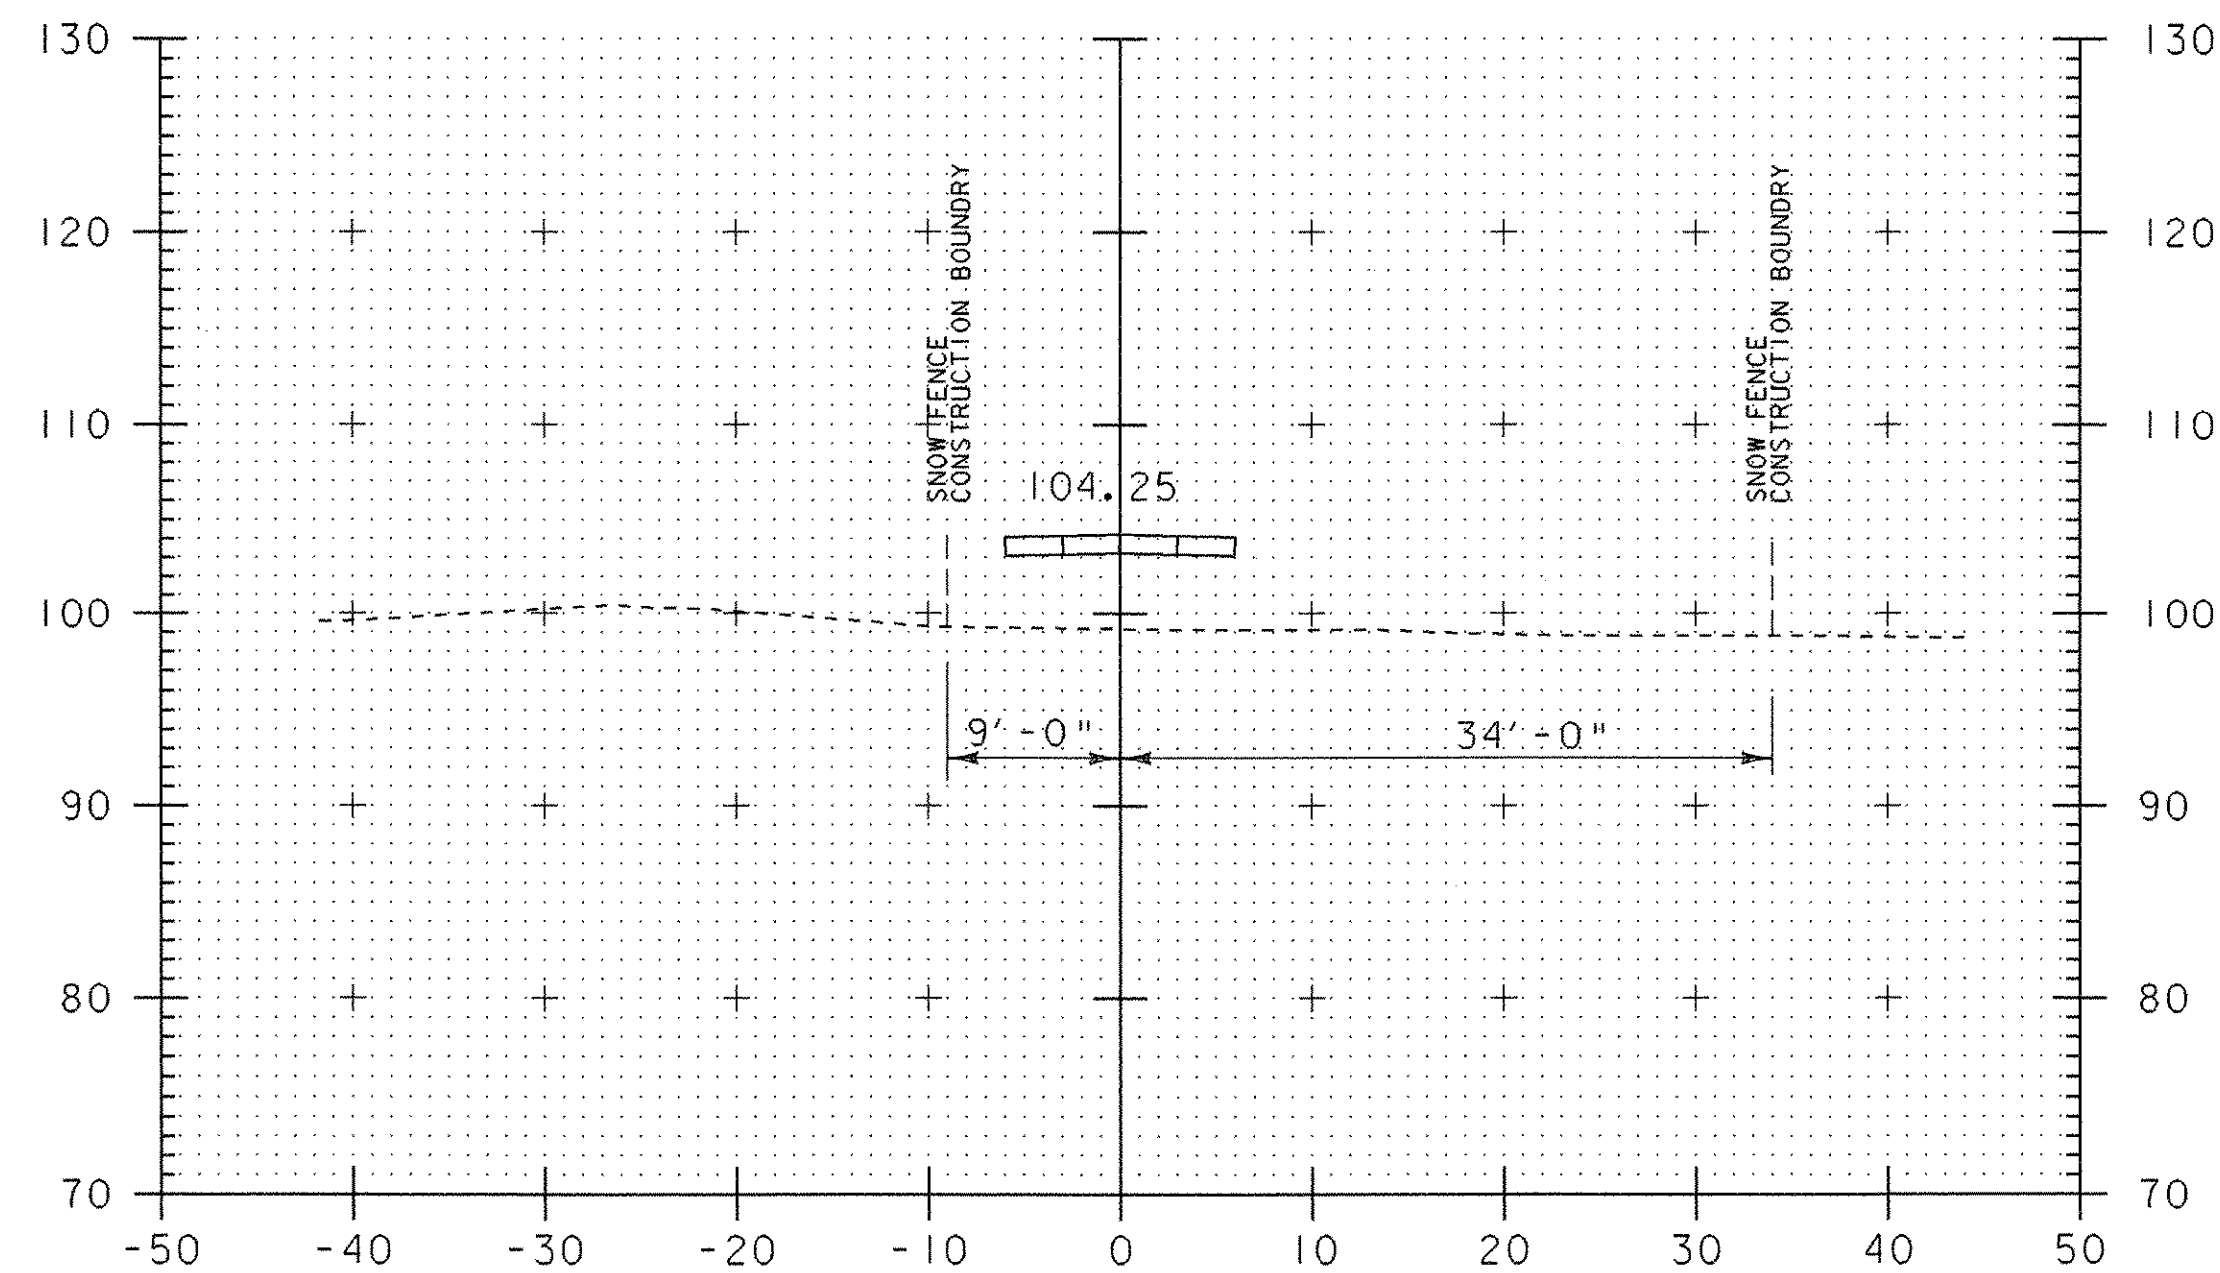

24+00

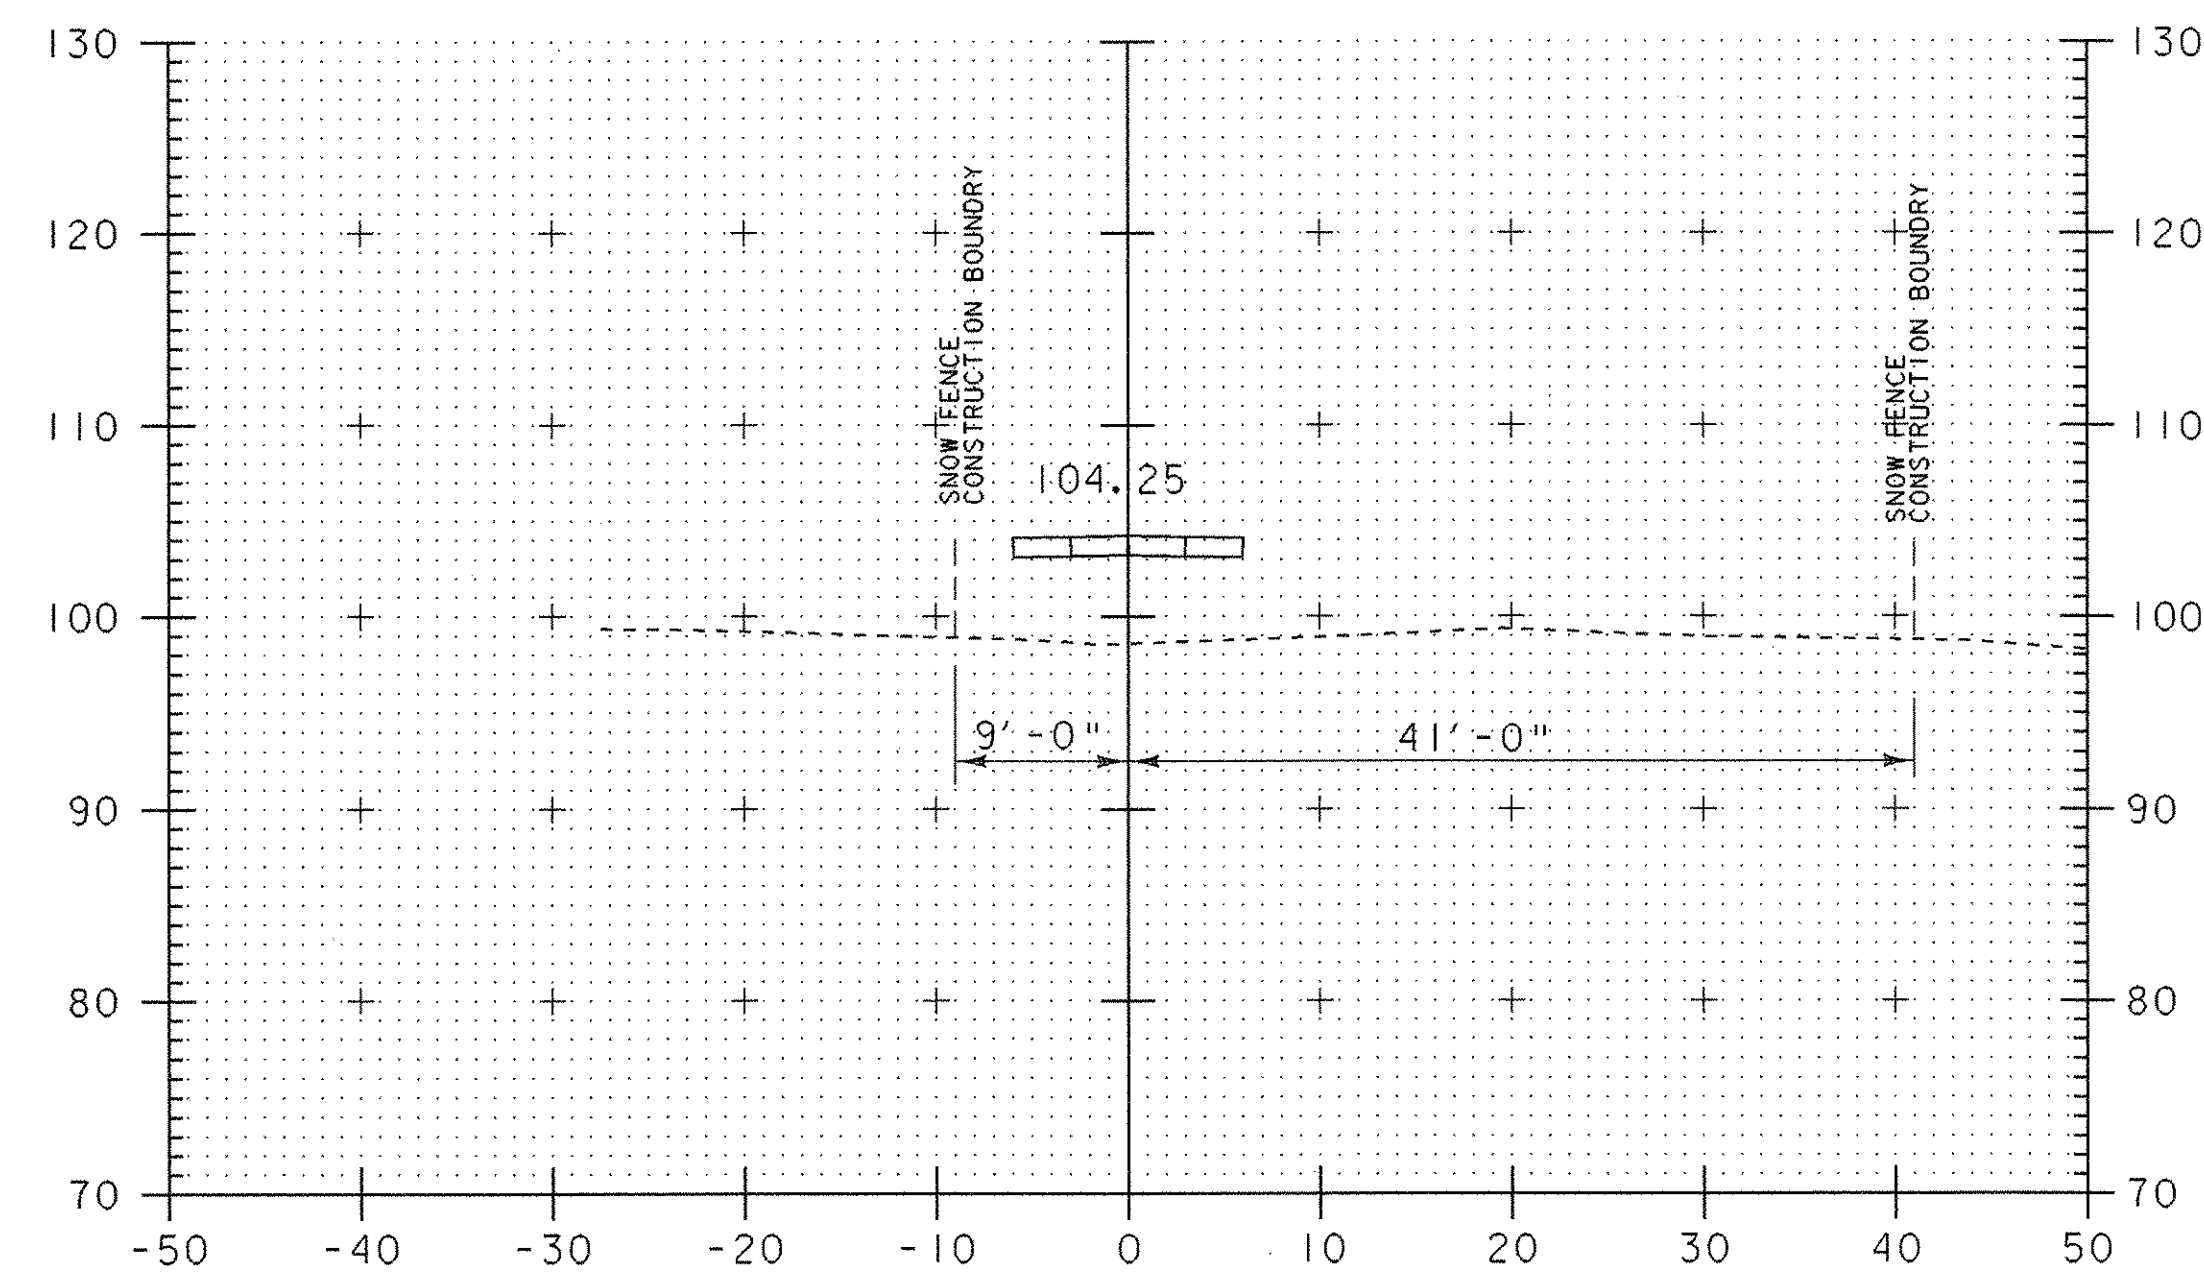

23+25

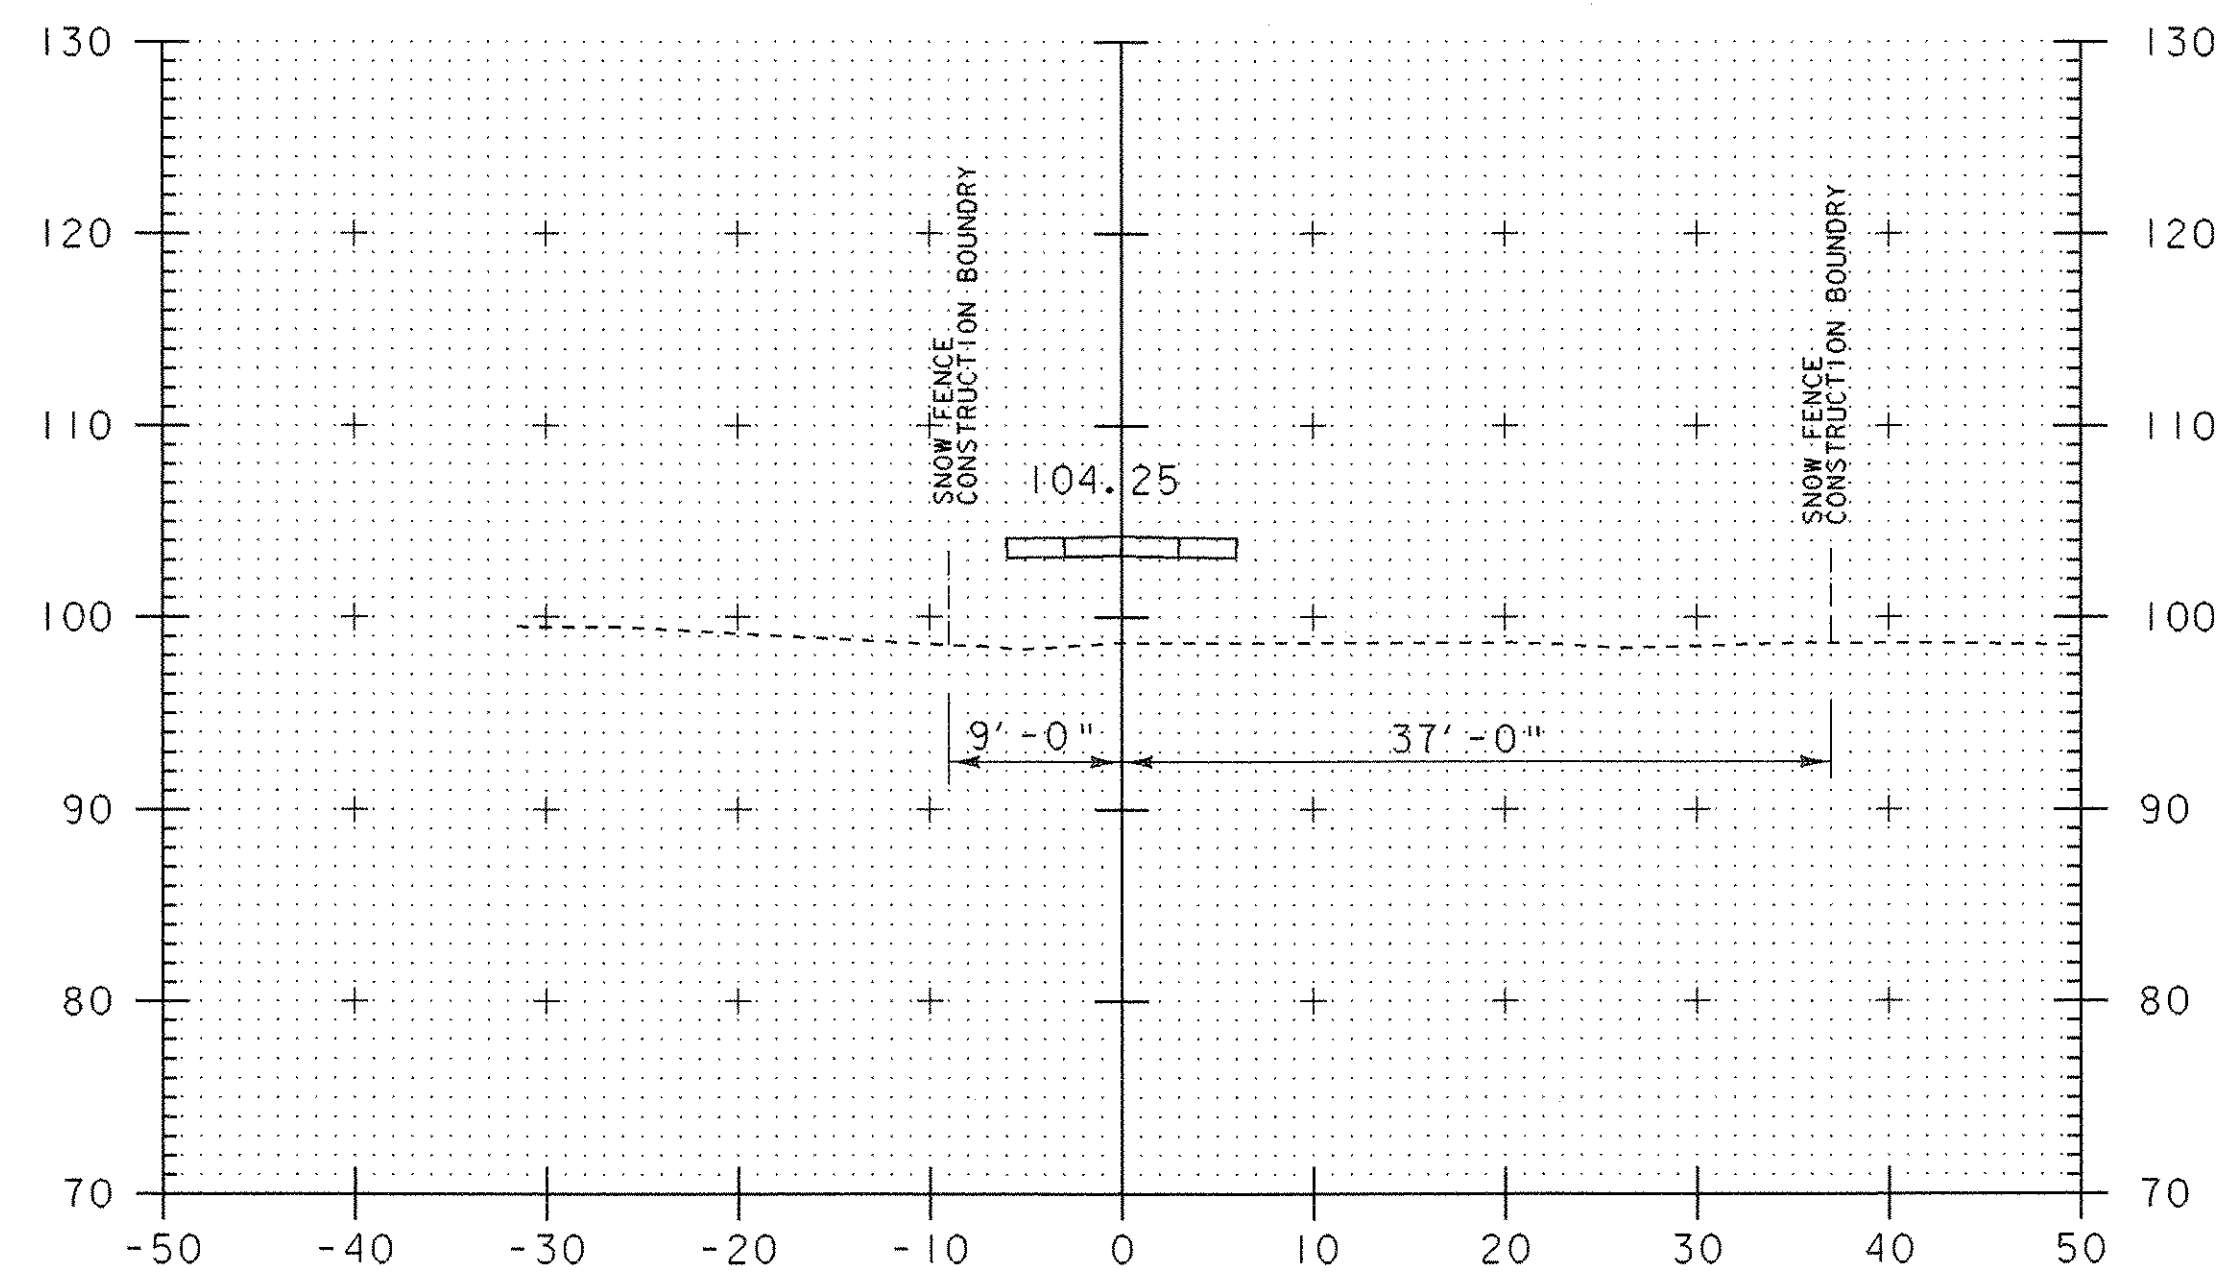

23+75

CROSS SECTIONS 23+25 - 24+00

PROJECT NAME: Colchester
PROJECT NUMBER: STP Bike(48)

FILE NAME: str5/03f038/sf038xsl.dgn PLOT DATE: 05-AUG-2003
PROJECT LEADER: C. Keller DRAWN BY: G. Shangraw
DESIGNED BY: G. Shangraw CHECKED BY:
sf038xsl3.1 SHEET 82 OF 87