




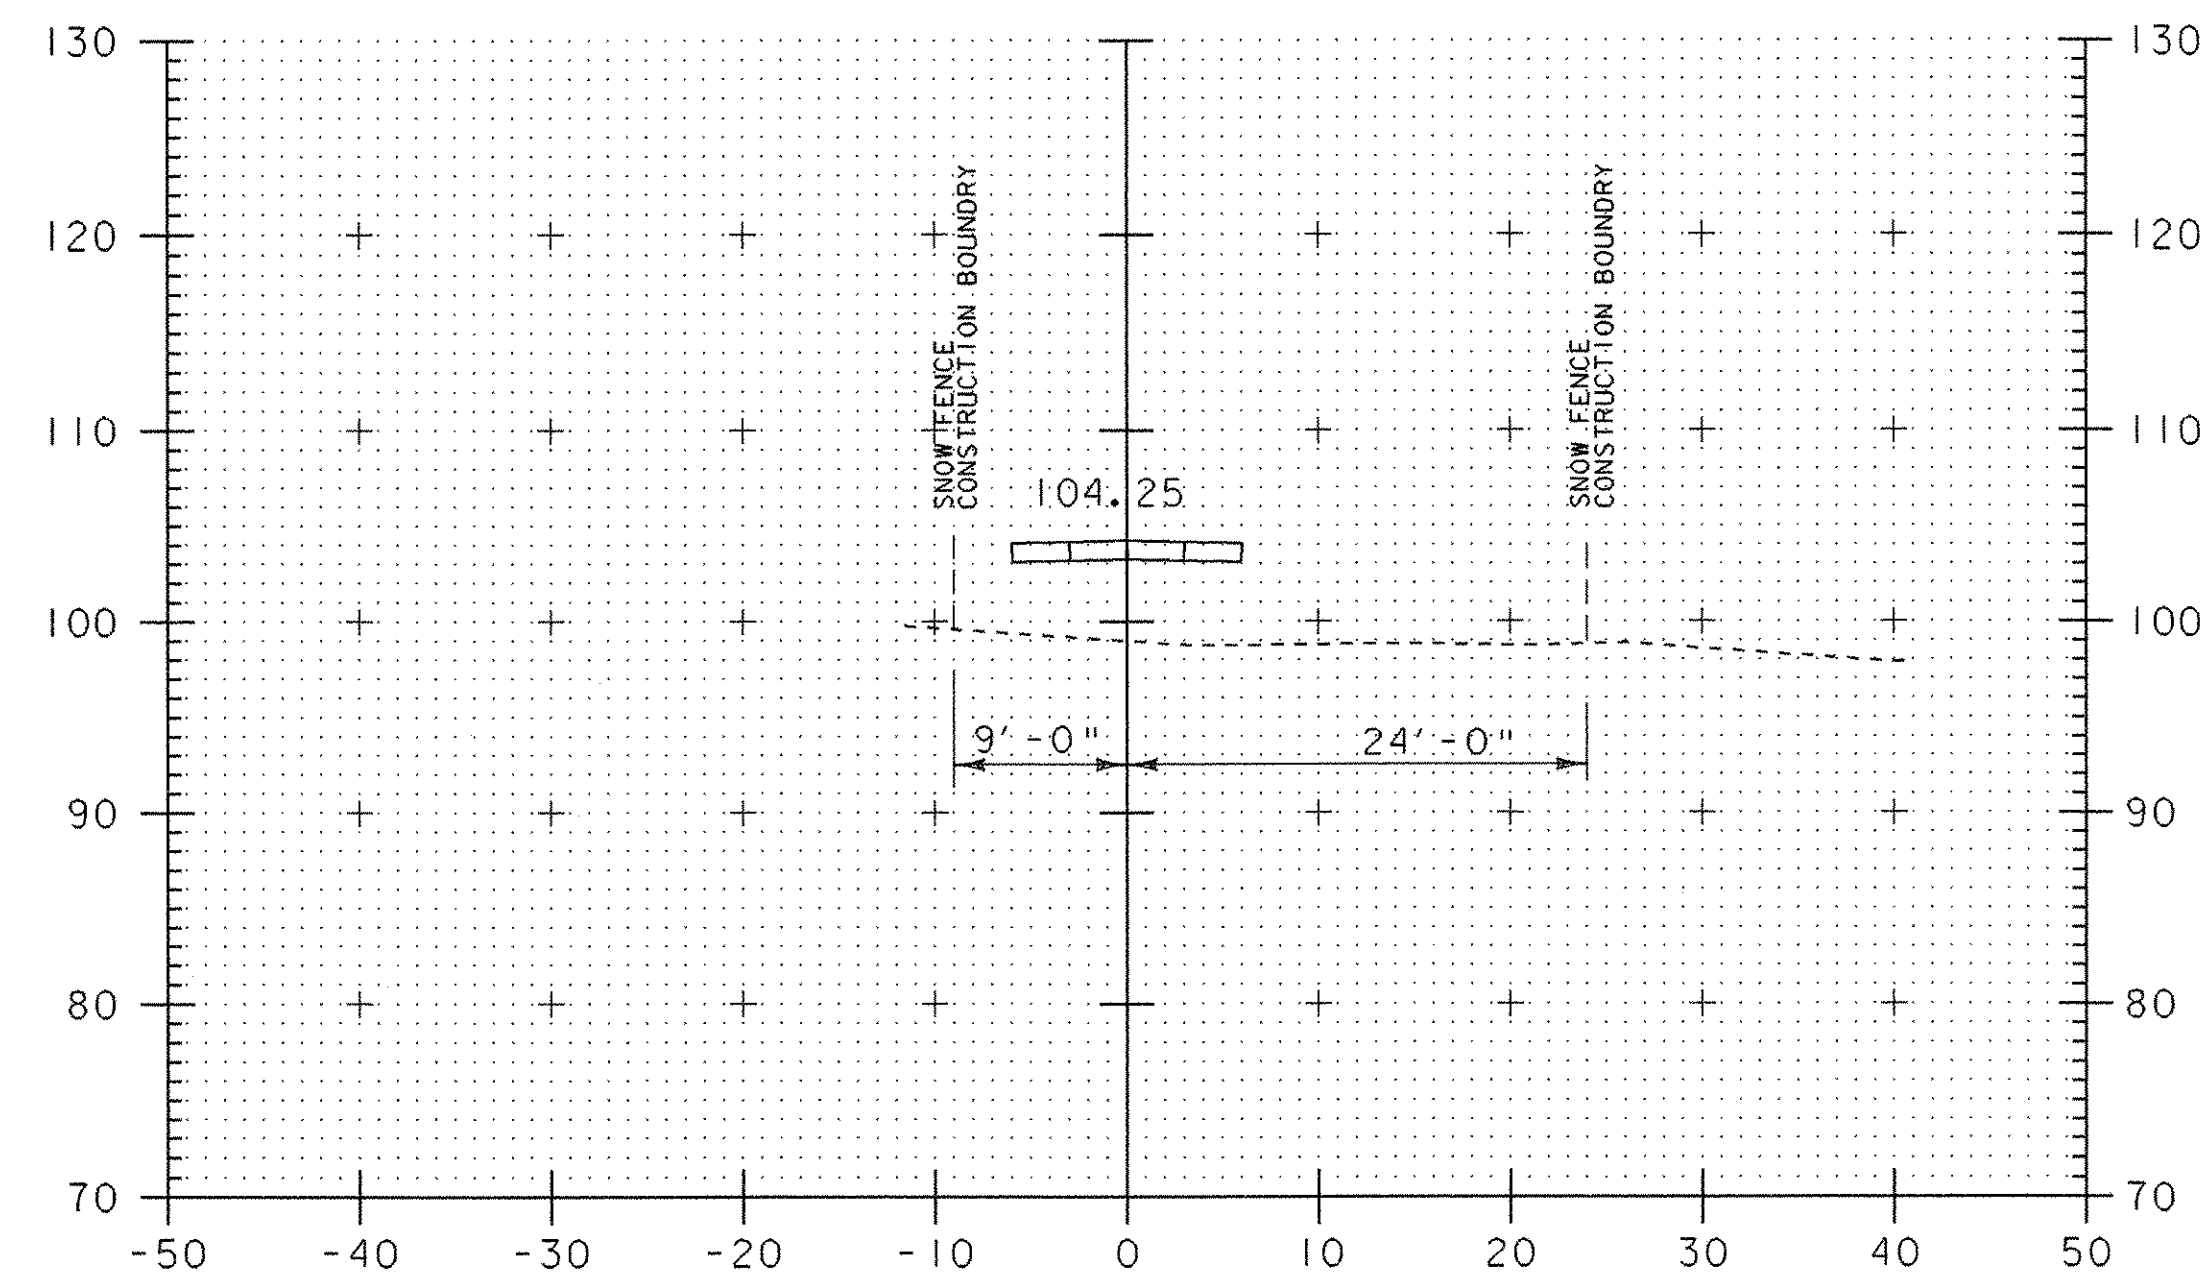


24+50

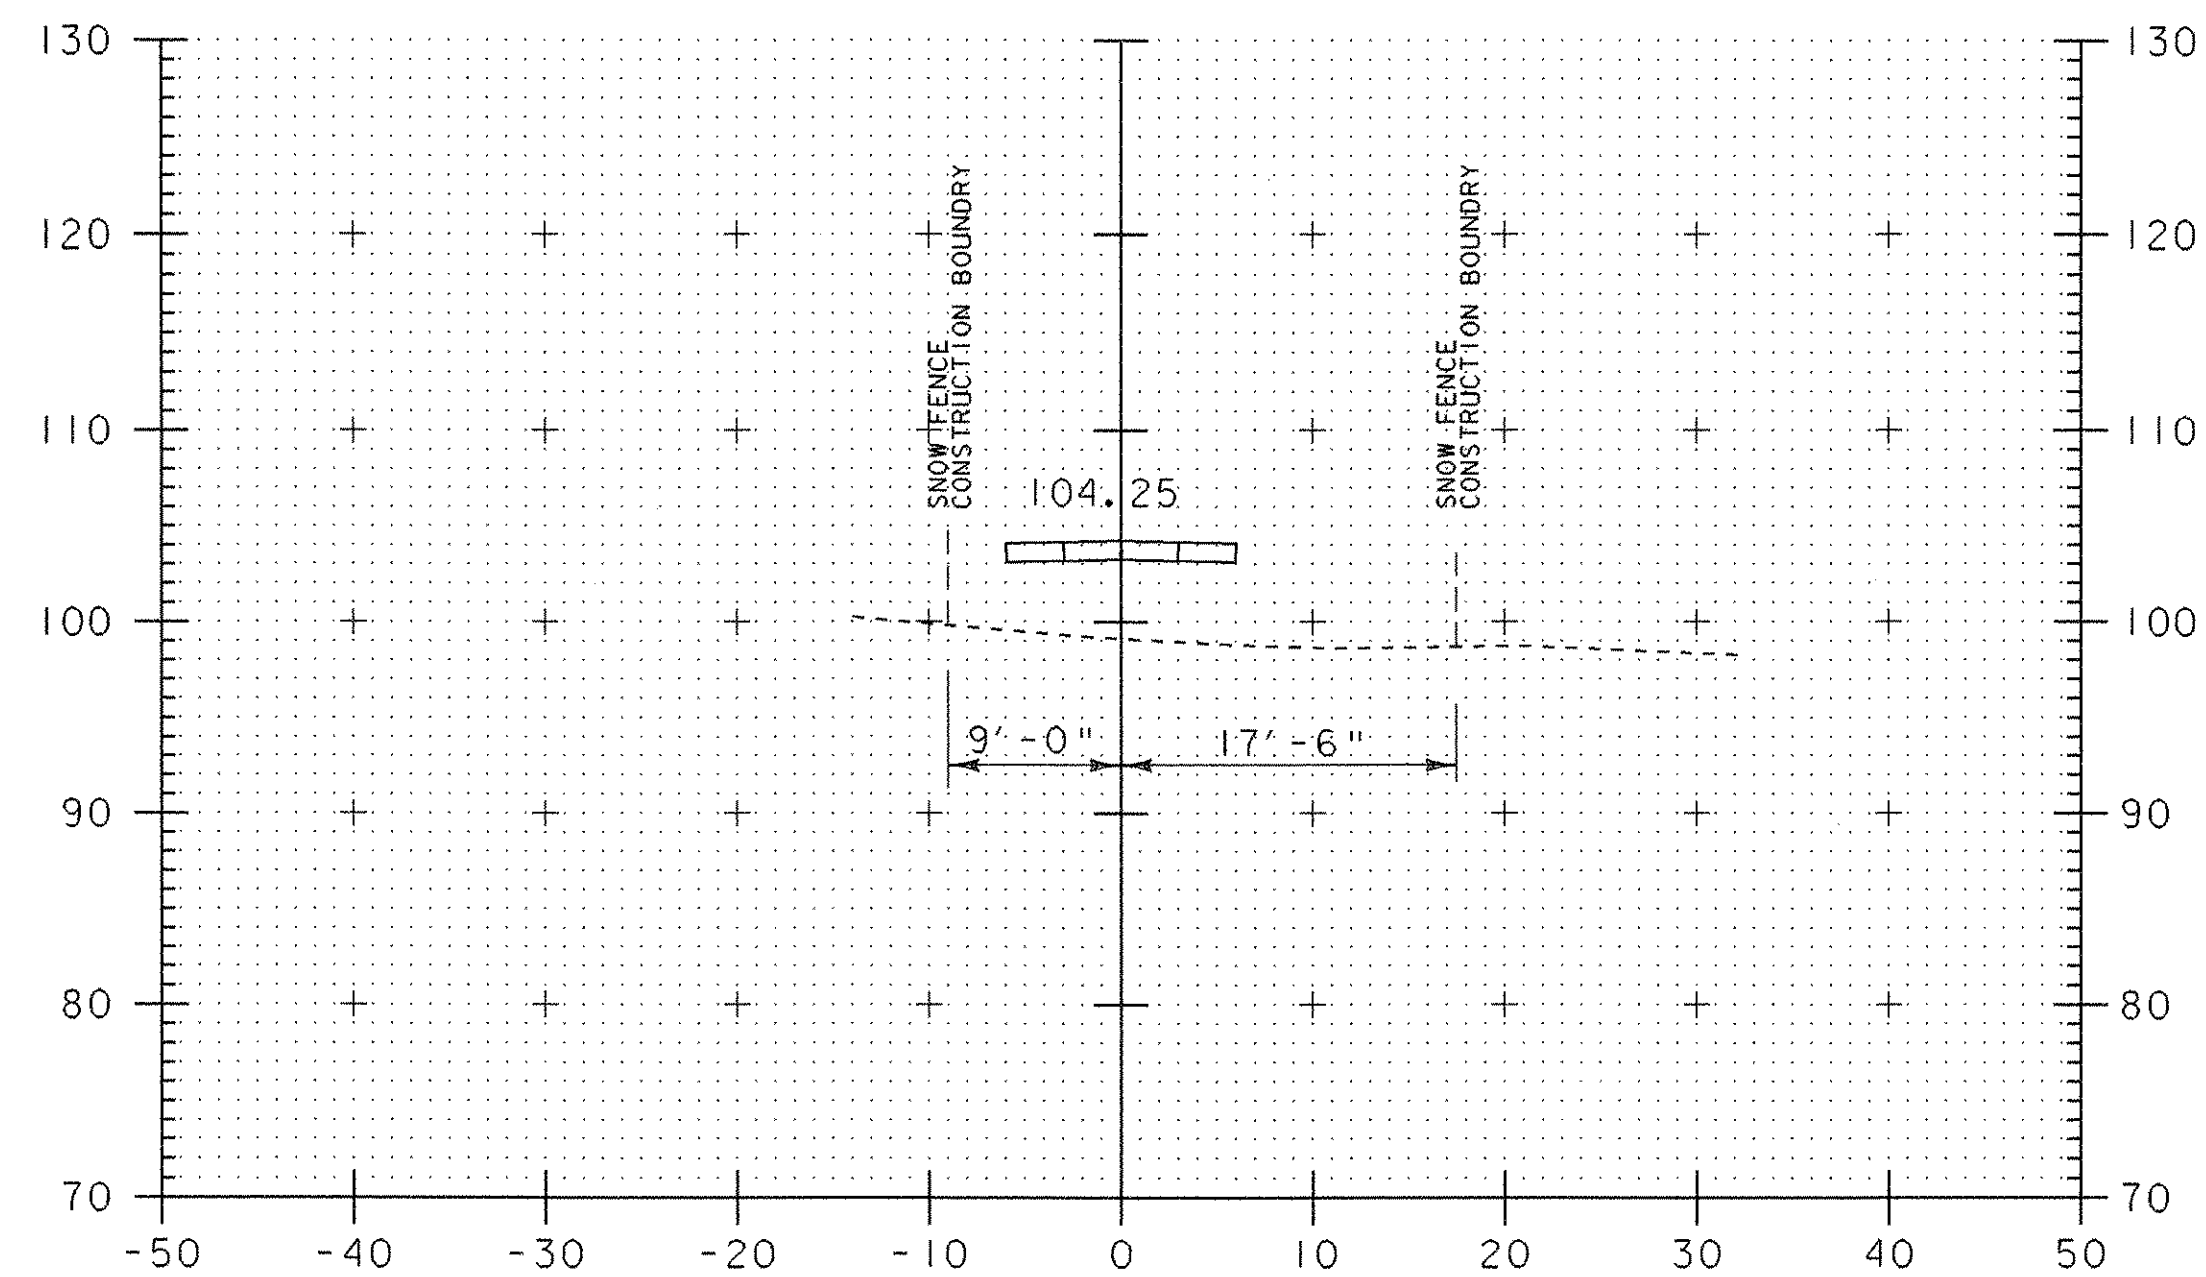


25+00

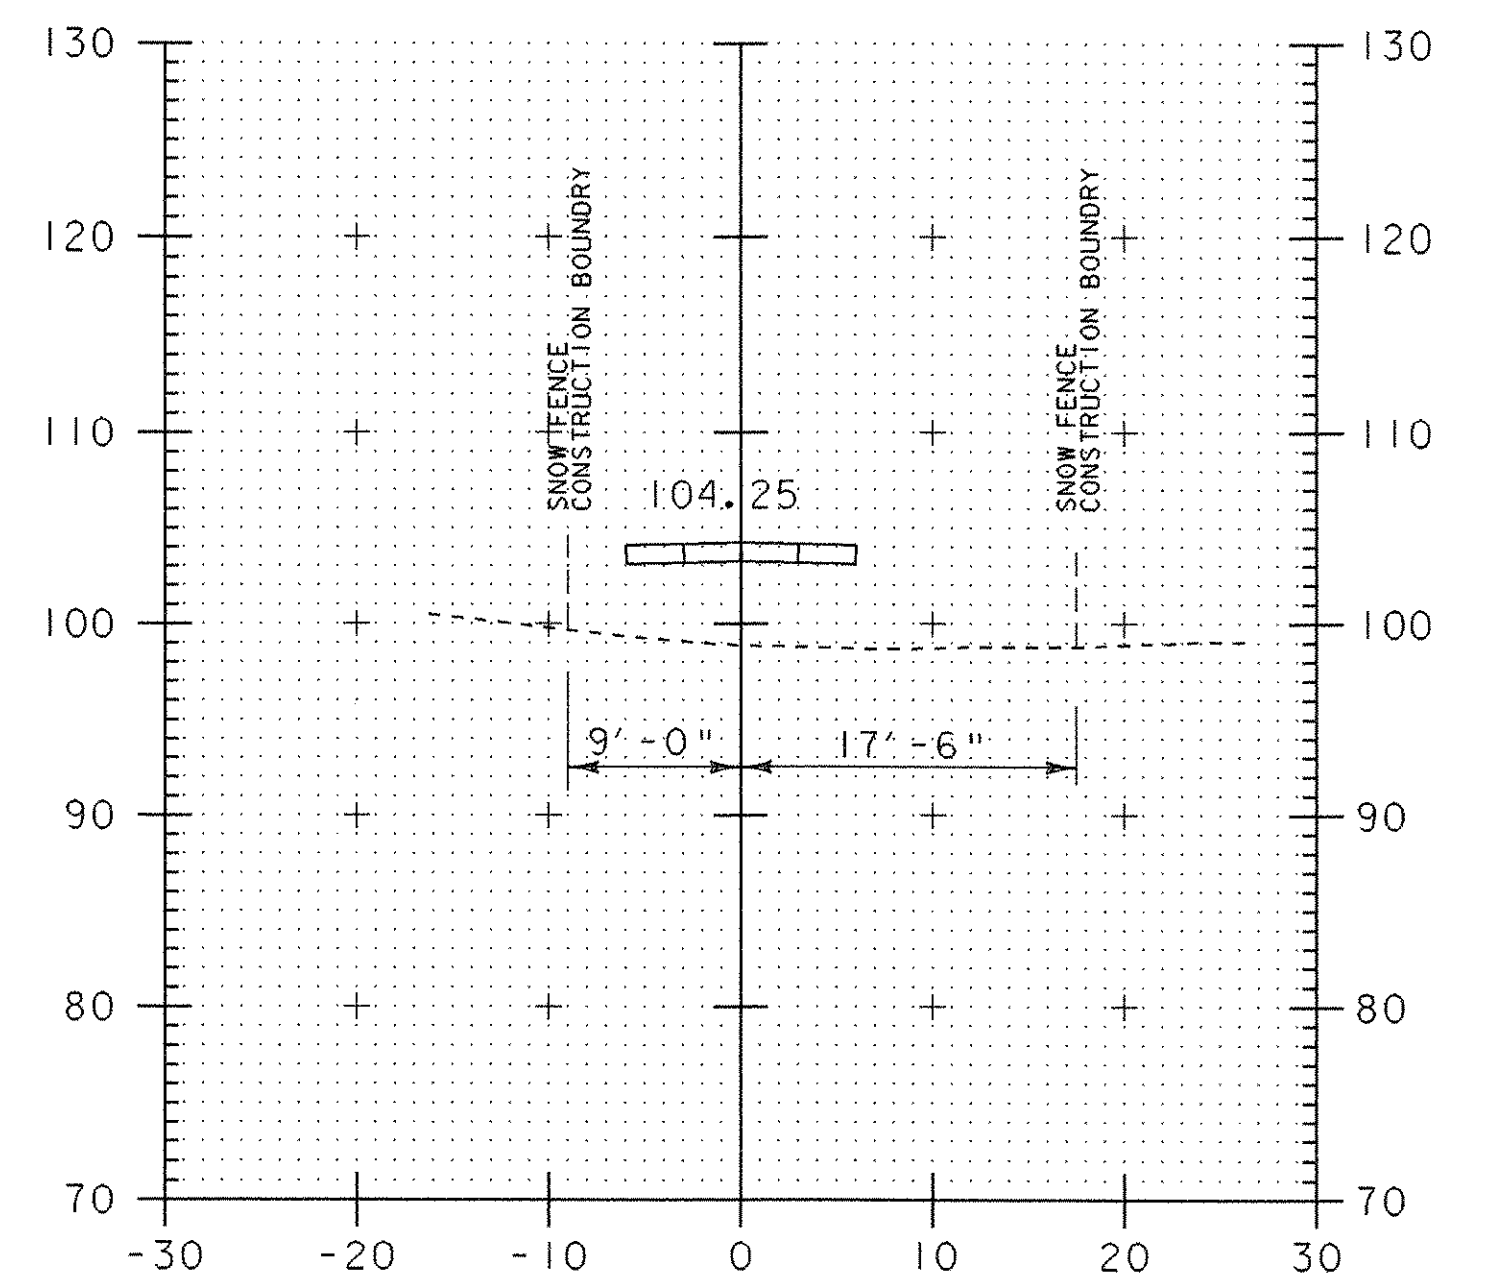


25+50

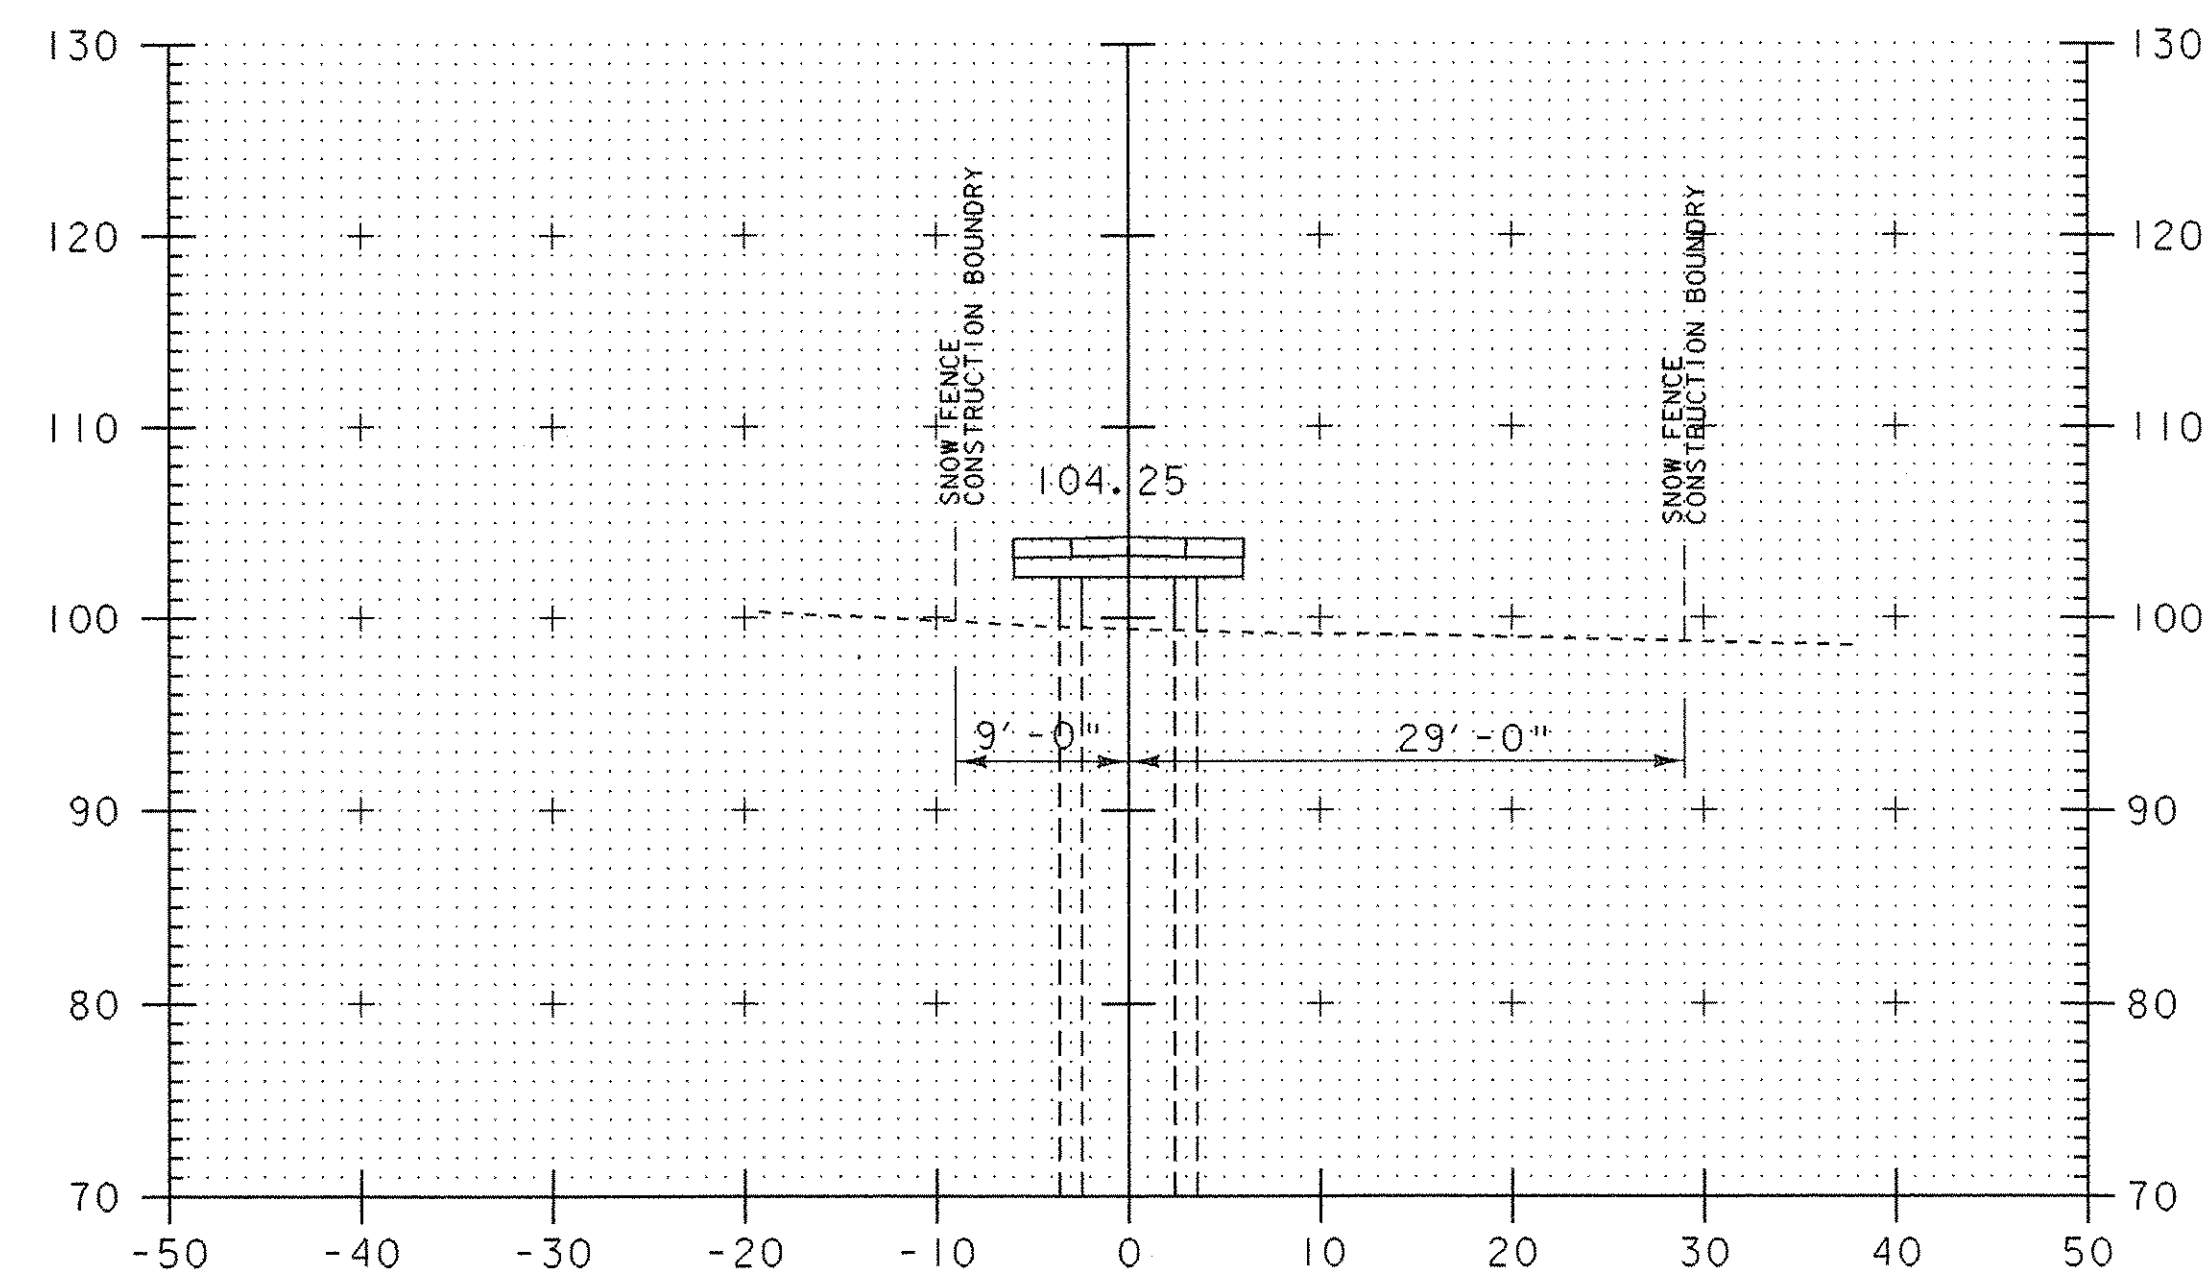

24+25

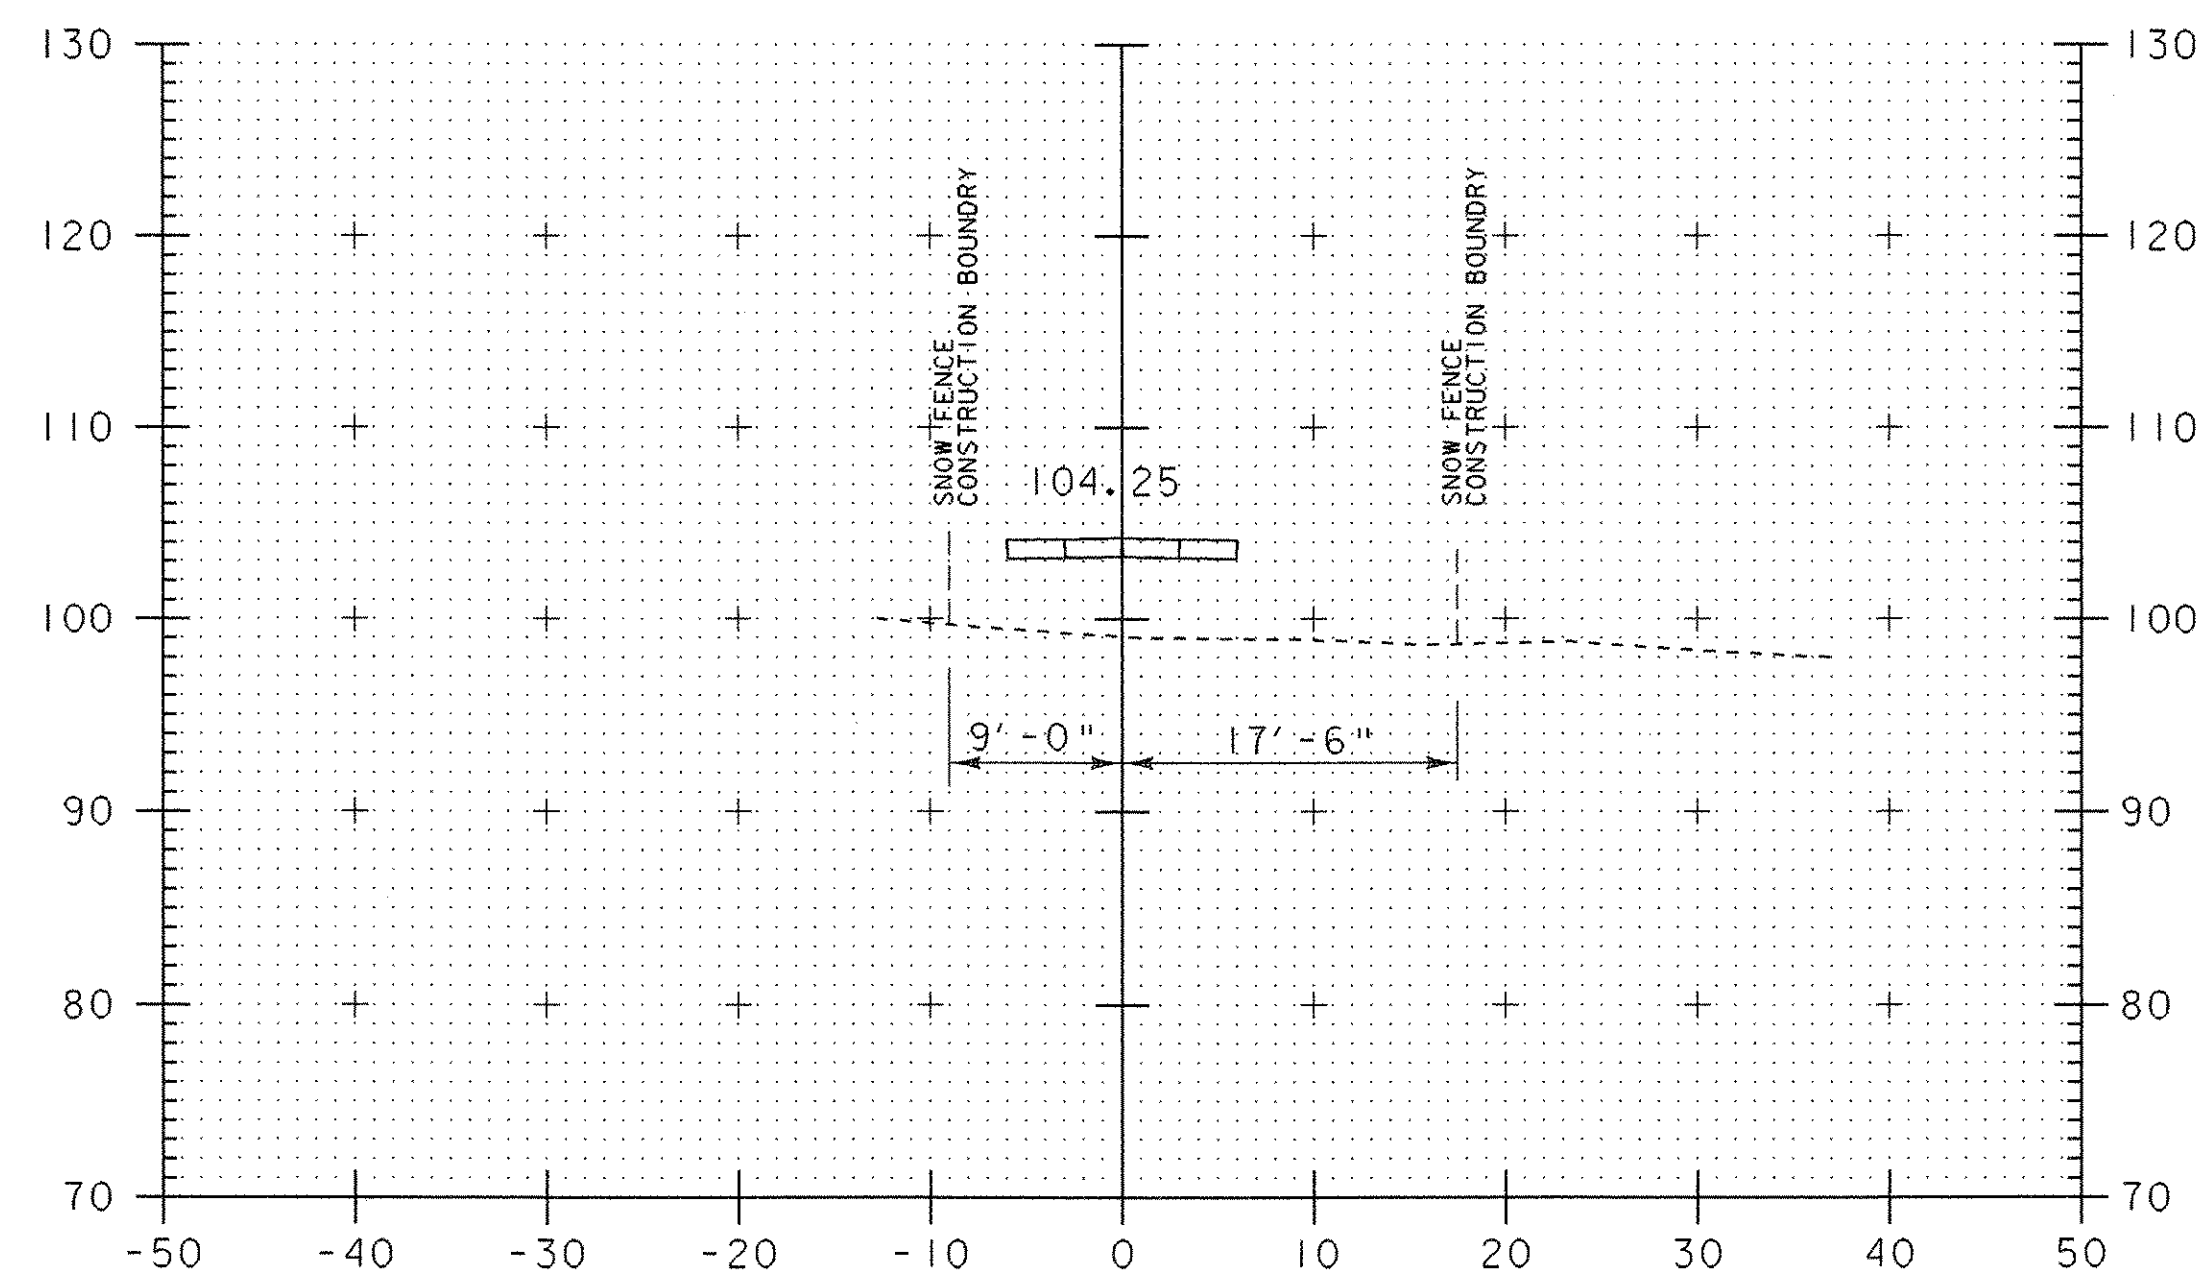

24+75

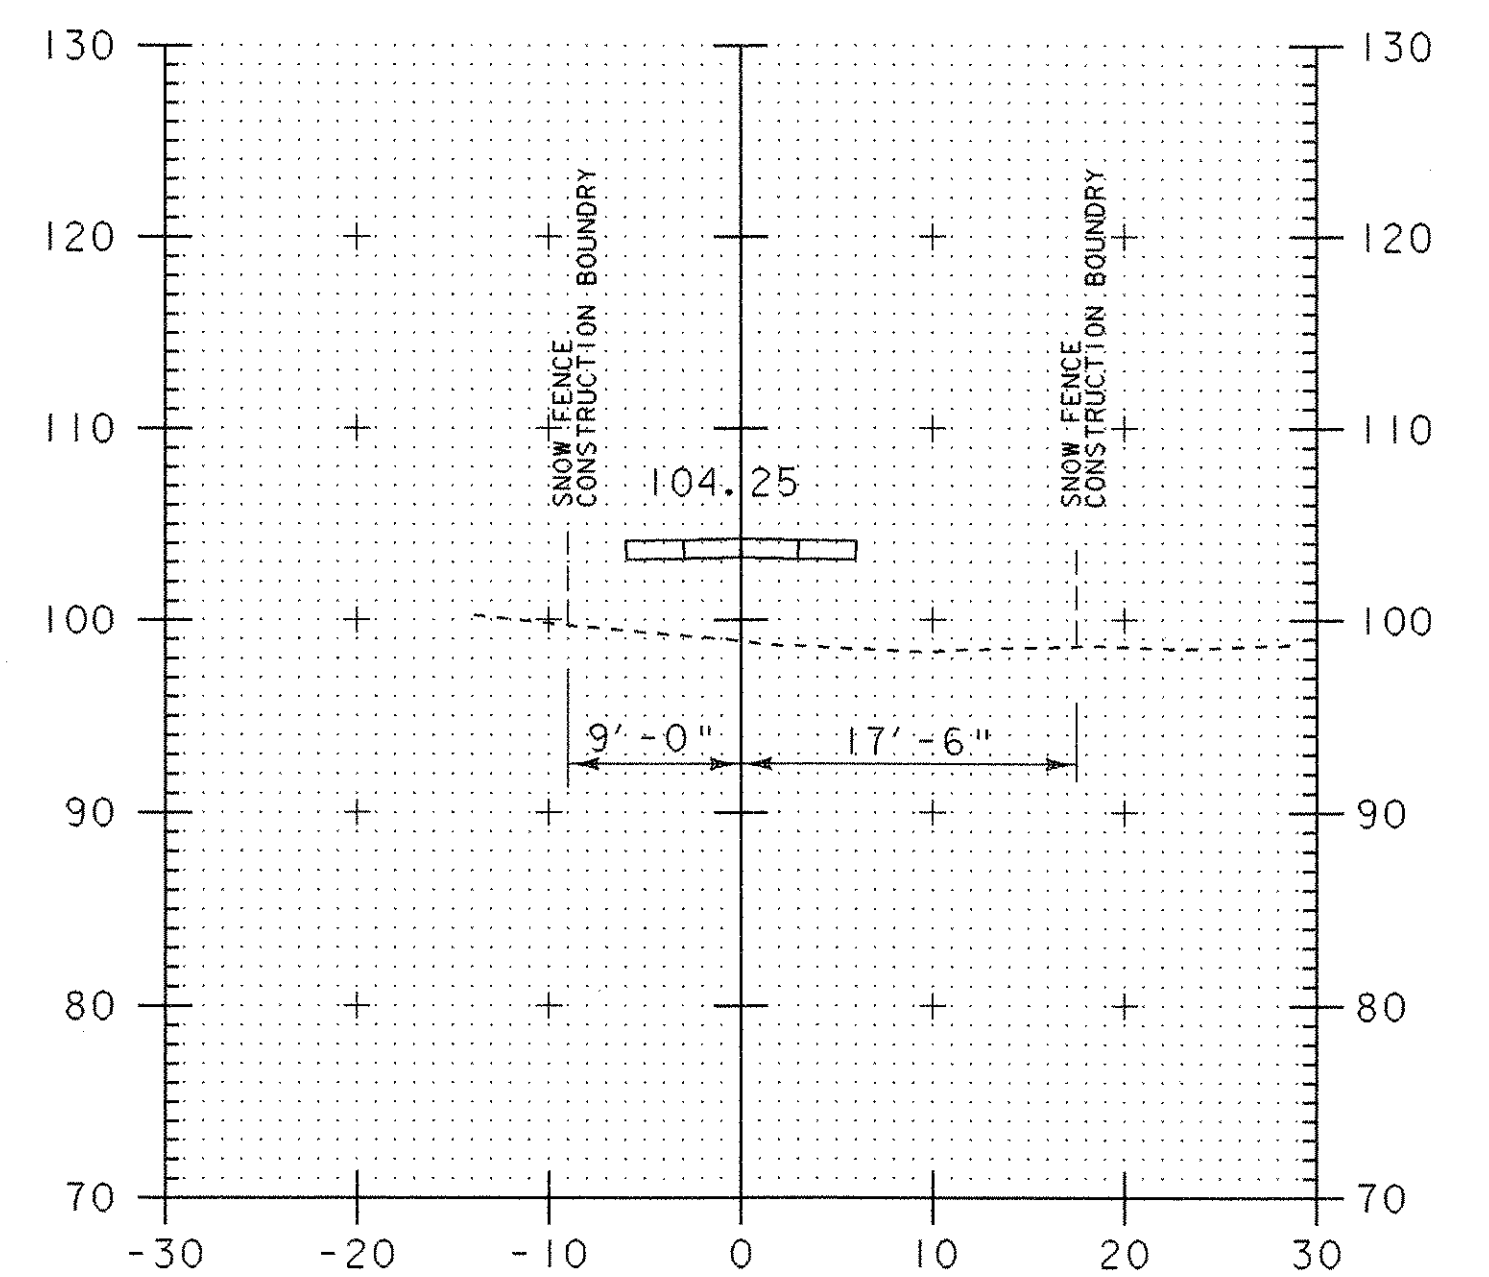

25+25

CROSS SECTIONS 24+25 - 25+50

PROJECT NAME: Colchester
PROJECT NUMBER: STP Bike(48)

FILE NAME: str5/03f038/sf038xsl.dgn PLOT DATE: 05-AUG-2003
PROJECT LEADER: C. Keller DRAWN BY: G. Shangraw
DESIGNED BY: G. Shangraw CHECKED BY:
sf038xsl4.i SHEET 83 OF 87