




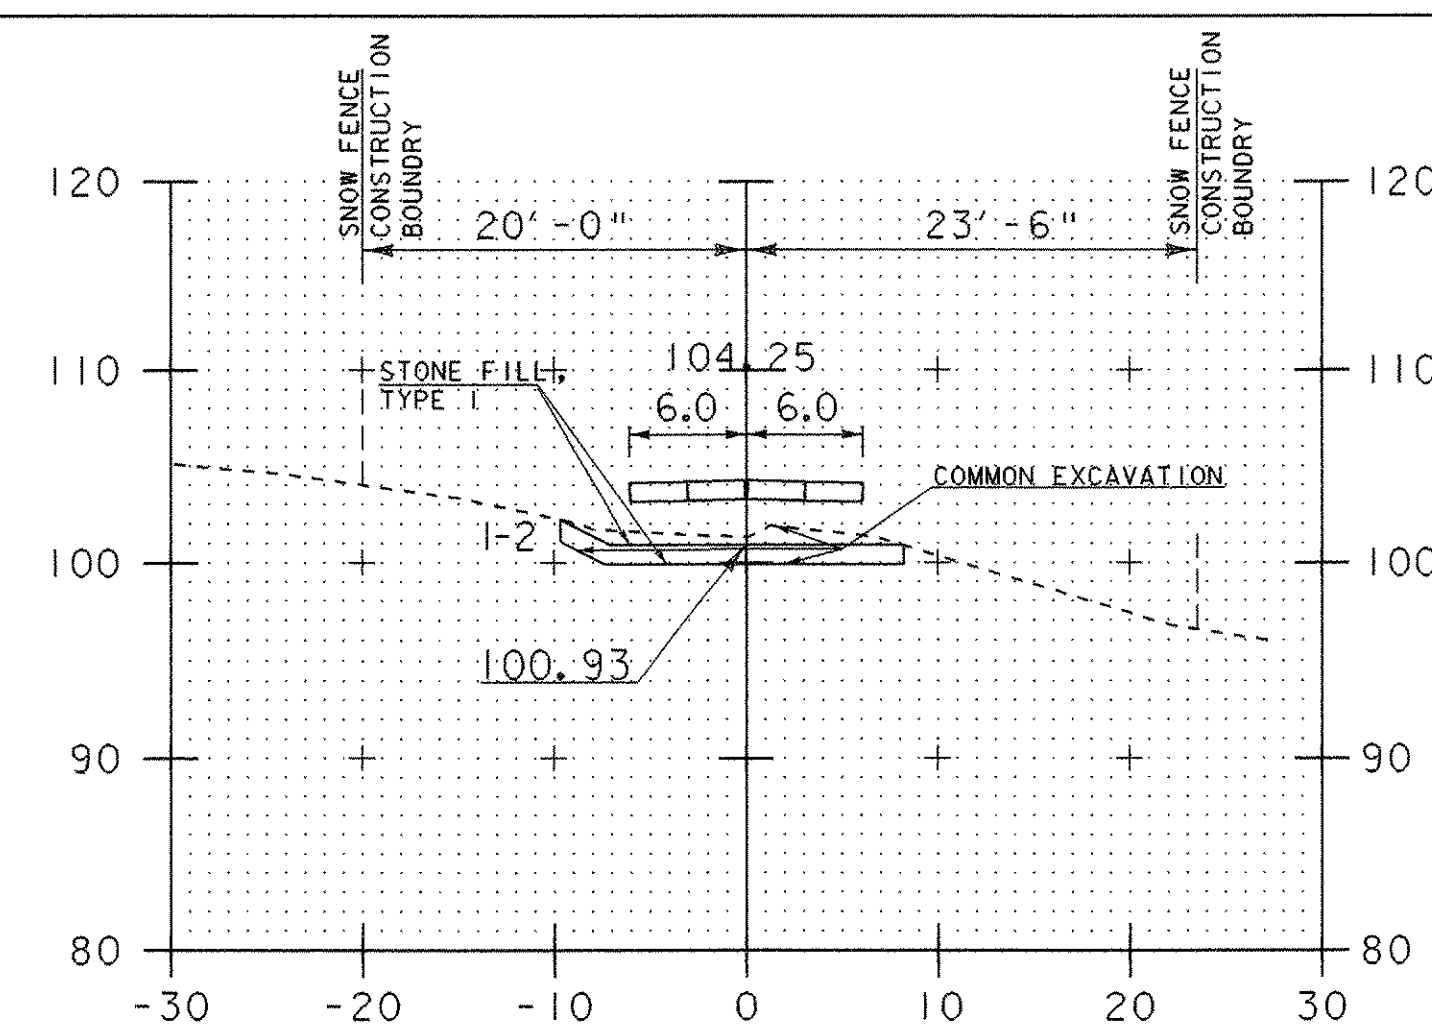


26+80 Sta. 26+70 BEGIN COMMON EXCAVATION
BEGIN STONE FILL TYPE I

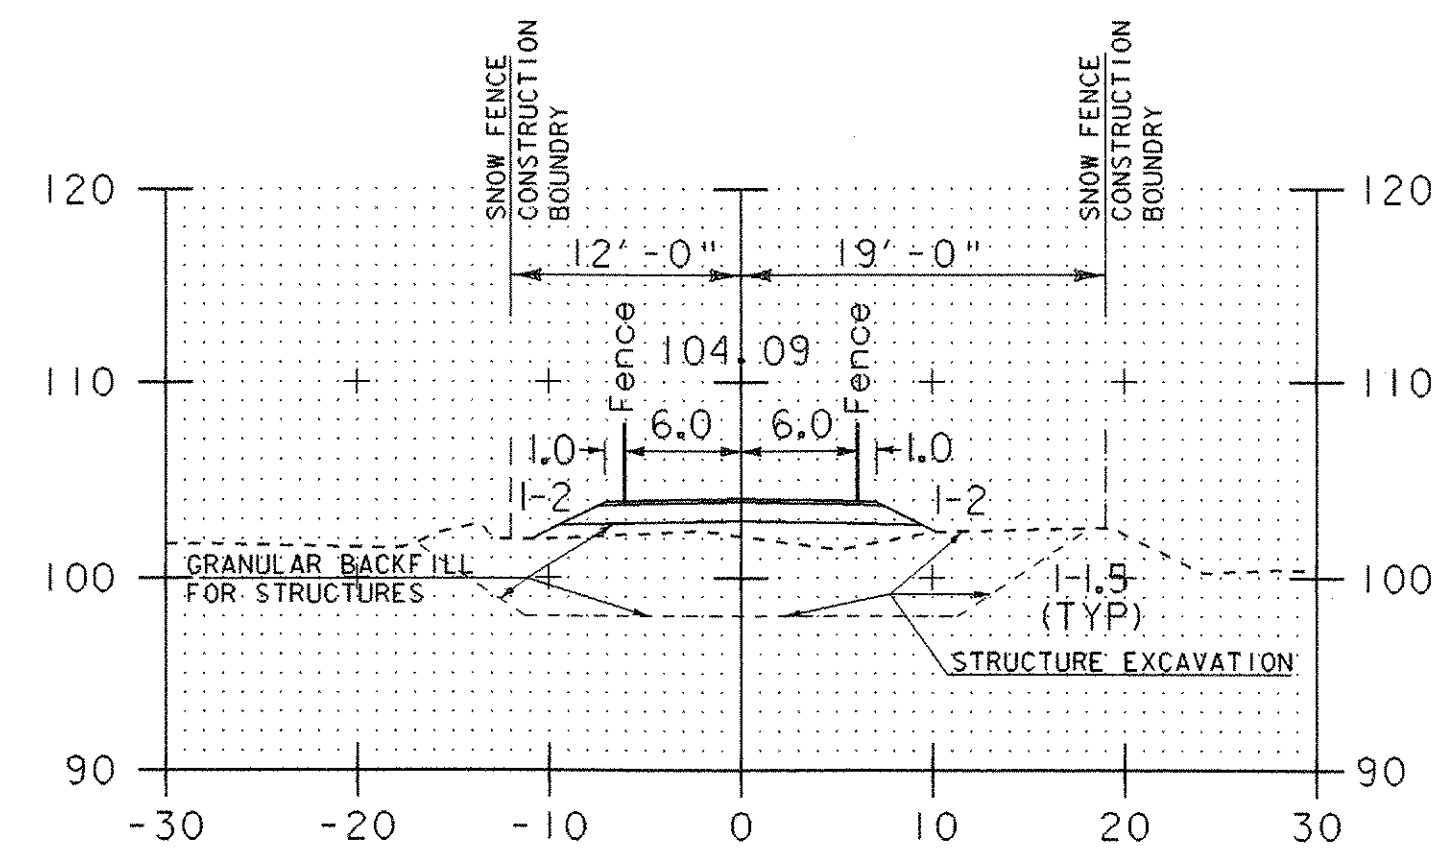


27+10 Sta. 27+05 END STONE FILL TYPE I
27+05.52
End Elevated Concrete Path

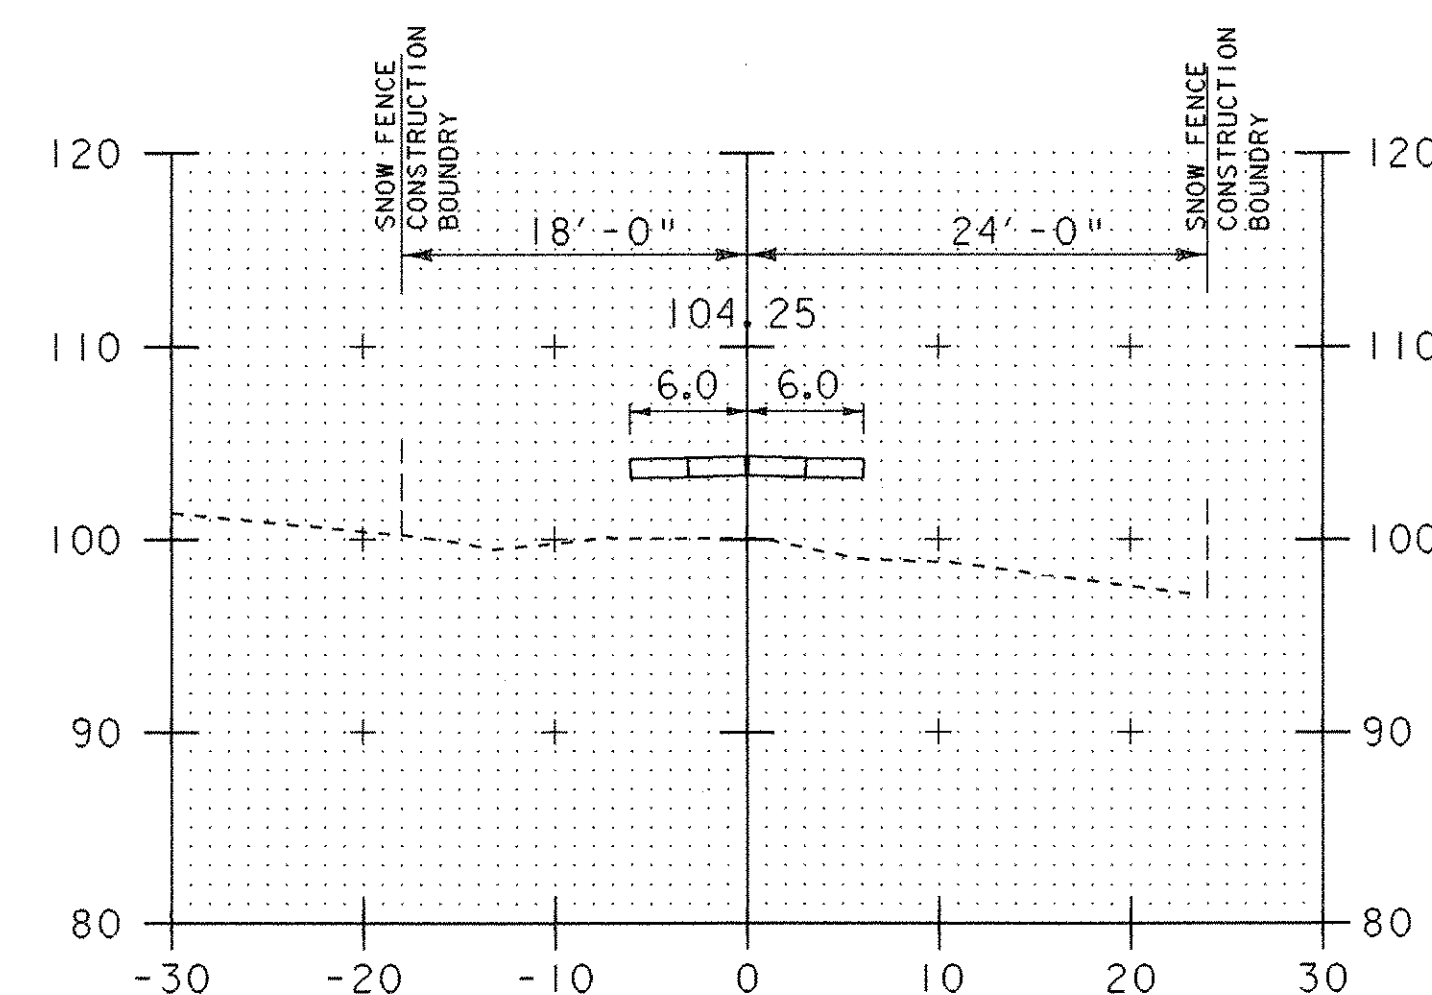


26+70

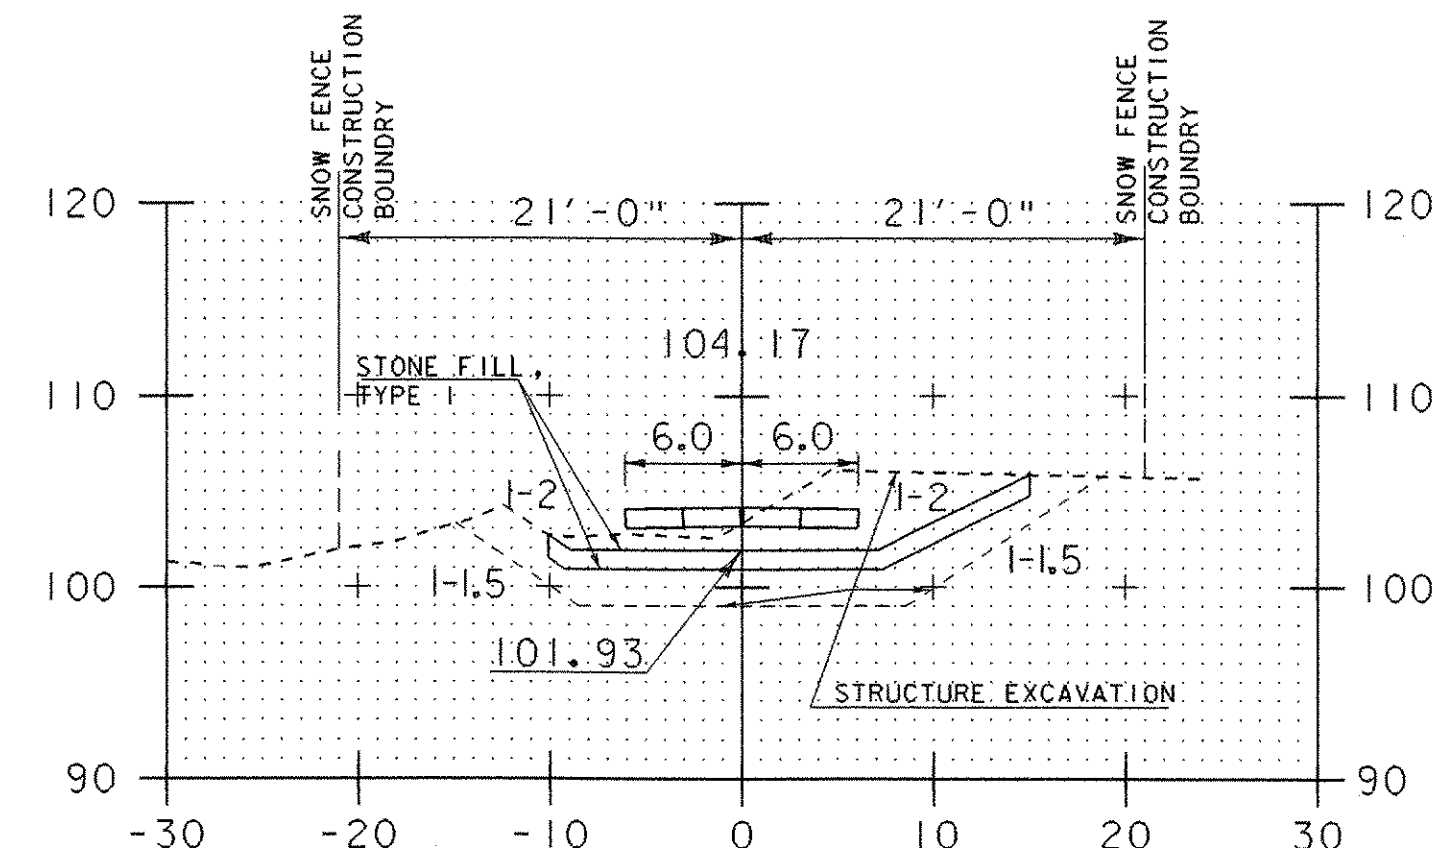


27+00 Sta. 27+00 END COMMON EXCAVATION

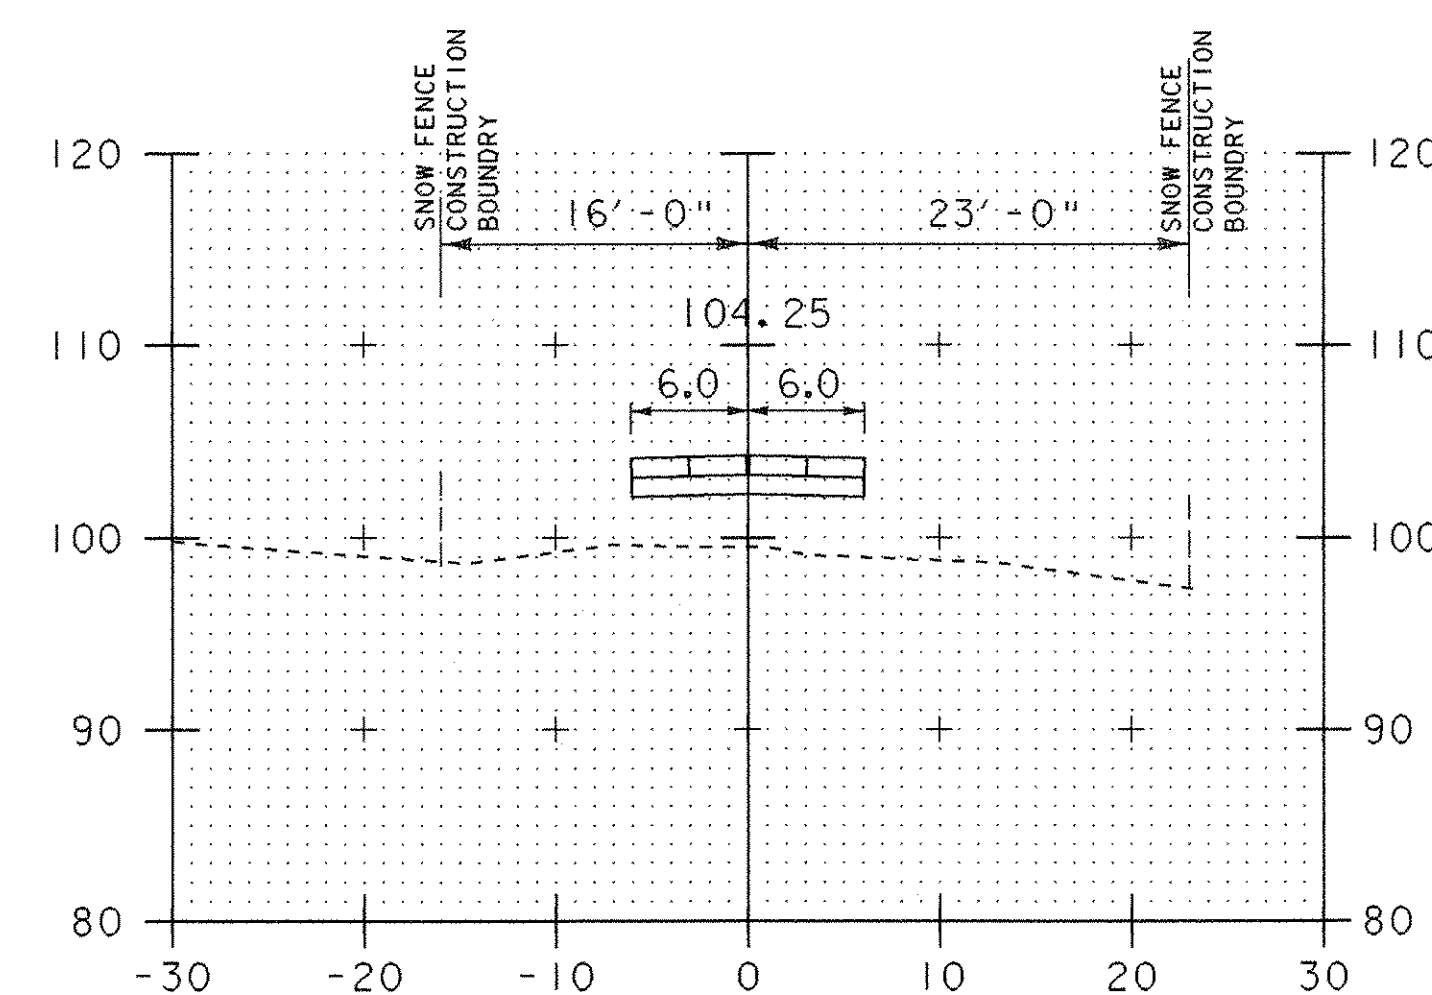


26+66

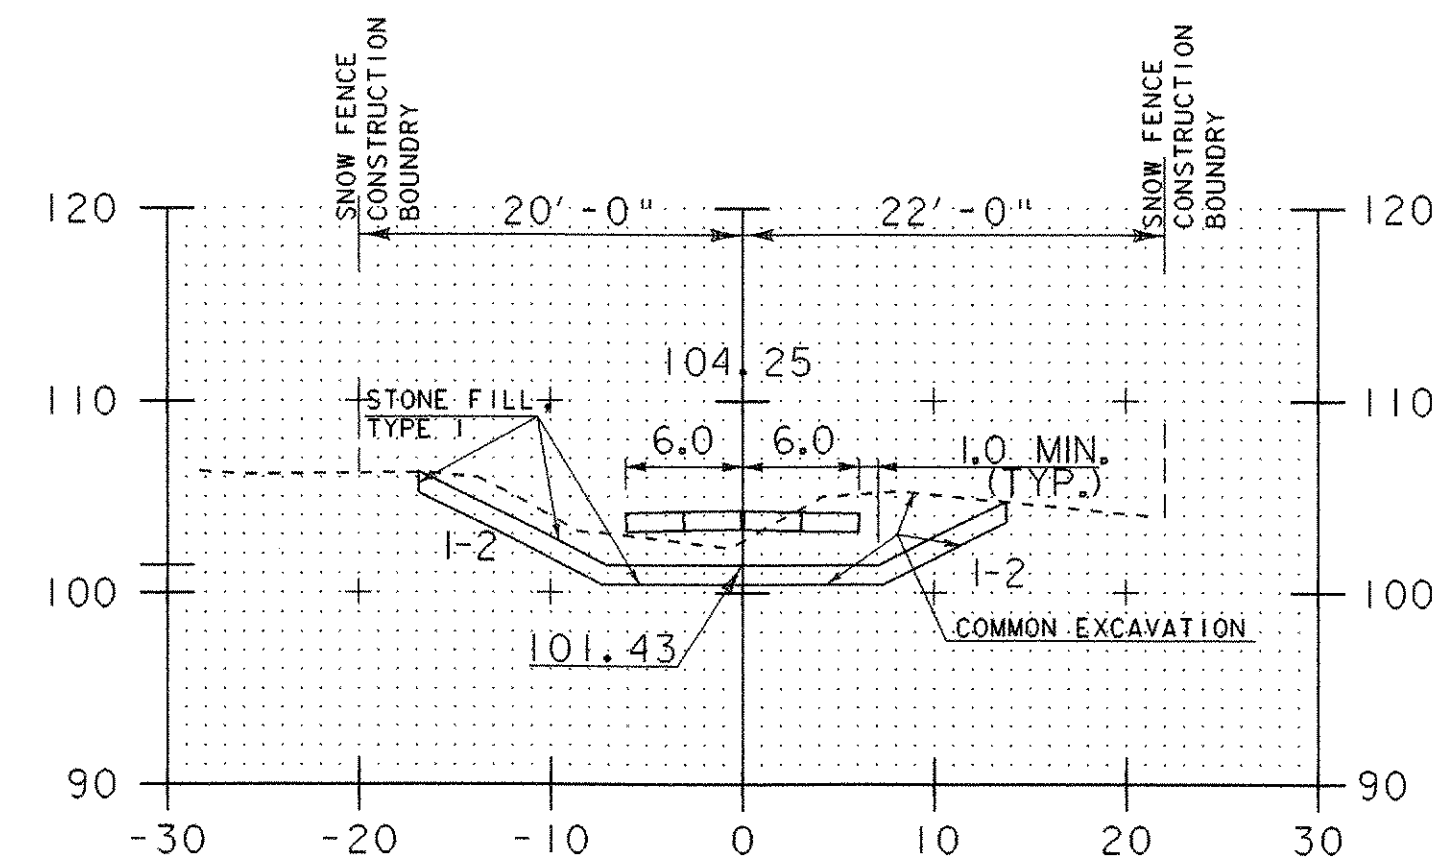


26+90

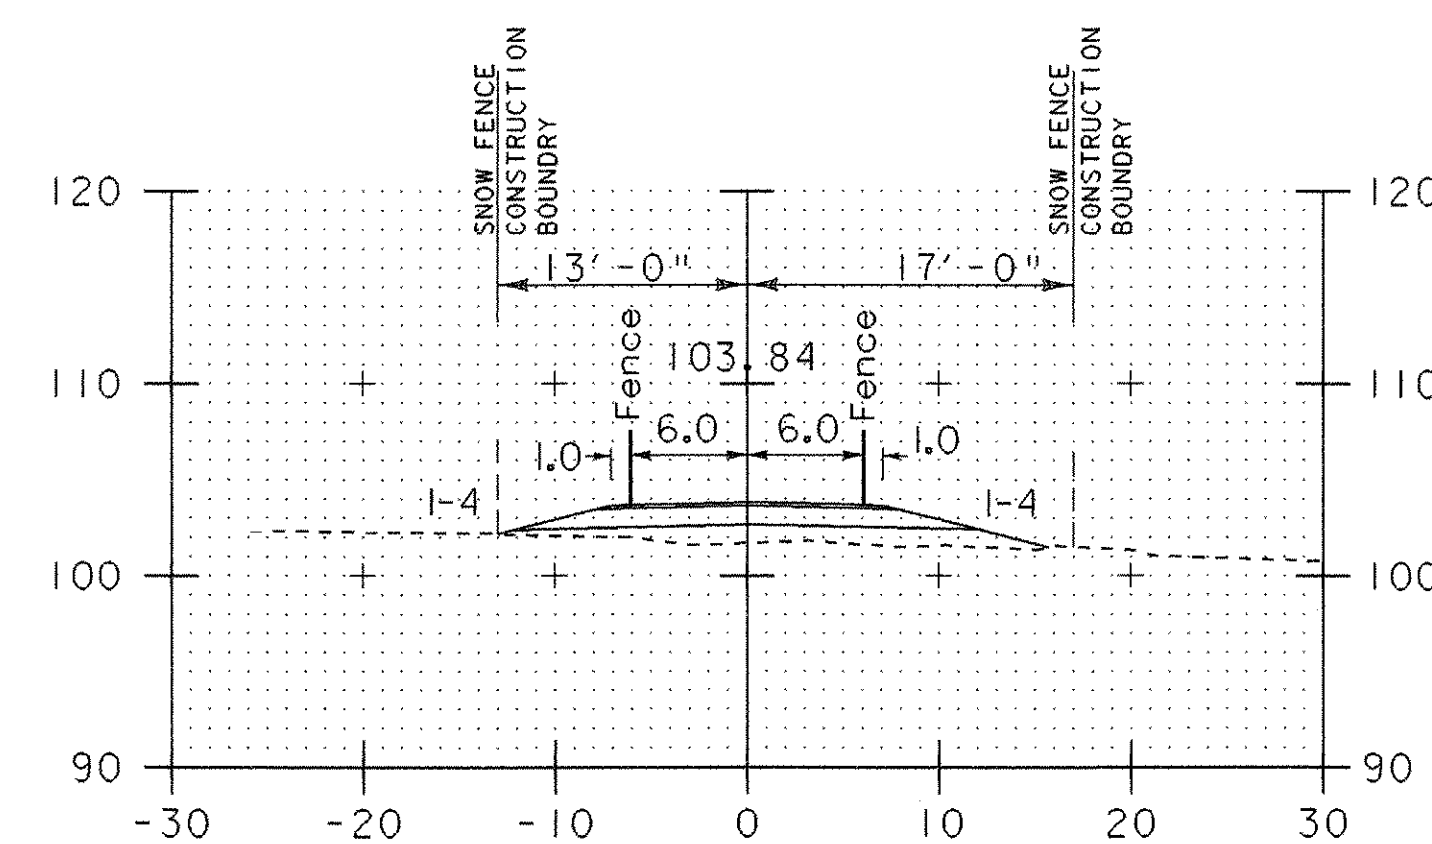


27+40
End Fence Lt. & Rt.
Begin Path Width Taper

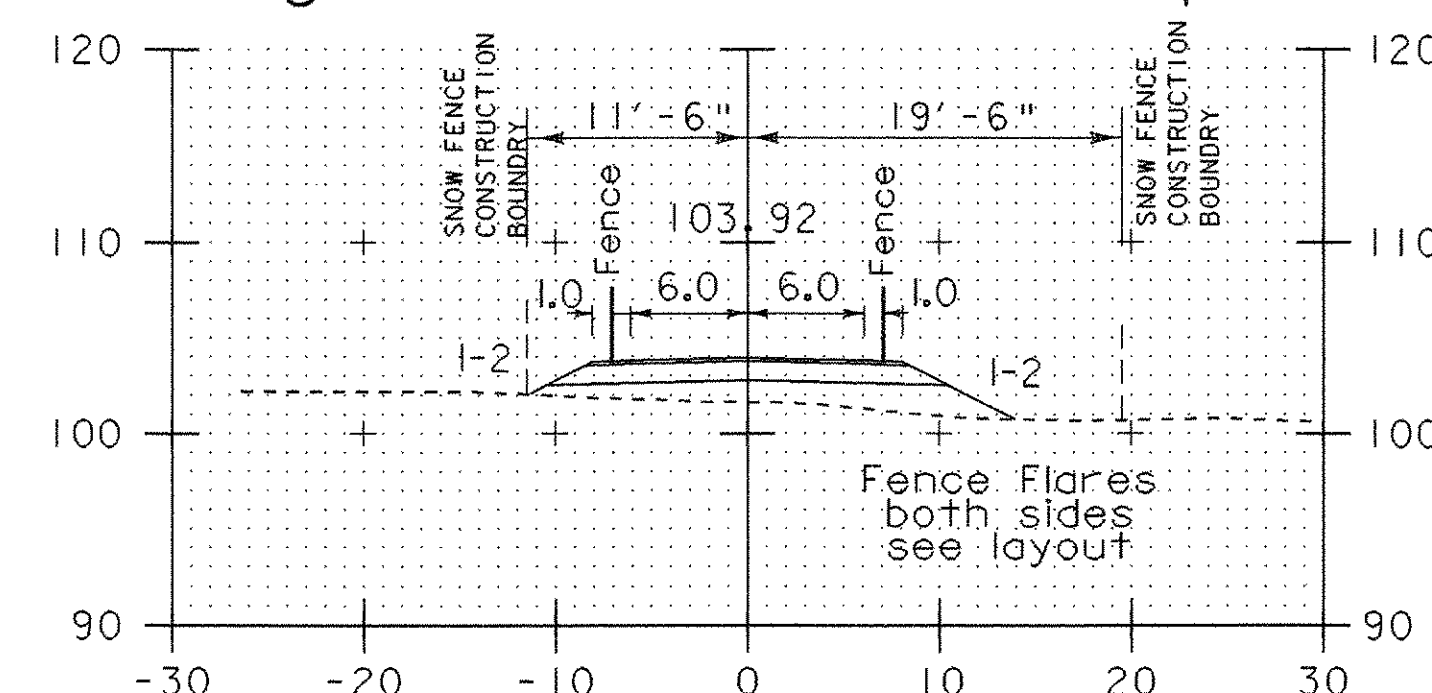


27+30

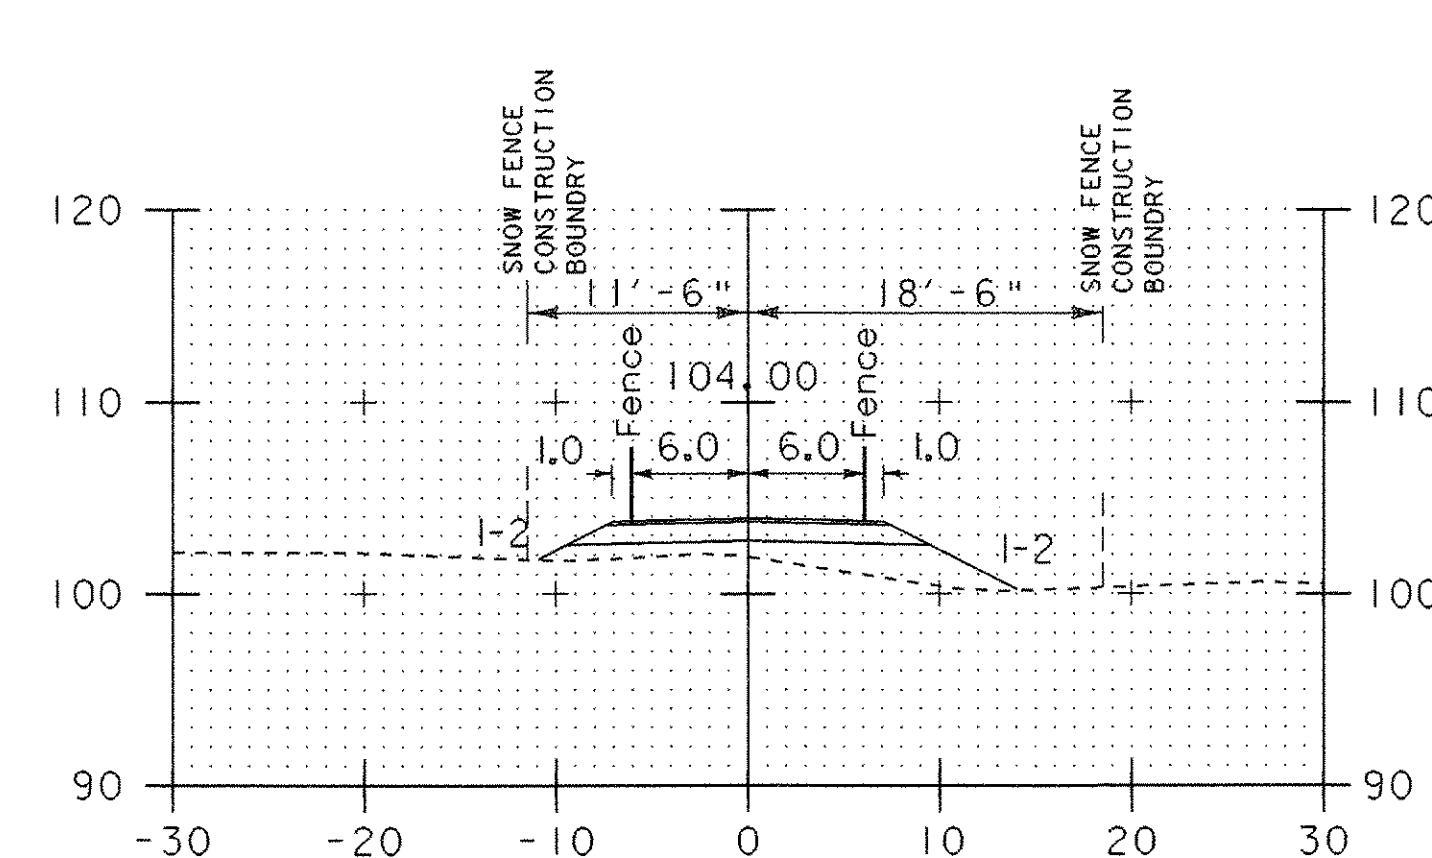


27+20

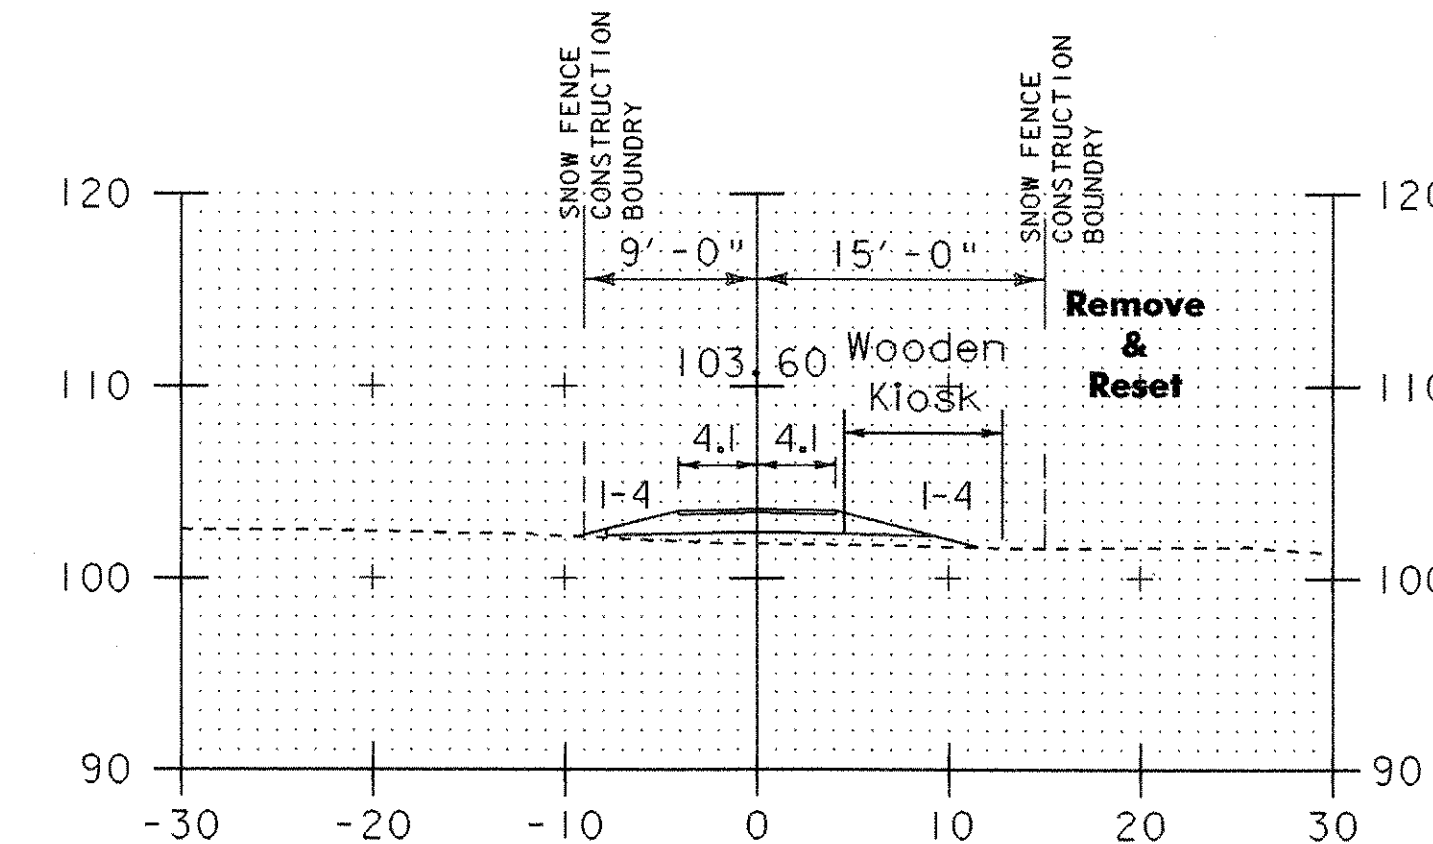

27+70

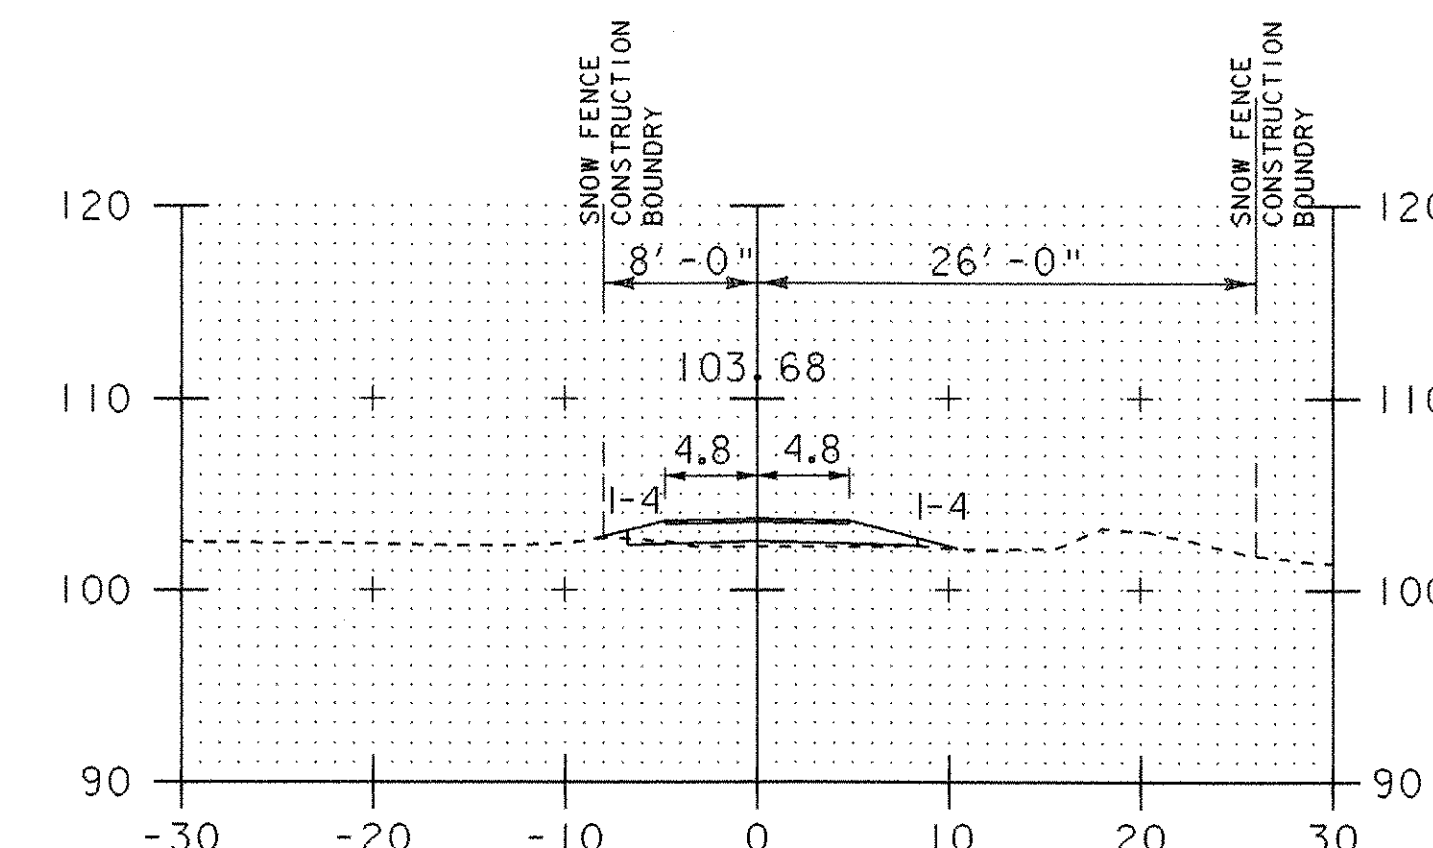

27+60

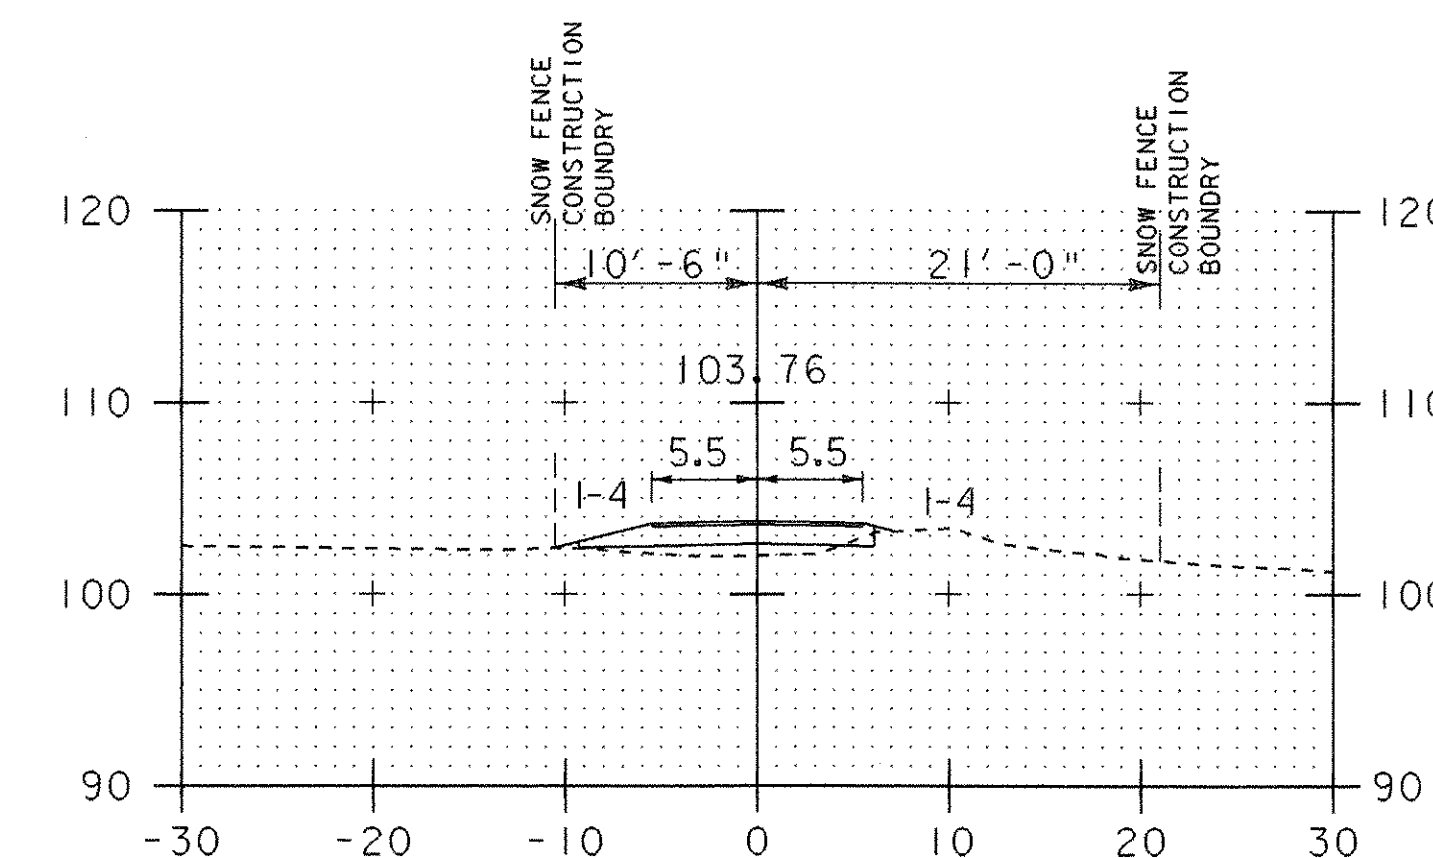

27+50

CROSS SECTIONS 26+66 - 27+70

PROJECT NAME:	Colchester
PROJECT NUMBER:	STP Bike(48)
FILE NAME:	str5/03f038/sf038xsl.dgn
PROJECT LEADER:	C. Keller
DESIGNED BY:	G. Shangraw
PLLOT DATE:	05-AUG-2003
DRAWN BY:	G. Shangraw
CHECKED BY:	
SHEET	85 OF 87