


1 PARTIAL P/S PILE CAP PLAN
 F3
 1/8" = 1'-0"

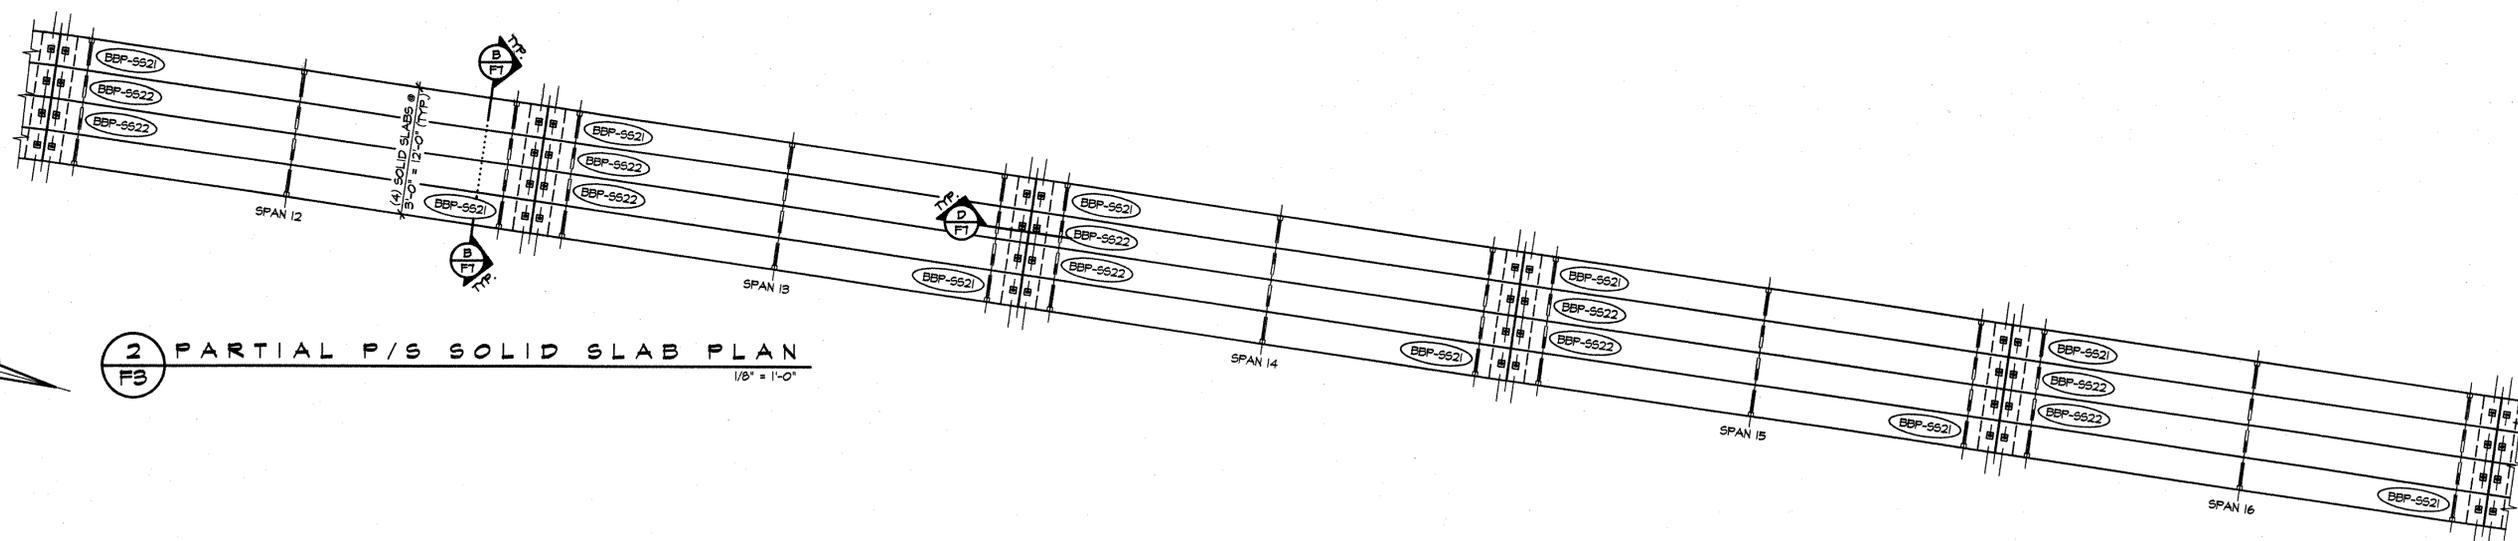

2 PARTIAL P/S SOLID SLAB PLAN
 F3
 1/8" = 1'-0"

J.P. CARRARA & SONS, INC.
 NOV 12 2003
 ISSUED FOR PRODUCTION

APPROVAL STAMP:
 RECEIVED
 CKD BY: [Signature]
 NOV 14 2003
 RESUBMIT BY: [Signature]
 DATE: 12/3/03

J.P. CARRARA & SONS INC. Precast & Prestress Manufacturer 2464 CASE STR., WOODSBURY, VERMONT 05753 Phone: (802)388-8361 Fax: (802)388-9010		KUBRICKY CONSTRUCTION CORP. CONTRACTOR GLENS FALLS, NEW YORK	
STATE OF VERMONT AGENCY OF TRANSPORTATION		DATE: SEPT. 26, 2003	
TOWN OF COLCHESTER PROJECT NUMBER: STP BIKE (48)		SCALE: NOTED	CHKD: DFTM: B.L.
P/S PILE CAP & SOLID SLAB LAYOUTS (SPANS 12-16)		JOB NO: 23169-03	DWG. NO: F3 091