




1 PARTIAL P/S PILE CAP PLAN
F6
1/8" = 1'-0"

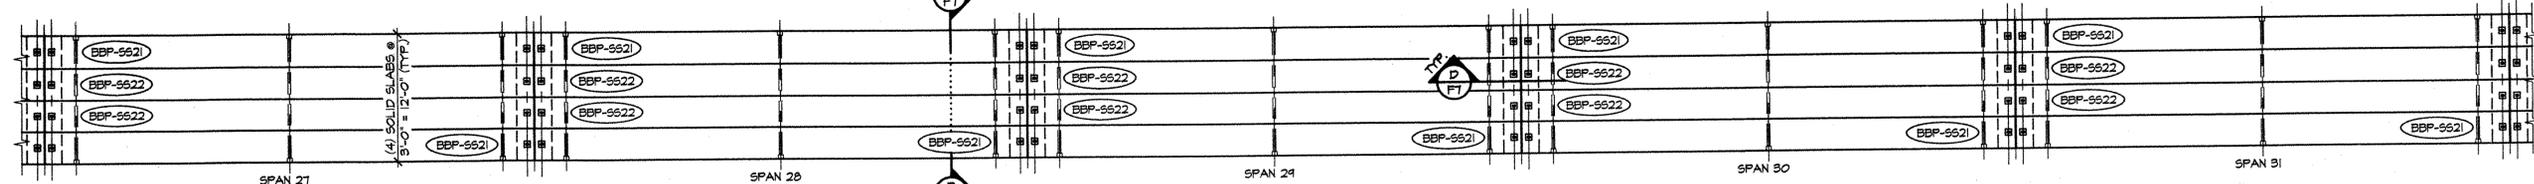


2 PARTIAL P/S SOLID SLAB PLAN
F6
1/8" = 1'-0"

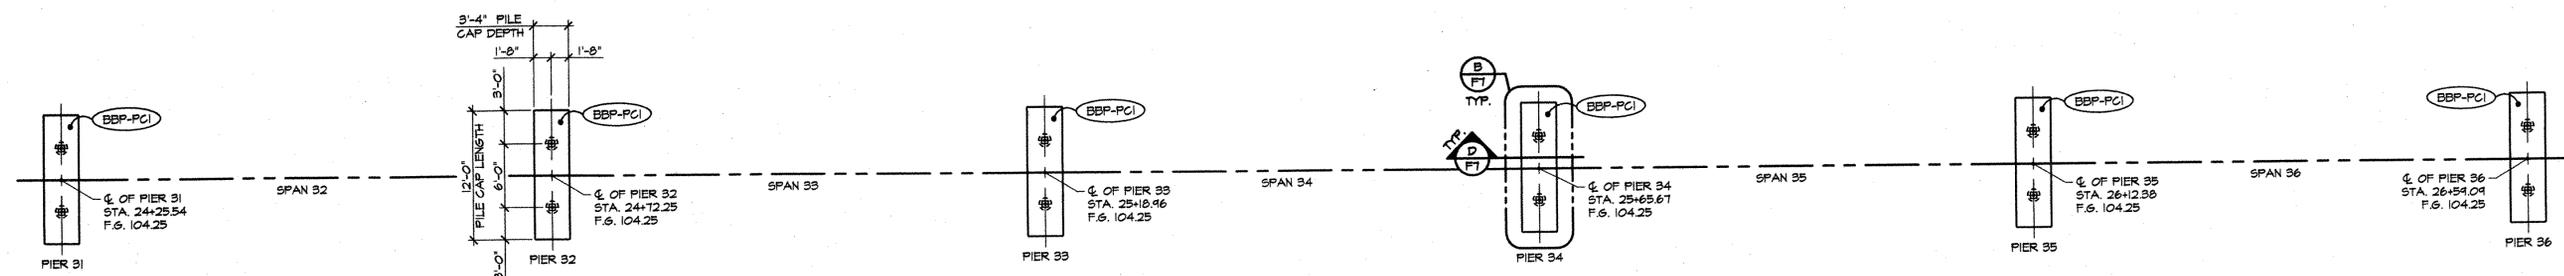

3 PARTIAL P/S PILE CAP PLAN
F6
1/8" = 1'-0"

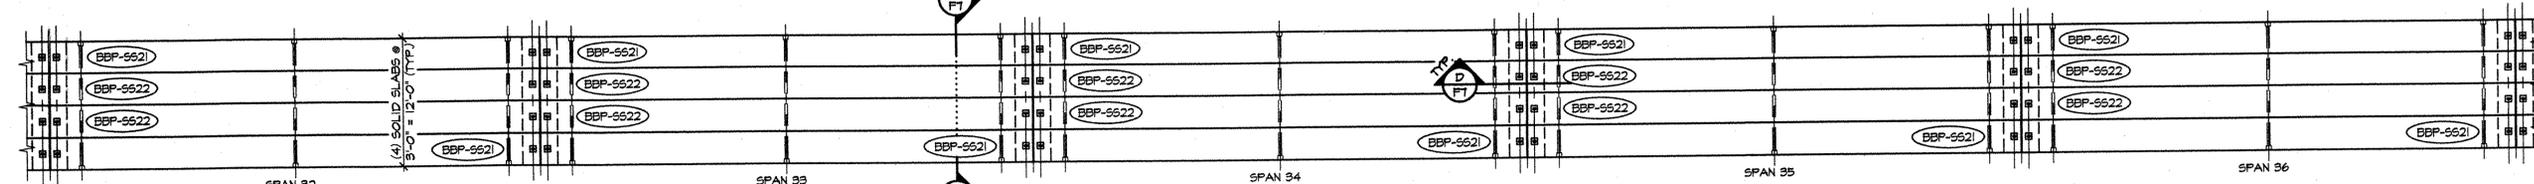

4 PARTIAL P/S SOLID SLAB PLAN
F6
1/8" = 1'-0"

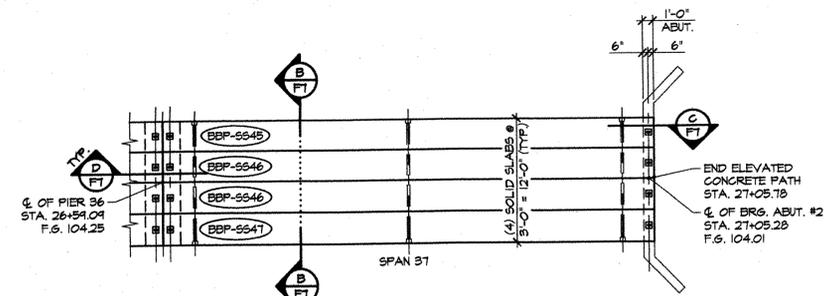

5 PARTIAL P/S SOLID SLAB PLAN
F6
1/8" = 1'-0"

J.P. CARRARA & SONS, INC.
NOV 12 2003
ISSUED FOR PRODUCTION

APPROVAL STAMP:
 RECEIVED
 NOV 14 2003
 RESUBMIT APPROVED
 BY DATE 12/3/03

J.P. CARRARA & SONS, INC. Precast & Prestress Manufacturer <small>2444 CASE ST., WOODBURY, VERMONT 05753 Phone: (802) 388-6361 Fax: (802) 388-9010</small>		KUBRICKY CONSTRUCTION CORP. CONTRACTOR <small>GLENS FALLS, NEW YORK</small>	
STATE OF VERMONT AGENCY OF TRANSPORTATION		DATE: SEPT. 26, 2003 SCALE: NOTED	
TOWN OF COLCHESTER PROJECT NUMBER: STP BIKE (48)		CHKD:	DFTM: B.L.
P/S FILE CAP & SOLID SLAB LAYOUTS (SPANS 27-31, 32-36, & 37)		JOB NO:	23169-03
		DWG. NO:	F6 094