



P/S SOLID SLAB LAYOUT
SPAN 1

- ERECTION MATERIALS (QTY. / SPAN)**
 (6) EM-1 [E] WASHER 3/4"x5"x5" W/ 2" HOLE
 (6) SINGLE USE STRESSING CHUCK
 (3) 1/2" x 14'-4" POLYSTRAND
 (16) 1/2"x6"x6" ELASTOMERIC BEARING PAD (SUPPLIED & INSTALLED BY OTHERS)
 (8) 1/4" x 1'-10" ANCHOR BOLT (GALV.) W/ HEAVY NUT (GALV.)
 (8) EM-3 [E] WASHER 3/4"x5"x5" W/ 1/2" HOLE

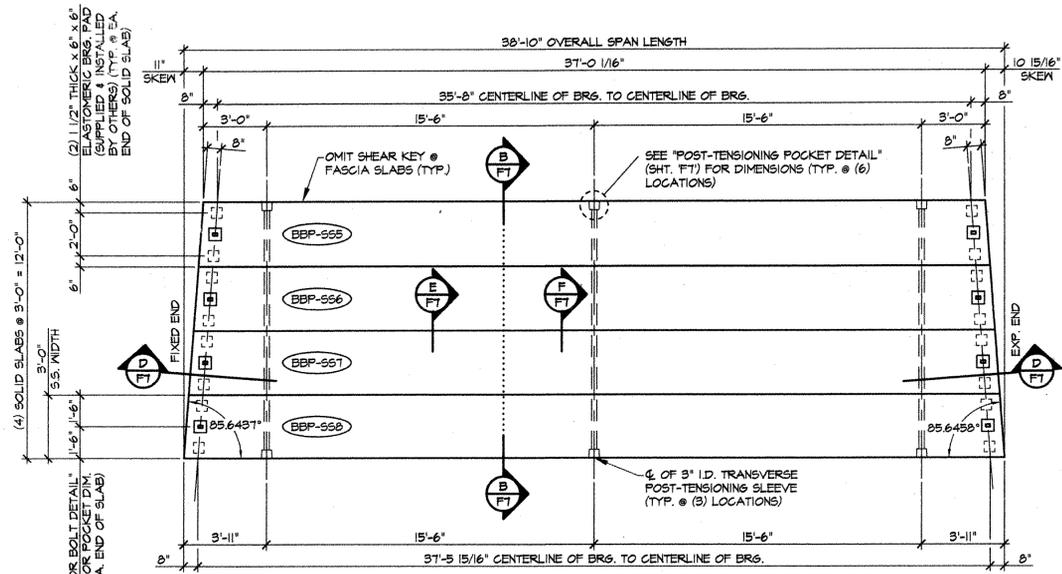


P/S SOLID SLAB LAYOUT
SPANS 2 & 3

- ERECTION MATERIALS (QTY. / SPAN)**
 (6) EM-1 [E] WASHER 3/4"x5"x5" W/ 2" HOLE
 (6) SINGLE USE STRESSING CHUCK
 (3) 1/2" x 14'-4" POLYSTRAND
 (16) 1/2"x6"x6" ELASTOMERIC BEARING PAD (SUPPLIED & INSTALLED BY OTHERS)
 (8) 1/4" x 1'-10" ANCHOR BOLT (GALV.) W/ HEAVY NUT (GALV.)
 (8) EM-3 [E] WASHER 3/4"x5"x5" W/ 1/2" HOLE

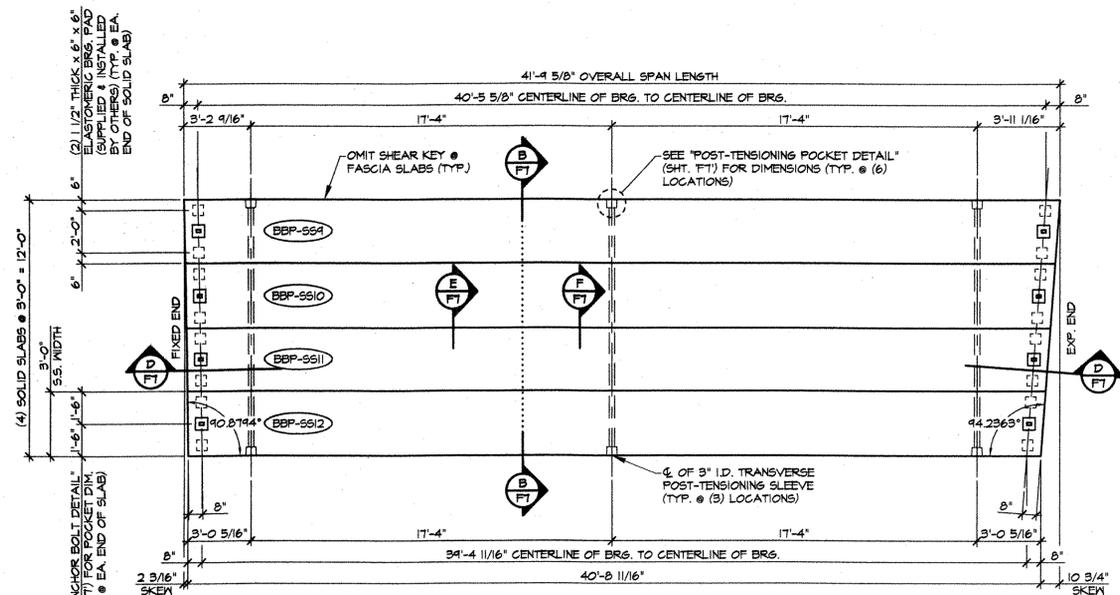

P/S SOLID SLAB LAYOUT
SPAN 4

- ERECTION MATERIALS (QTY. / SPAN)**
 (6) EM-1 [E] WASHER 3/4"x5"x5" W/ 2" HOLE
 (6) SINGLE USE STRESSING CHUCK
 (3) 1/2" x 14'-4" POLYSTRAND
 (16) 1/2"x6"x6" ELASTOMERIC BEARING PAD (SUPPLIED & INSTALLED BY OTHERS)
 (8) 1/4" x 1'-10" ANCHOR BOLT (GALV.) W/ HEAVY NUT (GALV.)
 (8) EM-3 [E] WASHER 3/4"x5"x5" W/ 1/2" HOLE

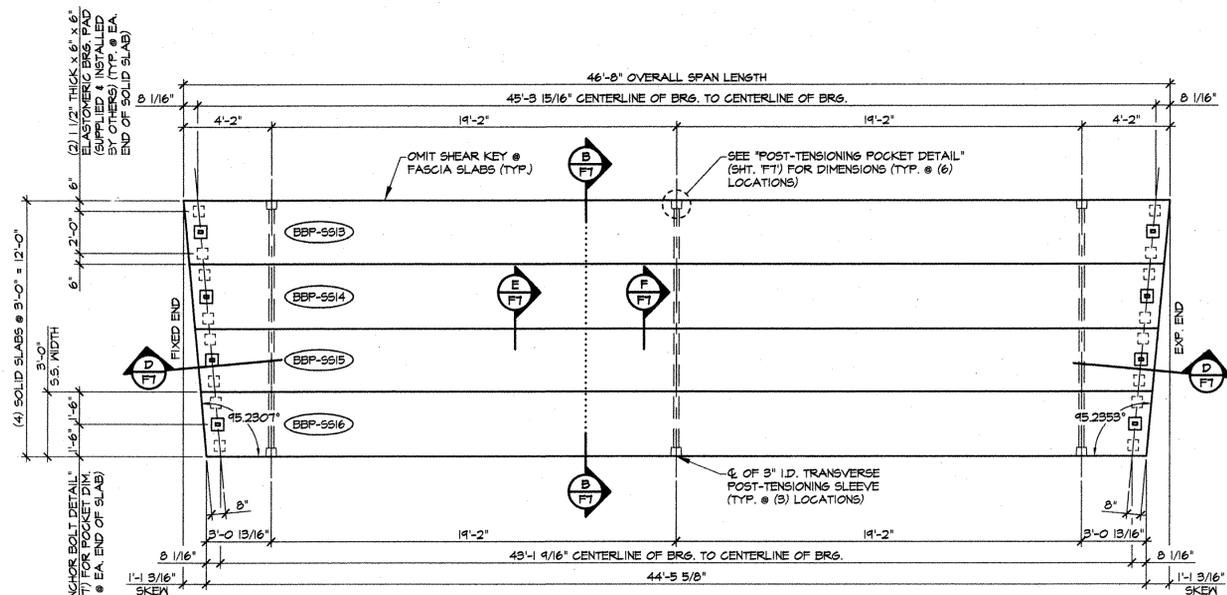

P/S SOLID SLAB LAYOUT
SPAN 5

- ERECTION MATERIALS (QTY. / SPAN)**
 (6) EM-1 [E] WASHER 3/4"x5"x5" W/ 2" HOLE
 (6) SINGLE USE STRESSING CHUCK
 (3) 1/2" x 14'-4" POLYSTRAND
 (16) 1/2"x6"x6" ELASTOMERIC BEARING PAD (SUPPLIED & INSTALLED BY OTHERS)
 (8) 1/4" x 1'-10" ANCHOR BOLT (GALV.) W/ HEAVY NUT (GALV.)
 (8) EM-3 [E] WASHER 3/4"x5"x5" W/ 1/2" HOLE

J.P. CARRARA & SONS, INC.

NOV 12 2003

ISSUED FOR PRODUCTION

APPROVAL STAMP:

RECEIVED
 NOV 14 2003
 APPROVED BY: [Signature]
 DATE: 12/3/03

J.P. CARRARA & SONS INC. PRECAST & PRESTRESS MANUFACTURER
 284 GLE FALLS RD., WOODVILLE, VERMONT 05753 Phone: (802) 388-6361 Fax: (802) 388-8010
KUBRICKY CONSTRUCTION CORP. CONTRACTOR
 GLENS FALLS, NEW YORK

STATE OF VERMONT AGENCY OF TRANSPORTATION	DATE: SEPT. 26, 2003
TOWN OF COLCHESTER PROJECT NUMBER: STP BIKE (48)	SCALE: NOTED
P/S SOLID SLAB LAYOUTS	CHKD: DFTM: B.L. JOB NO: 23169-03 DWG. NO: F8 096