
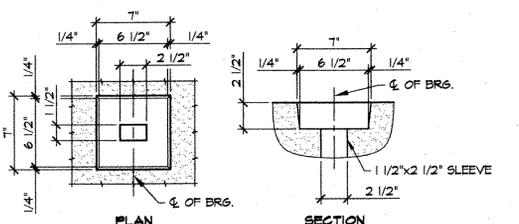
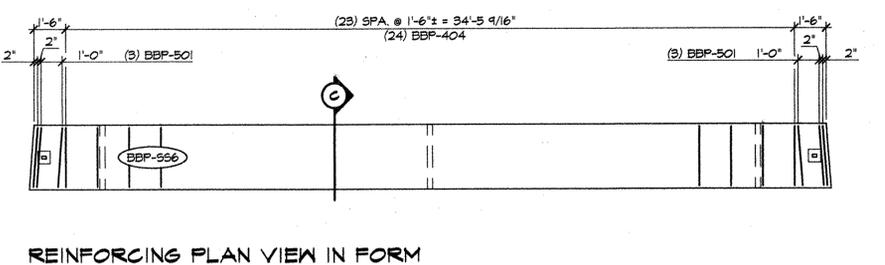


**POST-TENSIONING SLEEVE DETAIL**  
1 1/2" = 1'-0"

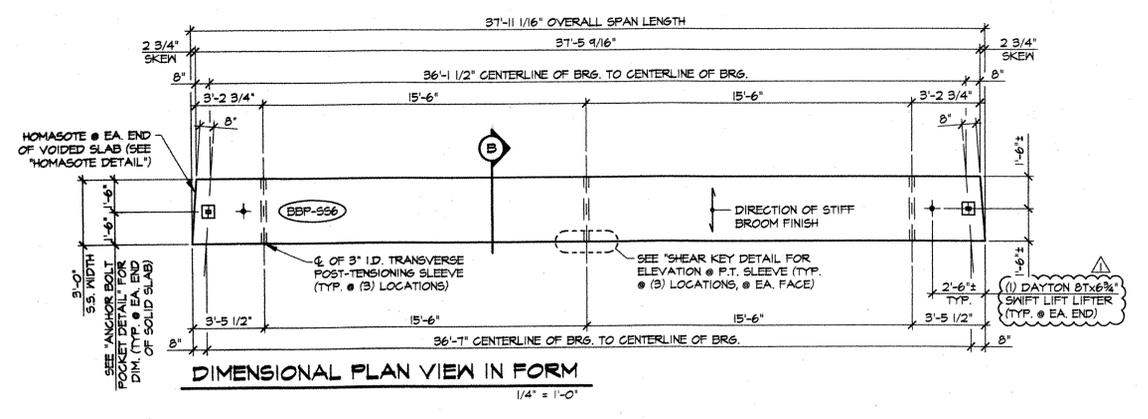





**ANCHOR BOLT POCKET DETAIL**  
1 1/2" = 1'-0"

MARK: BFP-554	QTY.: 1	WT.: 0.34 T	VOL.: 4.22 cy	Pc = 4,000 PSI Pc = 6,000 PSI
MARK: BFP-555	QTY.: 2	WT.: 0.23 T	VOL.: 4.07 cy	
MARK: BFP-556	QTY.: 2	WT.: 0.21 T	VOL.: 4.06 cy	

MATERIAL LIST / SOLID SLAB					
ITEM	MARK	DESCRIPTION	QTY./SLAB		
			554	555	556
1	404	#4 BENT BAR	25	24	24
2					
3	501	#5 BENT BAR	6	6	6
4					
5					
6					
7					
8					
9		DAYTON 6T x 6 3/4" SWIFT LIFT LIFTER	2	2	2
10					

DETENSIONING SCHEDULE	
1	2
3 3 7 9	6 6 4

N.T.S.

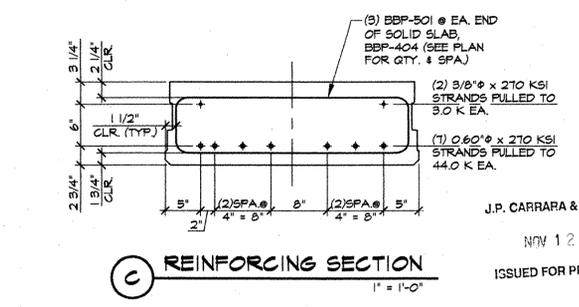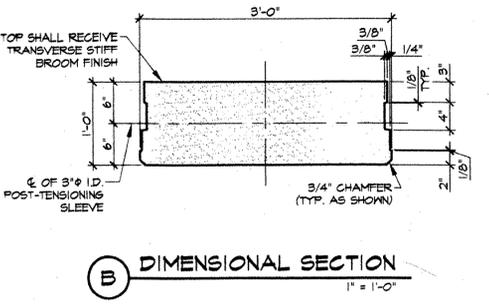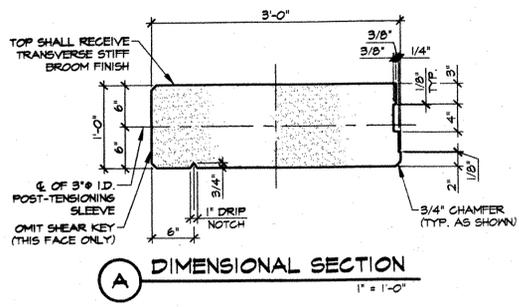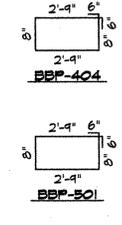

APPROVAL STAMP:

RECEIVED  
NOV 14 2003  
RESUBMIT APPROVED BY DATE 12/5/03

J.P. CARRARA & SONS INC. KUBRICKY CONSTRUCTION CORP.  
Precast & Prestress Manufacturer CONTRACTOR  
2464 CASE STR., MIDDLEBURY, VERMONT 05753 Phone: (802) 398-6361 Fax: (802) 398-9010  
GLENS FALLS, NEW YORK

STATE OF VERMONT AGENCY OF TRANSPORTATION  
TOWN OF COLCHESTER PROJECT NUMBER: STP BIKE (48)

DATE: SEPT. 26, 2003  
SCALE: NOTED  
CHKD: DFTM: B.L.  
JOB NO: 23169-03

F/S SOLID SLAB DETAILS  
DWG. NO: 552  
101