




DIMENSIONAL PLAN VIEW IN FORM
1/4" = 1'-0"

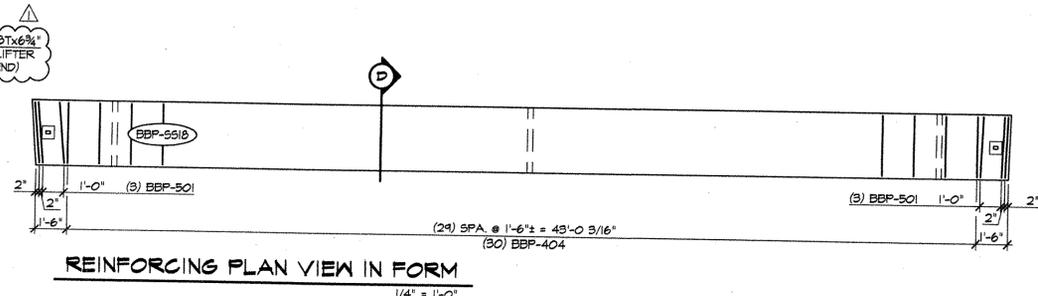


REINFORCING PLAN VIEW IN FORM
1/4" = 1'-0"

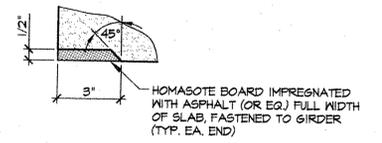


HOMASOTE DETAIL
3" = 1'-0"

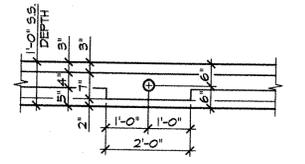


SHEAR KEY DETAIL
1/2" = 1'-0"

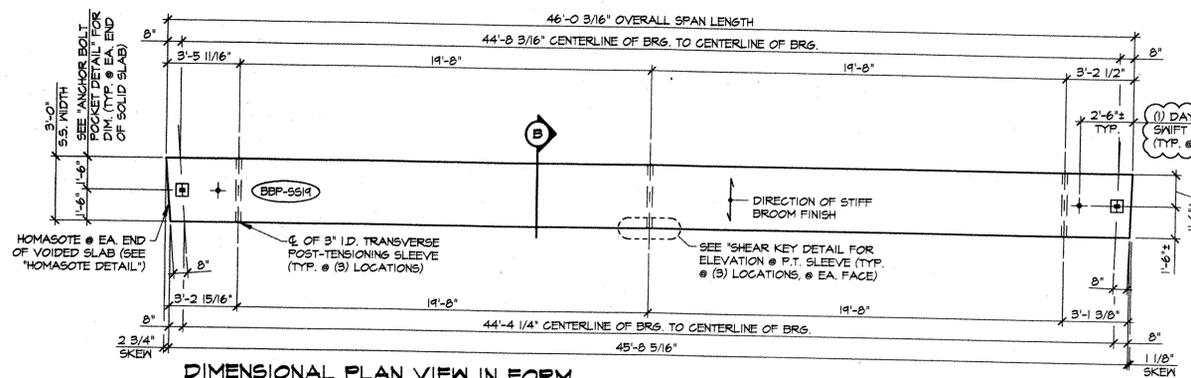


DIMENSIONAL PLAN VIEW IN FORM
1/4" = 1'-0"

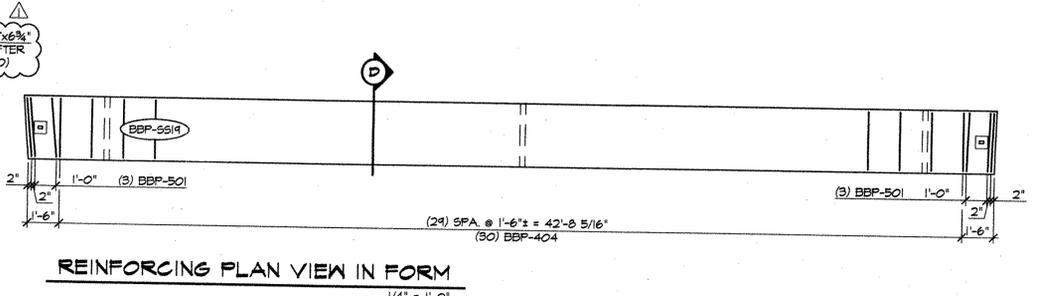


REINFORCING PLAN VIEW IN FORM
1/4" = 1'-0"

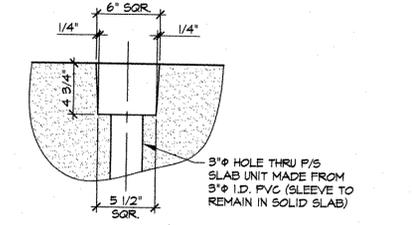


POST-TENSIONING POCKET DETAIL
1 1/2" = 1'-0"

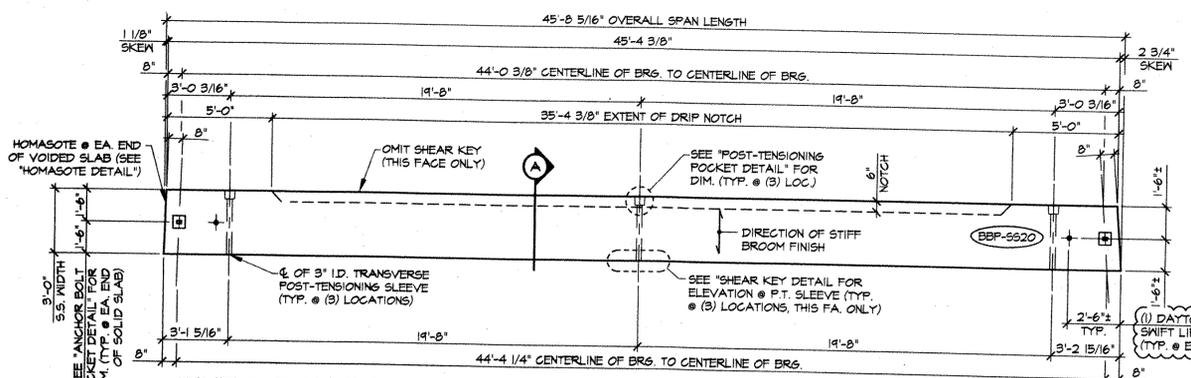


DIMENSIONAL PLAN VIEW IN FORM
1/4" = 1'-0"

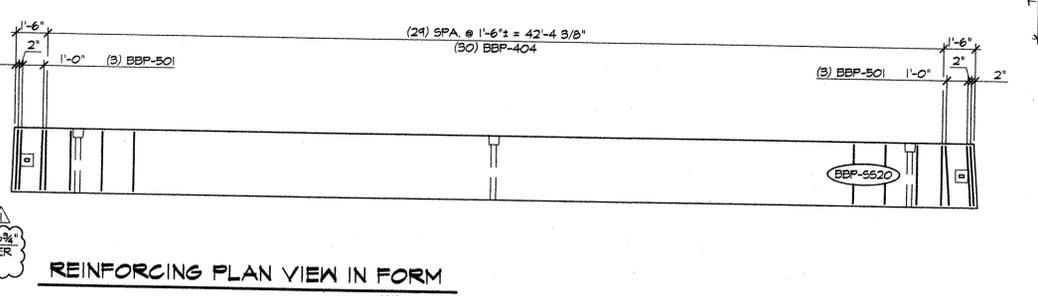


REINFORCING PLAN VIEW IN FORM
1/4" = 1'-0"

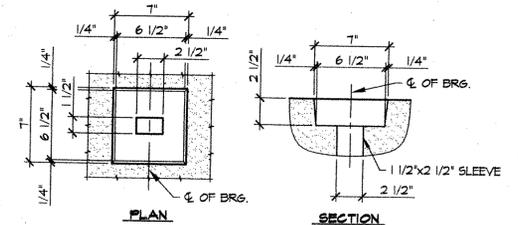


ANCHOR BOLT POCKET DETAIL
1 1/2" = 1'-0"

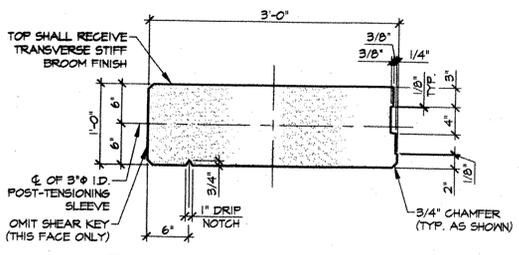

A DIMENSIONAL SECTION
1" = 1'-0"

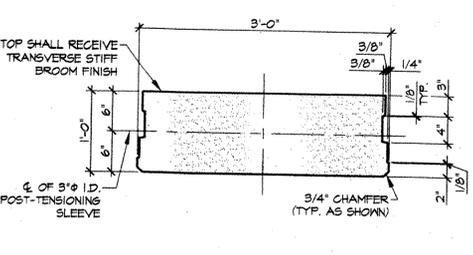


B DIMENSIONAL SECTION
1" = 1'-0"

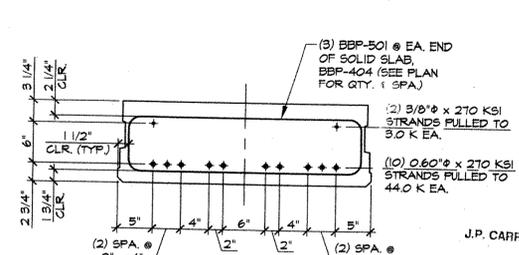

D REINFORCING SECTION
1" = 1'-0"

DETENSIONING SCHEDULE
N.T.S.

① ②
③ ④ ⑤ ⑥ ⑦ ⑧ ⑨ ⑩ ⑪ ⑫ ⑬ ⑭ ⑮ ⑯ ⑰ ⑱ ⑲ ⑳ ㉑ ㉒ ㉓ ㉔ ㉕ ㉖ ㉗ ㉘ ㉙ ㉚ ㉛ ㉜ ㉝ ㉞ ㉟ ㊱ ㊲ ㊳ ㊴ ㊵ ㊶ ㊷ ㊸ ㊹ ㊺ ㊻ ㊼ ㊽ ㊾ ㊿

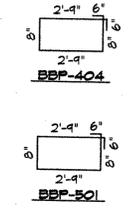

MARK: BBP-5518	QTY.: 1	WT.: 10.06 T	VOL.: 4.97 cy
MARK: BBP-5519	QTY.: 1	WT.: 9.99 T	VOL.: 4.93 cy
MARK: BBP-5520	QTY.: 1	WT.: 10.07 T	VOL.: 4.97 cy

MATERIAL LIST / SOLID SLAB					
ITEM	MARK	DESCRIPTION	QTY./SLAB		
			5518	5519	5520
1	404	#4 BENT BAR	30	30	30
2	501	#5 BENT BAR	6	6	6
4		DAYTON 8T x 6 3/4\"/>	2	2	2

APPROVAL STAMP:

RECEIVED
NOV 14 2003

RESUBMIT APPROVED
DATE 12/3/03

J.P. CARRARA & SONS INC.
Precast & Prestress Manufacturer
2644 CASE STR., MIDDLEBURY, VERMONT 05753 Phone: (802)338-6361 Fax: (802)388-9010

KUBRICKY CONSTRUCTION CORP.
CONTRACTOR
GLENS FALLS, NEW YORK

STATE OF VERMONT
AGENCY OF TRANSPORTATION

TOWN OF COLCHESTER
PROJECT NUMBER: STP BIKE (48)

P/S SOLID SLAB DETAILS

DATE: SEPT. 26, 2003
SCALE: NOTED
CHKD: DFTM: B.L.
JOB NO: 23169-03
DWG. NO: S57
106