




HOMASOTE DETAIL
3" = 1'-0"

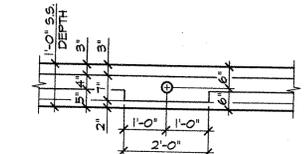


SHEAR KEY DETAIL
1/2" = 1'-0"

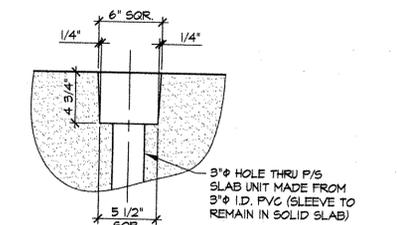


POST-TENSIONING POCKET DETAIL
1 1/2" = 1'-0"

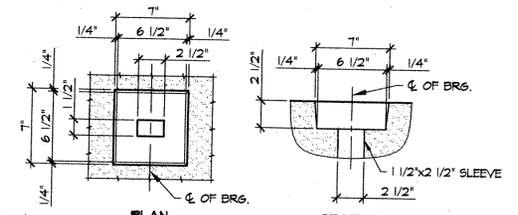


ANCHOR BOLT POCKET DETAIL
1 1/2" = 1'-0"

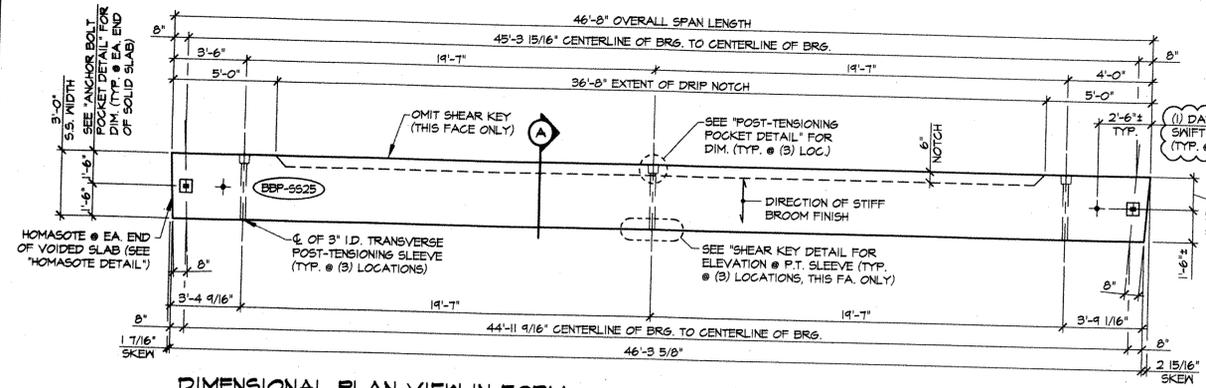


DIMENSIONAL PLAN VIEW IN FORM
1/4" = 1'-0"

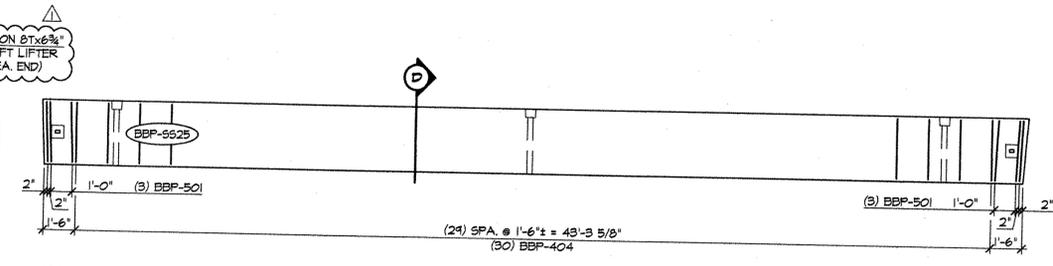


REINFORCING PLAN VIEW IN FORM
1/4" = 1'-0"

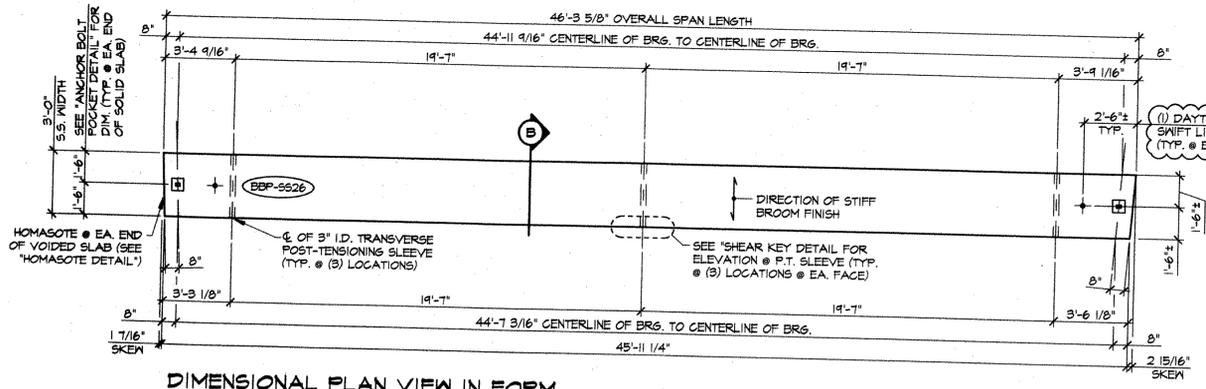


DIMENSIONAL PLAN VIEW IN FORM
1/4" = 1'-0"

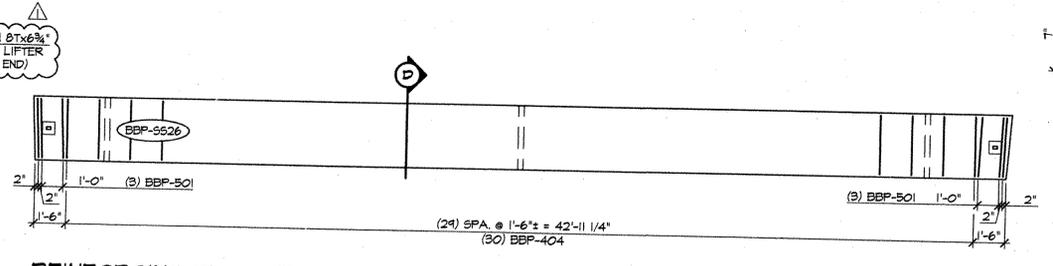


REINFORCING PLAN VIEW IN FORM
1/4" = 1'-0"

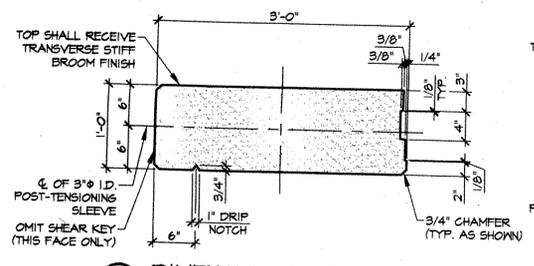

A DIMENSIONAL SECTION
1" = 1'-0"

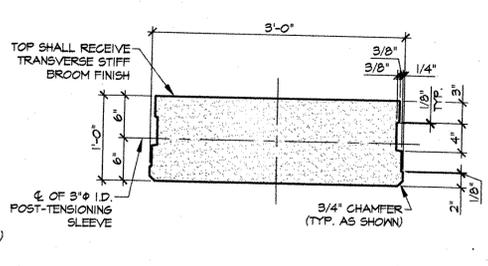

B DIMENSIONAL SECTION
1" = 1'-0"

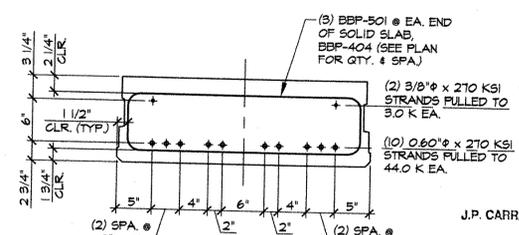

D REINFORCING SECTION
1" = 1'-0"

① ②

BBP-404

BBP-501

DETENSIONING SCHEDULE
N.T.S.

MARK:	QTY.:	WT.:	VOL.:	
MARK: BBP-5525	QTY.:	WT. 10.28 T	VOL. 5.08 cy	f _{ci} = 4,000 PSI f _c = 6,000 PSI
MARK: BBP-5526	QTY.:	WT. 10.21 T	VOL. 5.04 cy	
MATERIAL LIST / SOLID SLAB				
ITEM	MARK	DESCRIPTION	QTY./SLAB	
1	404	#4 BENT BAR	30	30
2	501	#5 BENT BAR	6	6
3				
4	△	DAYTON 8T x 6 3/4" SWIFT LIFT LIFTER	2	2
5				

APPROVAL STAMP:

RECEIVED
NOV 14 2003

RESUBMIT: _____ APPROVED: _____
BY: _____ DATE: 12/3/03

J.P. CARRARA & SONS INC. PRECAST & PRESTRESS MANUFACTURER
2464 CASE STR., MIDDLEBURY, VERMONT 05753 Phone: (802)388-6361 Fax: (802)388-9010

KUBRICKY CONSTRUCTION CORP. CONTRACTOR
GLENS FALLS, NEW YORK

STATE OF VERMONT AGENCY OF TRANSPORTATION
TOWN OF COLCHESTER PROJECT NUMBER: STP BIKE (48)

P/S SOLID SLAB DETAILS

DATE: SEPT. 26, 2003
SCALE: NOTED
CHKD: DFTM: B.L.
JOB NO: 23164-03
DWG. NO: 559
108

J.P. CARRARA & SONS, INC.
NOV 12 2003
ISSUED FOR PRODUCTION