




DIMENSIONAL PLAN VIEW IN FORM
1/4" = 1'-0"

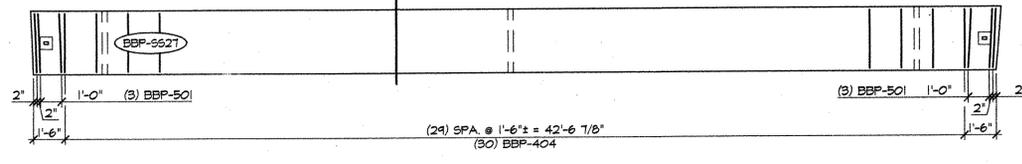


REINFORCING PLAN VIEW IN FORM
1/4" = 1'-0"

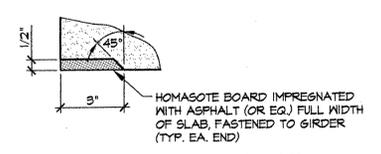


HOMASOTE DETAIL
3" = 1'-0"

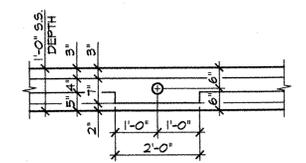


SHEAR KEY DETAIL
1/2" = 1'-0"

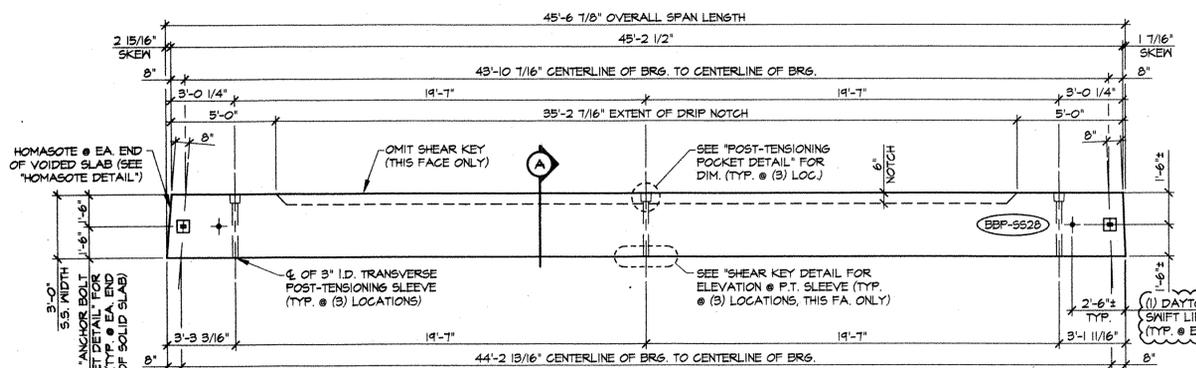


DIMENSIONAL PLAN VIEW IN FORM
1/4" = 1'-0"

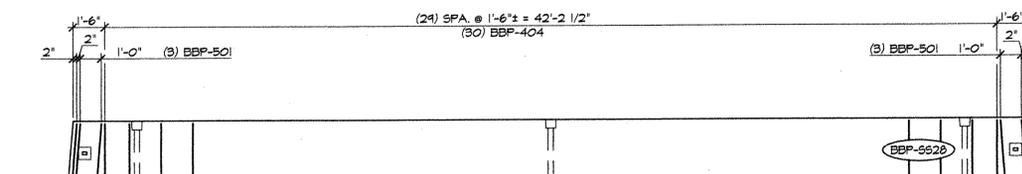


REINFORCING PLAN VIEW IN FORM
1/4" = 1'-0"

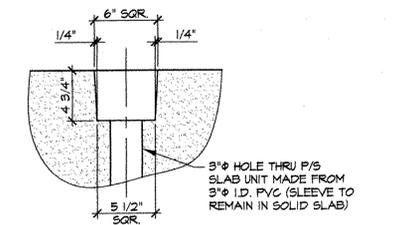


POST-TENSIONING POCKET DETAIL
1 1/2" = 1'-0"

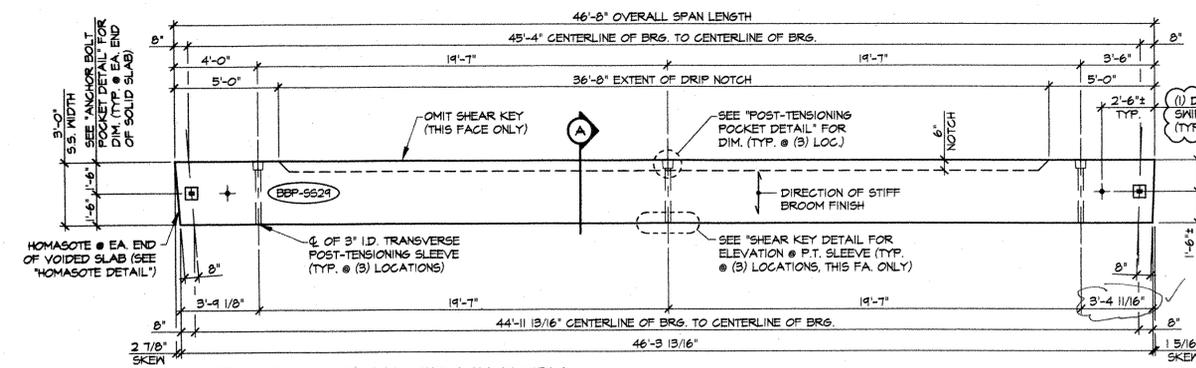


DIMENSIONAL PLAN VIEW IN FORM
1/4" = 1'-0"

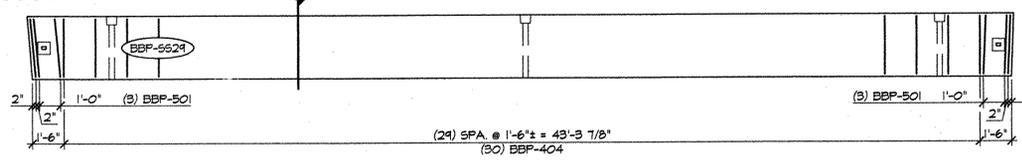


REINFORCING PLAN VIEW IN FORM
1/4" = 1'-0"

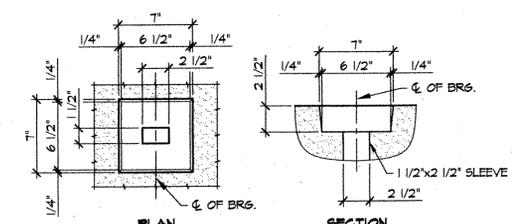


ANCHOR BOLT POCKET DETAIL
1 1/2" = 1'-0"

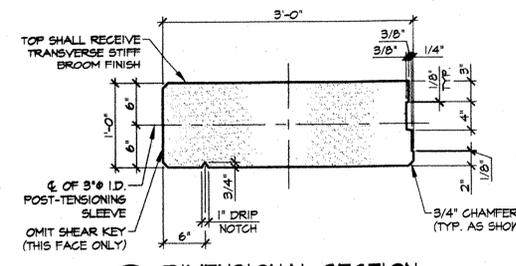

A DIMENSIONAL SECTION
1" = 1'-0"

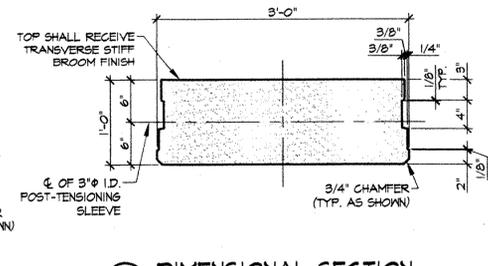

B DIMENSIONAL SECTION
1" = 1'-0"

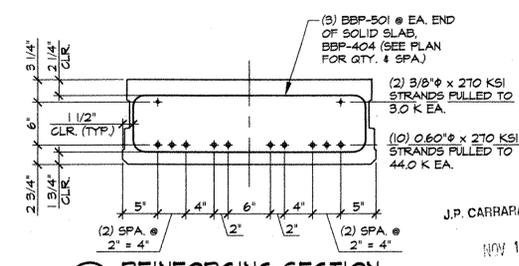


D REINFORCING SECTION
1" = 1'-0"

Handwritten notes:
3'-2 1/2"
3'-2 1/8"
- 1/8"
43'-3 3/8"
3'-4 1/8"
3'-4 1/8"
46'-0"

DETENSIONING SCHEDULE
N.T.S.

①	②
③ ⑤ ⑦ ⑨ ⑪	⑫ ⑭ ⑯ ⑰ ⑱

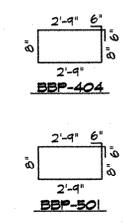

MARK: BBP-5521	QTY.: 1	WT.: 9.97 T	VOL.: 4.92 cy	△ f'c = 4,000 PSI f'c = 6,000 PSI	
MARK: BBP-5528	QTY.: 1	WT.: 10.04 T	VOL.: 4.96 cy		
MARK: BBP-5529	QTY.: 1	WT.: 10.28 T	VOL.: 5.08 cy		
MATERIAL LIST / SOLID SLAB					
ITEM	MARK	DESCRIPTION	QTY./SLAB		
1	404	#4 BENT BAR	30	30	30
2	501	#5 BENT BAR	6	6	6
3					
4	△	DAYTON 8T x 6 3/4" SWIFT LIFT LIFTER	2	2	2
5					

APPROVAL STAMP:

RECEIVED
NOV 14 2003

RESUBMIT: _____ APPROVED: _____
BY: _____ DATE: 12/3/03

J.P. CARRARA & SONS INC. **KUBRICKY CONSTRUCTION CORP.**
Precast & Prestress Manufacturer CONTRACTOR
2444 CASE STR., MIDDLEBURY, VERMONT 05753 Phone: (802)388-6361 Fax: (802)388-9010 GLENS FALLS, NEW YORK

STATE OF VERMONT
AGENCY OF TRANSPORTATION

TOWN OF COLCHESTER
PROJECT NUMBER: STP BIKE (48)

P/S SOLID SLAB DETAILS

DATE: SEPT. 26, 2003
SCALE: NOTED
CHKD: _____ DFTM: B.L.
JOB NO: 23169-03
DWG. NO: **SS10**
109