




**DIMENSIONAL PLAN VIEW IN FORM**  
1/4" = 1'-0"

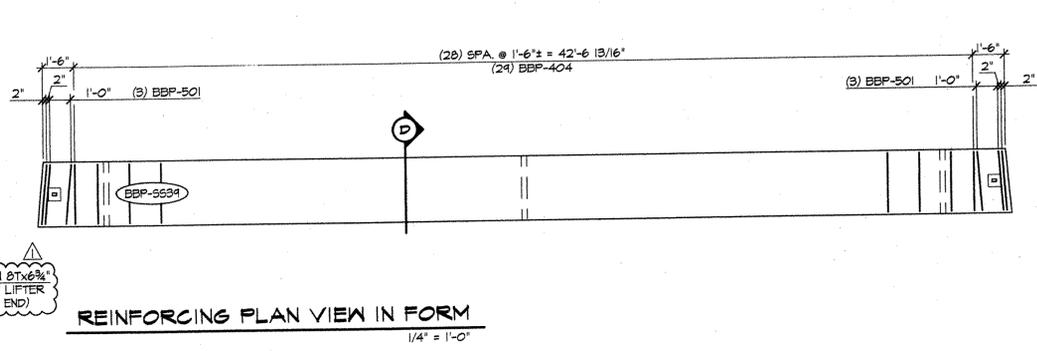


**REINFORCING PLAN VIEW IN FORM**  
1/4" = 1'-0"

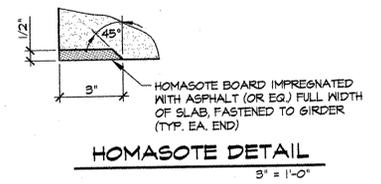


**HOMASOTE DETAIL**  
3\"/>

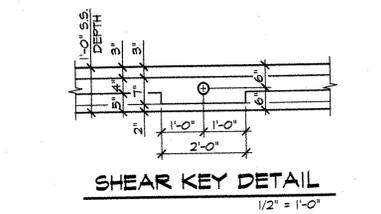


**SHEAR KEY DETAIL**  
1/2\"/>

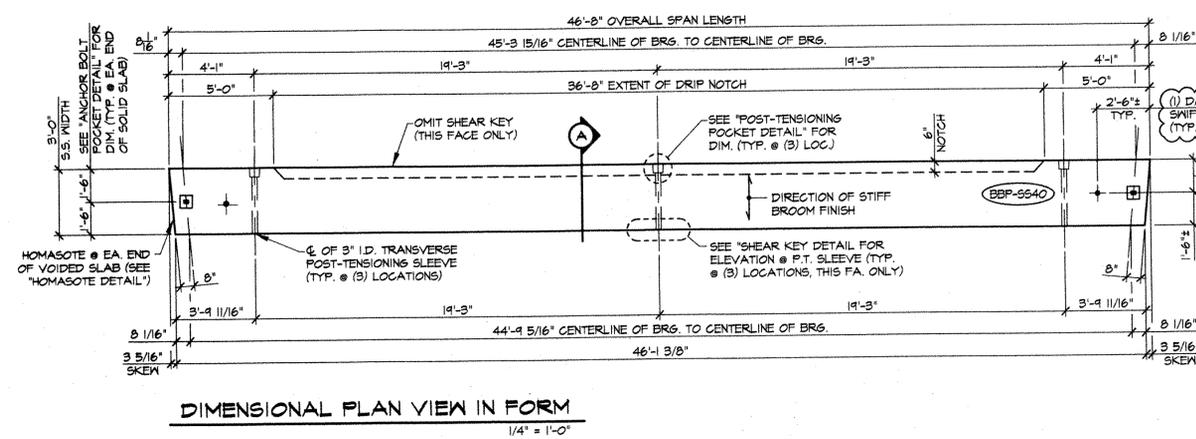


**DIMENSIONAL PLAN VIEW IN FORM**  
1/4" = 1'-0"

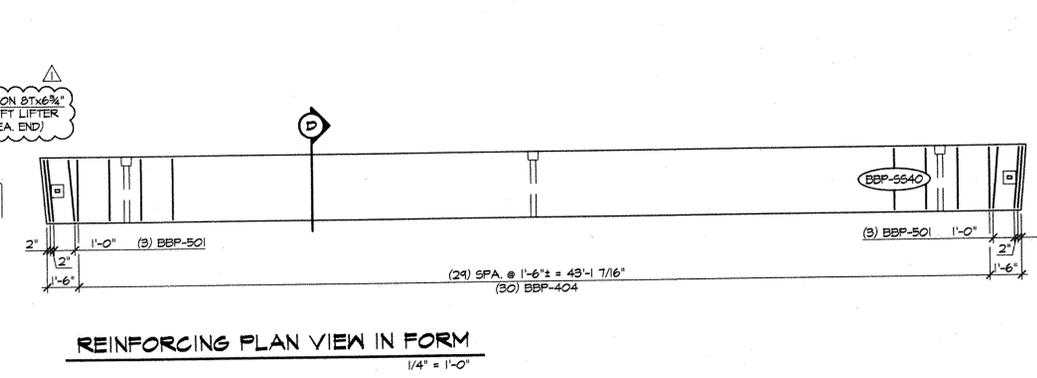


**REINFORCING PLAN VIEW IN FORM**  
1/4" = 1'-0"

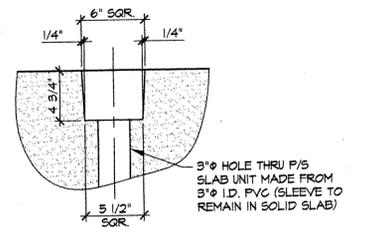


**POST-TENSIONING POCKET DETAIL**  
1 1/2\"/>

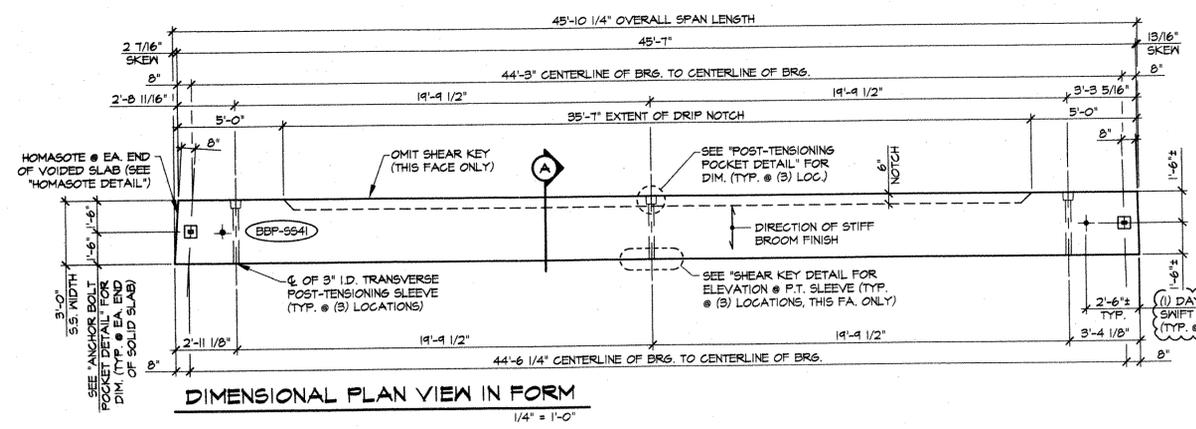


**DIMENSIONAL PLAN VIEW IN FORM**  
1/4" = 1'-0"

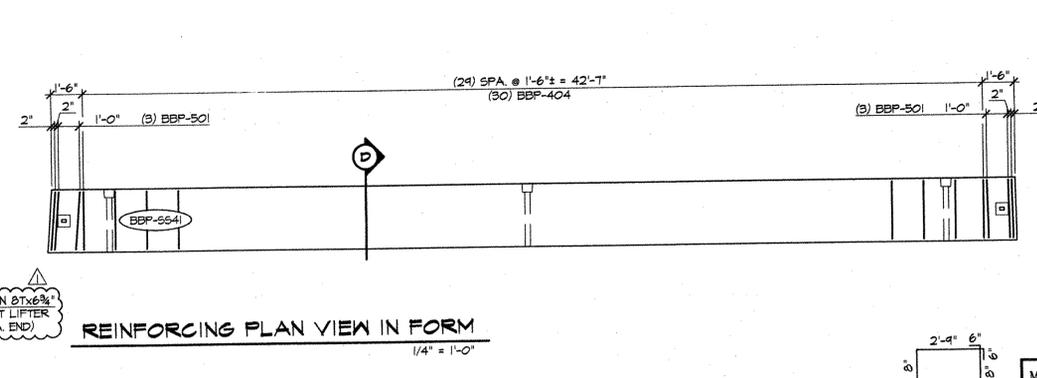


**REINFORCING PLAN VIEW IN FORM**  
1/4" = 1'-0"

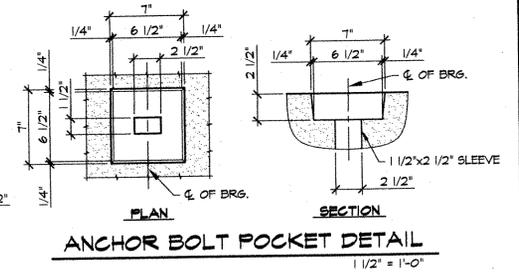


**ANCHOR BOLT POCKET DETAIL**  
1 1/2\"/>

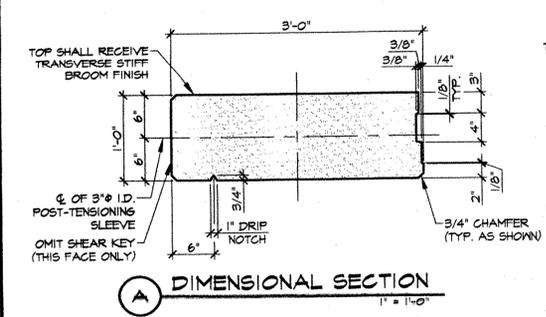

**A DIMENSIONAL SECTION**  
1\"/>

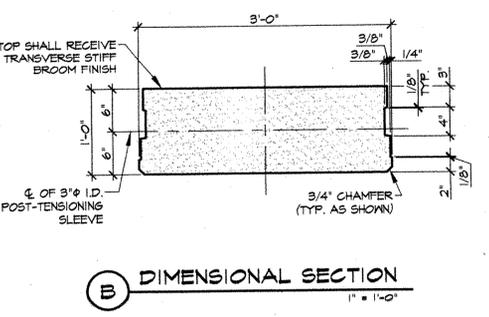


**B DIMENSIONAL SECTION**  
1\"/>

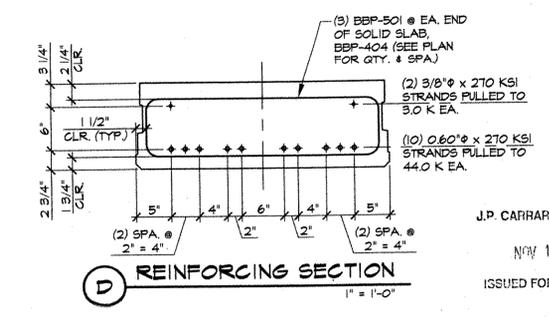

**D REINFORCING SECTION**  
1\"/>

① ②  
③ ④ ⑤ ⑥ ⑦ ⑧ ⑨ ⑩ ⑪ ⑫ ⑬ ⑭ ⑮ ⑯ ⑰ ⑱ ⑲ ⑳ ㉑ ㉒ ㉓ ㉔ ㉕ ㉖ ㉗ ㉘ ㉙ ㉚ ㉛ ㉜ ㉝ ㉞ ㉟ ㊱ ㊲ ㊳ ㊴ ㊵ ㊶ ㊷ ㊸ ㊹ ㊺

**DETENSIONING SCHEDULE**  
N.T.S.

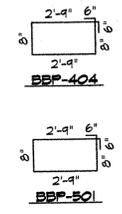

MARK: BBP-5534	QTY.: 1	WT.: 9.99 T	VOL.: 4.93 cy
MARK: BBP-5540	QTY.: 1	WT.: 10.26 T	VOL.: 5.07 cy
MARK: BBP-5541	QTY.: 1	WT.: 10.11 T	VOL.: 4.99 cy

MATERIAL LIST / SOLID SLAB					
ITEM	MARK	DESCRIPTION	QTY./SLAB		
			5534	5540	5541
1	404	#4 BENT BAR	29	30	30
2	501	#5 BENT BAR	6	6	6
3					
4		DAYTON 8\"/>	2	2	2
5					

APPROVAL STAMP:

RECEIVED  
NOV 14 2003

RESUBMIT APPROVED  
DATE 12/3/03

**J.P. CARRARA & SONS INC.** PRECAST & PRESTRESS MANUFACTURER  
2484 CASE ST., WOODFURY, VERMONT 05753 Phone: (802)388-6361 Fax: (802)388-9010

**KUBRICKY CONSTRUCTION CORP.** CONTRACTOR  
GLENS FALLS, NEW YORK

DATE: SEPT. 26, 2003  
SCALE: NOTED  
CHKD: DFTM: B.L.  
JOB NO: 23169-03

**STATE OF VERMONT**  
**AGENCY OF TRANSPORTATION**

**TOWN OF COLCHESTER**  
PROJECT NUMBER: STP BIKE (48)

**P/S SOLID SLAB DETAILS**

DWG. NO: **SS14**  
113