




DIMENSIONAL PLAN VIEW IN FORM
1/4" = 1'-0"

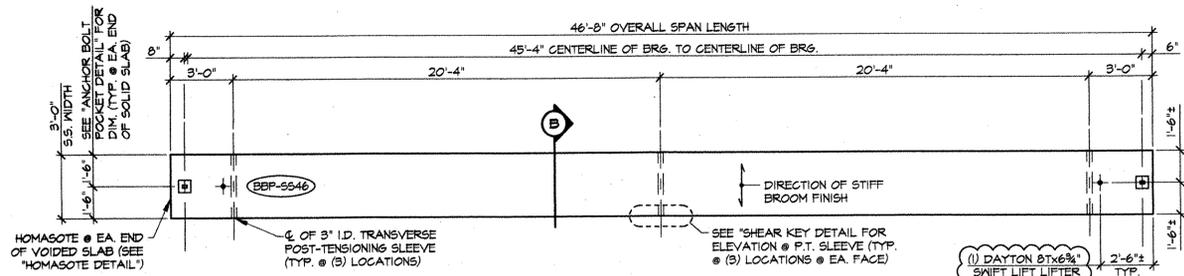


DIMENSIONAL PLAN VIEW IN FORM
1/4" = 1'-0"

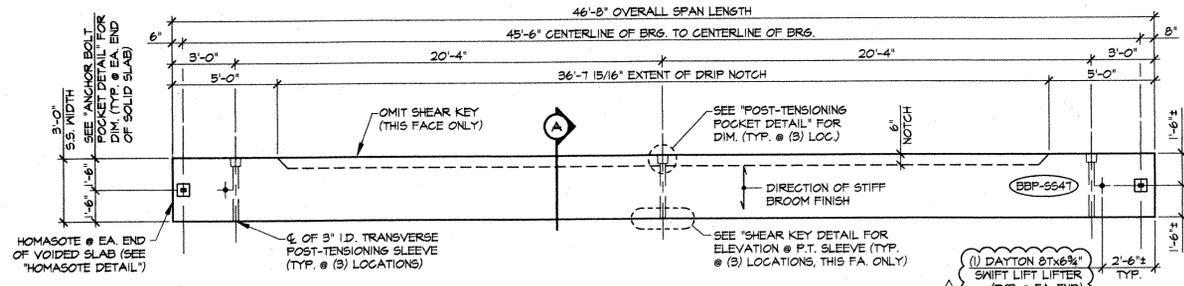


DIMENSIONAL PLAN VIEW IN FORM
1/4" = 1'-0"

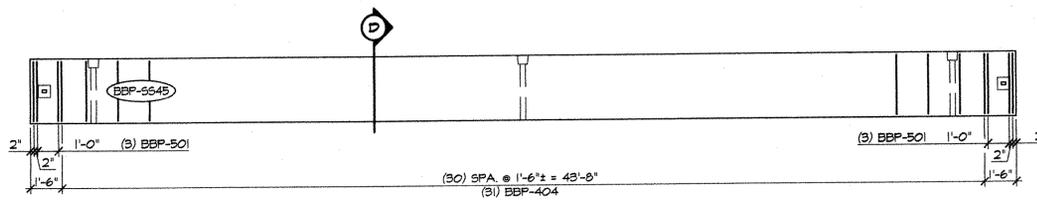


REINFORCING PLAN VIEW IN FORM
1/4" = 1'-0"

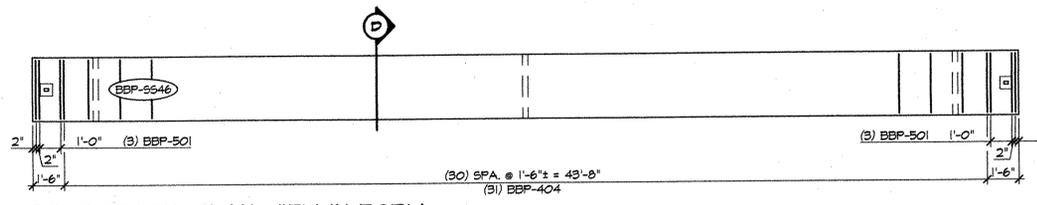


REINFORCING PLAN VIEW IN FORM
1/4" = 1'-0"

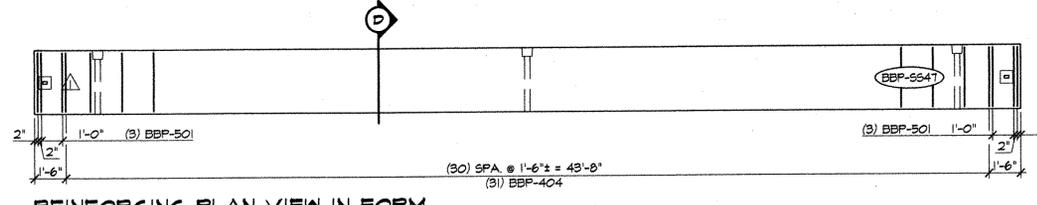


REINFORCING PLAN VIEW IN FORM
1/4" = 1'-0"

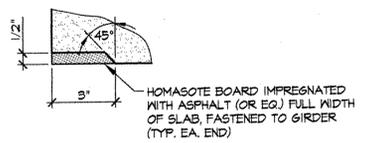


HOMASOTE DETAIL
3" = 1'-0"

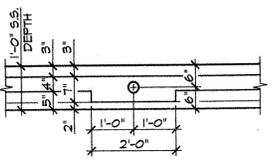

SHEAR KEY DETAIL
1/2" = 1'-0"

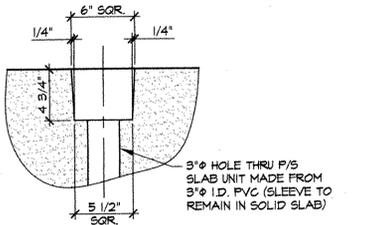

POST-TENSIONING POCKET DETAIL
1 1/2" = 1'-0"

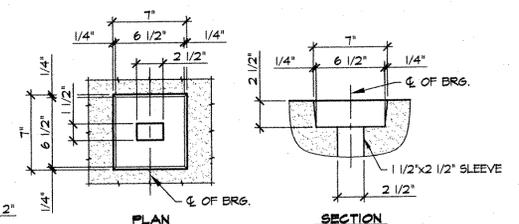


ANCHOR BOLT POCKET DETAIL
1 1/2" = 1'-0"

① ②


③ ⑤ ⑦ ⑨ ⑪ ⑫ ⑬ ⑭ ⑯ ⑰ ⑱

DETENSIONING SCHEDULE


N.T.S.

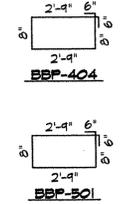


MARK: BBP-SS45	QTY.: 1	WT.: 10.32 T	VOL.: 5.10 cy	Pci = 4000 PSI Fc = 6000 PSI	
MARK: BBP-SS46	QTY.: 2	WT.: 10.17 T	VOL.: 5.02 cy		
MARK: BBP-SS47	QTY.: 1	WT.: 10.32 T	VOL.: 5.10 cy		
MATERIAL LIST / SOLID SLAB					
ITEM	MARK	DESCRIPTION	QTY./SLAB		
			SS45	SS46	SS47
1	404	#4 BENT BAR	31	31	31
2	501	#5 BENT BAR	6	6	6
3					
4	DAYTON	8T x 6 3/4" SWIFT LIFT LIFTER	2	2	2
5					

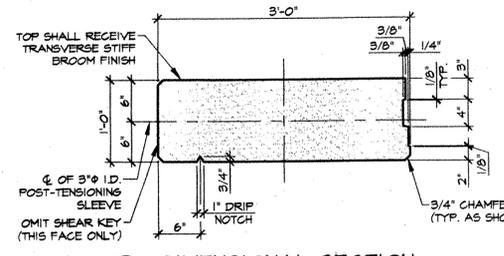

A DIMENSIONAL SECTION
1" = 1'-0"

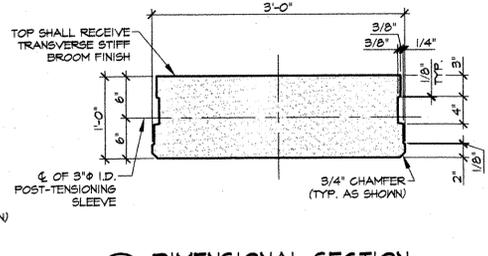

B DIMENSIONAL SECTION
1" = 1'-0"

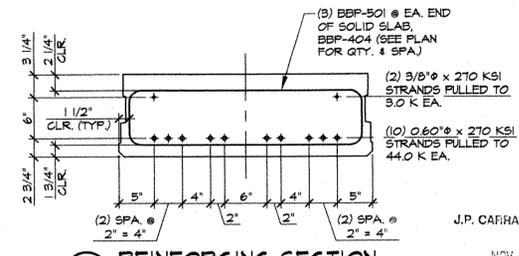

D REINFORCING SECTION
1" = 1'-0"

APPROVAL STAMP:
 RECEIVED
 NOV 14 2003
 RESUBMIT APPROVED
 BY DATE 12/17/03

J.P. CARRARA & SONS INC. KUBRICKY CONSTRUCTION CORP.
 Precast & Prestress Manufacturer CONTRACTOR
 2464 CASE STR., MIDDLEBURY, VERMONT 05753 Phone: (802)388-6361 Fax: (802)388-9010
 GLENS FALLS, NEW YORK
STATE OF VERMONT DATE: SEPT. 26, 2003
AGENCY OF TRANSPORTATION SCALE: NOTED
TOWN OF COLCHESTER CHKD: DFTM: B.L.
PROJECT NUMBER: STP BIKE (48) JOB NO: 23164-03
P/S SOLID SLAB DETAILS DWG. NO: **SS16**
 115