



BENT BARS, TIES, & STIRRUPS

ITEM	MARK	QTY.	SIZE	LENGTH	TYPE	A	B	C	D	E	F/R	G	H	J	K	O	GRADE	REMARKS
1	401	468	#4	7'-11"	T2	6"	3'-0"	8"	3'-0"	8"		6"					60	
2	402	216	#4	3'-4 3/4"	S10		1'-6"	6 3/4"	1'-6"								60	
3	403	144	#4	5'-8 3/4"	S10		1'-6"	2'-10 3/4"	1'-6"								60	
4	404	5,256	#4	7'-3"	T2	6"	2'-4"	8"	2'-4"	8"		6"					60	
5																		
6	501	888	#5	7'-2 3/8"	T2	6"	2'-4"	8"	2'-4"	8"		6"					60	
7																		
8																		
9																		
10																		

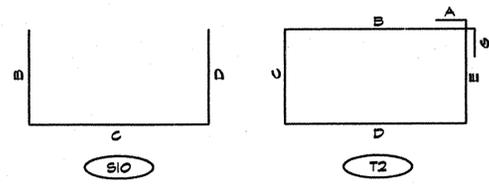


MISCELLANEOUS MATERIALS


ITEM	MARK	QTY.	DESCRIPTION	REMARKS
1	EM-1	222	1/2" WASHER 3/4" x 5" x 5" W/ (1) 2" HOLE (GALV.)	FOR ERECTION, SEE DETAIL THIS SHEET
2	EM-3	368	1/2" WASHER 3/4" x 5" x 5" W/ (1) 1 1/2" HOLE (GALV.)	FOR ERECTION, SEE DETAIL THIS SHEET
3		222	SINGLE USE STRESSING CHUCK	FOR ERECTION
4		111	1/2" x 14'-4" POLYSTRAND	FOR ERECTION
5		296	1 1/4" x 1'-10" ANCHOR BOLT (GALV.)	FOR ERECTION, SEE DETAIL THIS SHEET
6		T2	1 1/4" x 2'-6 1/2" ANCHOR BOLT (GALV.)	FOR ERECTION, SEE DETAIL THIS SHEET
7				
8				
9			(14) DAYTON 2T x 6 3/4" SWIFT LIFT LIFTER	
10	BBB-L1	144	DAYTON 2T x 6" (MIN) SWIFT LIFT LIFTER (OR SIM)	
11				
12				
13				
14				
15				

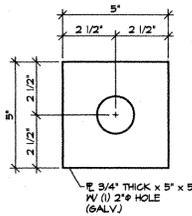


EM - 1
3" = 1'-0"

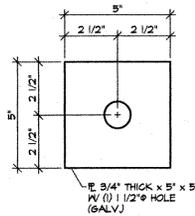

EM - 3
3" = 1'-0"

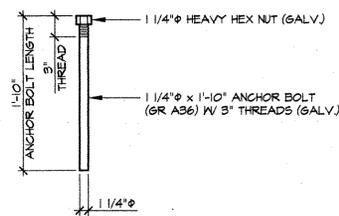

ANCHOR BOLT DETAIL
1" = 1'-0"

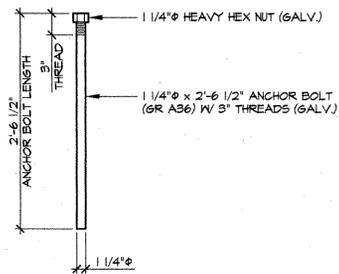

ANCHOR BOLT DETAIL
1" = 1'-0"

J.P. CARRARA & SONS, INC.

NOV 12 2003

ISSUED FOR PRODUCTION

11-11-03 REVISED AS NOTED

APPROVAL STAMP:

RECEIVED
 OK'D BY: *WGM* OK'D BY: _____
 NOV 14 2003
 RESUBMIT _____ APPROVED _____
 BY: _____ DATE 12/3/03

J.P. CARRARA & SONS INC. Precast & Prestress Manufacturer 2464 CASE STR., MIDDLEBURY, VERMONT 05753 Phone:(802)388-6361 Fax:(802)388-9010		KUBRICKY CONSTRUCTION CORP. CONTRACTOR GLENS FALLS, NEW YORK	
STATE OF VERMONT AGENCY OF TRANSPORTATION		DATE: SEPT. 26, 2003	SCALE: NOTED
TOWN OF COLCHESTER PROJECT NUMBER: STP BIKE (48)		CHKD: _____ DFTM: B.L.	JOB NO: 23164-03
MATERIALS LIST		DWG. NO: M1	116