

STATE OF VERMONT AGENCY OF TRANSPORTATION

PROPOSED IMPROVEMENT

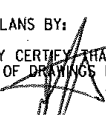
RAIL TRAIL PROJECT – MISSISQUOI VALLEY RAIL TRAIL (MVRT) IN THE TOWNS OF ST. ALBANS, SWANTON, FAIRFIELD, SHELDON, ENOSBURG, BERKSHIRE, AND RICHFORD; AND BEEBE SPUR RAIL TRAIL IN THE TOWNS OF NEWPORT AND DERBY

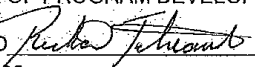
FRANKLIN COUNTY AND ORLEANS COUNTY

TOTAL PROJECT LENGTH = 30.16
MISSISQUOI VALLEY RAIL TRAIL – 26.33 MILES
BEEBE SPUR RAIL TRAIL – 3.83 MILES

WORK TO BE PERFORMED UNDER THIS PROJECT INCLUDES PREPARING THE EXISTING SURFACE, APPLYING A GEOTEXTILE FABRIC TO THE EXISTING TRAIL SURFACE (MVRT ONLY), RESURFACING THE TRAIL WITH A NEW AGGREGATE SURFACE, INSTALLATION OF DETECTABLE WARNINGS AT ROAD CROSSINGS AND NEW SIGNS.

THESE PLANS ARE SUBJECT TO SUCH ENGINEERING CHANGES AS MAY BE REQUIRED BY THE FEDERAL HIGHWAY ADMINISTRATION OR THE DIRECTOR OF PROGRAM DEVELOPMENT. CONSTRUCTION IS TO BE CARRIED ON IN ACCORDANCE WITH THESE PLANS AND THE STANDARD SPECIFICATIONS FOR CONSTRUCTION DATED 2006, AS APPROVED BY THE FEDERAL HIGHWAY ADMINISTRATION ON JANUARY 15, 2006 FOR USE ON THIS PROJECT, INCLUDING ALL SUBSEQUENT REVISIONS AND SUCH REVISED SPECIFICATIONS AND SPECIAL PROVISIONS AS ARE INCORPORATED IN THESE PLANS.

RECORD PLANS	
CONTRACTOR:	G.W. TATRO CONSTRUCTION, INC. JEFFERSONVILLE, VERMONT
RESIDENT ENGINEER:	JEFF COTA
CONSTRUCTION BEGAN:	APRIL 19, 2010
CONSTRUCTION COMPLETED:	DECEMBER 12, 2010
RECORD PLANS BY:	JEFF COTA & AMOS KEMPTON
I HEREBY CERTIFY THAT ALL THE CONSTRUCTION REQUIRED BY THIS SET OF DRAWINGS HAS BEEN ACCOMPLISHED AS INDICATED HEREIN.	
BY:	 , RESIDENT ENGINEER
DATE:	8/3/11
NOTE: ANY FURTHER INFORMATION CONCERNING FINAL QUANTITIES, AMOUNTS OR OTHER DETAILS RELATIVE TO THIS PROJECT MAY BE FOUND ON MICROFILM IN CENTRAL FILES.	

DIRECTOR OF PROGRAM DEVELOPMENT
APPROVED  DATE 10-8-09
PROJECT MANAGER: JON KAPLAN
PROJECT STATEWIDE STP NWRT(1)
SHEET 1 OF 20 SHEETS