


**LEGEND**

89 INTERSTATE  
 7 U.S. ROUTE  
 105 STATE ROUTE  
 TOWN HIGHWAY

NOTE: THE FOLLOWING AREAS (SHOWN AS THE HATCHED PATTERN) ARE ENVIRONMENTALLY SENSITIVE. NO EXCAVATION, STORAGE OF MATERIALS OR OTHER DISTURBANCE IS ALLOWED IN THESE AREAS UNLESS OTHERWISE SPECIFIED IN THE PLANS OR DIRECTED BY THE RESIDENT ENGINEER.

RR MM	OFFSET	RR MM	OFFSET
1.08 TO 1.40	LT	8.10 TO 8.43	LT&RT
1.08 TO 1.65	RT	8.45 TO 8.57	RT
2.01 TO 3.55	RT	8.49 TO 8.57	LT
2.40 TO 3.55	LT	9.00 TO 9.57	LT&RT
4.10 TO 4.60	LT&RT		

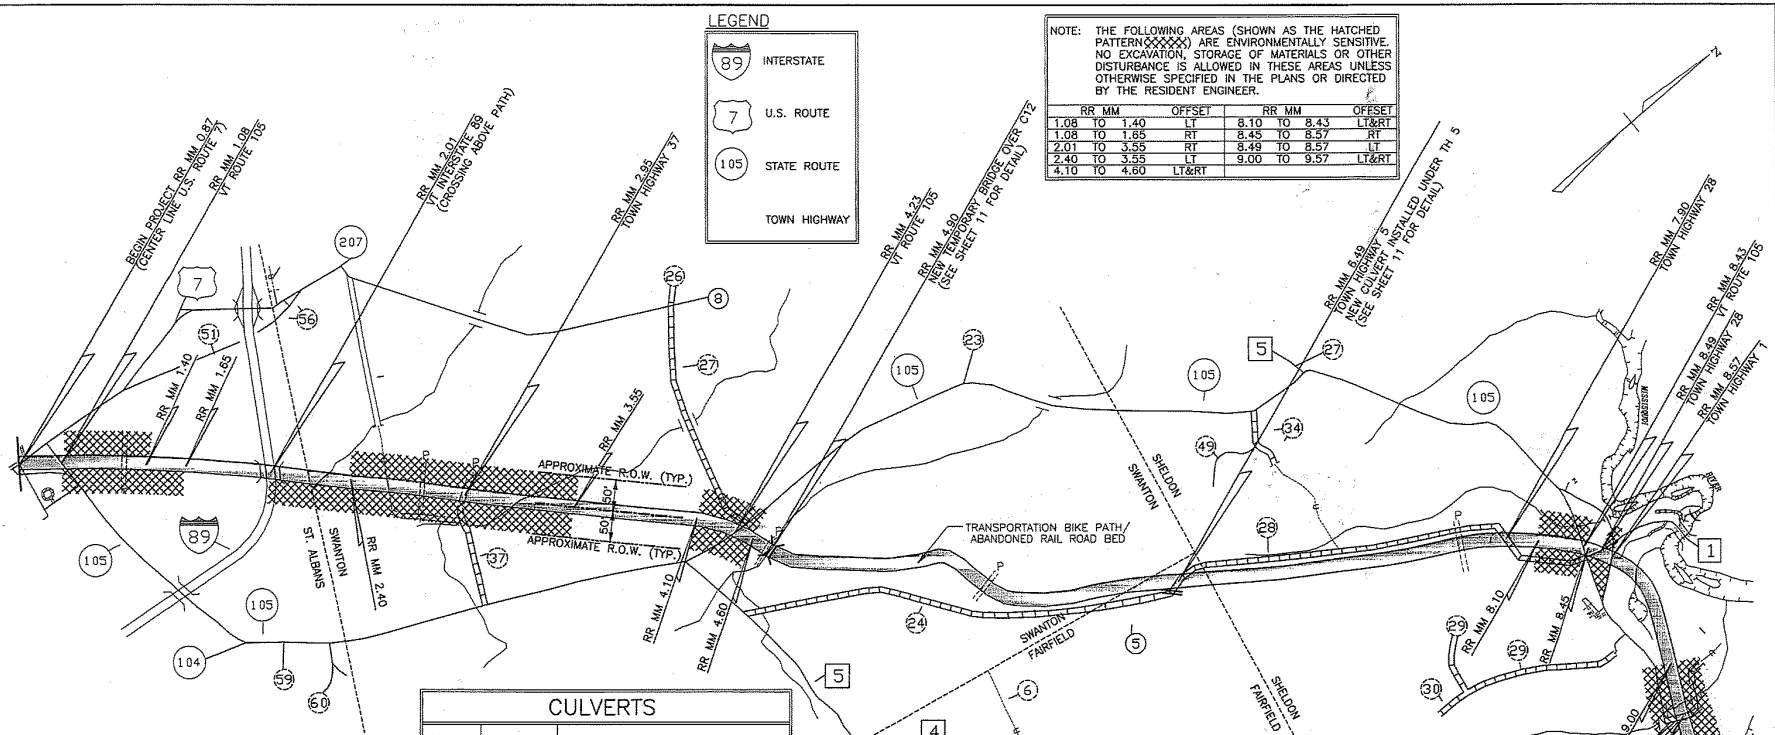

**SOLID WASTE**

STATION	IDENTIFIER	VOLUME & DESCRIPTION
0.78 TO 1.33	S1	3 cy TRASH
1.43	S2	15 cy TRASH, APPLIANCES, TIRES
1.79	S3	OLD MATTRESS
2.54	S4	3 cy TRASH
3.01	S5	OLD SWING SET
4.13	S6	15 cy TRASH, APPLIANCES, TIRES
6.00	S7	3 cy TRASH
6.09	S8	3 cy TRASH
6.20 TO 6.23	S9	15 cy TRASH
6.29	S10	7 cy TRASH, CONSTRUCTION DEBRIS
6.40 TO 6.42	S11	15 cy TRASH
8.13 TO 8.18	S12	SHARPS, TRUCKS, DEBRIS
8.63	S13	55 GAL OIL DRUM EMPTY

NOTE: ALL SOLID WASTE DEPICTED SHALL BE PICKED UP, REMOVED AND DISPOSED OF AS DIRECTED BY THE RESIDENT ENGINEER.

**CULVERTS**

RR MM	IDENTIFIER	TYPE
0.89	C1	24" CMP
1.09	C2	18" CMP
1.44	C3	60" CMP
1.57	C4	18" CMP
1.90	C5	3'x2' CONC. BOX
2.28	C6	6'x7' CONC. BOX
3.15	C7	5'x6' CONC. BOX
3.32	C8	4'x5' CONC. BOX
3.60	C9	6'x7' CONC. BOX
4.34	C10	66" RCP
4.78	C11	24" x18" STONE BOX
4.90	C12	78" x42" STONE & STEEL RAIL BRIDGE
5.23	C13	18" CMP
5.67	C14	30" x36" TIMBER
5.96	C15	24" x24" CONC. BOX
6.38	C16	48" x48" CONC. BOX
6.78	C17	18" CMP
7.41	C18	24" x30" CONC. BOX
7.64	C19	30" x30" CONC. BOX
7.95	C20	18" CMP
8.22	C21	18" x48" STONE BOX
8.71	C22	24" CMP
9.13	C23	18" CMP
9.41	C24	48" RCP

NOTE: THE ONLY WORK TO BE PERFORMED AT THESE CULVERT LOCATIONS ARE TYPICAL CLEARING AS SHOWN ON SHEET 2 OF 21 AND THE NEW TEMPORARY BRIDGE OVER CULVERT C12.

**FARM (F) & PRIVATE (P) CROSSINGS**

RR MM	IDENTIFIER	TYPE
1.17	F1	FARM
	F2	FARM (NOT USED)
2.61	F3	FARM
3.22	F4	FARM
3.82	F5	FARM
4.24	F6	FARM
4.42	F7	FARM
6.78	P1	PRIVATE - 3 TO 4 HOMES
6.91	P2	PRIVATE - 2 HOMES
8.17	FB	FARM
9.25	F9	FARM
9.71	F10	FARM

NOTE: SEE SHEETS 7 THROUGH 10 OF 21 FOR FENCING, GATES AND SIGNING ASSOCIATED WITH THESE CROSSINGS.

- NOTES:**
- THE TRANSPORTATION PATH RIGHT OF WAY IS APPROXIMATELY 50' EACH SIDE OF THE PATH CENTER. THIS SHALL BE THE LIMITS OF CONSTRUCTION.
  - SEE LAYOUT SHEETS 1 THRU 4 FOR LOCATIONS OF FARM AND PRIVATE CROSSINGS, SOLID WASTE AND CULVERTS

DATUM  
 VERTICAL N/A  
 HORIZONTAL N/A

PROJECT NAME/NUMBER: STATEWIDE STP NWRT(1)  
 SHEET 11 OF 20  
 MISSISQUOI VALLEY RAIL TRAIL  
 FOR REFERENCE ONLY