

GUIDE POST (MOD.-BOLLARDS)  
RR MM 38.860 @ (3 EA.)  
(SEE DETAIL SHEET 15)

POWER GRADER RENTAL  
RR MM 38.861 - RR MM 38.344  
(GRADING OF EXISTING BALLAST)

~~GEOTEXTILE FOR ROADDED SUBGRADE SEPARATOR  
RR MM 38.861 - RR MM 38.344  
PLACE UNDER AGGREGATE SURFACE COURSE 10' WIDTH~~


AGGREGATE SURFACE COURSE  
RR MM 38.861 - RR MM 38.344



EACH SIGN PLACED ON 1 POST  
1 SIGN EACH SIDE OF ROAD



BEGIN PROJECT  
BEEBE SPUR  
STP BIKE (19)S  
RR MM 38.861

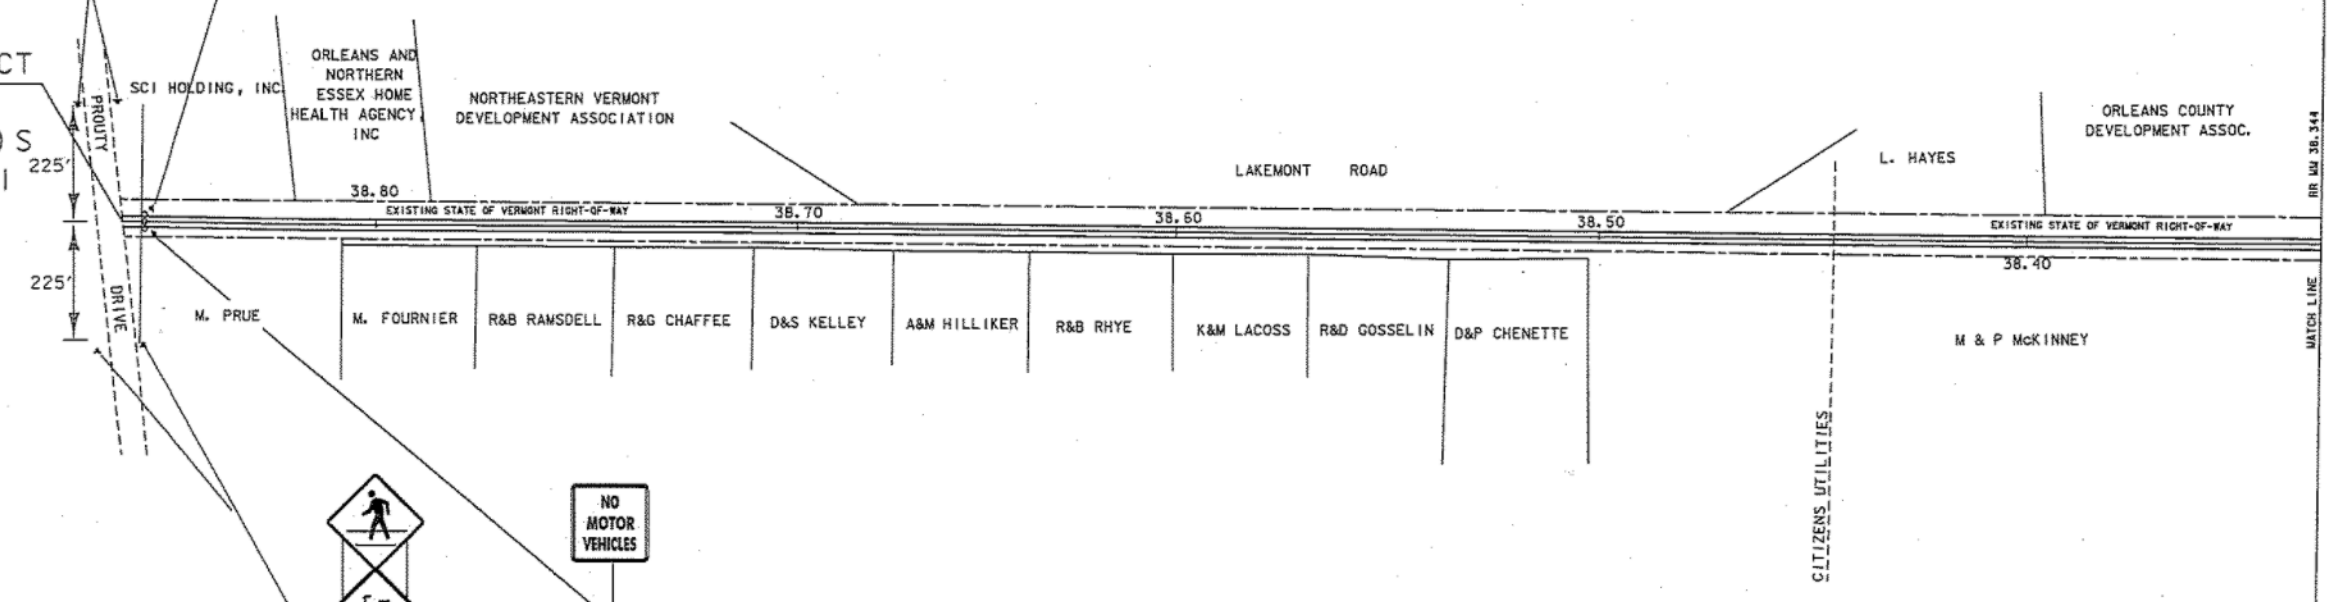

225'  
PRODUCE DRIVE



EACH SIGN PLACED ON 1 POST  
1 SIGN EACH SIDE OF ROAD



- NOTES:
1. ALL WORK IS WITHIN EXISTING STATE OF VERMONT RIGHT-OF-WAY AND SHALL BE DONE WITHIN THE EXISTING RAILROAD BED UNLESS OTHERWISE NOTED ON PLANS OR AS DIRECTED BY THE ENGINEER
  2. WIDTH OF EXISTING RIGHT-OF-WAY IS 33' EACH SIDE OF CENTERLINE
  3. PROPERTY LINES ARE APPROXIMATE AND PROPERTY OWNERS MAY NOT BE ACCURATE

PROJECT NAME/NUMBER: STATEWIDE STP NWRT(1)

SHEET 14 OF 20  
BEEBE SPUR RAIL TRAIL

FOR REFERENCE ONLY



PLAN NOT TO SCALE

DATUM	
VERTICAL	N/A
HORIZONTAL	N/A

PROJECT: BEEBE SPUR	PROJECT NO.: STP BIKE(19)S
DESIGN FILE NAME: ISRVOI/LTF/BEEBE/BEEBE.DGN	PLOT DATE: 29-NOV-2004 15
IPARM FILE NAME: LAYO1J	SURVEY DATE:
SURVEYED BY:	DRAWN BY: MAGNAN
SQUAD LEADER: LEWIS	SHEET: 6 OF 20