
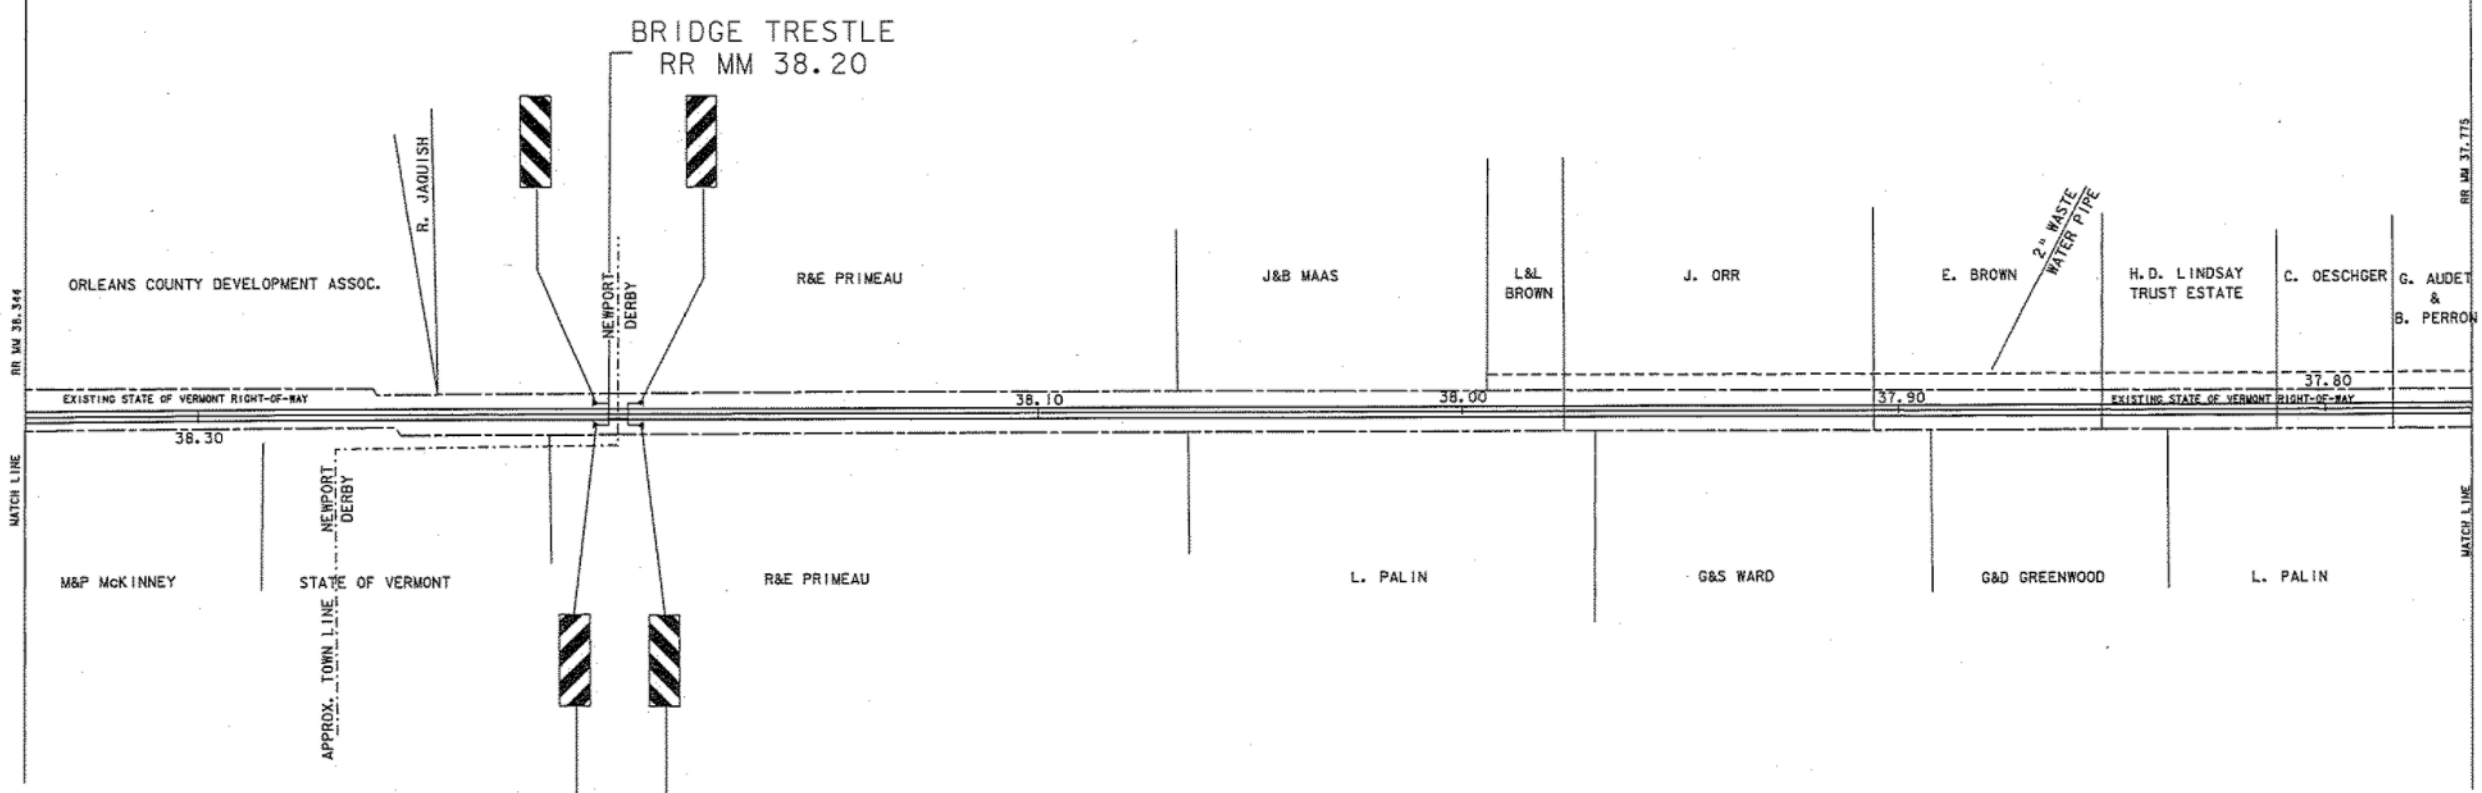


POWER GRADER RENTAL
RR MM 38.344 - RR MM 37.775
(GRADING OF EXISTING BALLAST)

~~GEOTEXTILE FOR ROADDED SUBGRADE SEPARATOR~~
~~RR MM 38.344 - RR MM 37.775~~
~~(PLACE UNDER AGGREGATE SURFACE COURSE 18' WIDTH)~~

AGGREGATE SURFACE COURSE
RR MM 38.344 - RR MM 37.775

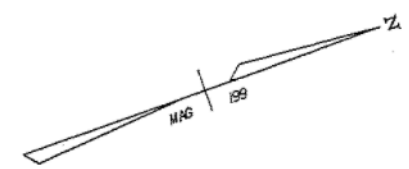

- NOTES:
1. ALL WORK IS WITHIN EXISTING STATE OF VERMONT RIGHT-OF-WAY AND SHALL BE DONE WITHIN THE EXISTING RAILROAD BED UNLESS OTHERWISE NOTED ON PLANS OR AS DIRECTED BY THE ENGINEER
 2. WIDTH OF EXISTING RIGHT-OF-WAY IS 33' EACH SIDE OF CENTERLINE
 3. PROPERTY LINES ARE APPROXIMATE AND PROPERTY OWNERS MAY NOT BE ACCURATE

PLAN NOT TO SCALE

PROJECT NAME/NUMBER: STATEWIDE STP NWRT(1)

SHEET 15 OF 20
BEEBE SPUR RAIL TRAIL

FOR REFERENCE ONLY



DATUM	
VERTICAL	N/A
HORIZONTAL	N/A

PROJECT: BEEBE SPUR	PROJECT NO.: STP BIKE(19)S
DESIGN FILE NAME: ISRV01/LTF/BEEBE/BEEBE.DGN	PLOT DATE: 29-NOV-2004 15
IPARM FILE NAME: LAY02.I	SURVEY DATE:
SURVEYED BY:	DRAWN BY: MAGNAN
SQUAD LEADER: LEWIS	SHEET: 7 OF 20