


LAKE

MEMPHAMAGOG

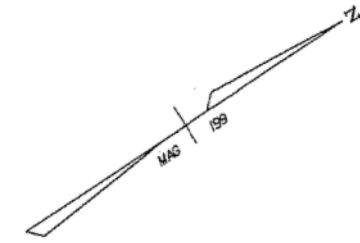


GUIDE POST (MOD.-BOLLARDS)
RR MM 35.710 @ (3 EA.)
RR MM 35.690 @ (3 EA.)
(SEE DETAIL SHEET 15)

POWER GRADER RENTAL
RR MM 36.071 - RR MM 35.502
(GRADING OF EXISTING BALLAST)

~~GEOTEXTILE FOR ROADDED SUBGRADE SEPARATOR~~
~~RR MM 35.071 - RR MM 35.502~~
~~PLACE UNDER AGGREGATE SURFACE COURSE 10' WIDTH~~

AGGREGATE SURFACE COURSE
RR MM 36.071 - RR MM 35.502

EACH SIGN PLACED ON 1 POST

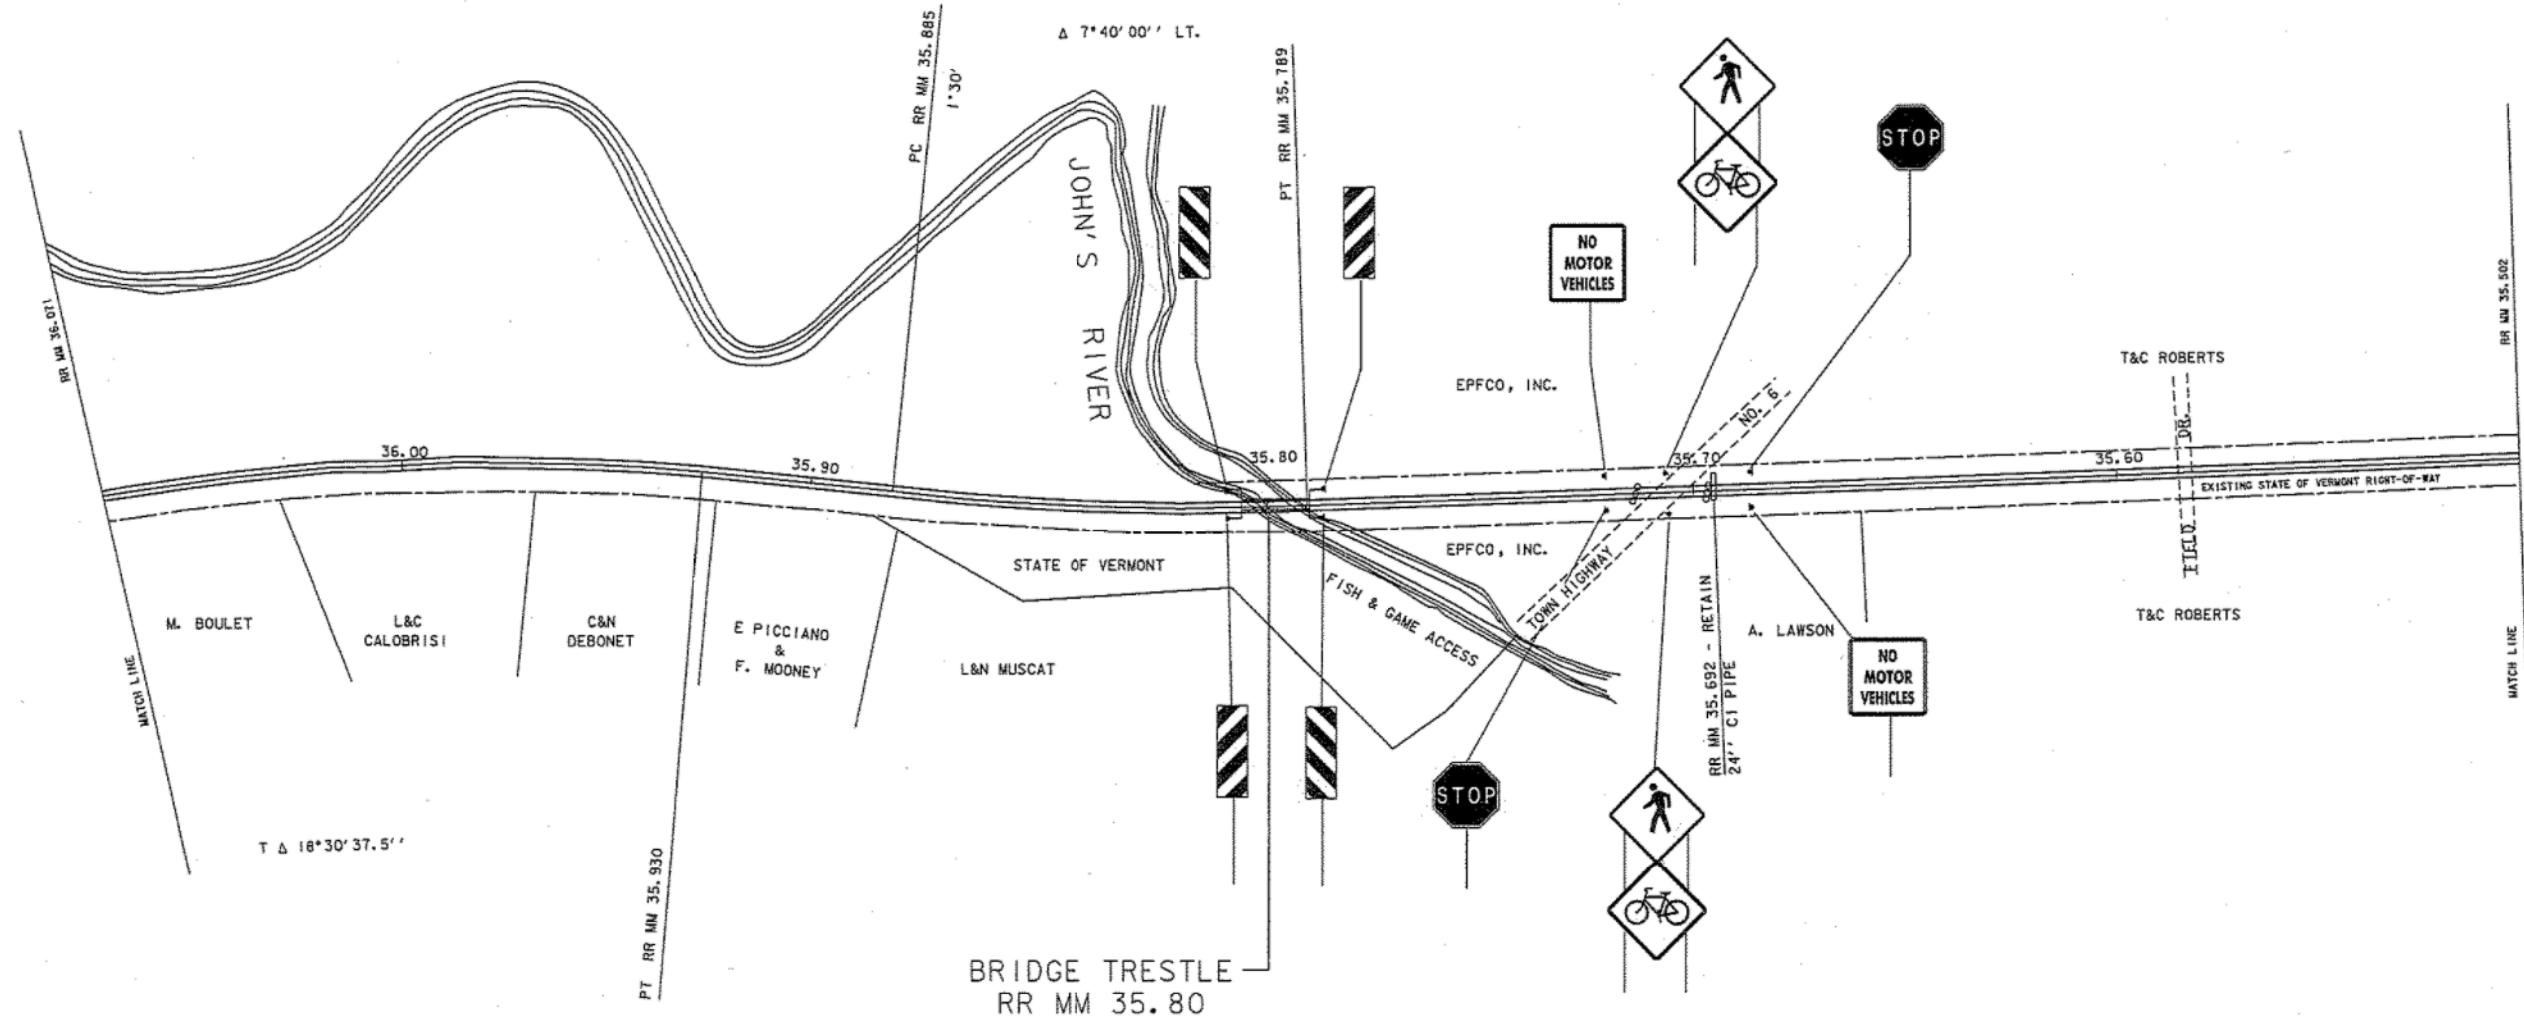

EACH SIGN PLACED ON 1 POST

1 SIGN EACH SIDE OF ROAD

NOTES:

1. ALL WORK IS WITHIN EXISTING STATE OF VERMONT RIGHT-OF-WAY AND SHALL BE DONE WITHIN THE EXISTING RAILROAD BED UNLESS OTHERWISE NOTED ON PLANS OR AS DIRECTED BY THE ENGINEER
2. WIDTH OF EXISTING RIGHT-OF-WAY IS 33' EACH SIDE OF CENTERLINE
3. PROPERTY LINES ARE APPROXIMATE AND PROPERTY OWNERS MAY NOT BE ACCURATE

PROJECT NAME/NUMBER: STATEWIDE STP NWRT(1)

SHEET 19 OF 20
BEEBE SPUR RAIL TRAIL

FOR REFERENCE ONLY

**ARCHIVED
IN DPR**

PLAN NOT TO SCALE

DATUM	
VERTICAL	N/A
HORIZONTAL	N/A

PROJECT: BEEBE SPUR	PROJECT NO.: STP BIKE(19)S
DESIGN FILE NAME: ISBYOZLIE/BEEBE/BEEBE.DGN	PLOT DATE: 29-NOV-2004 15
IPARM FILE NAME: LAYO6.I	SURVEY DATE:
SURVEYED BY:	DRAWN BY: MAGNAN
SQUAD LEADER: LEWIS	SHEET: 19 OF 20