


STA. 98+49.10 TO 104+00
NOT IN CONTRACT

THE CONTRACTOR IS TO NOTIFY "DIG-SAFE"
48 HOURS PRIOR TO ANY EXCAVATION
AT 1-800-225-4977

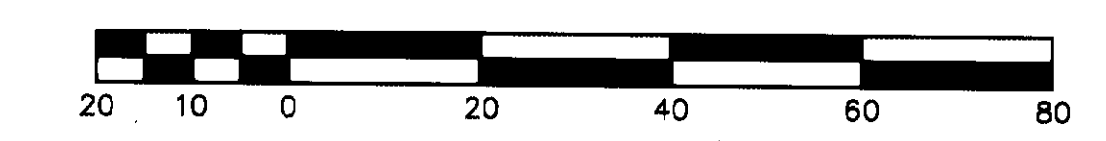

#	REVISIONS	DATE	#	REVISIONS	DATE

SURVEY: PEA
CALCULATED: NPN/LDY
PLOT: 6829-R3
DESIGN: DAW
DRAFT: NPN/JMM
CHECKED: LDY
APPROVED: LDY
DATE: 9/25/96
SCALE: 1"=20'

PLAN VIEW - STA 98+49.10~STA 104+00

WINOOSKI RIVER WEST
BIKE PATH
MONTPELIER, VERMONT

PROJ. NO. 6829
SHEET 10 OF 132

FAX (802)-658-3629
BUS. (802)- 658-5588

P.E.A.
PINKHAM ENGINEERING ASSOCIATES, INC.
The Maltex Building, 431 Pine St., Burlington, VT 05401