


**ARCHIVED
IN DPR**

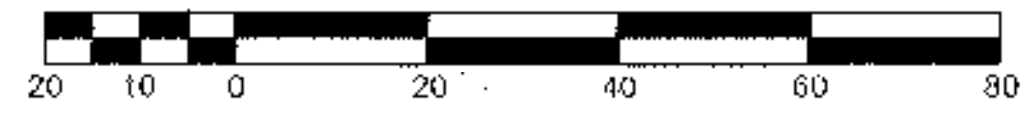

#	REVISIONS	DATE	#	REVISIONS	DATE
1	REALIGN STA 106+30.10 TO STA 109+00.00 BK ADDED UNDERDRAIN CARRIER PIPE	6/10/98			

SURVEY: HEA
CALCULATED: LDY
PLOT: 6829-R4
DESIGN: DAW
DRAFT: NPN/JMM
CHECKED: LDY
APPROVED: KWP
DATE: 4/9/97
SCALE: 1"=20'

PLAN VIEW - STA 104+00~STA 109+00

**WINOOSKI RIVER WEST
BIKE PATH
MONTPELIER, VERMONT**

FAX: (802)-658-3629 **P.E.A.** BUS: (802)-658-5589

PINKHAM ENGINEERING ASSOCIATES, INC.
50 Jay Drive, P.O. Box 2228, South Burlington, VT 05407

PROJ. NO. 6829
SHEET 11 OF 132