

CURVE #8
 $\Delta = 44^\circ 11' 03''$ LT
 $D = 60' 18' 41''$
 $R = 95.00'$
 $L = 38.96'$
 $T = 73.26'$
 $E = 7.53'$

CURVE #7
 $\Delta = 19^\circ 50' 15''$ LT
 $D = 21' 06' 19''$
 $R = 271.48'$
 $T = 47.47'$
 $L = 93.99'$
 $E = 4.12'$

CURVE #6B
 $\Delta = 75^\circ 17' 04''$
 $D = 0'$
 $R = 0'$



THE CONTRACTOR IS TO NOTIFY "DIG-SAFE"
 48 HOURS PRIOR TO ANY EXCAVATION
 AT 1-800-225-4977

#	REVISIONS	DATE	#	REVISIONS	DATE
1	REV'D ALIGNMENT, ADDED UNDERDRAIN	6/10/98			

SURVEY: PEA
 CALCULATED: LDY
 PLOT: 6829-R5
 DESIGN: DAW
 DRAFT: MFP/JMM
 CHECKED: LDY
 APPROVED: KWP
 DATE: 1/9/97
 SCALE: 1"=20'


PLAN VIEW - STA 109+00~STA 115+00

**WINOOSKI RIVER WEST
 BIKE PATH
 MONTPELIER, VERMONT**

FAX: (802)-656-3620 P.E.A. BUS: (802)-656-5888

PROJ. NO. 6829
 SHEET 12 OF 132

PINKHAM ENGINEERING ASSOCIATES, INC.
 50 Joy Drive, P.O. Box 2225, South Burlington, VT 05407

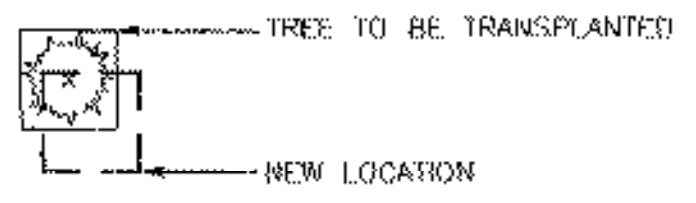

TRANSPLANTING TREES, ITEM 656.45
 112+66 LT 113+92 LT
 112+88 LT 114+28 LT
 113+23 LT
 113+58 LT

RR CROSSING SYMBOL, ITEM 646.32
 STA 112+96

DURABLE 12" WHITE LINE
 FOR STOP BARS, ITEM 646.44
 STA 109+73
 STA 111+75