


STA. 98+49.10 TO 104+00 NOT IN CONTRACT

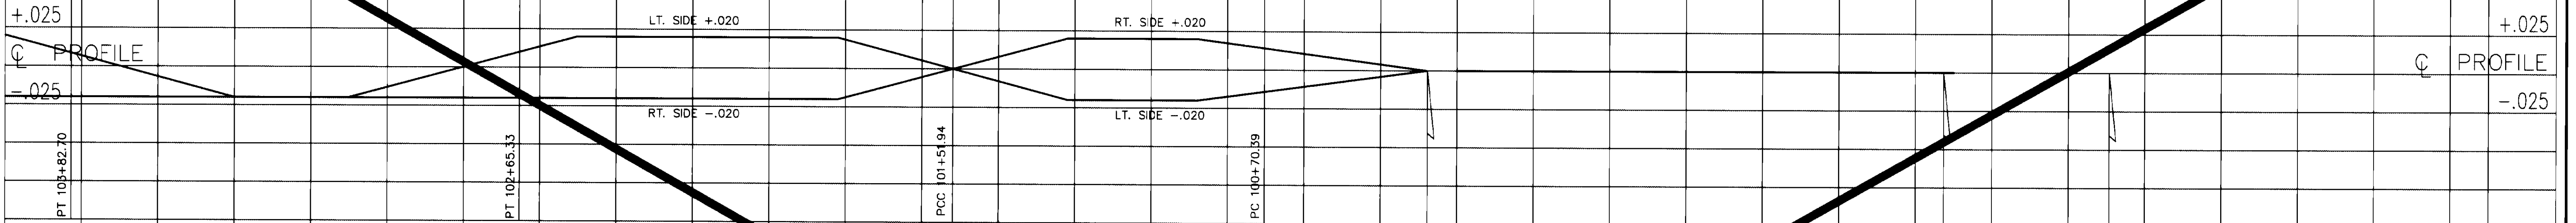


BANKING DIAGRAM

1"=20' HORIZ.
1"=0.050 FT/FT VERT.

104+00 103+00 102+00 101+00 100+00 99+00 98+00 97+50

STA 101+46.94 TO STA 106+54 NOT IN CONTRACT
END NEW CONSTRUCTION STA 101+46.94
END BRIDGE 100+27.80 RESUME PATH
BEGIN BRIDGE 98+92.70
BEGIN PATH 98+49.10

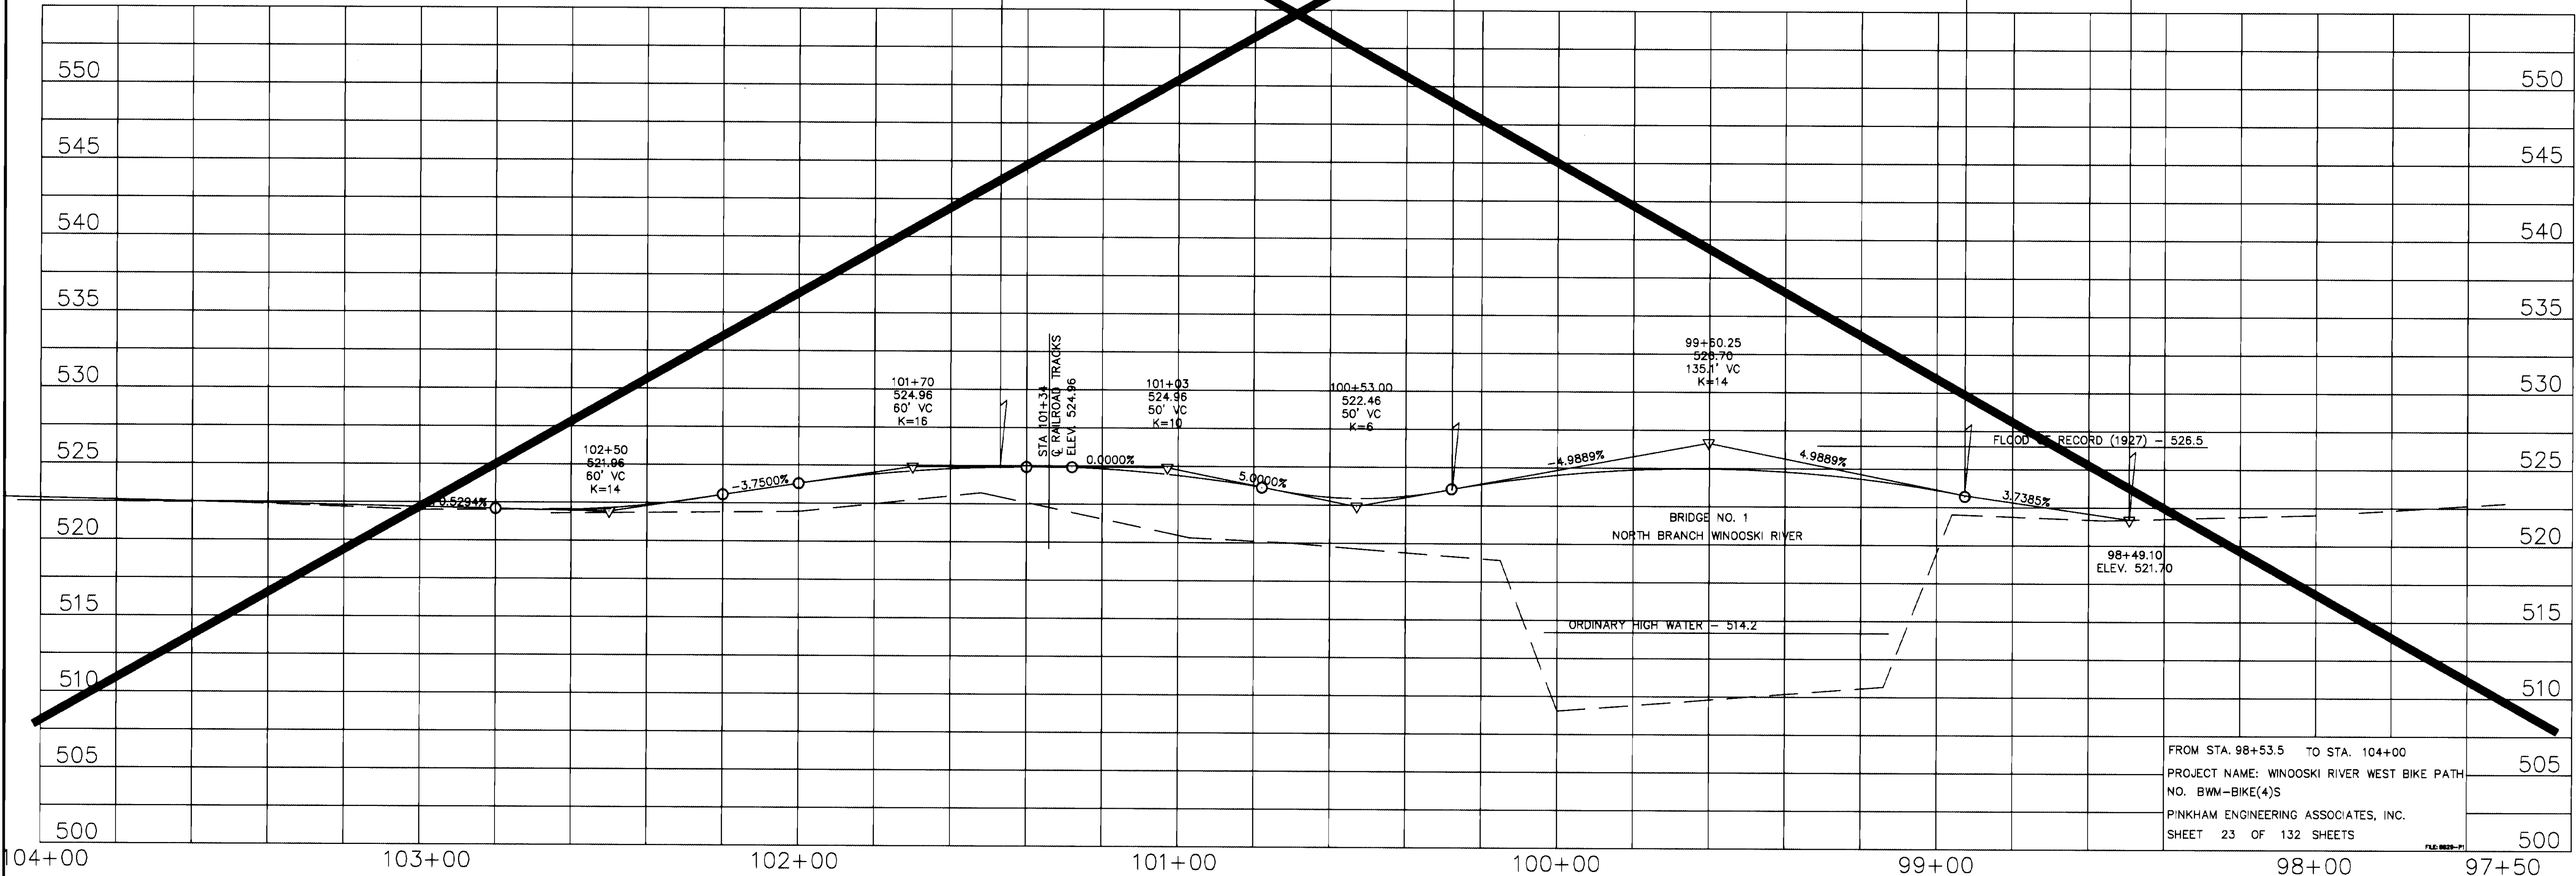

FROM STA. 98+53.5 TO STA. 104+00
PROJECT NAME: WINDOSKI RIVER WEST BIKE PATH
NO. BMW-BIKE(4)S
PINKHAM ENGINEERING ASSOCIATES, INC.
SHEET 23 OF 132 SHEETS