



UNION SURVEY
 SURVEY
 NOTE: ENGINEER'S TEMPERATURE
 NOT FROM TEMPLATE
 AREAS CHECKED

UNION SURVEY
 SURVEY
 NOTE: ENGINEER'S TEMPERATURE
 NOT FROM TEMPLATE
 AREAS CHECKED

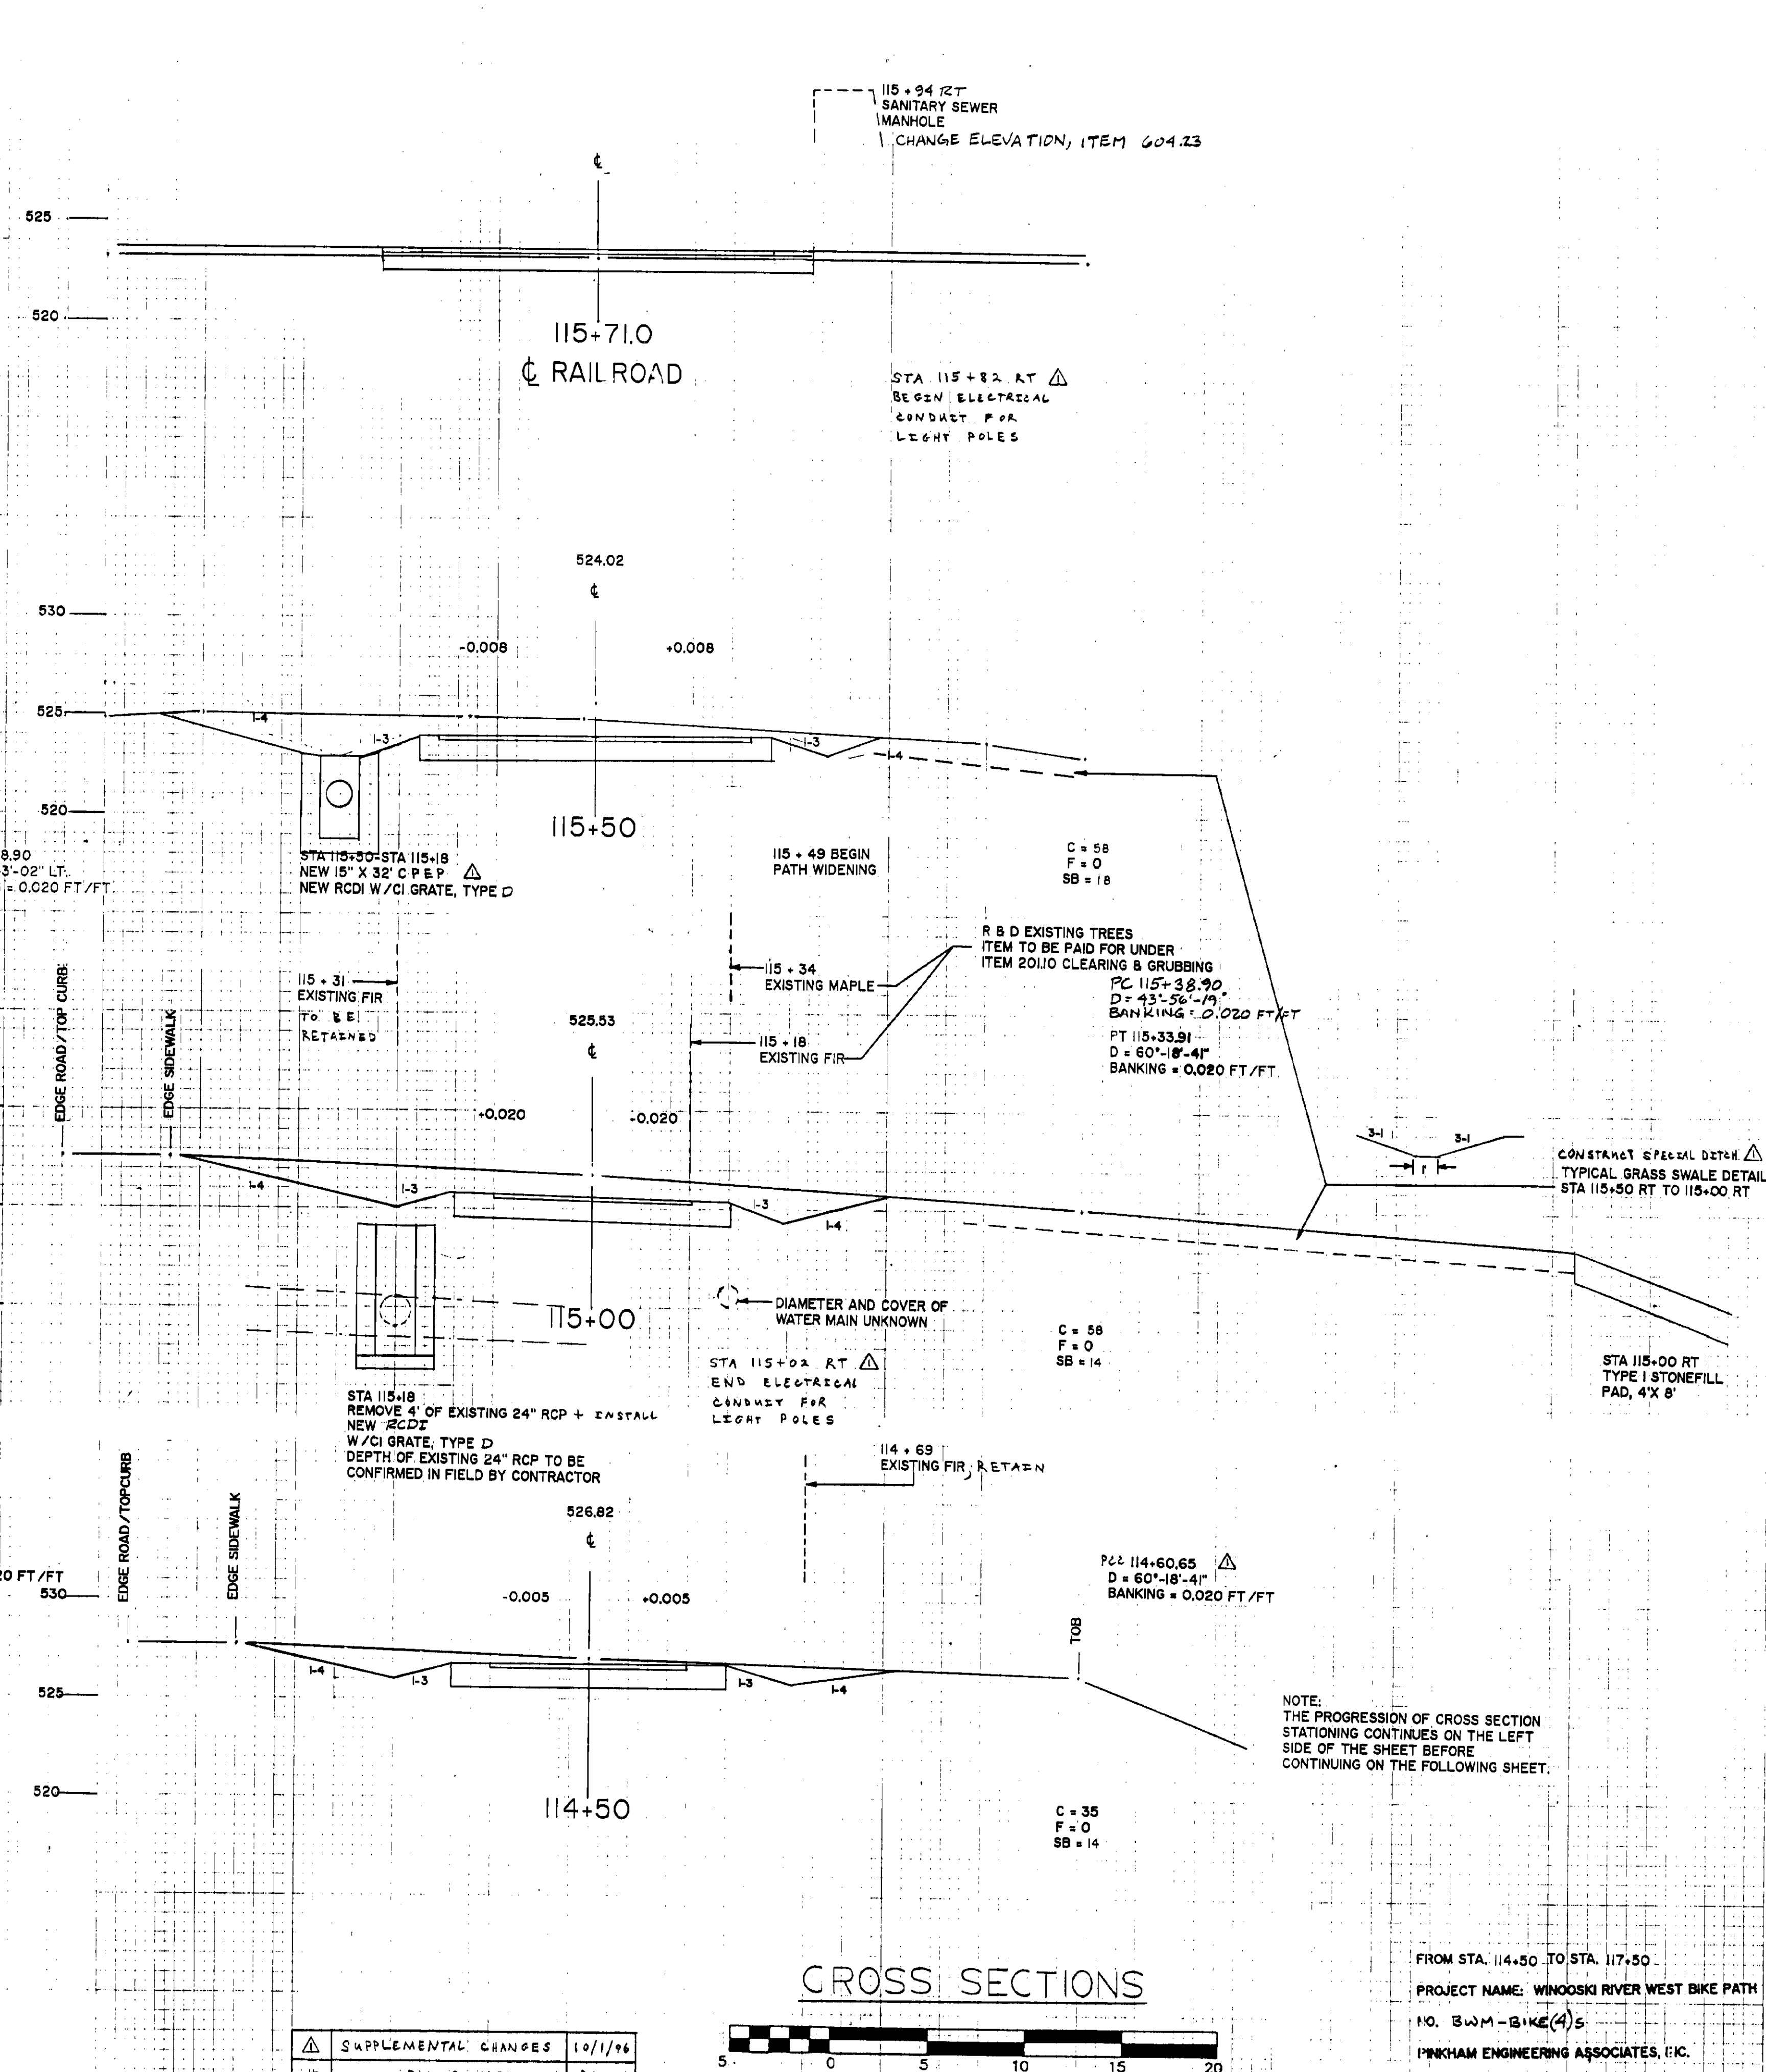

#	REVISIONS	DATE
1	SUPPLEMENTAL CHANGES	10/1/96

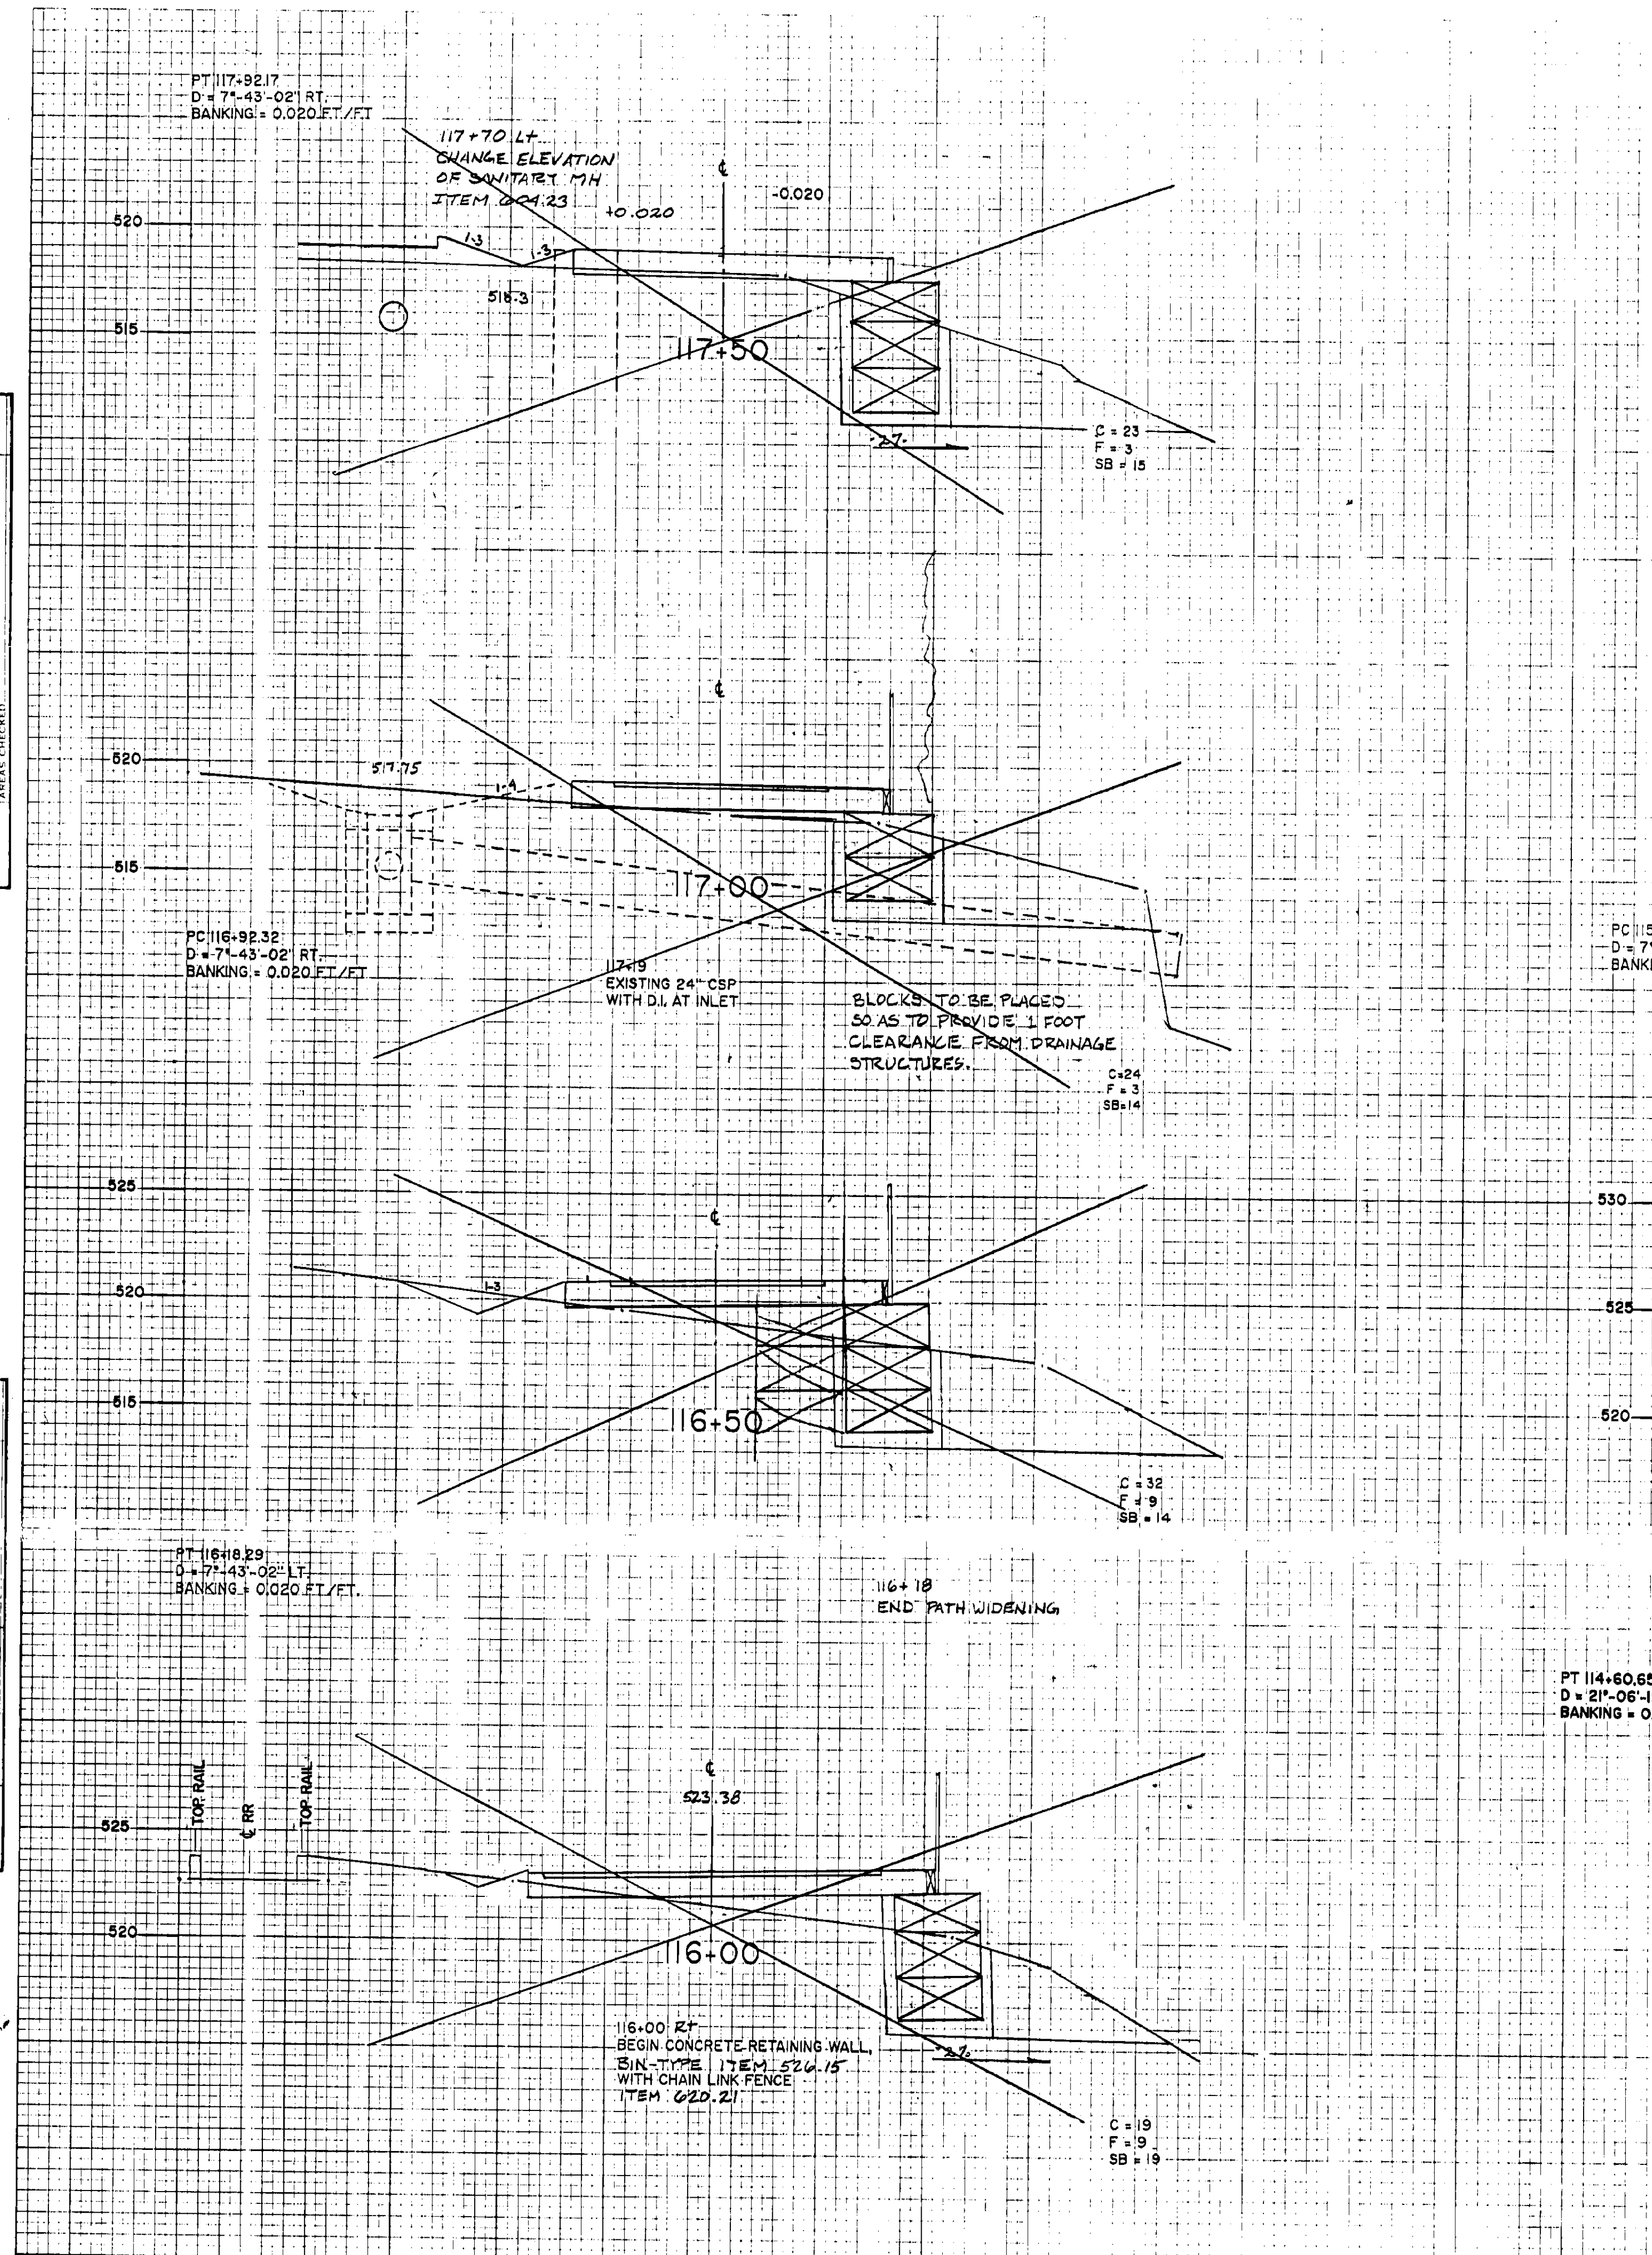

CROSS SECTIONS

FROM STA. 114.50 TO STA. 117.50
 PROJECT NAME: WINOOSKI RIVER WEST BIKE PATH
 NO. BWM-BIKE(4)5
 INKHAM ENGINEERING ASSOCIATES, INC.
 SHEET 79 OF 132 SHEETS