


CROSS SECTIONS

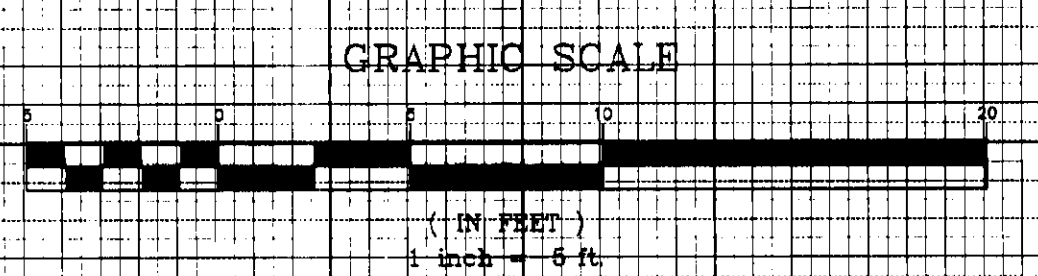

FROM STA 115+75 TO STA 118+25
 PROJECT NAME: WINOOSKI RIVER WEST BIKE PATH
 NG. BWM - BIKE(4)S
 PINKHAM ENGINEERING ASSOC., INC.
 SHEET 80 OF 132 DWG. NO: 6829XCUI.DWG