


CROSS SECTIONS

GRAPHIC SCALE

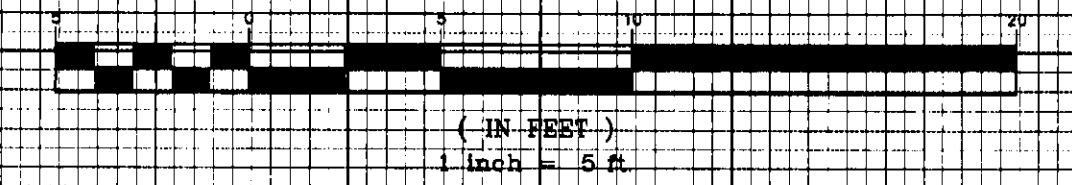

FROM STA. 118+50 TO STA. 121+00
 PROJECT NAME: WNOOSKI RIVER WEST BIKE PATH
 NG.
 PINKHAM ENGINEERING ASSOC., INC
 SHEET 8 OF 132 DWG. NO. 8829X02.DWG