

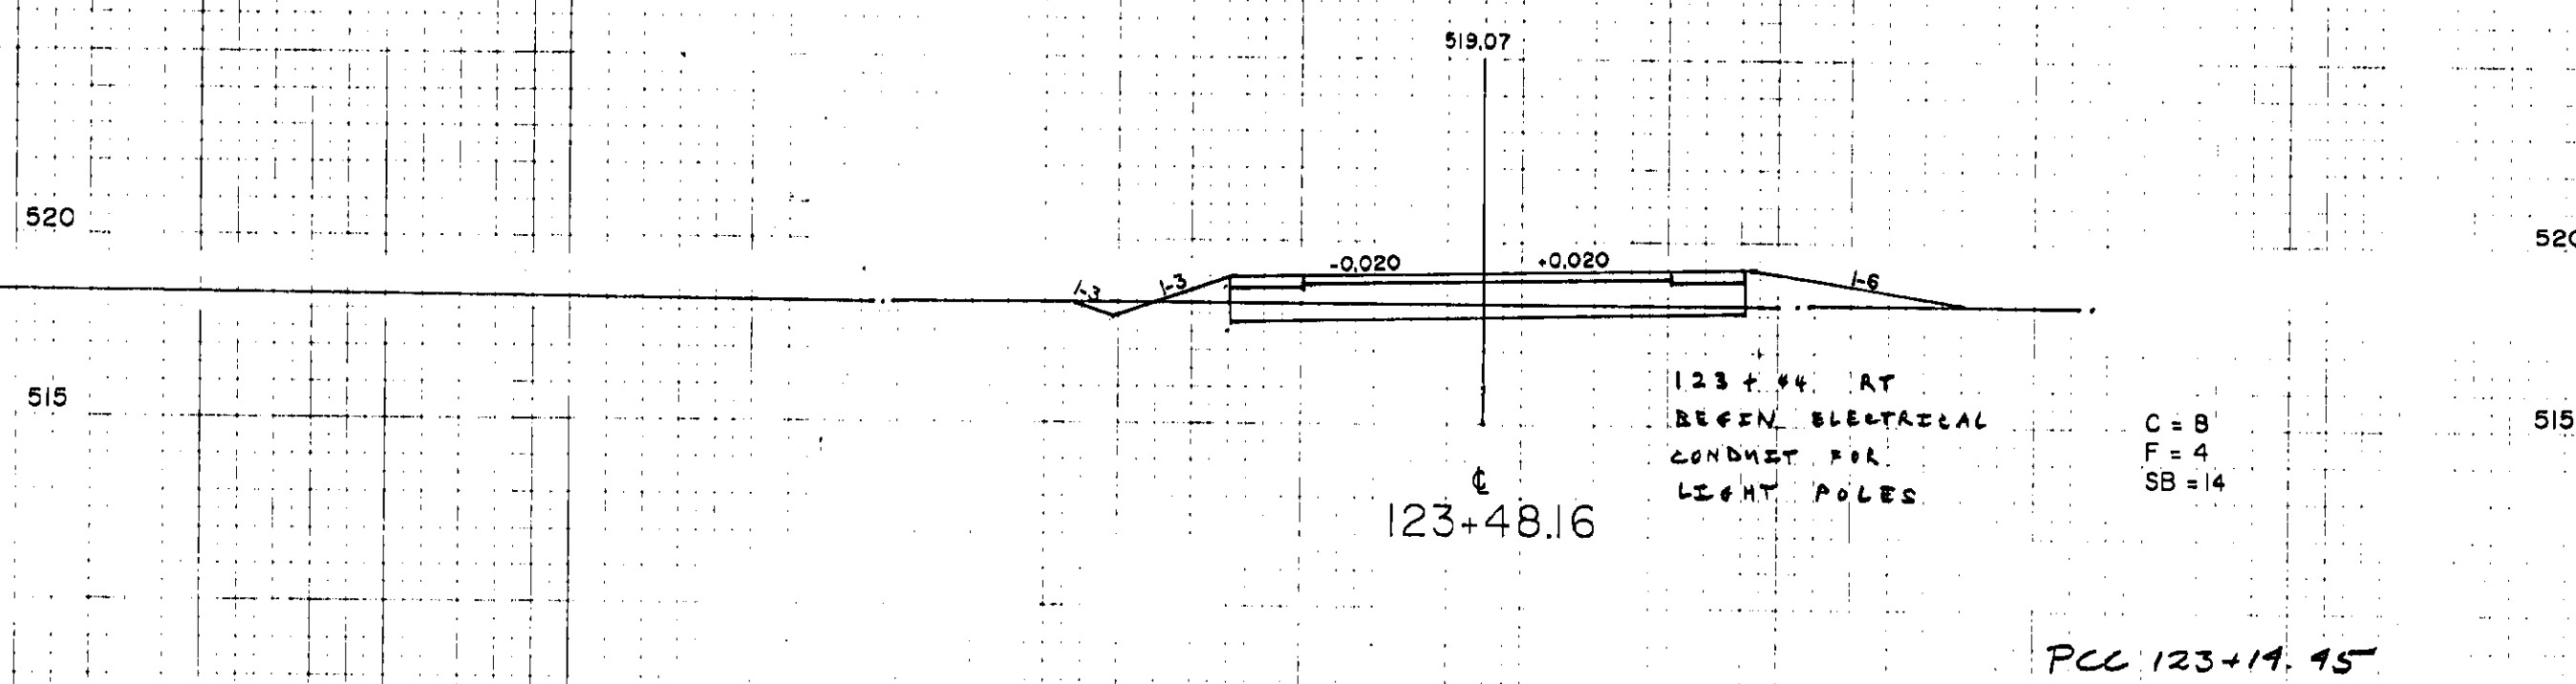
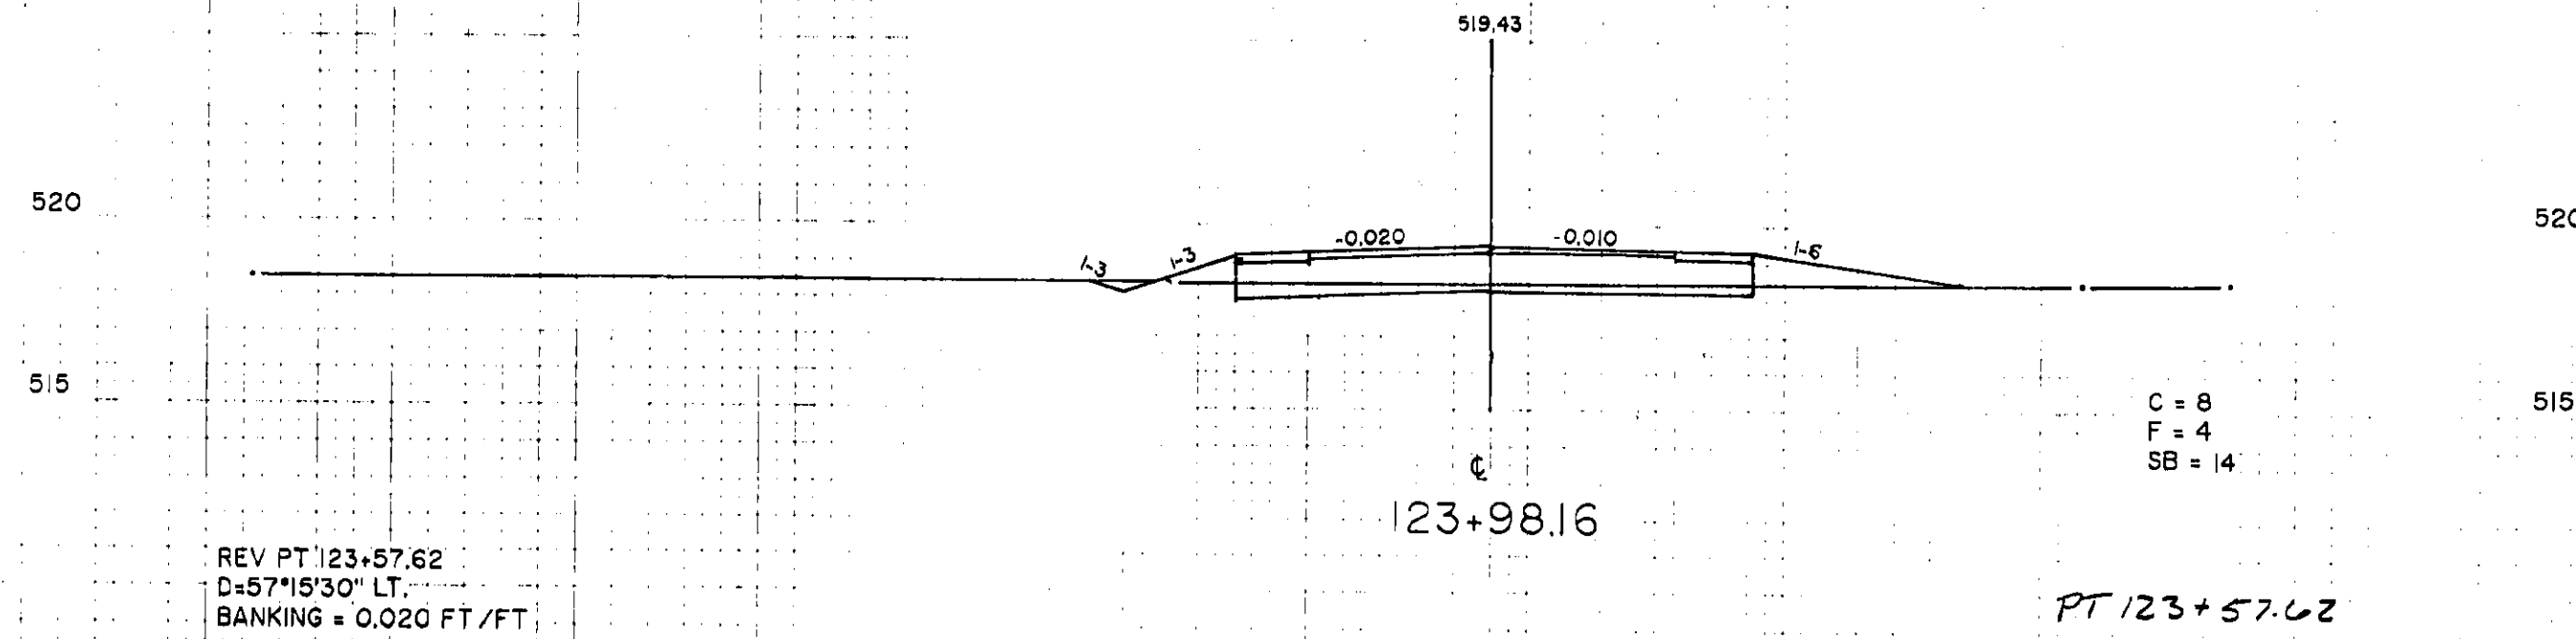


ORIGINAL
 DATE: 11/15/11
 NOTE BOOK TEMPLATE
 NO. 11/15/11
 DATE CHECKED:

ORIGINAL
 DATE: 11/15/11
 NOTE BOOK TEMPLATE
 NO. 11/15/11
 DATE CHECKED:

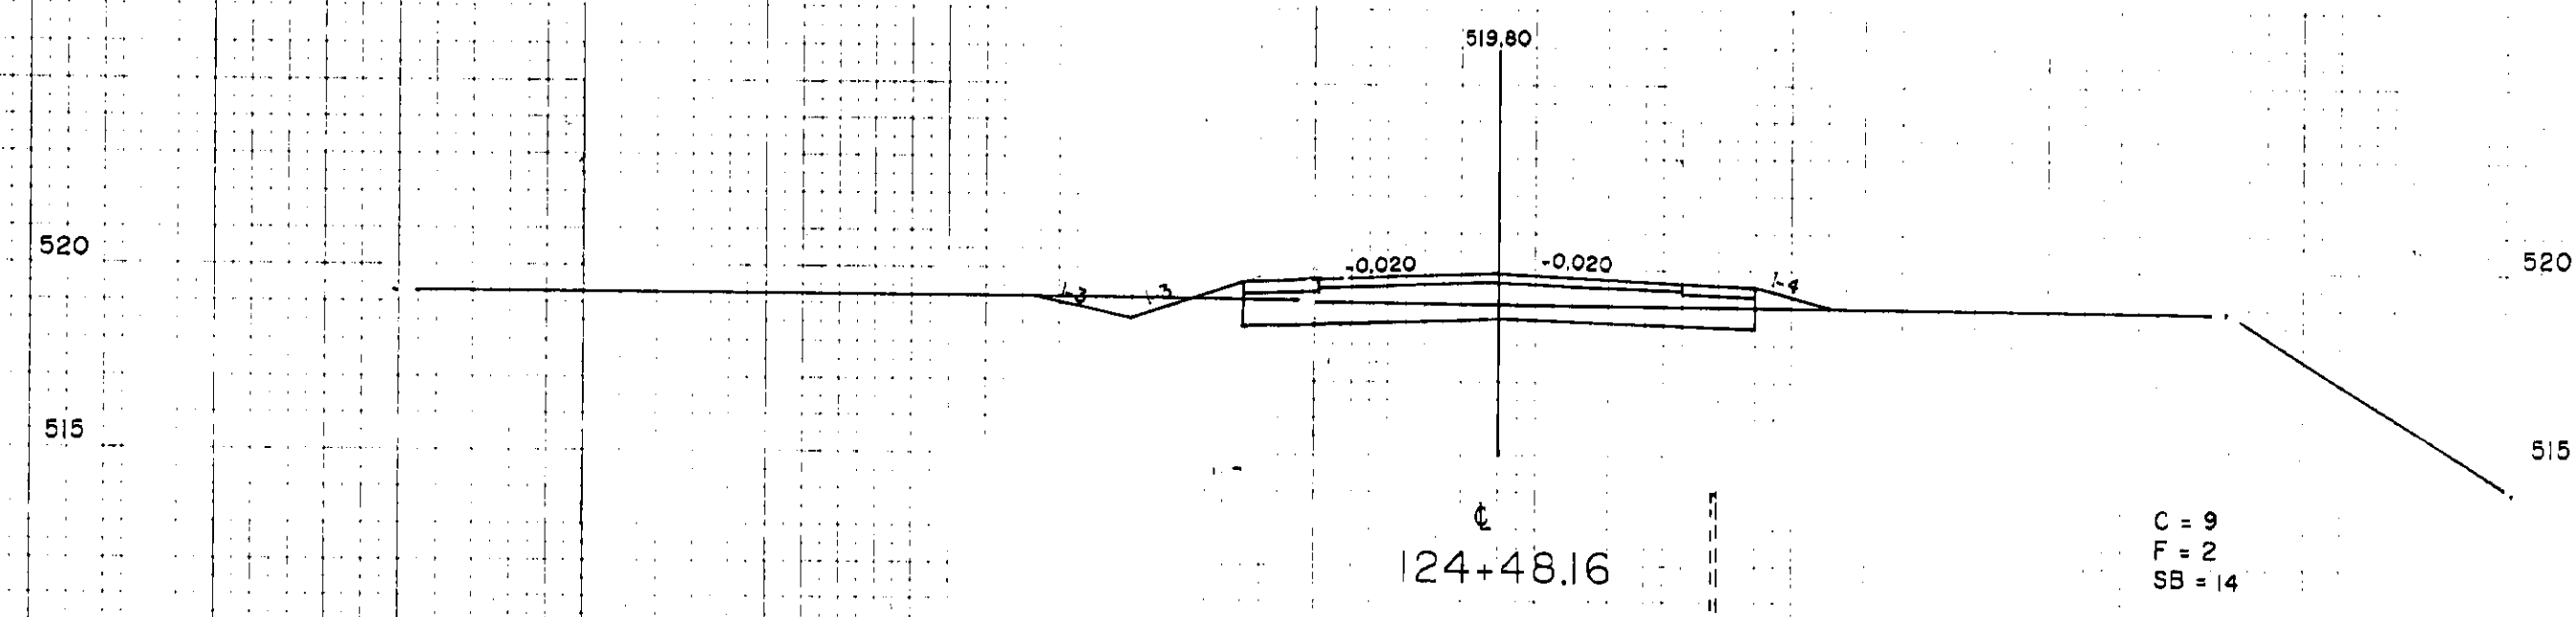

CROSS SECTIONS

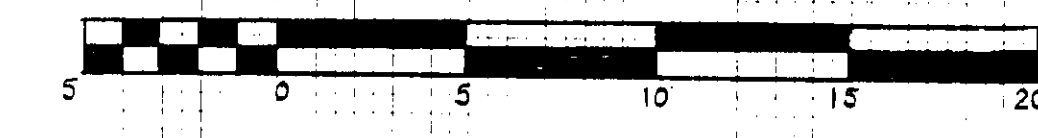

FROM STA. 123+48.16 TO STA. 124+48.16
 PROJECT NAME: WINOOSKI RIVER WEST BIKE PATH
 NO. 30-M-BIKE(A)S
 PINKHAM ENGINEERING ASSOCIATES, INC.
 SHEET 83 OF 154 SHEETS