
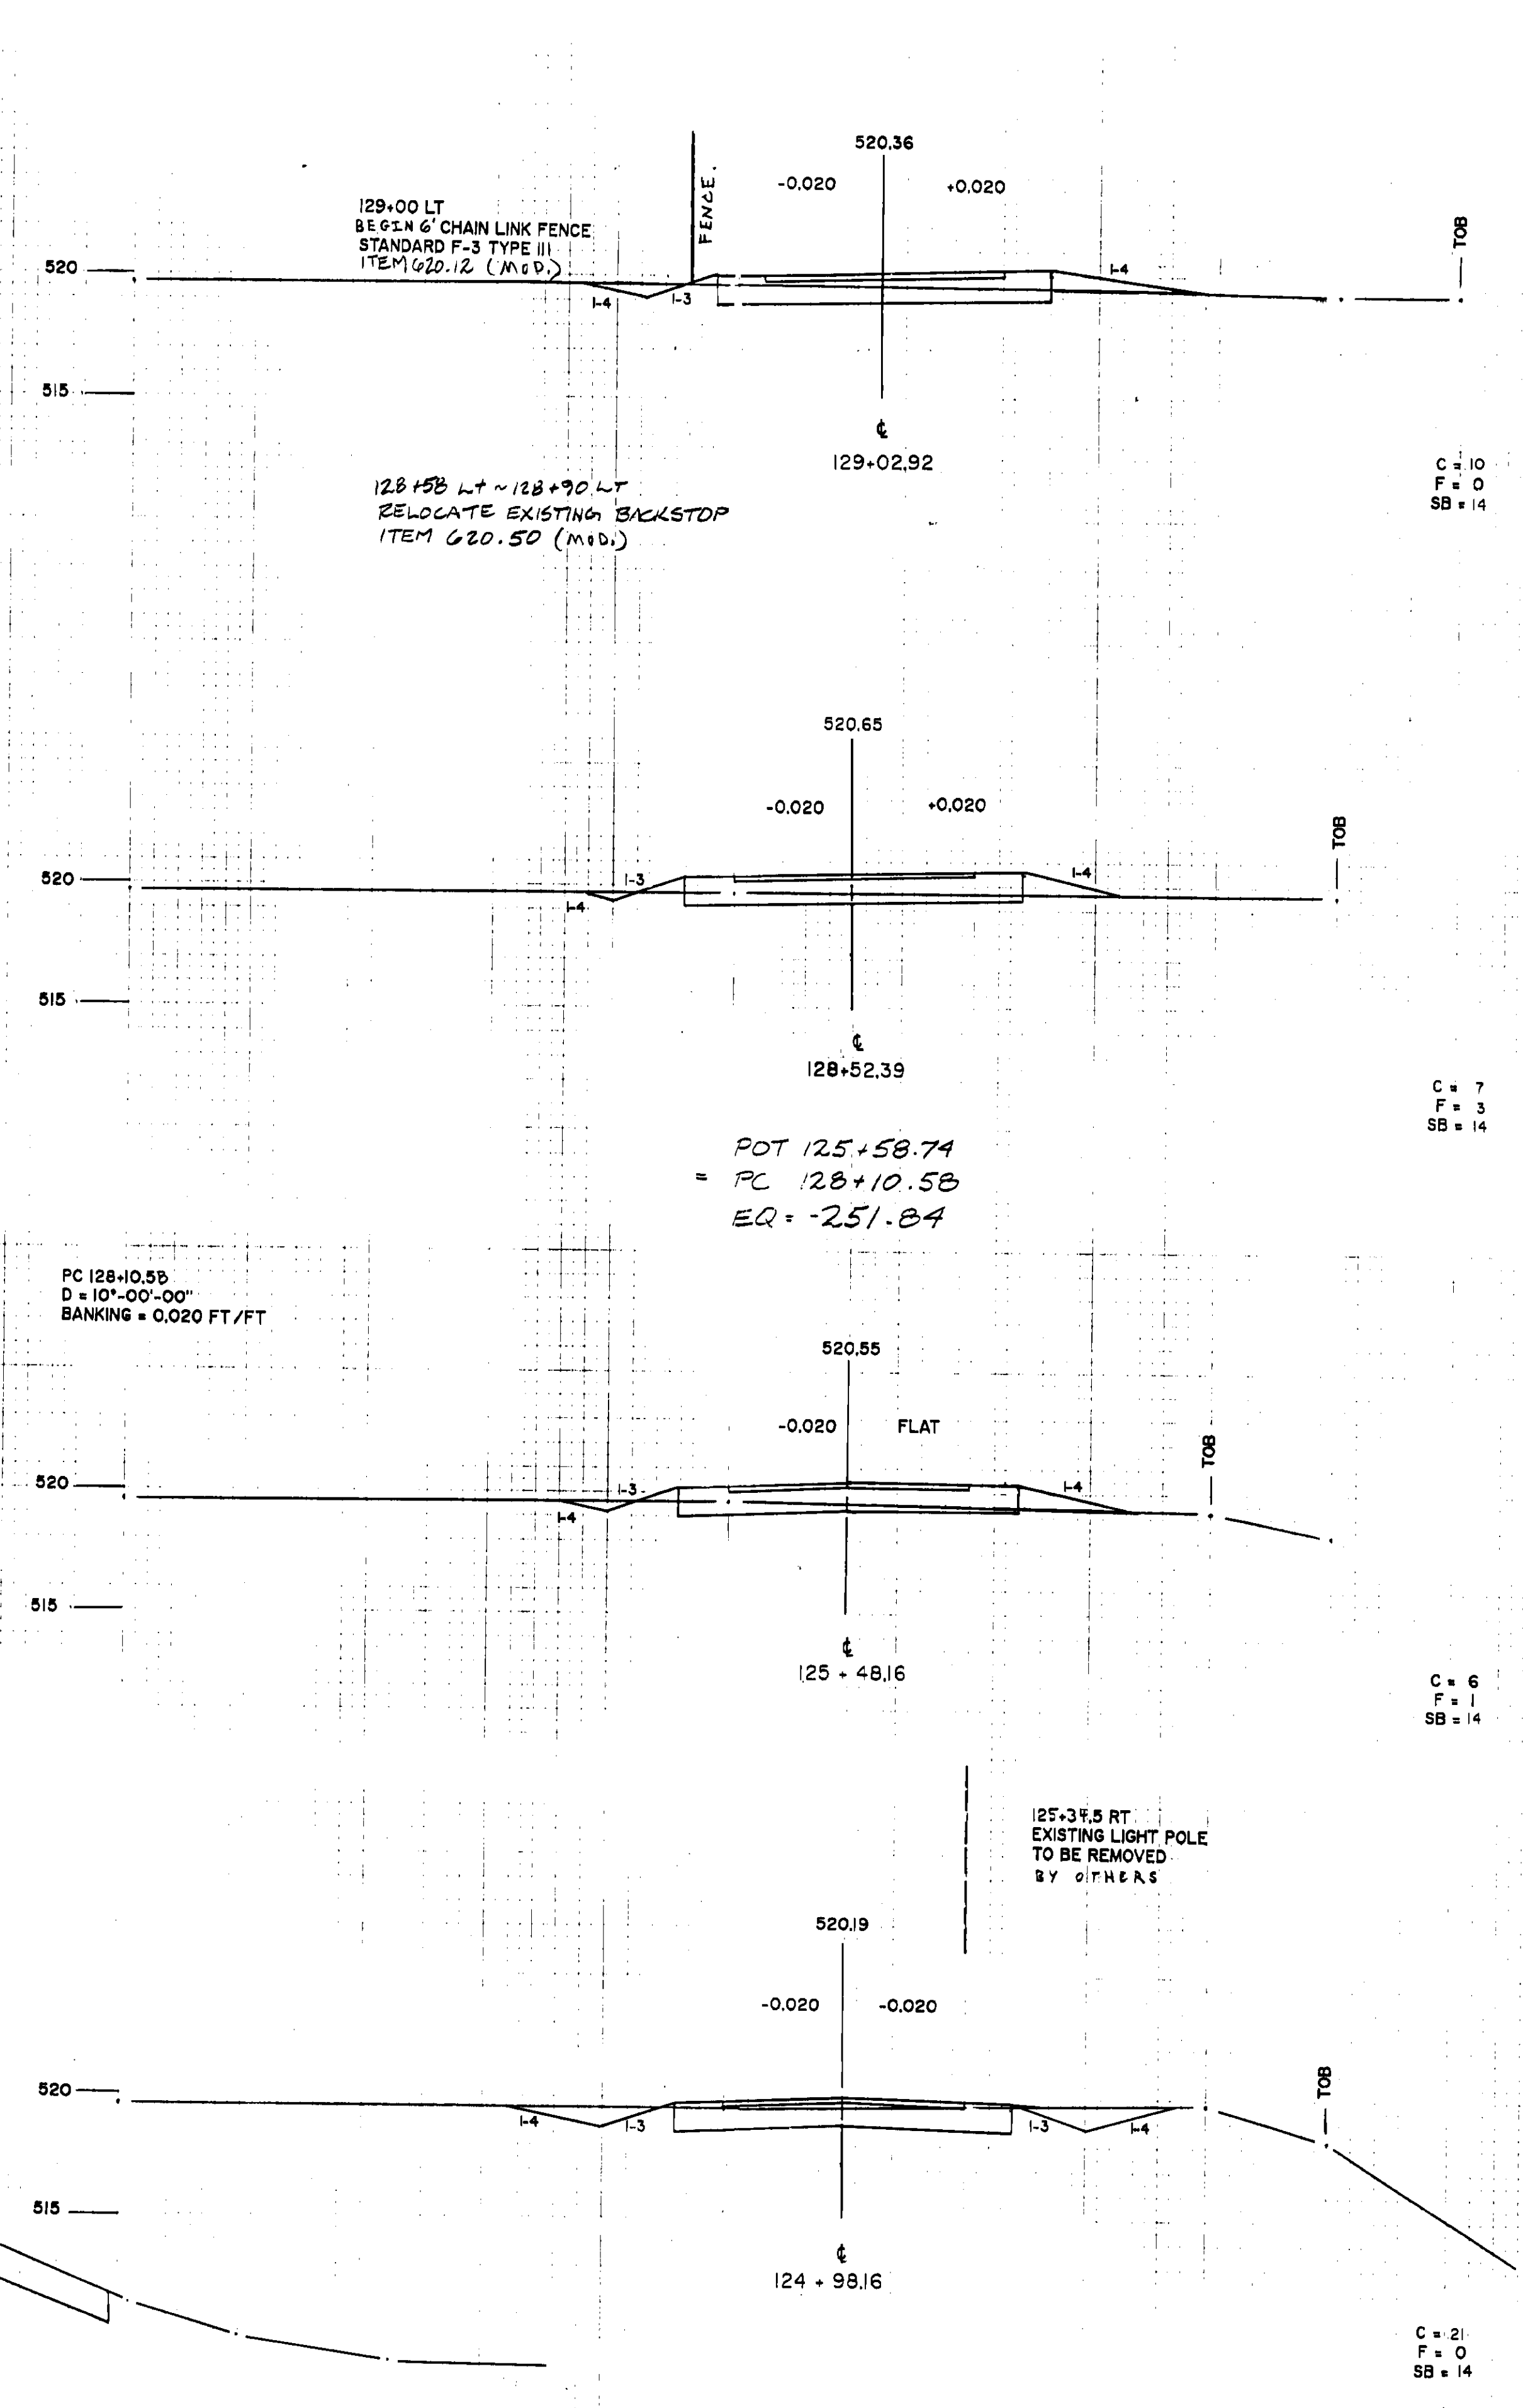



SURVEYED
 SURVEY
 NO. _____
 NOTE BOOK NO. _____
 AREA CHECKED

SURVEYED
 SURVEY
 NO. _____
 NOTE BOOK NO. _____
 AREA CHECKED

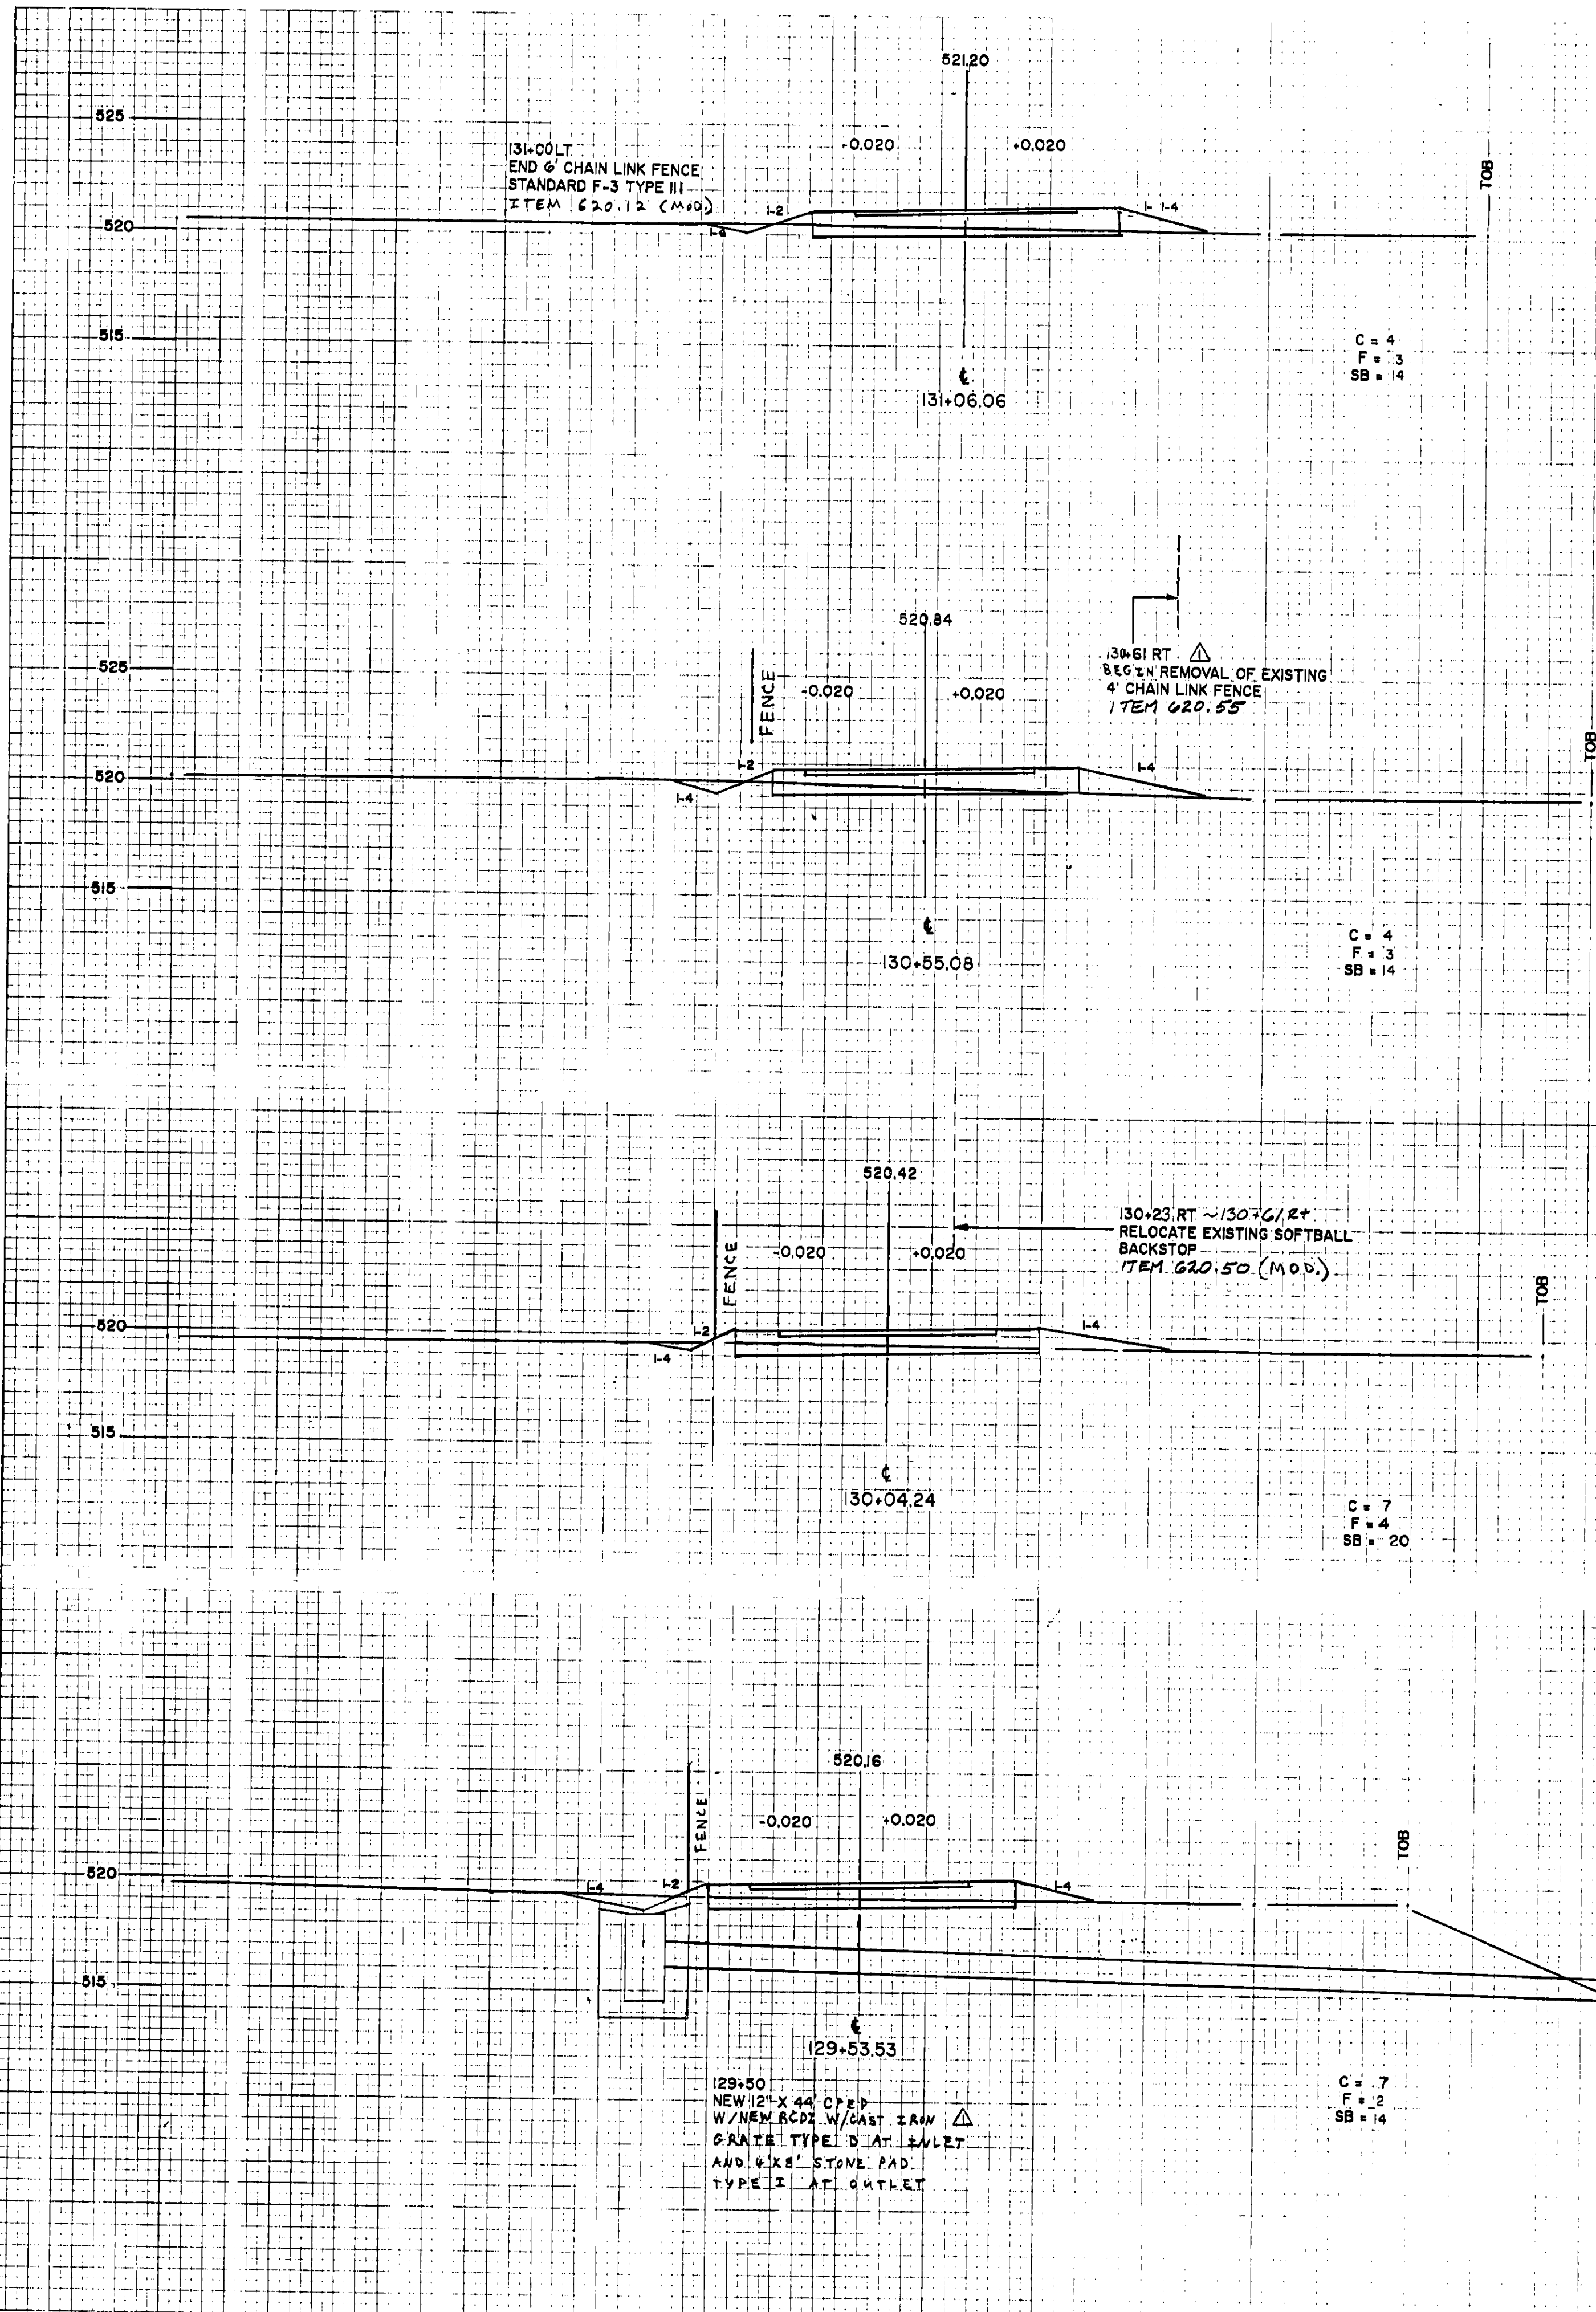

NOTE:
 THE PROGRESSION OF CROSS SECTION
 STATIONING CONTINUES ON THE LEFT
 SIDE OF THE SHEET BEFORE
 CONTINUING ON THE FOLLOWING SHEET.

CROSS SECTIONS

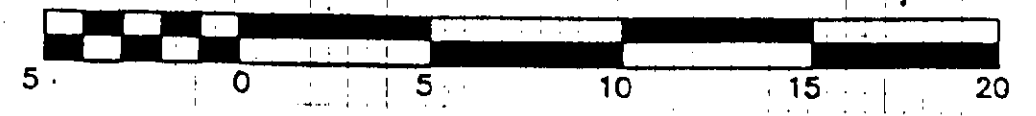

#	SUPPLEMENTAL CHANGES	DATE
1	10/1/16	

FROM STA. 124+98.16 TO STA. 131+06.06
 PROJECT NAME: WINDOSKI RIVER WEST BIKE PATH
 NO. BWM-BIKE (4)S
 PINKHAM ENGINEERING ASSOCIATES, INC.
 SHEET 84 OF 132 SHEETS