
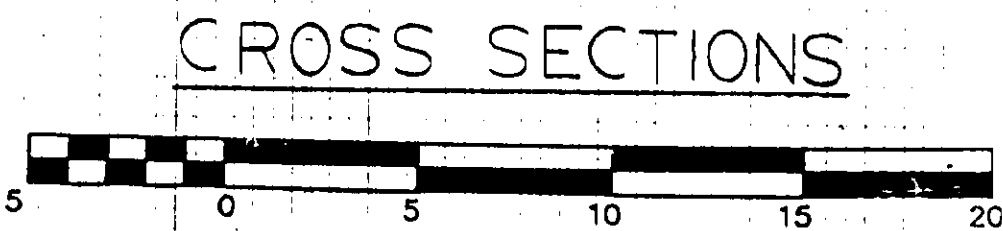
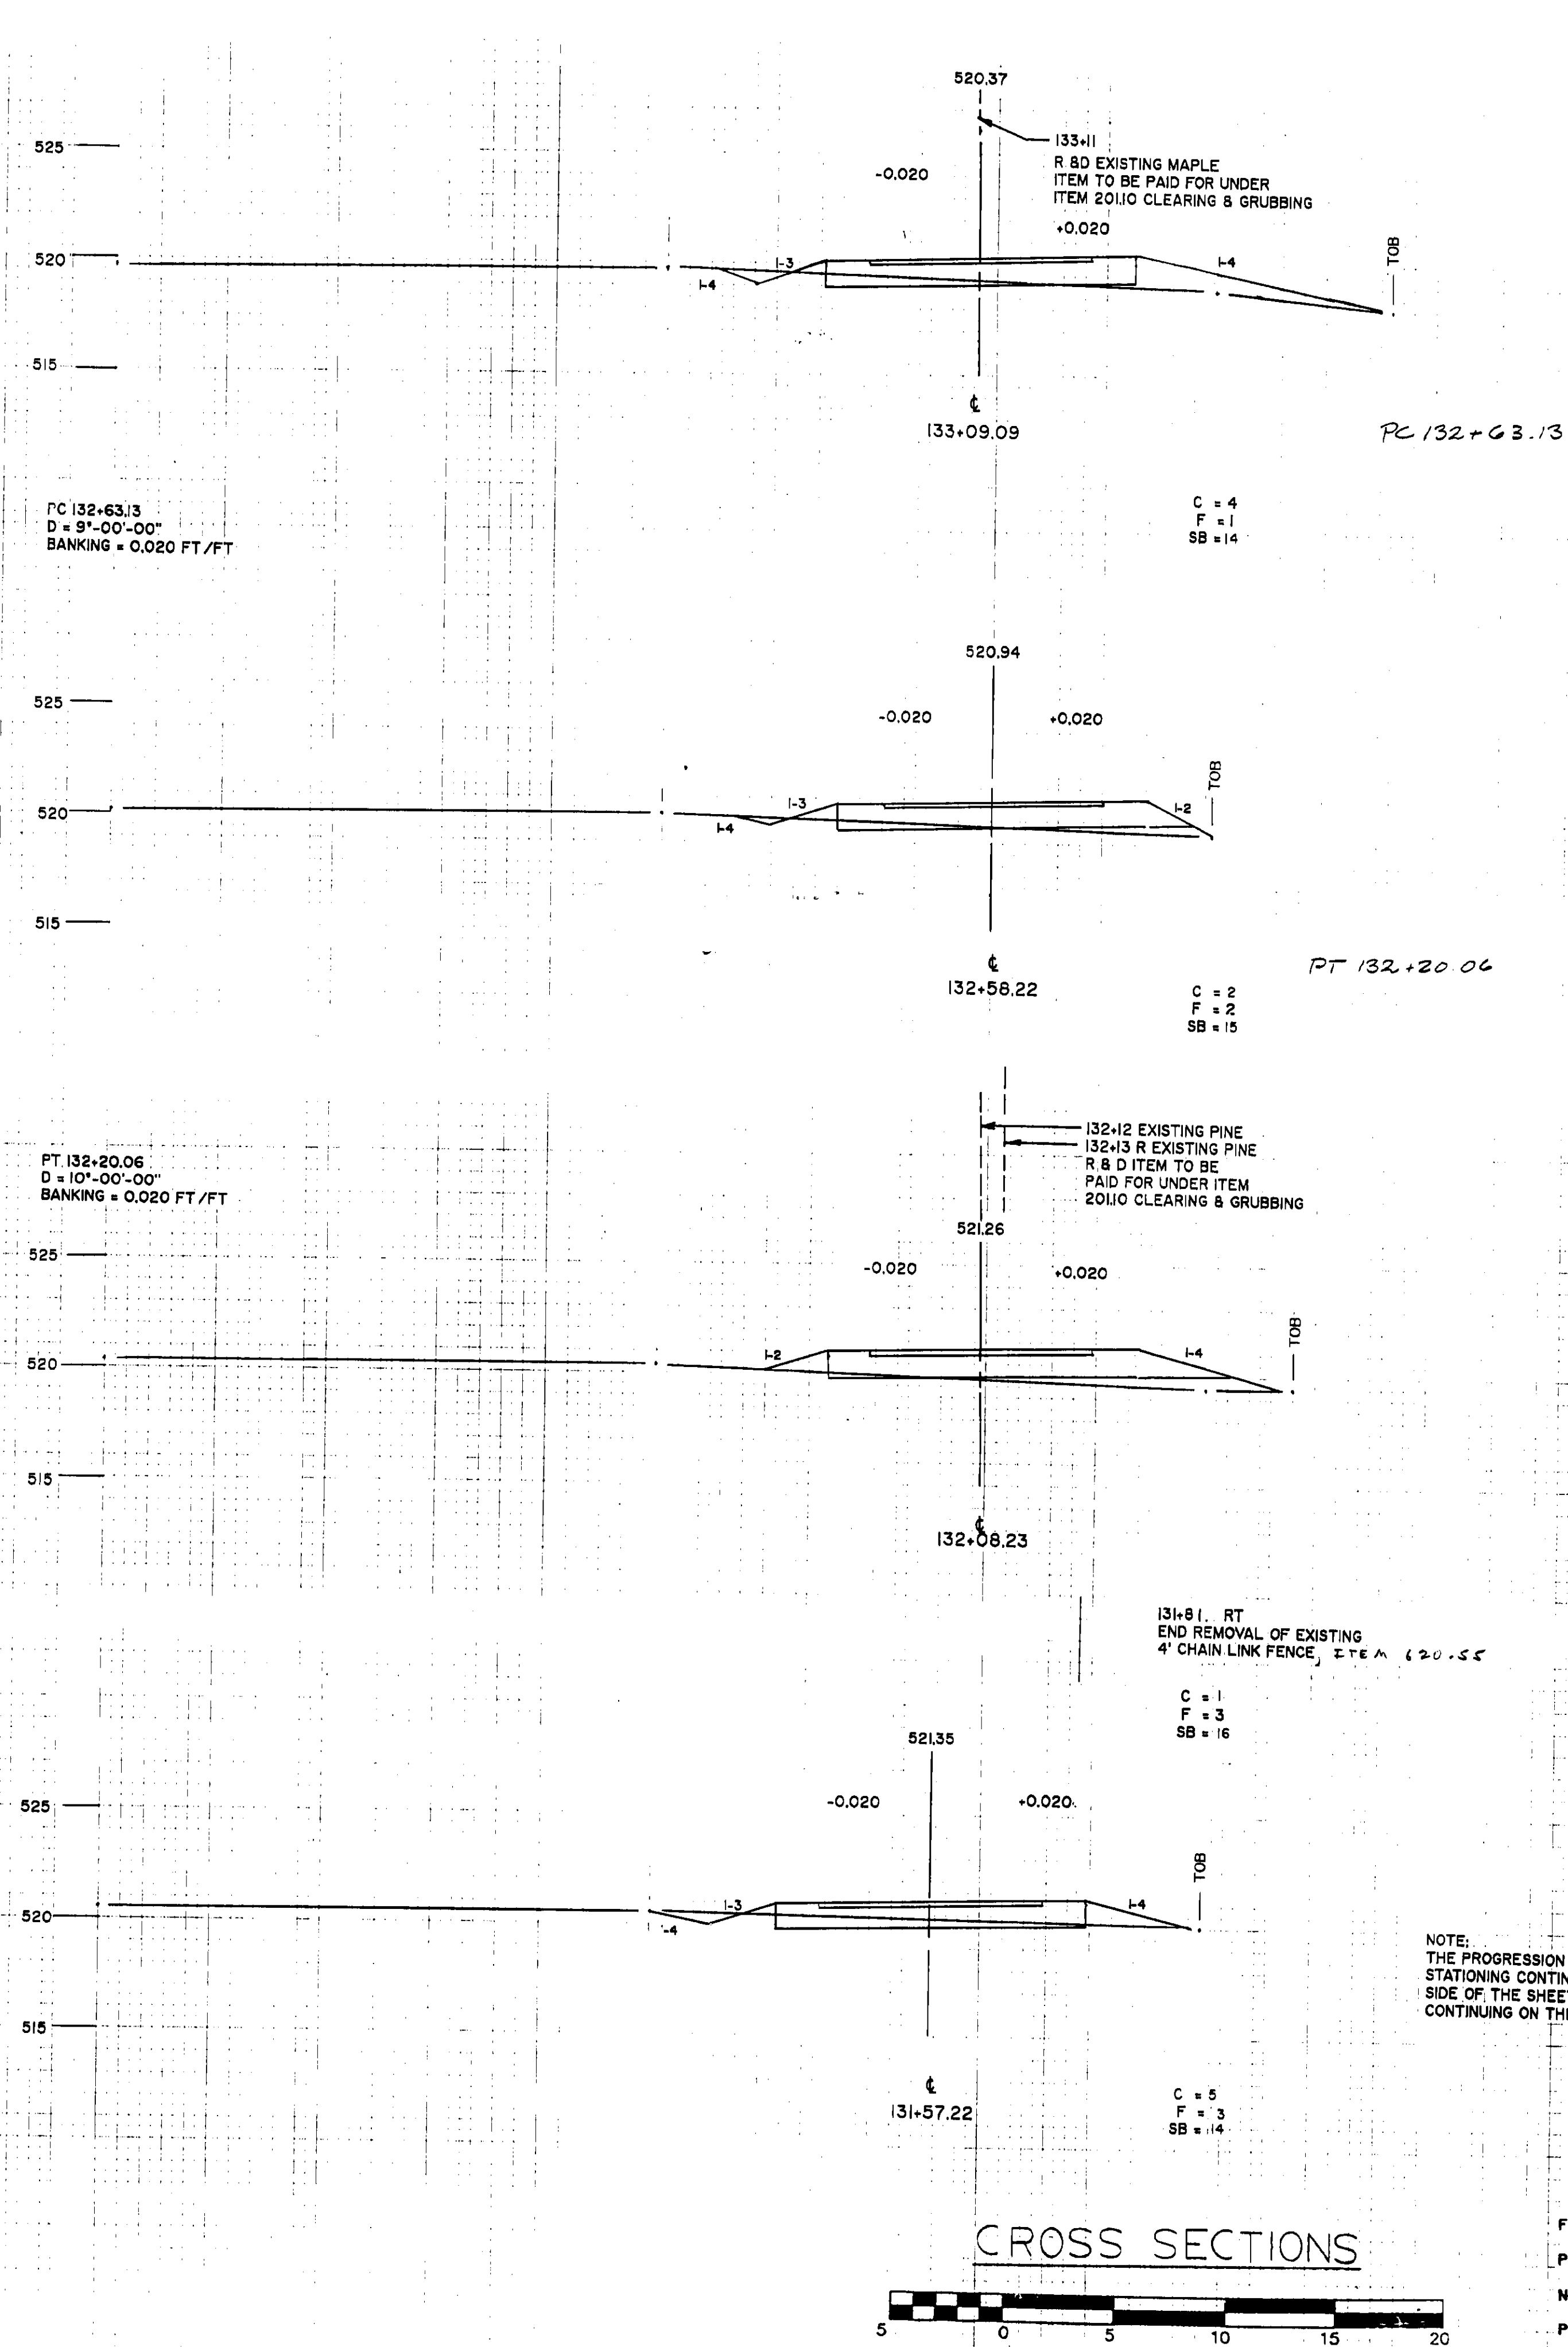


ORIGINAL SURVEY
 SURVEY
 NOTE BOOK TEMPLATE
 NO. _____
 AREAS CHECKED

ORIGINAL SURVEY
 SURVEY
 NOTE BOOK TEMPLATE
 NO. _____
 AREAS CHECKED

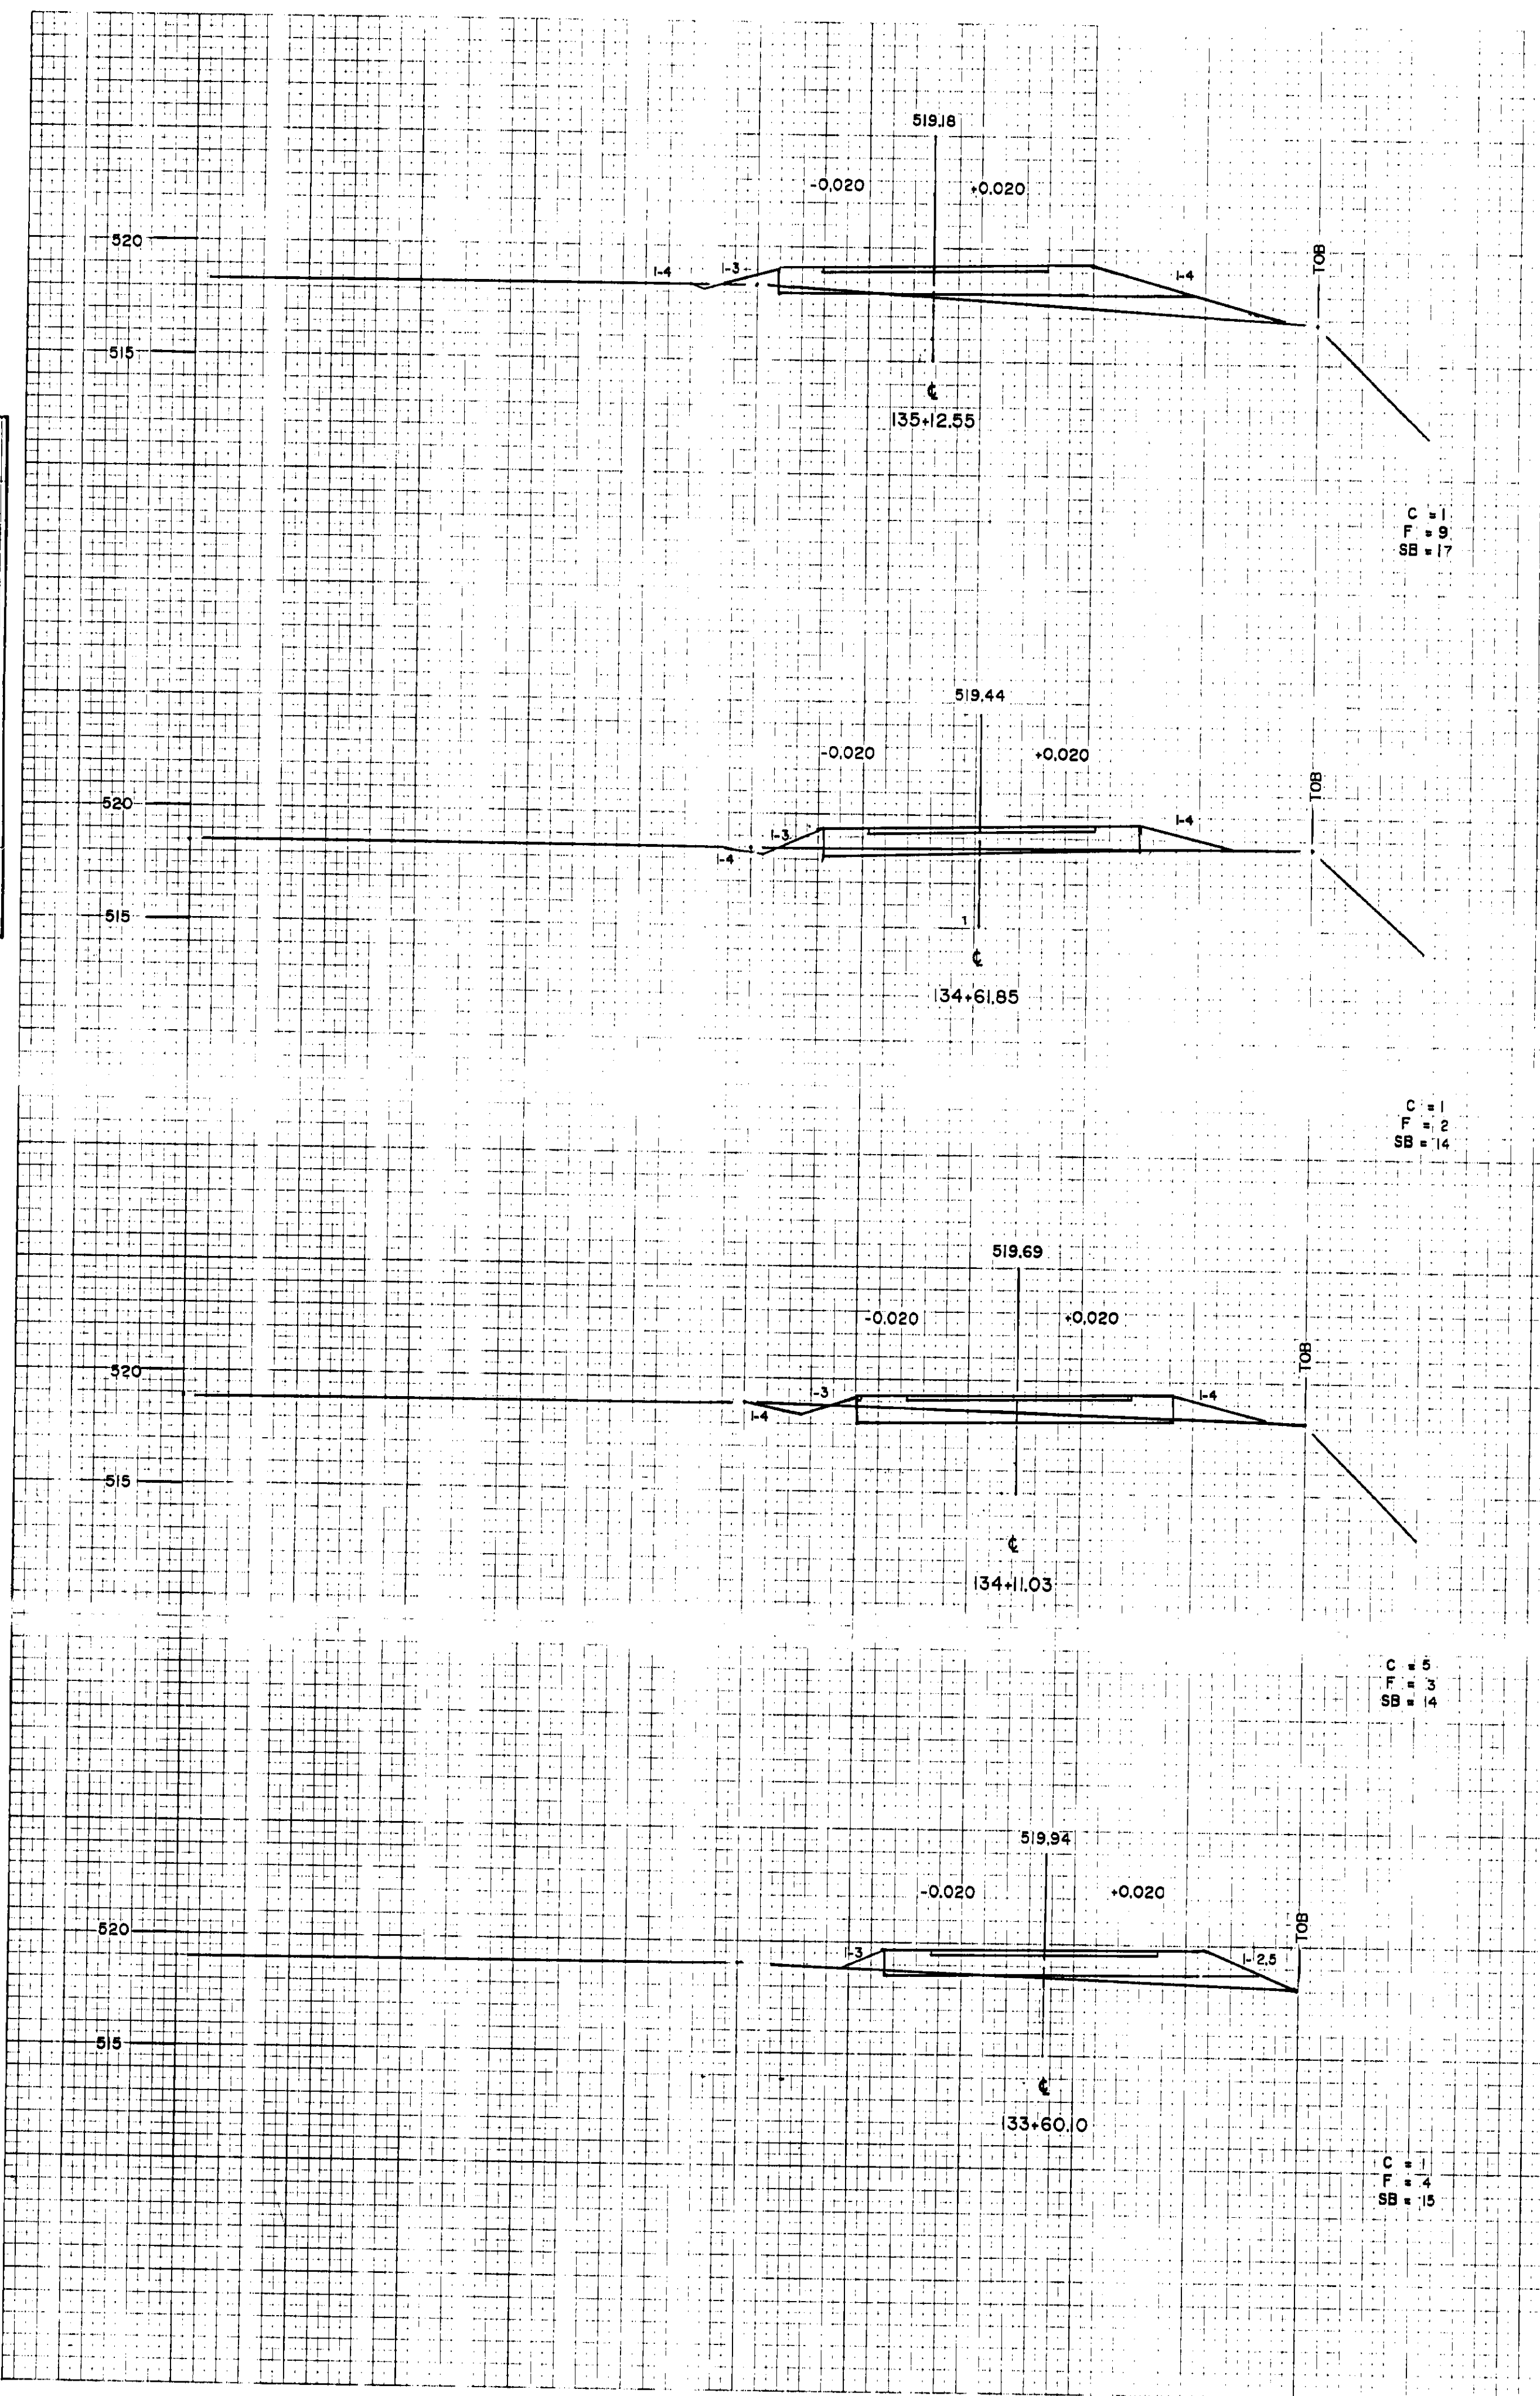

FROM STA. 131+50 TO STA. 135+00
 PROJECT NAME: WINOOSKI RIVER WEST BIKE PATH
 NO. BWM-BIKE(4)5
 PINKHAM ENGINEERING ASSOCIATES, INC.
 SHEET 85 OF 132 SHEETS