
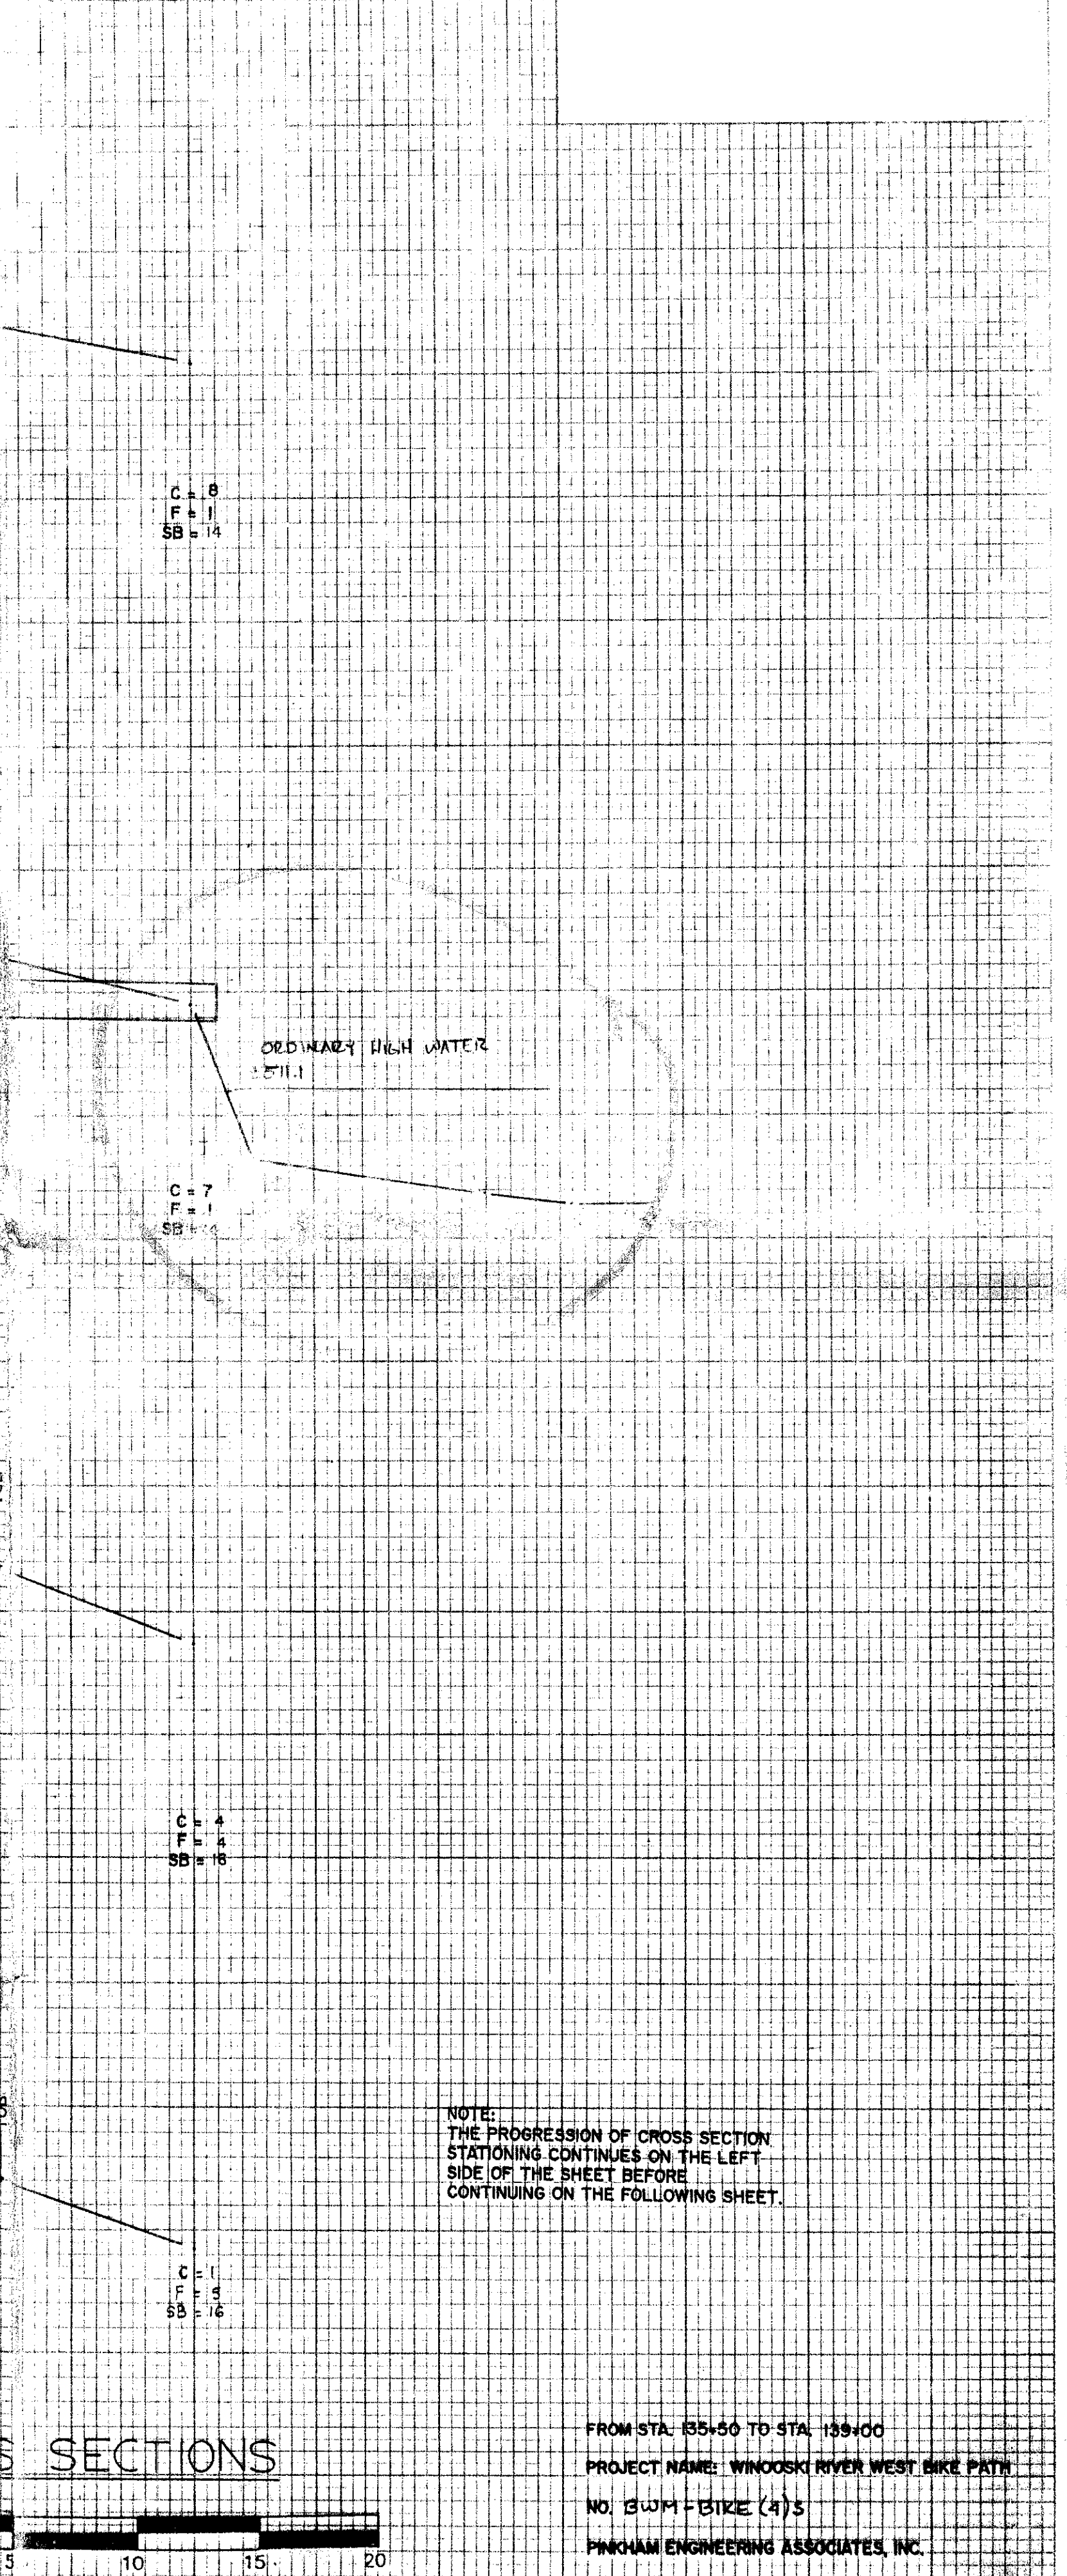
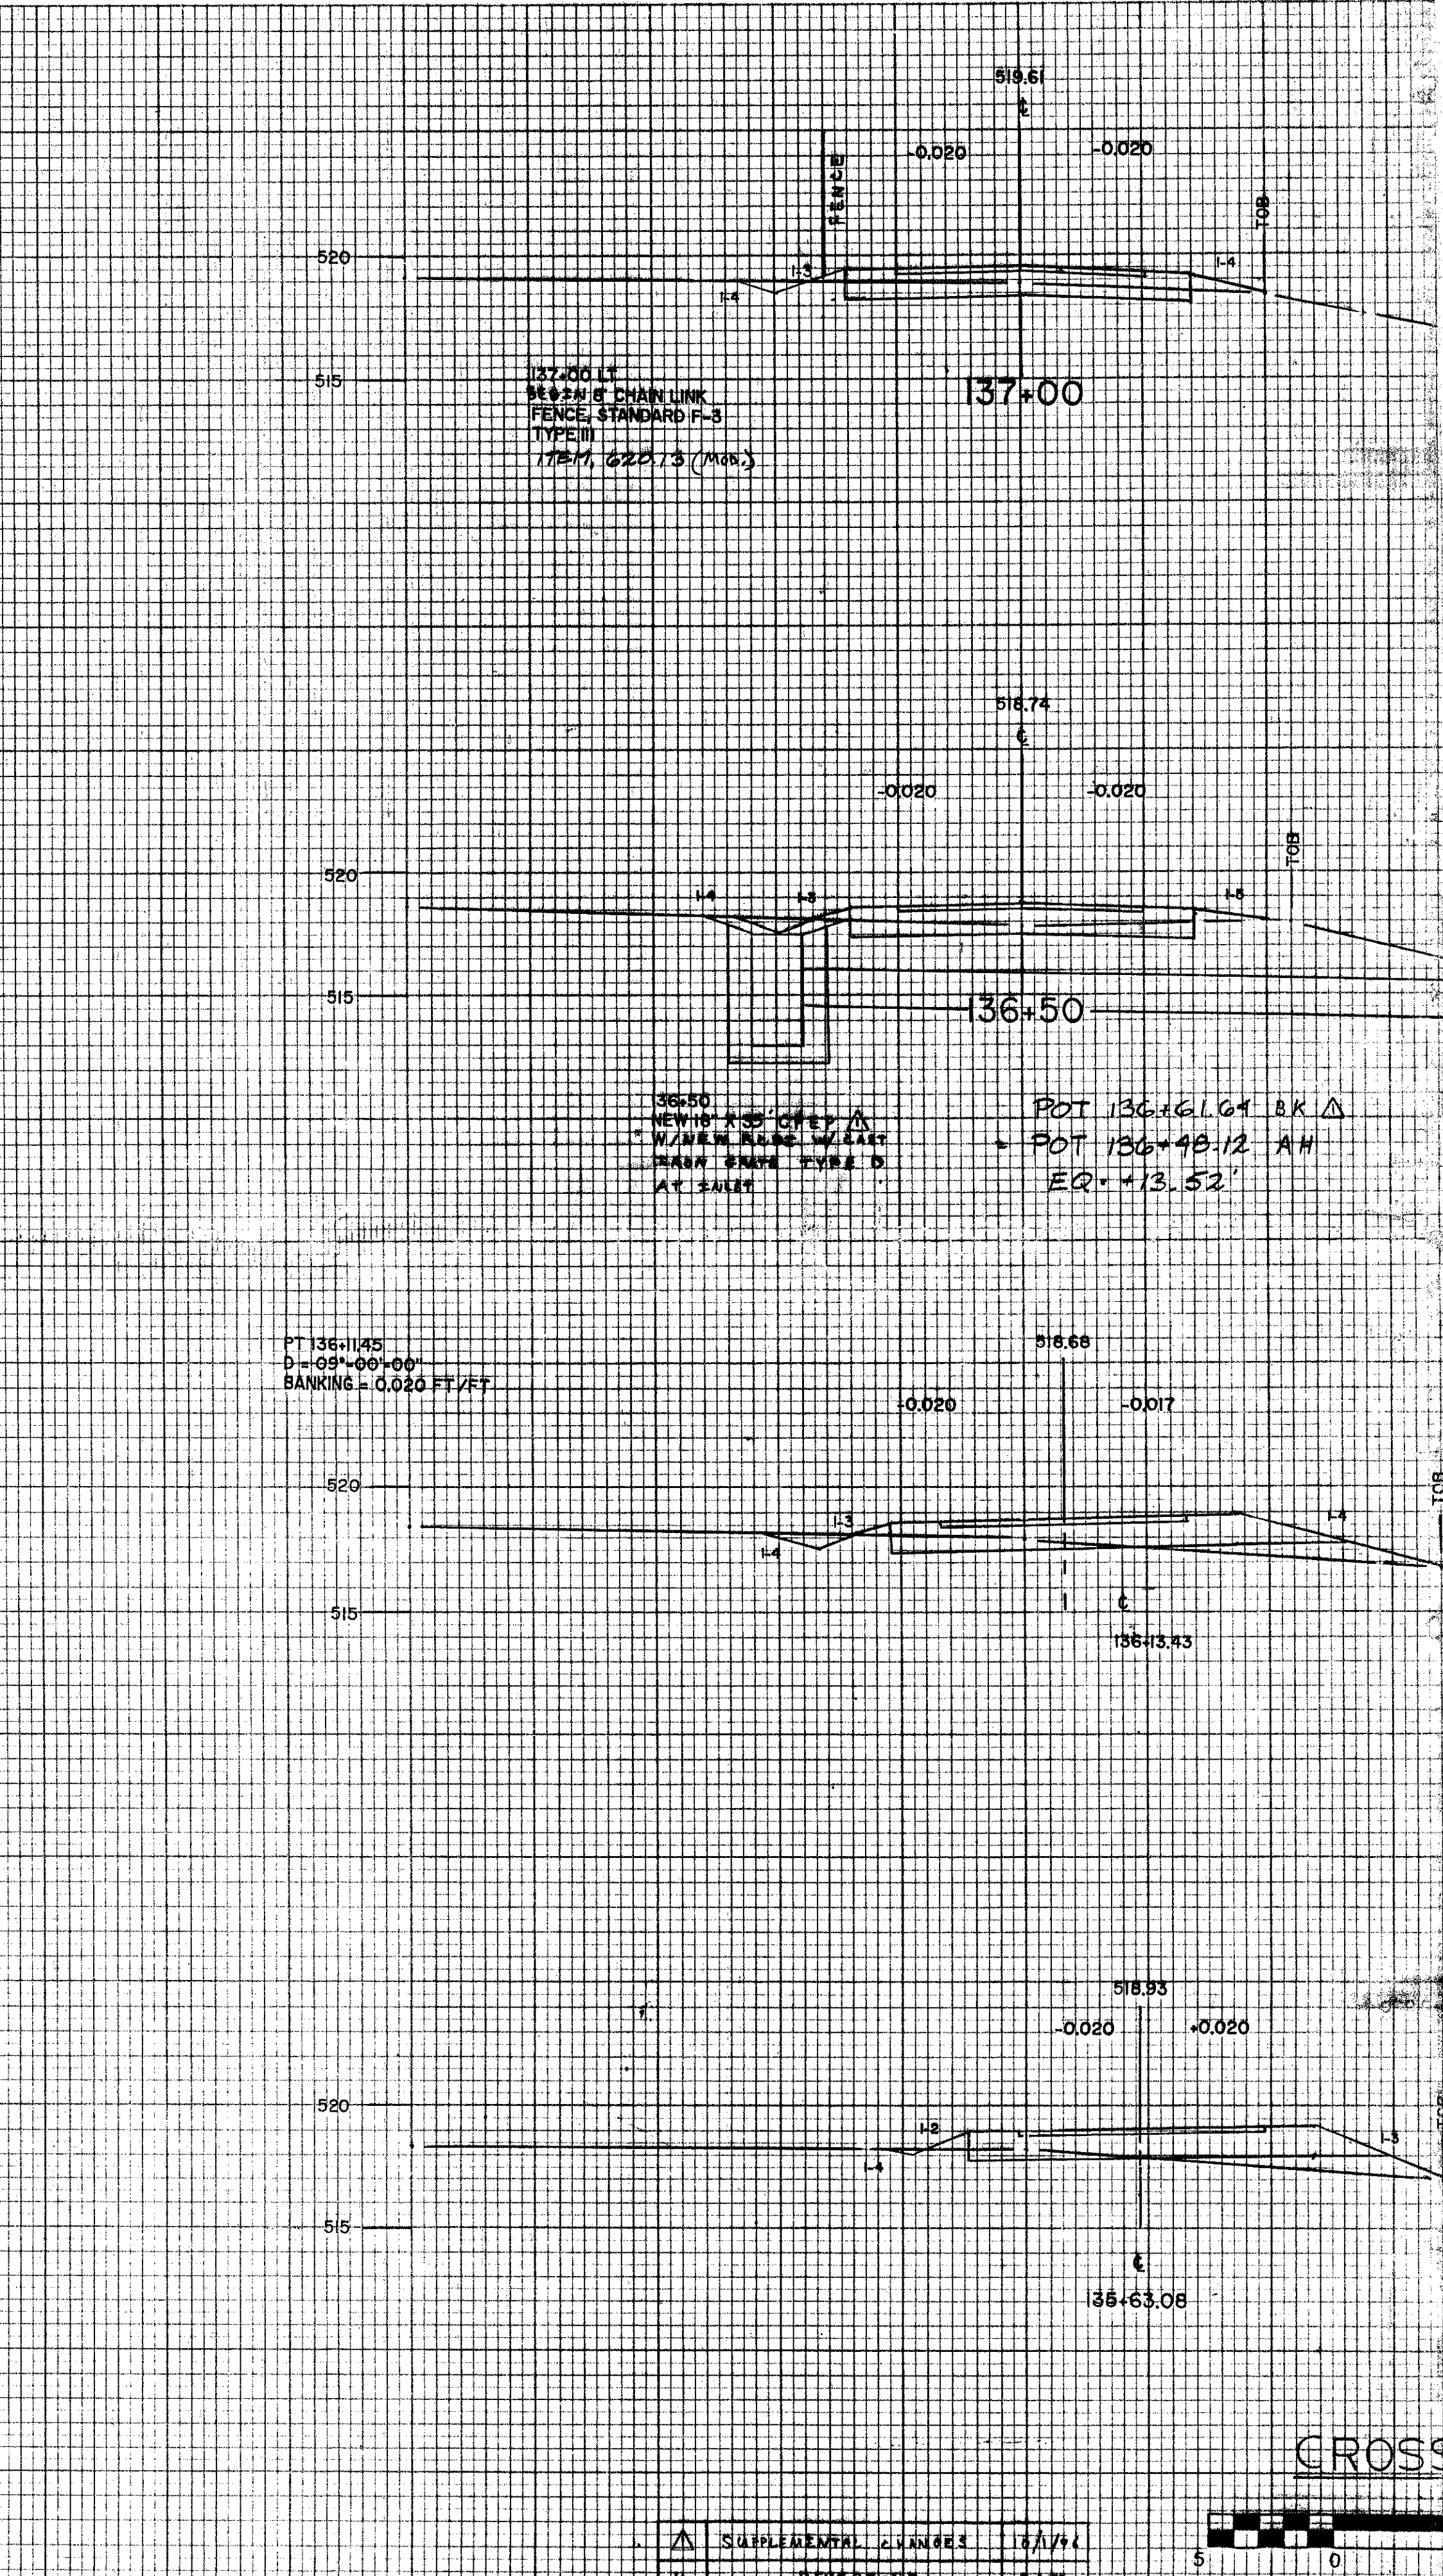



DATE: _____ BY: _____
 ORIGINAL SURVEY PLOTTED TEMPLATE
 SURVEY NOTEBOOK NO. _____
 SURVEY AREA CHECKED

DATE: _____ BY: _____
 ORIGINAL SURVEY PLOTTED TEMPLATE
 SURVEY NOTEBOOK NO. _____
 SURVEY AREA CHECKED

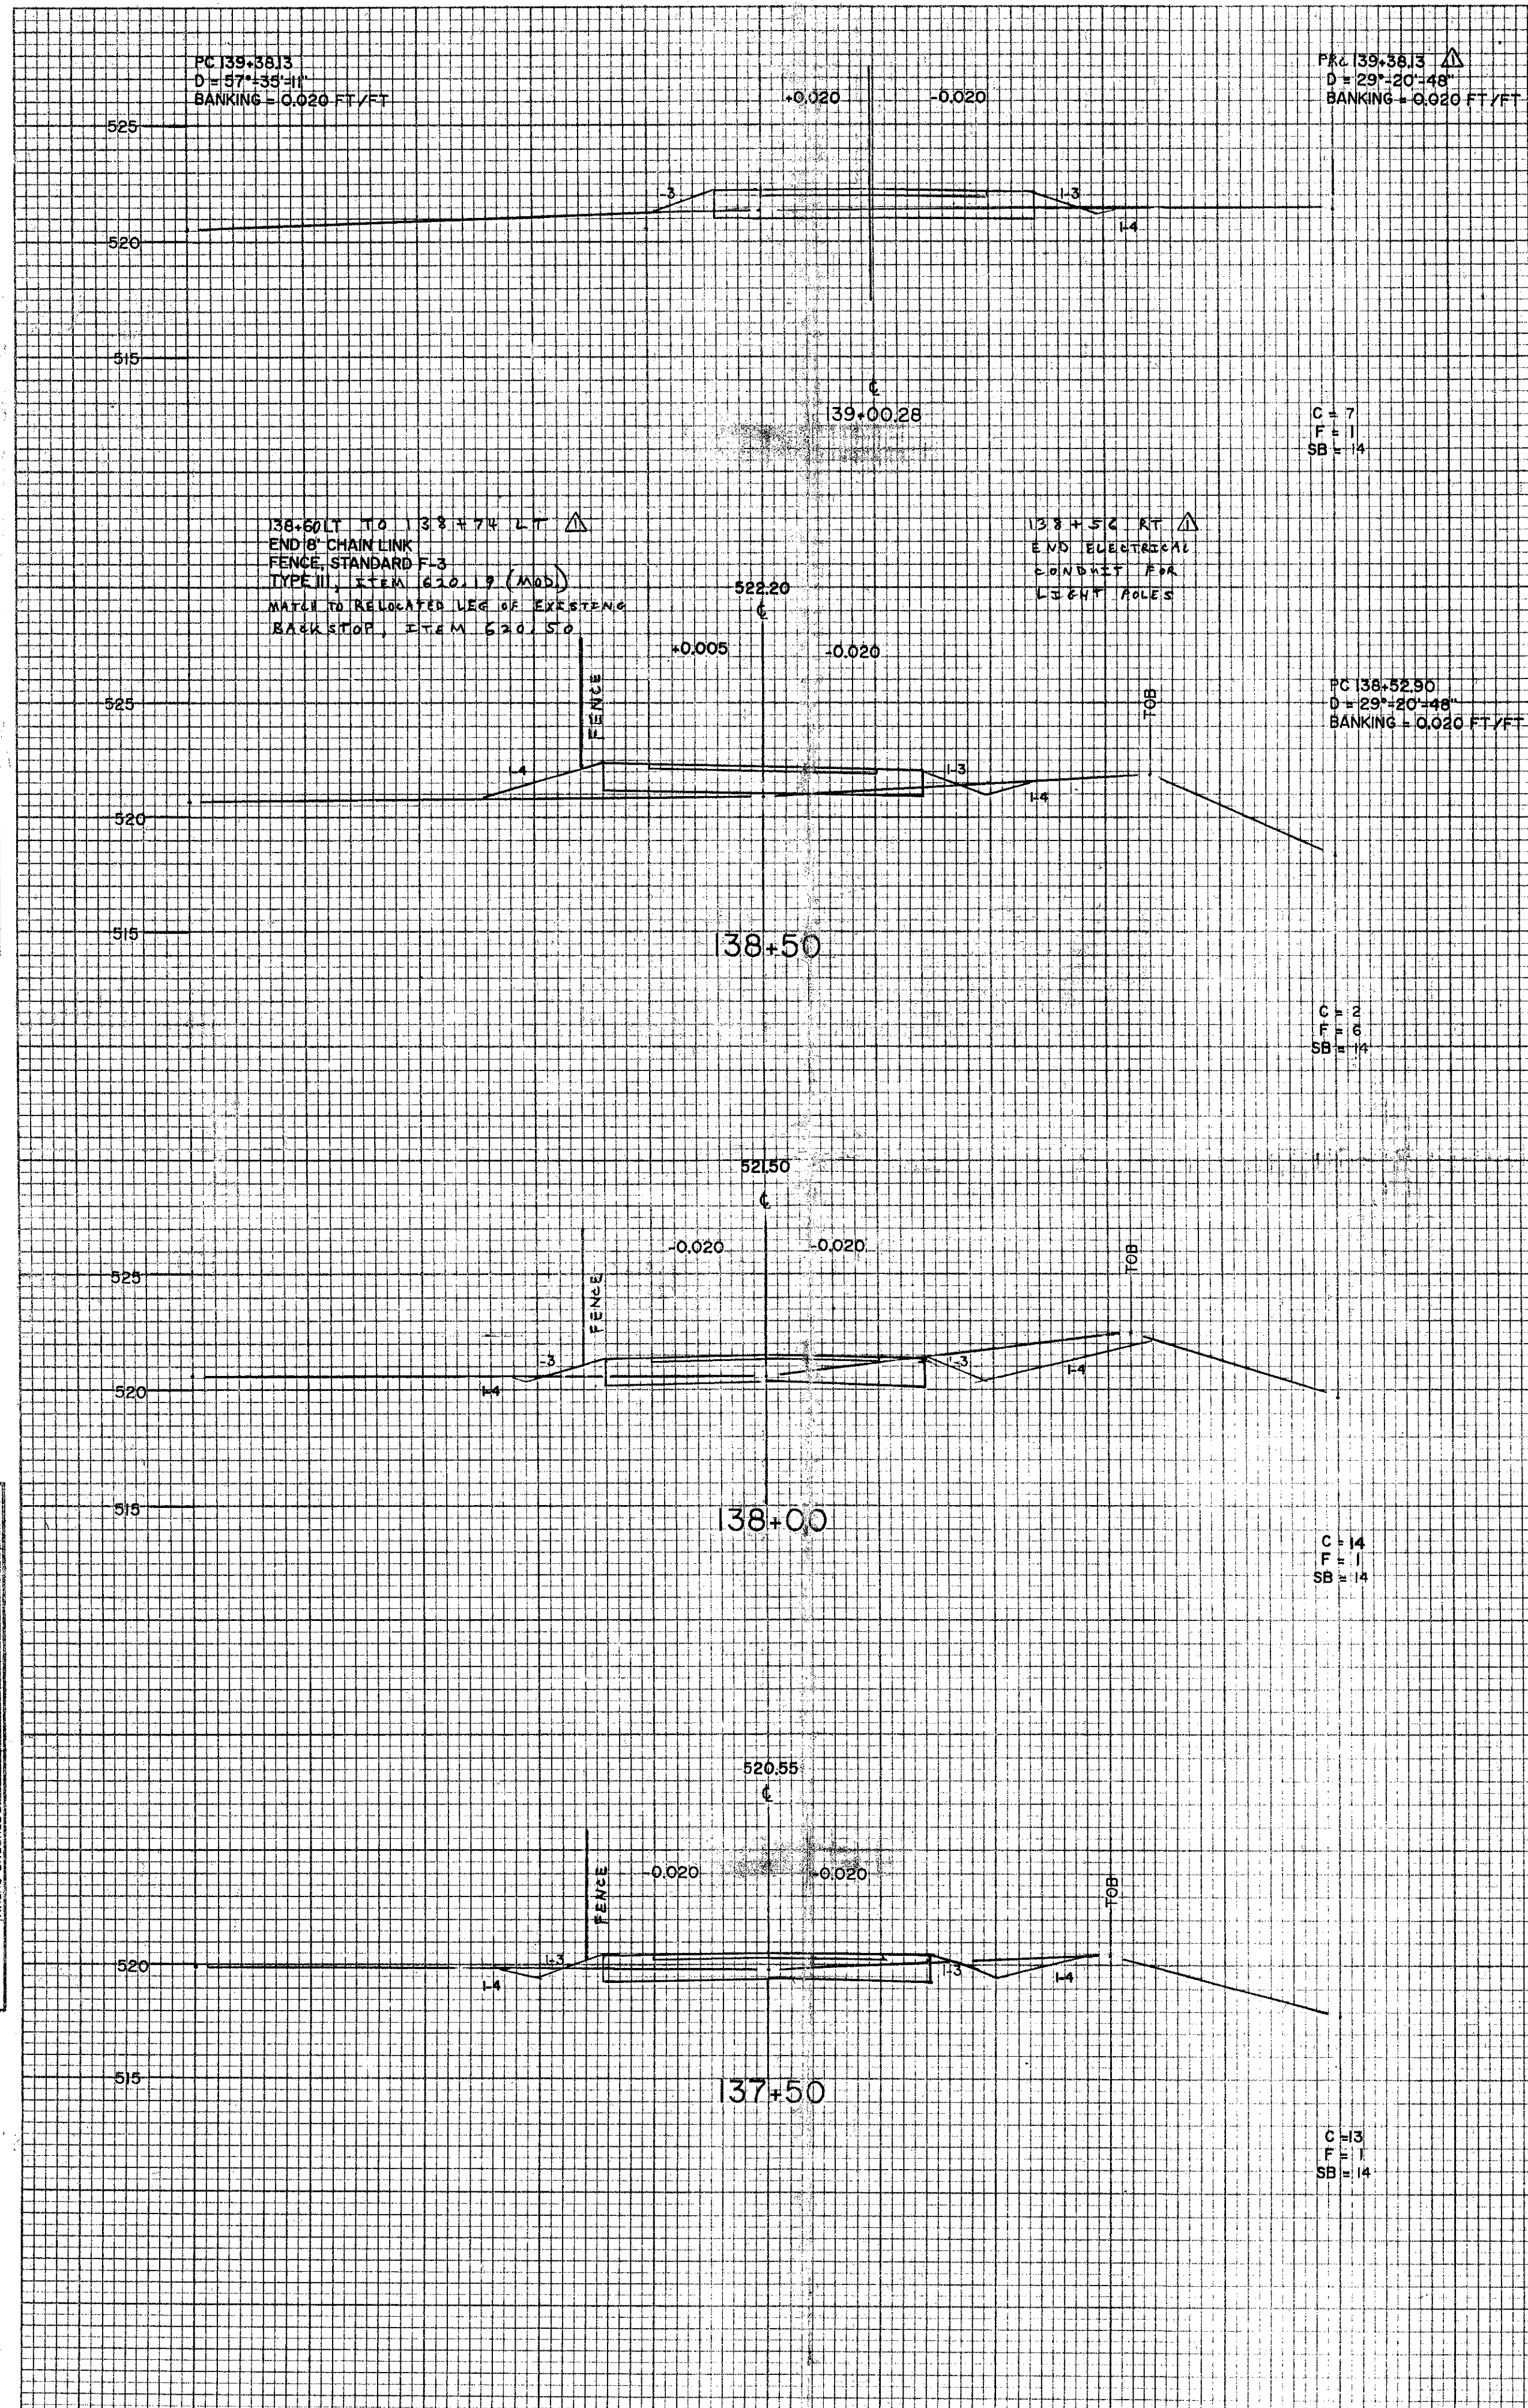

NOTE:
 THE PROGRESSION OF CROSS SECTION
 STATIONING CONTINUES ON THE LEFT
 SIDE OF THE SHEET BEFORE
 CONTINUING ON THE FOLLOWING SHEET.

CROSS SECTIONS

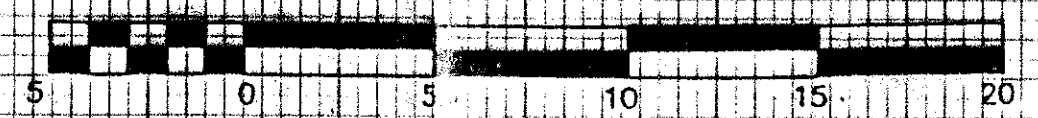

NO.	REVISIONS	DATE
1	SUPPLEMENTAL CHANGES	10/1/94

FROM STA. 135+50 TO STA. 136+00
 PROJECT NAME: WINOOSKI RIVER WEST BIKE PATH
 NO. 6001 - BIKE (4)S
 PINKHAM ENGINEERING ASSOCIATES, INC.
 SHEET 36 OF 112 SHEETS