



DATE _____ BY _____
 SURVEYED _____
 PLOTTED _____
 TEMPLATE _____
 NOTE BOOK _____
 NO. _____
 AREAS CHECKED _____

DATE _____ BY _____
 SURVEYED _____
 PLOTTED _____
 TEMPLATE _____
 NOTE BOOK _____
 NO. _____
 AREAS CHECKED _____

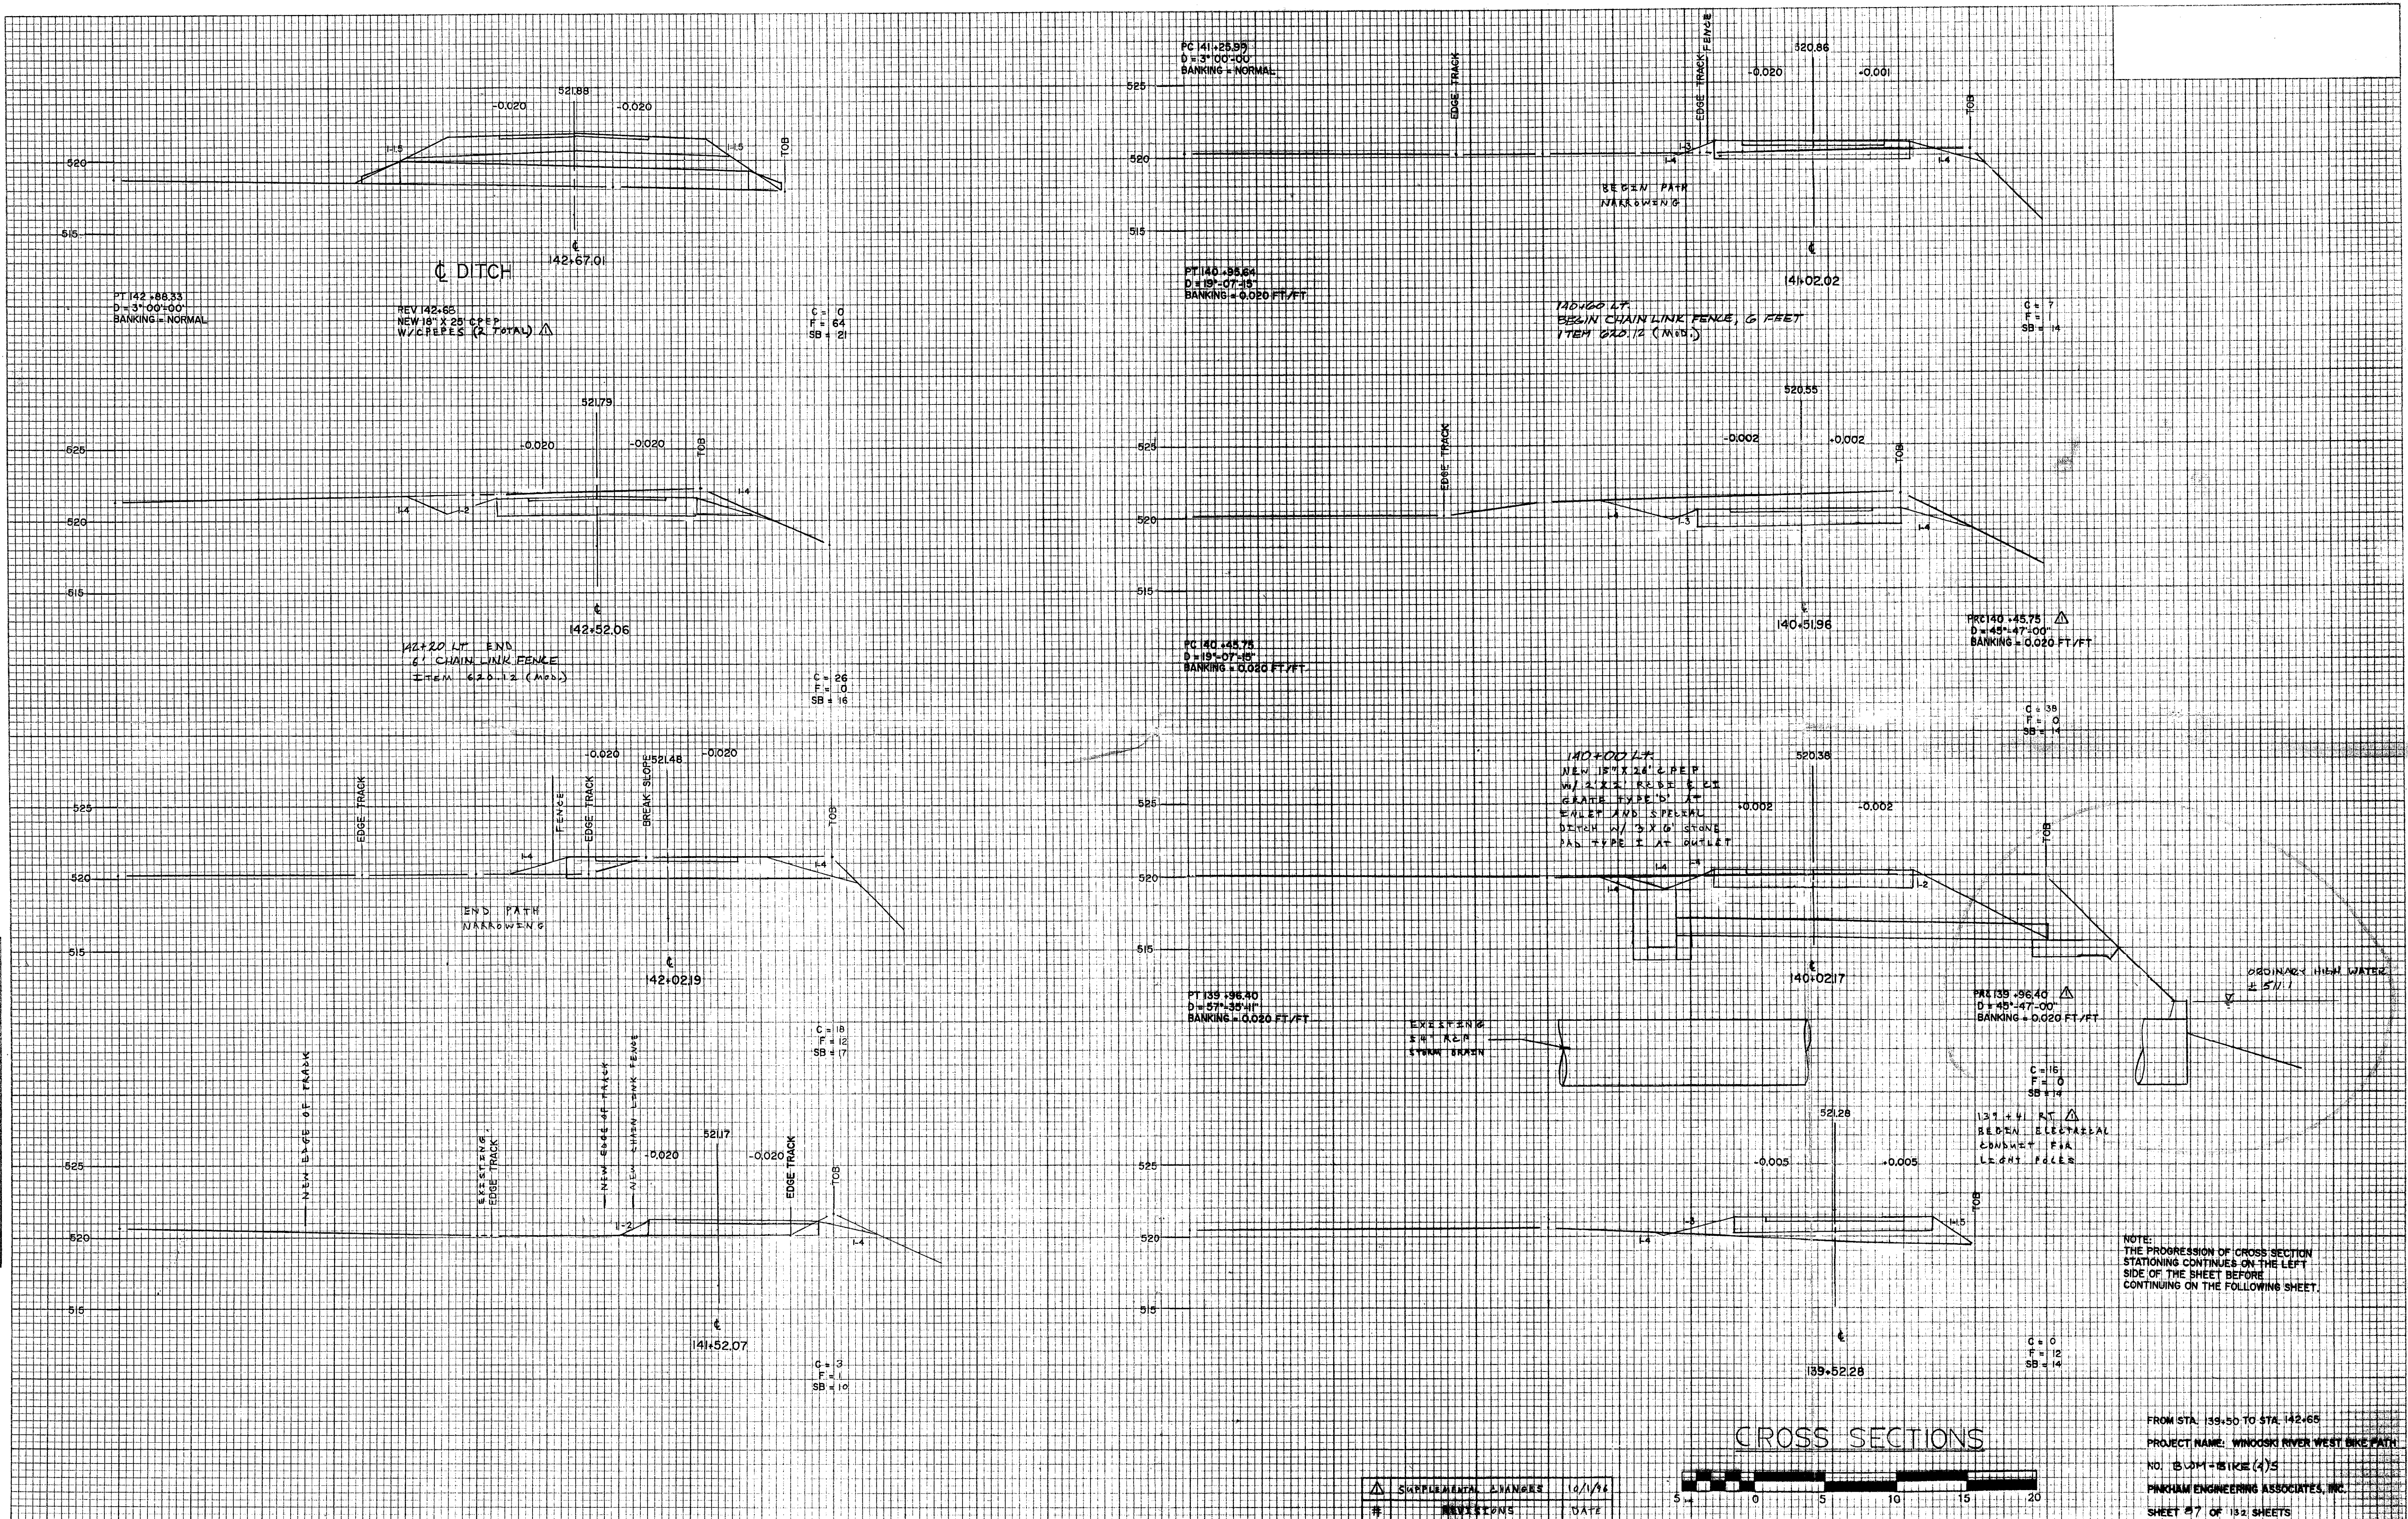

NOTE: THE PROGRESSION OF CROSS SECTION STATIONING CONTINUES ON THE LEFT SIDE OF THE SHEET BEFORE CONTINUING ON THE FOLLOWING SHEET.

CROSS SECTIONS

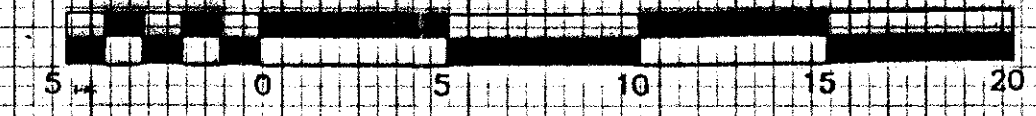

△	SUPPLEMENTAL DIMENSIONS	10/1/96
#	REVISIONS	DATE

FROM STA: 139+50 TO STA: 142+65
 PROJECT NAME: WINGOCK RIVER WEST BIKE PATH
 NO: 0301-1512E (4)S
 PINKHAM ENGINEERING ASSOCIATES, INC.
 SHEET #7 OF 152 SHEETS