
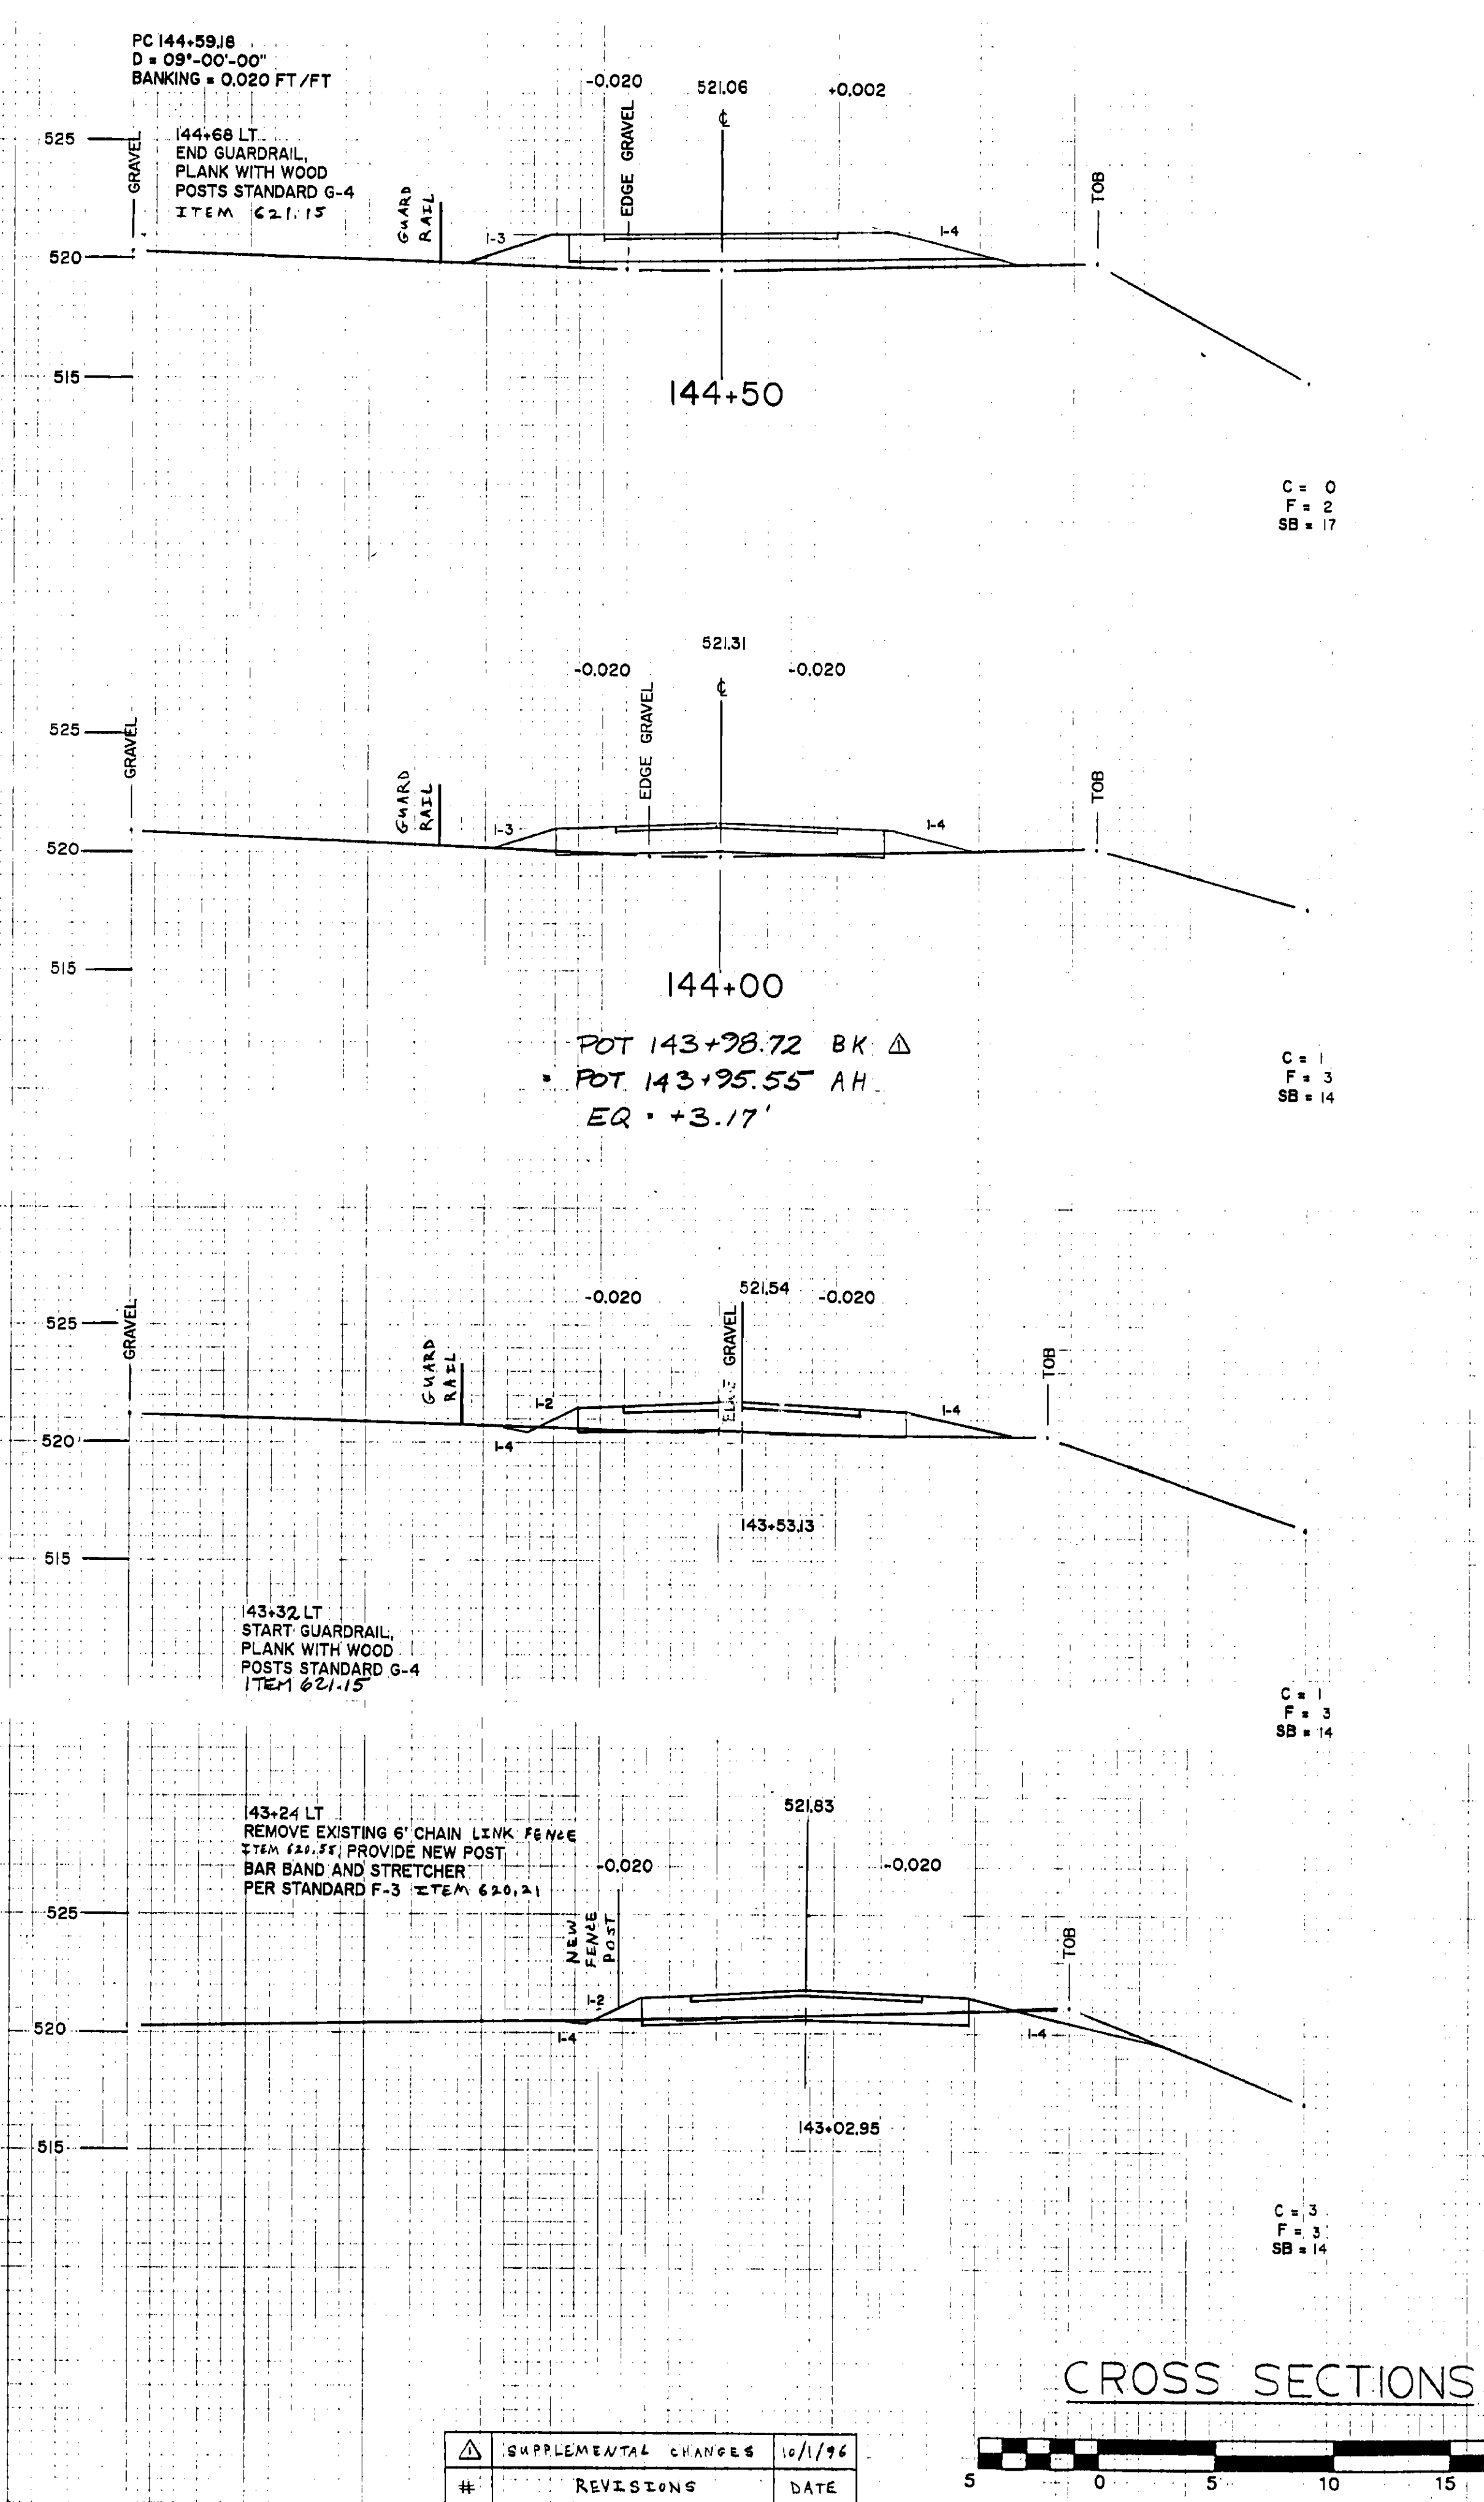



ORIGINAL SURVEY  
 SURVEY  
 DATE  
 NO.

ORIGINAL SURVEY  
 SURVEY  
 DATE  
 NO.

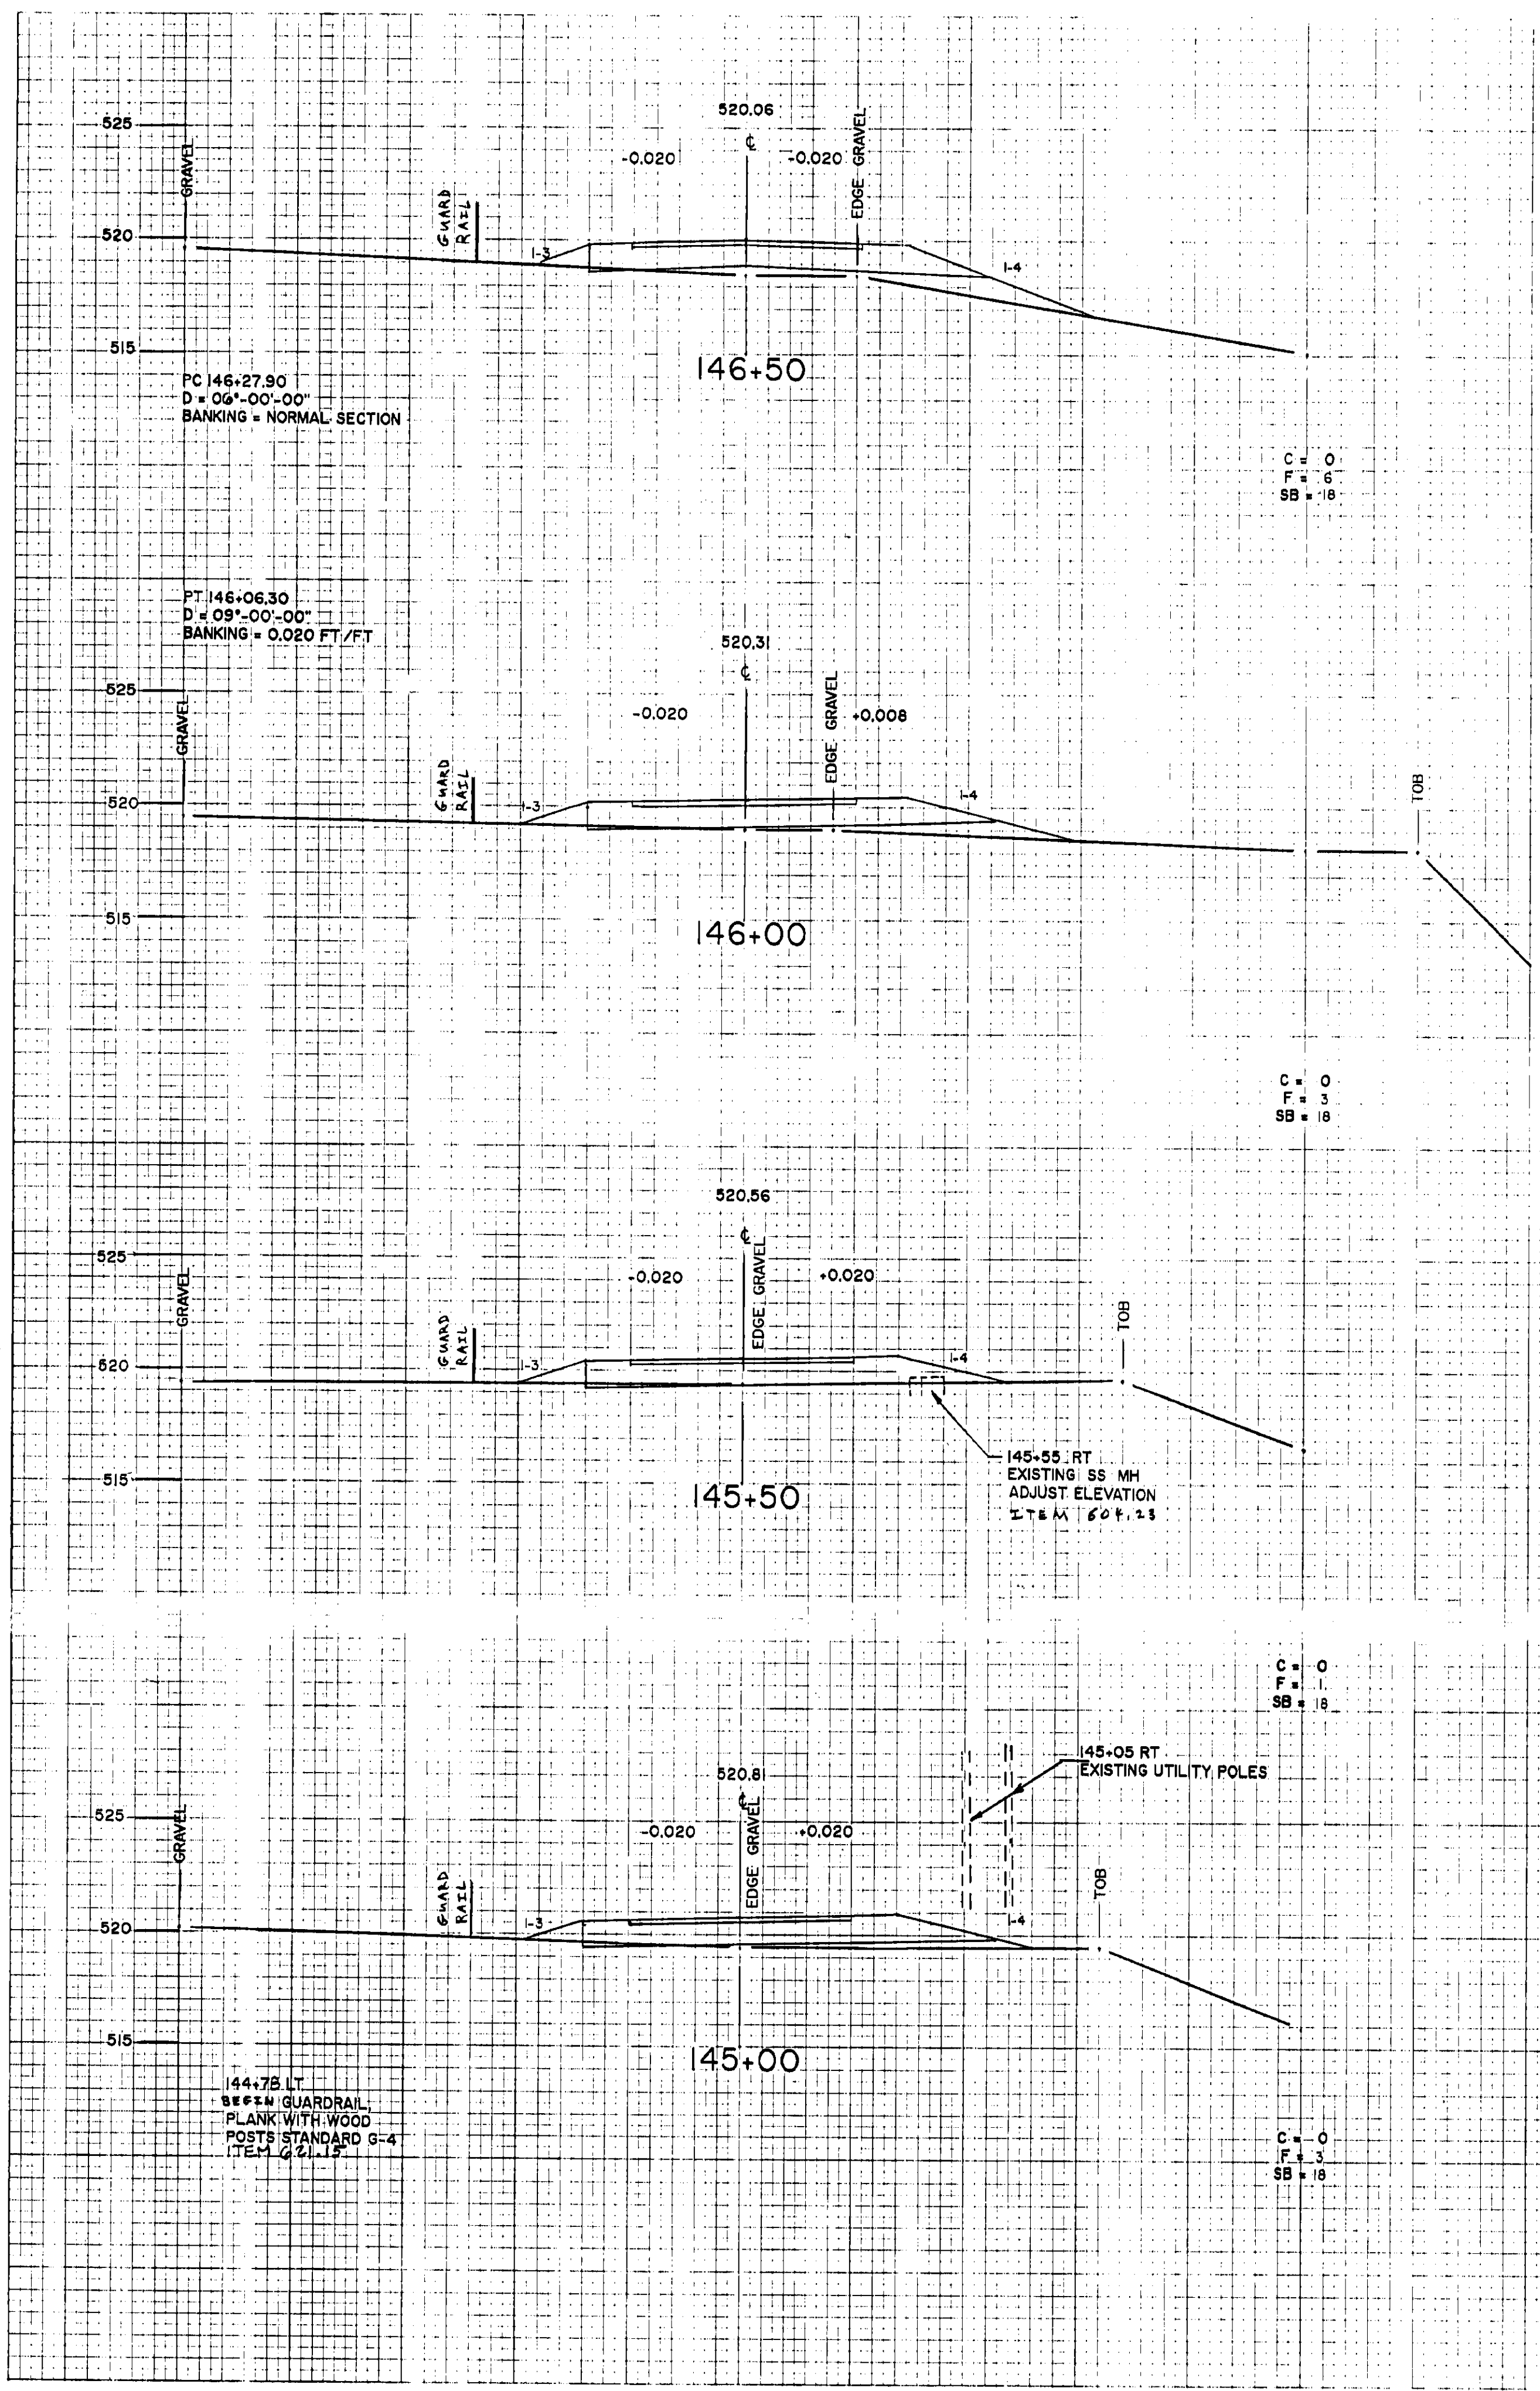

NOTE:  
 THE PROGRESSION OF CROSS SECTION  
 STATIONING CONTINUES ON THE LEFT  
 SIDE OF THE SHEET BEFORE  
 CONTINUING ON THE FOLLOWING SHEET.

CROSS SECTIONS

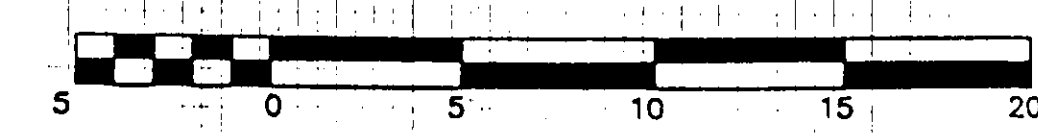

#	REVISIONS	DATE
1	SUPPLEMENTAL CHANGES	10/1/96

FROM STA. 143+00 TO STA. 146+50  
 PROJECT NAME: WINOOSKI RIVER WEST BIKE PATH  
 NO. BWM - BIKE (4)5  
 PINNAC ENGINEERING ASSOCIATES, INC.  
 SHEET 28 OF 132 SHEETS