


FINAL SURVEY BY DATE
 SURVEYED BY
 PLOTTED BY
 NOTE BOOK NO.
 AREA CHECKED

ORIGINAL SURVEY BY DATE
 SURVEYED BY
 PLOTTED BY
 NOTE BOOK NO.
 AREA CHECKED



CROSS SECTIONS

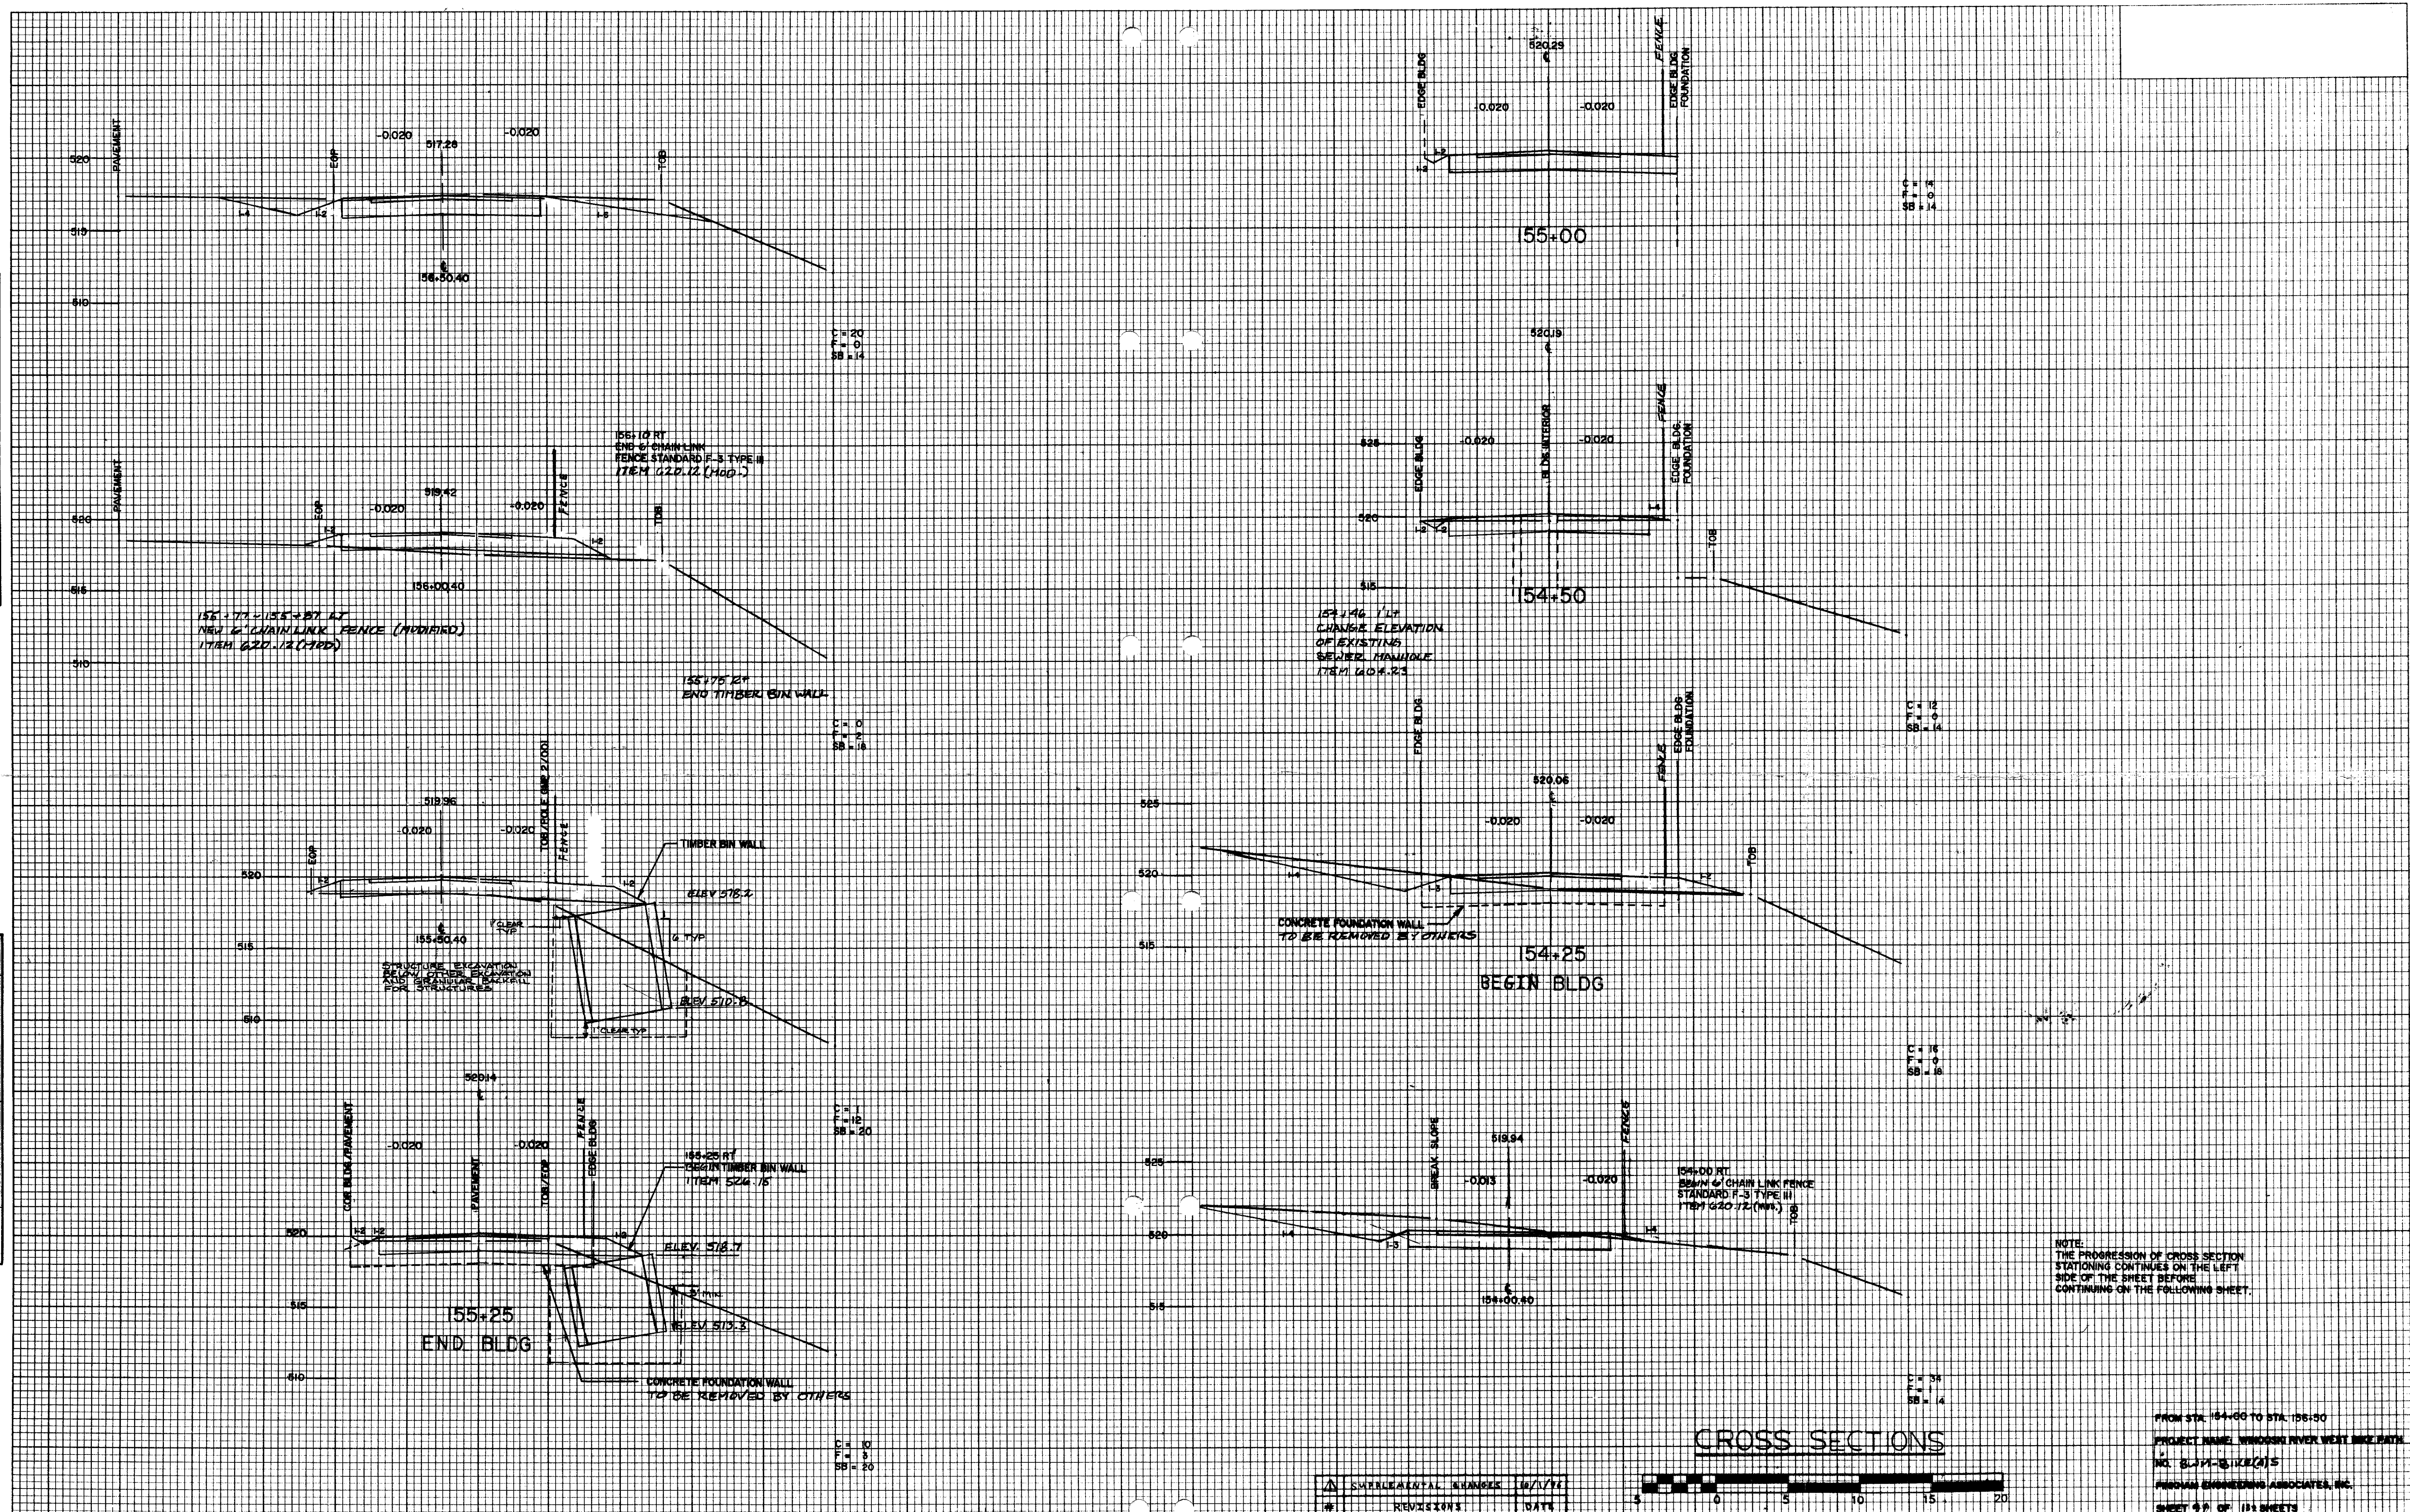

#	REVISIONS	DATE
1	APPROVED FOR CONSTRUCTION	06/17/14

FROM STA. 154+00 TO STA. 156+50
 PROJECT NAME: WINDSOR RIVER WEST BIKE PATH
 NO. 3-11-5-12(15)
 PARHAM ENGINEERING ASSOCIATES, INC.
 SHEET 99 OF 131 SHEETS