


DATE	
BY	
SURVEYED	
PLOTTED	
NOTED	
CHECKED	
AREAS	
CHECKED	
NO.	

DATE	
BY	
ORIGINAL SURVEYED	
PLOTTED	
NOTED	
CHECKED	
AREAS	
CHECKED	
NO.	

PARKING LOT ELEV 516.52  
TOP GRATE 516.35

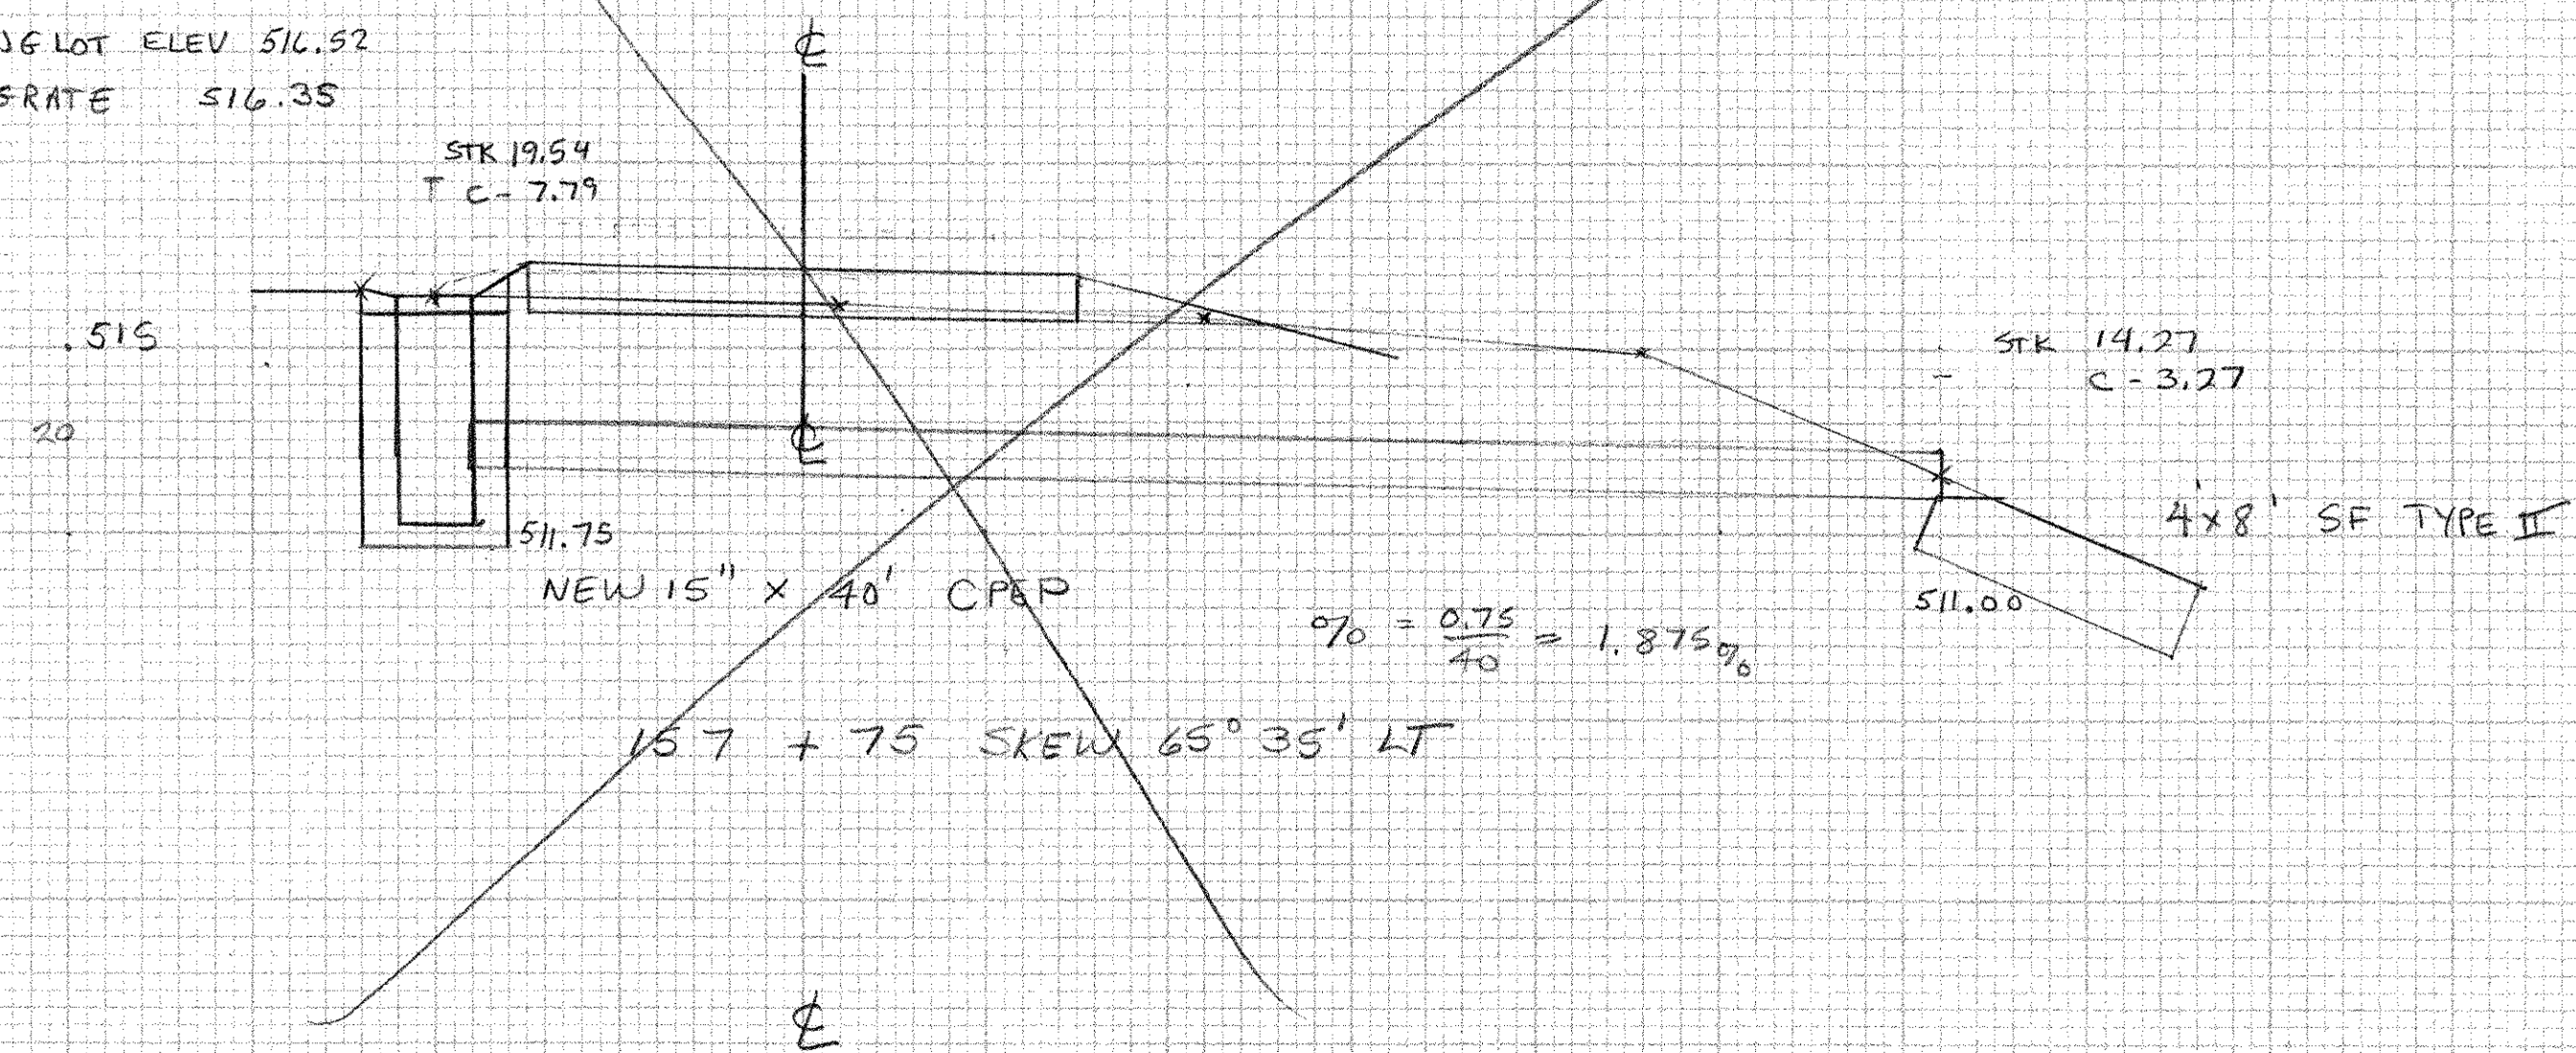

$$\% = \frac{0.75}{40} = 1.875\%$$

15.7 + 7.5 SKEW 65° 35' LT

MONTPELIER BWM-RIKE (4)S  
DRAINAGE SHEET # 2  
SCALE 1" = 5'