
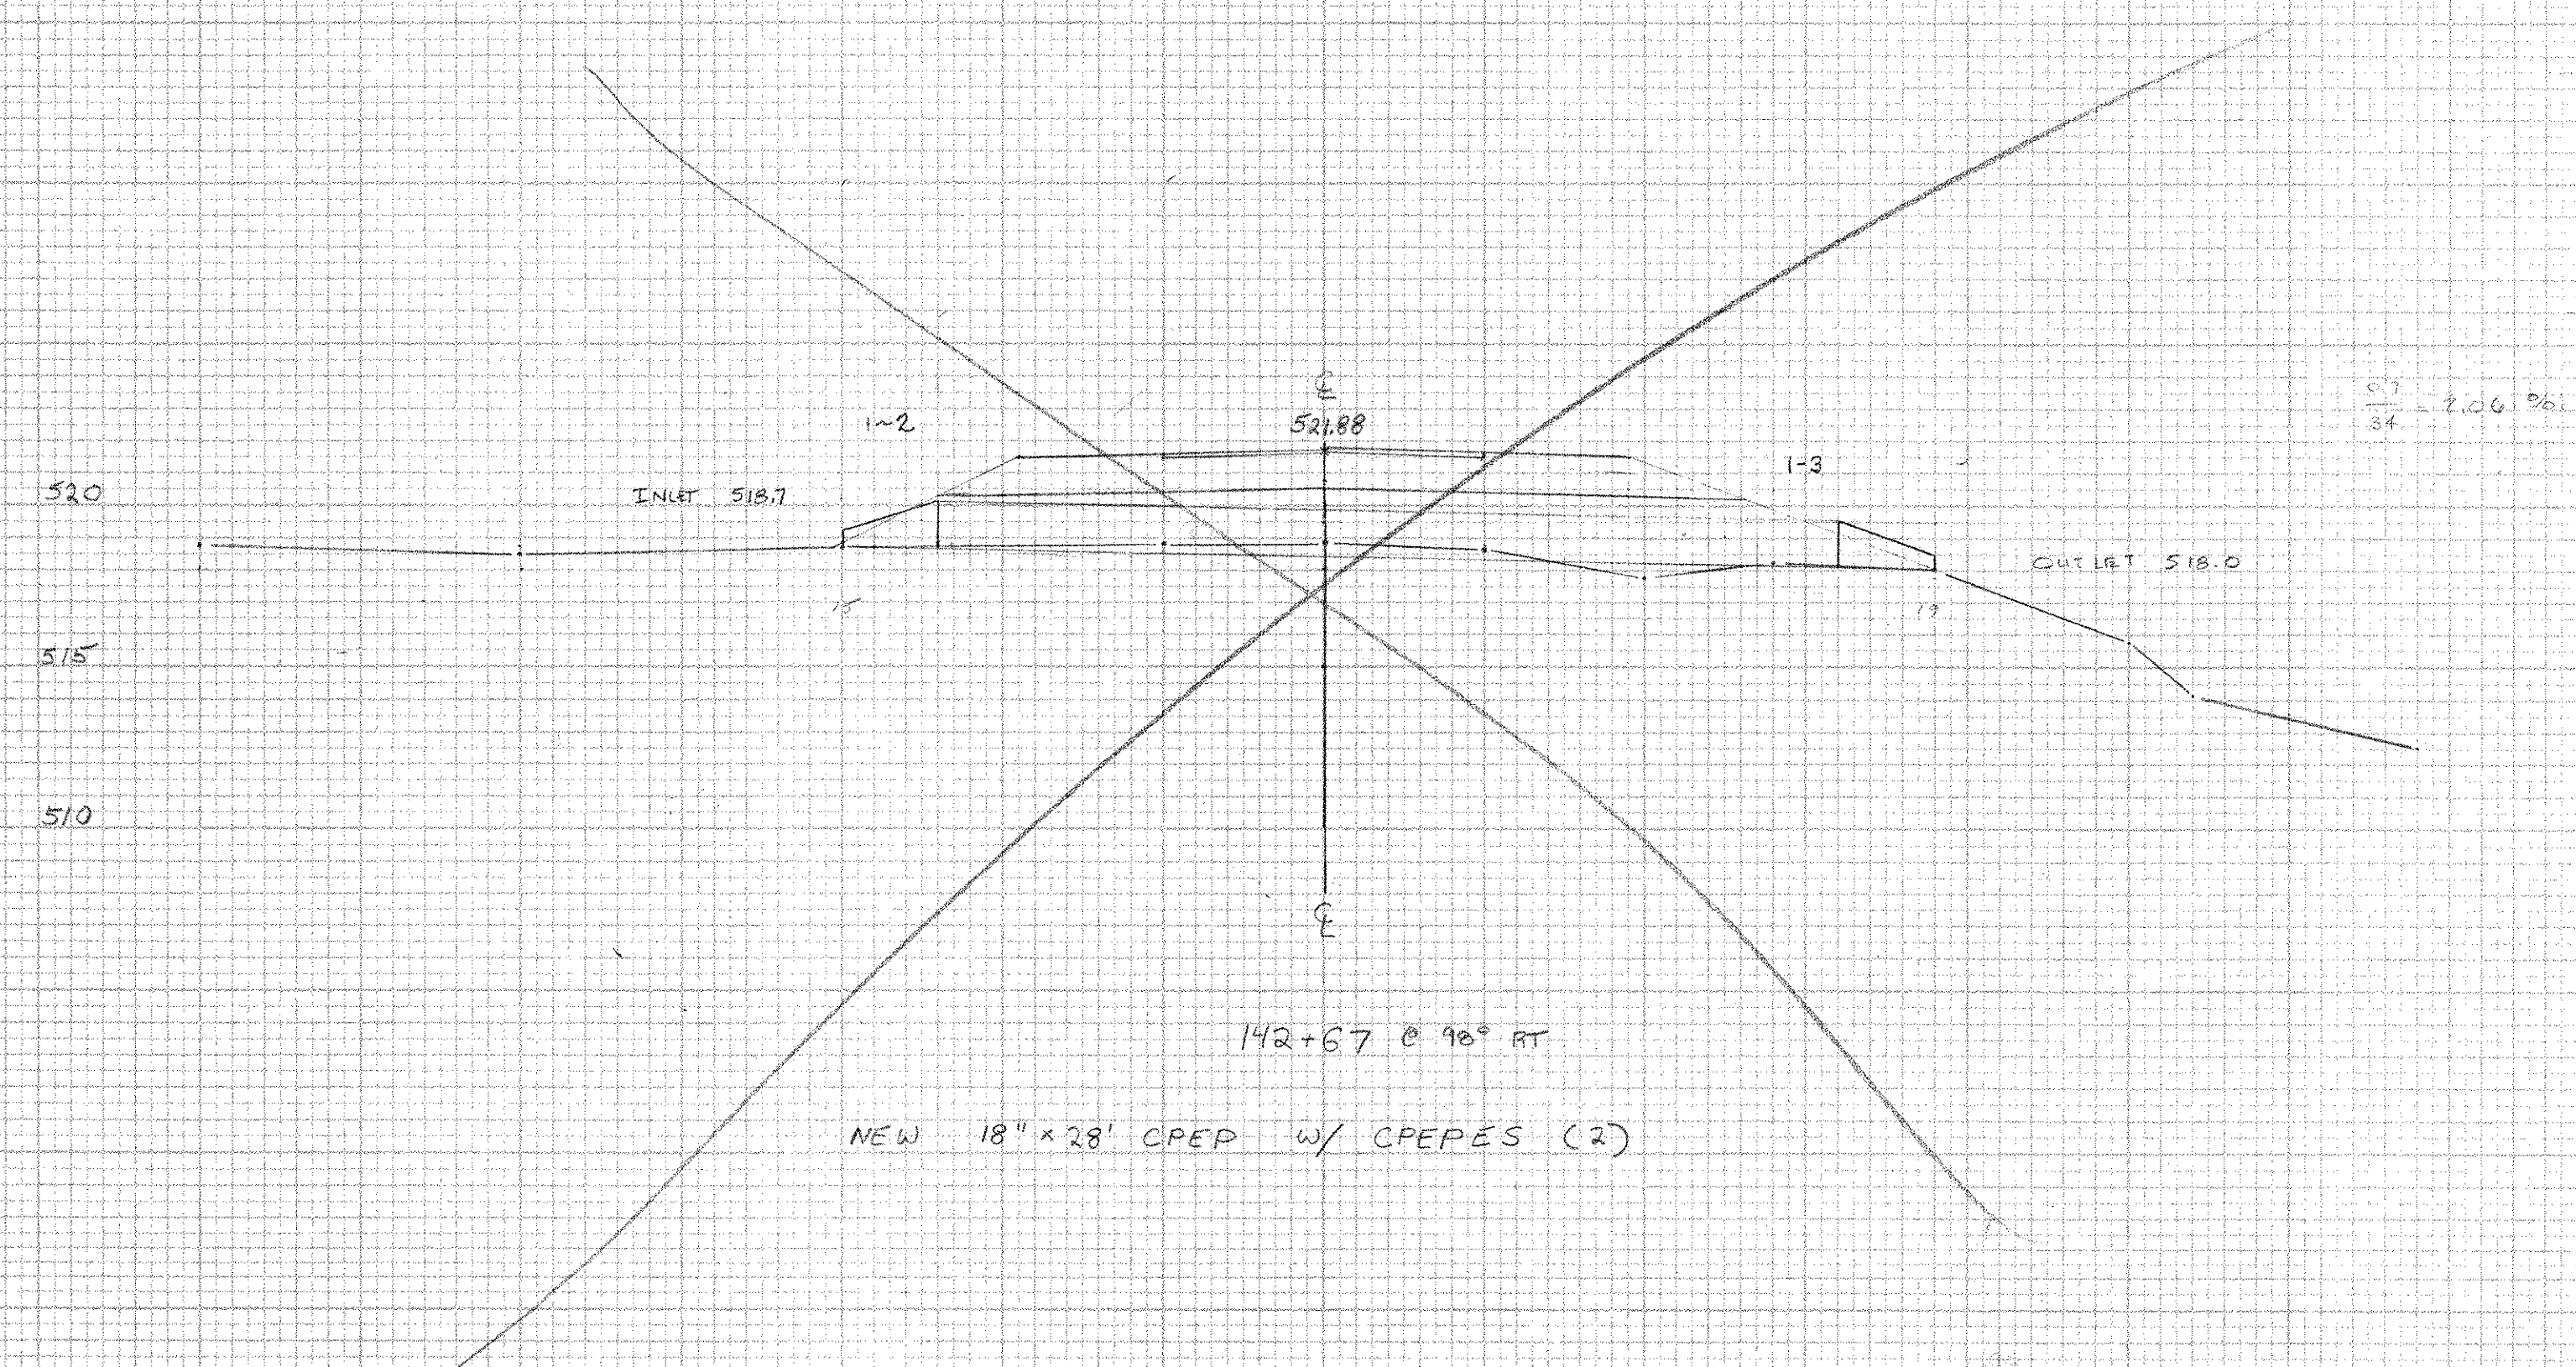


ORIGINAL SURVEY	SUBMITTED	BY	DATE
NOTE WORK	DATE		
AREAS	DATE		
AREAS	DATE		

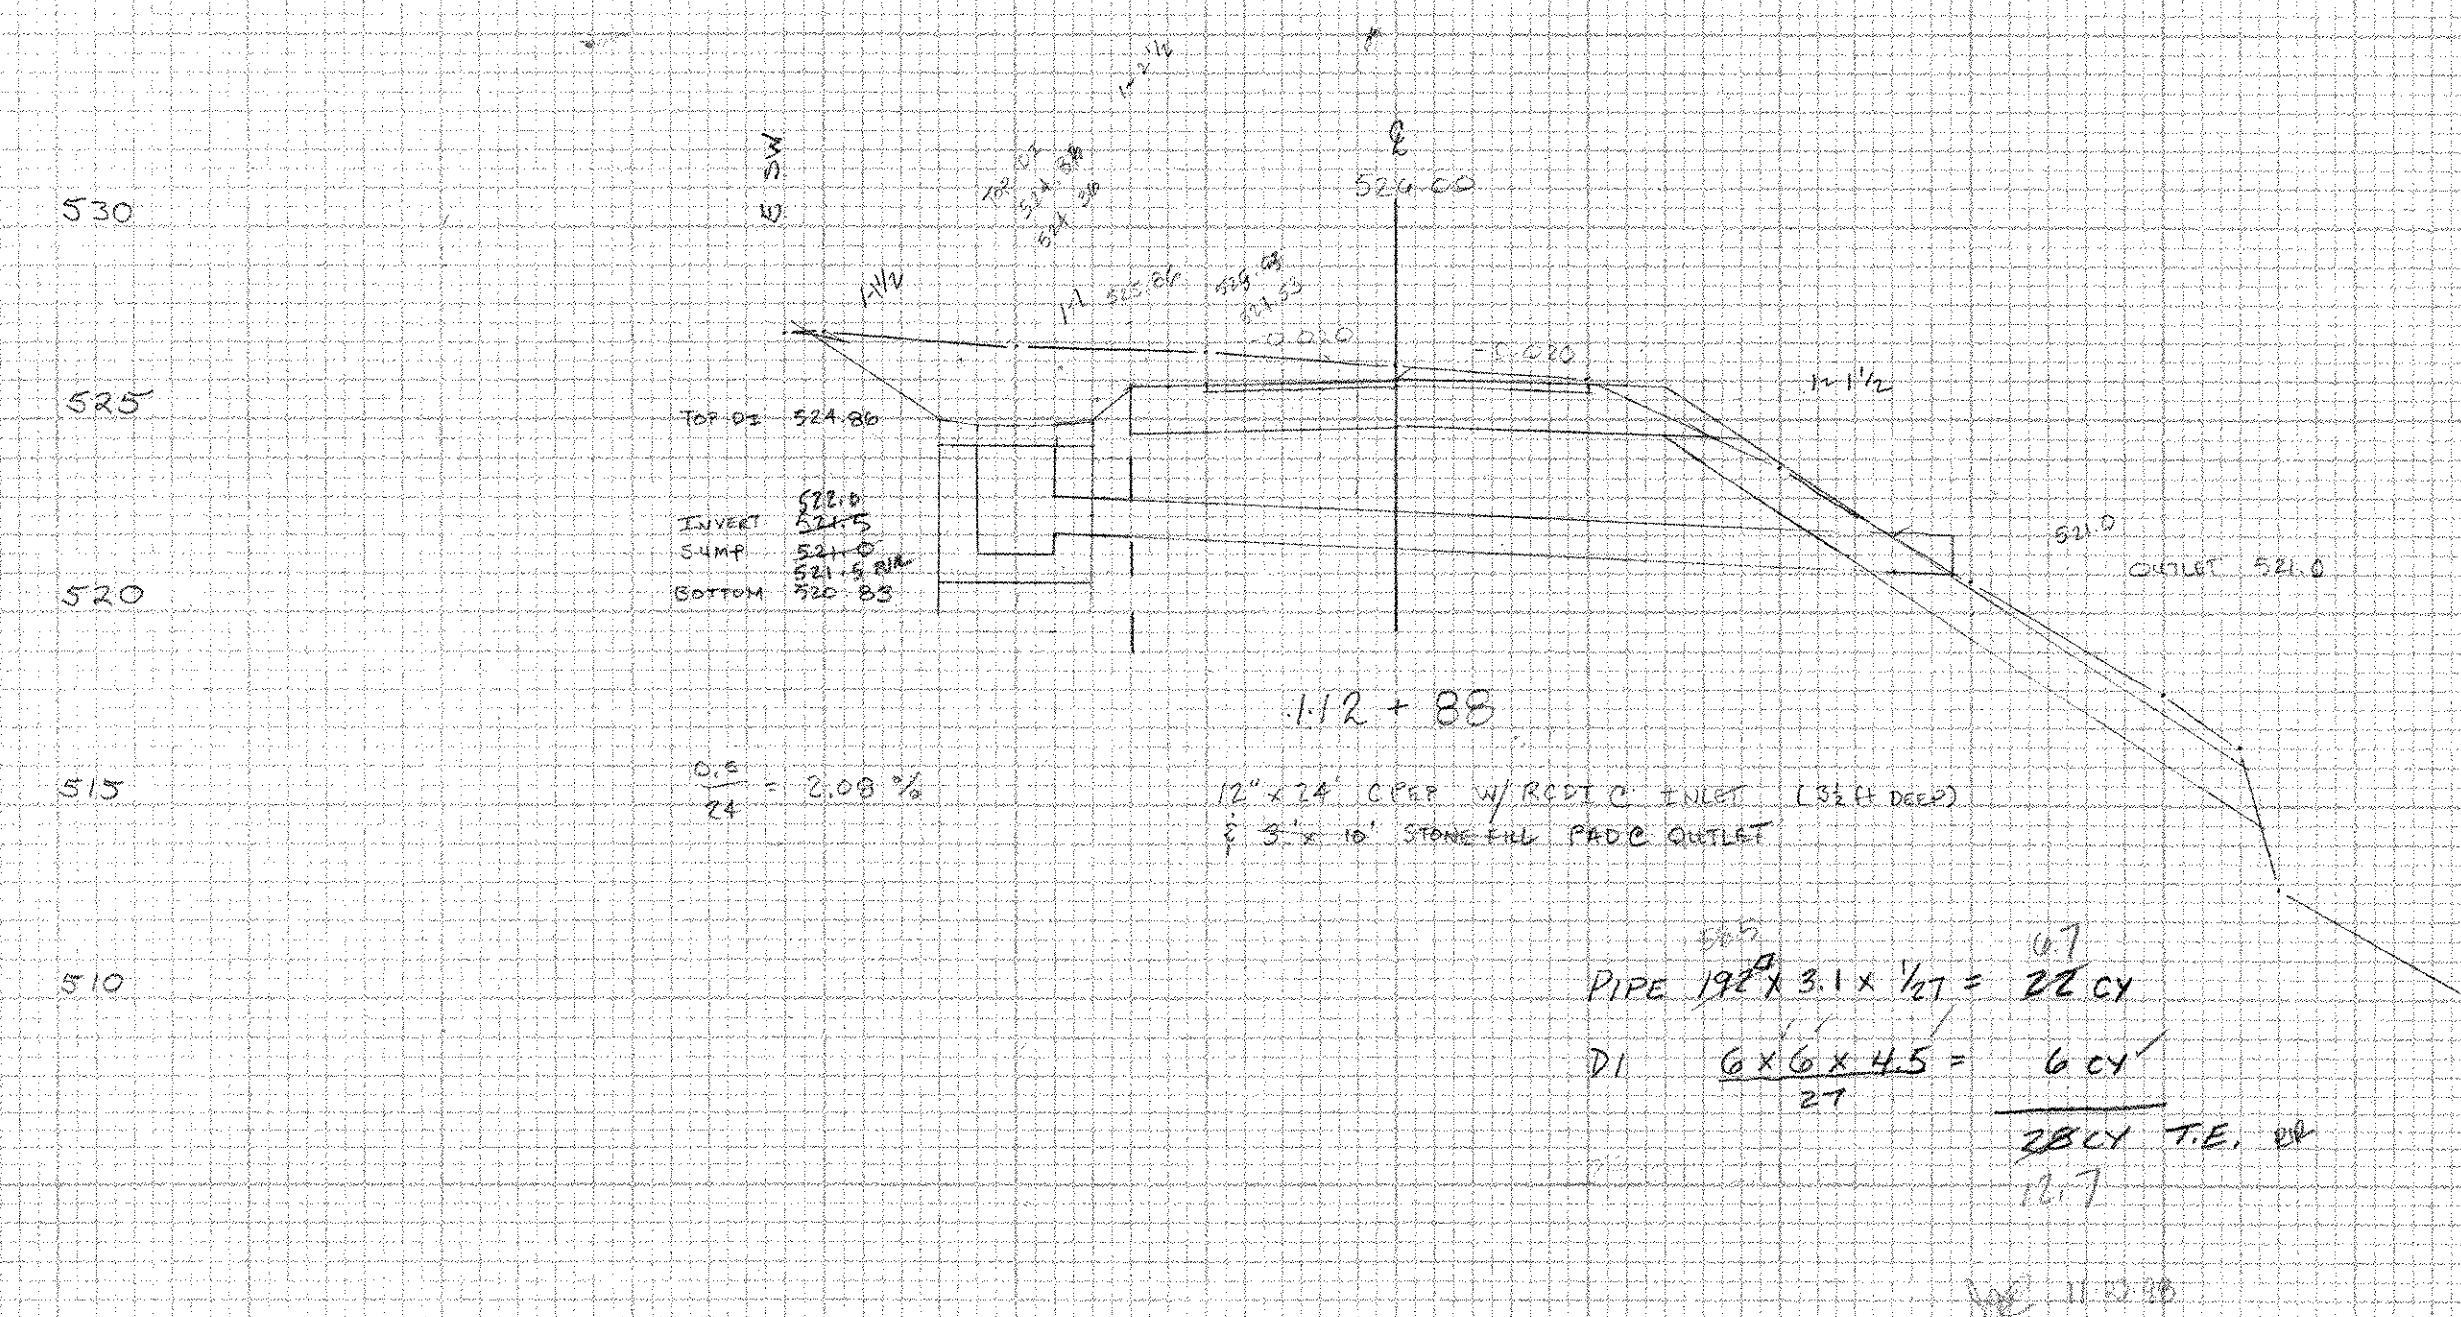

135