

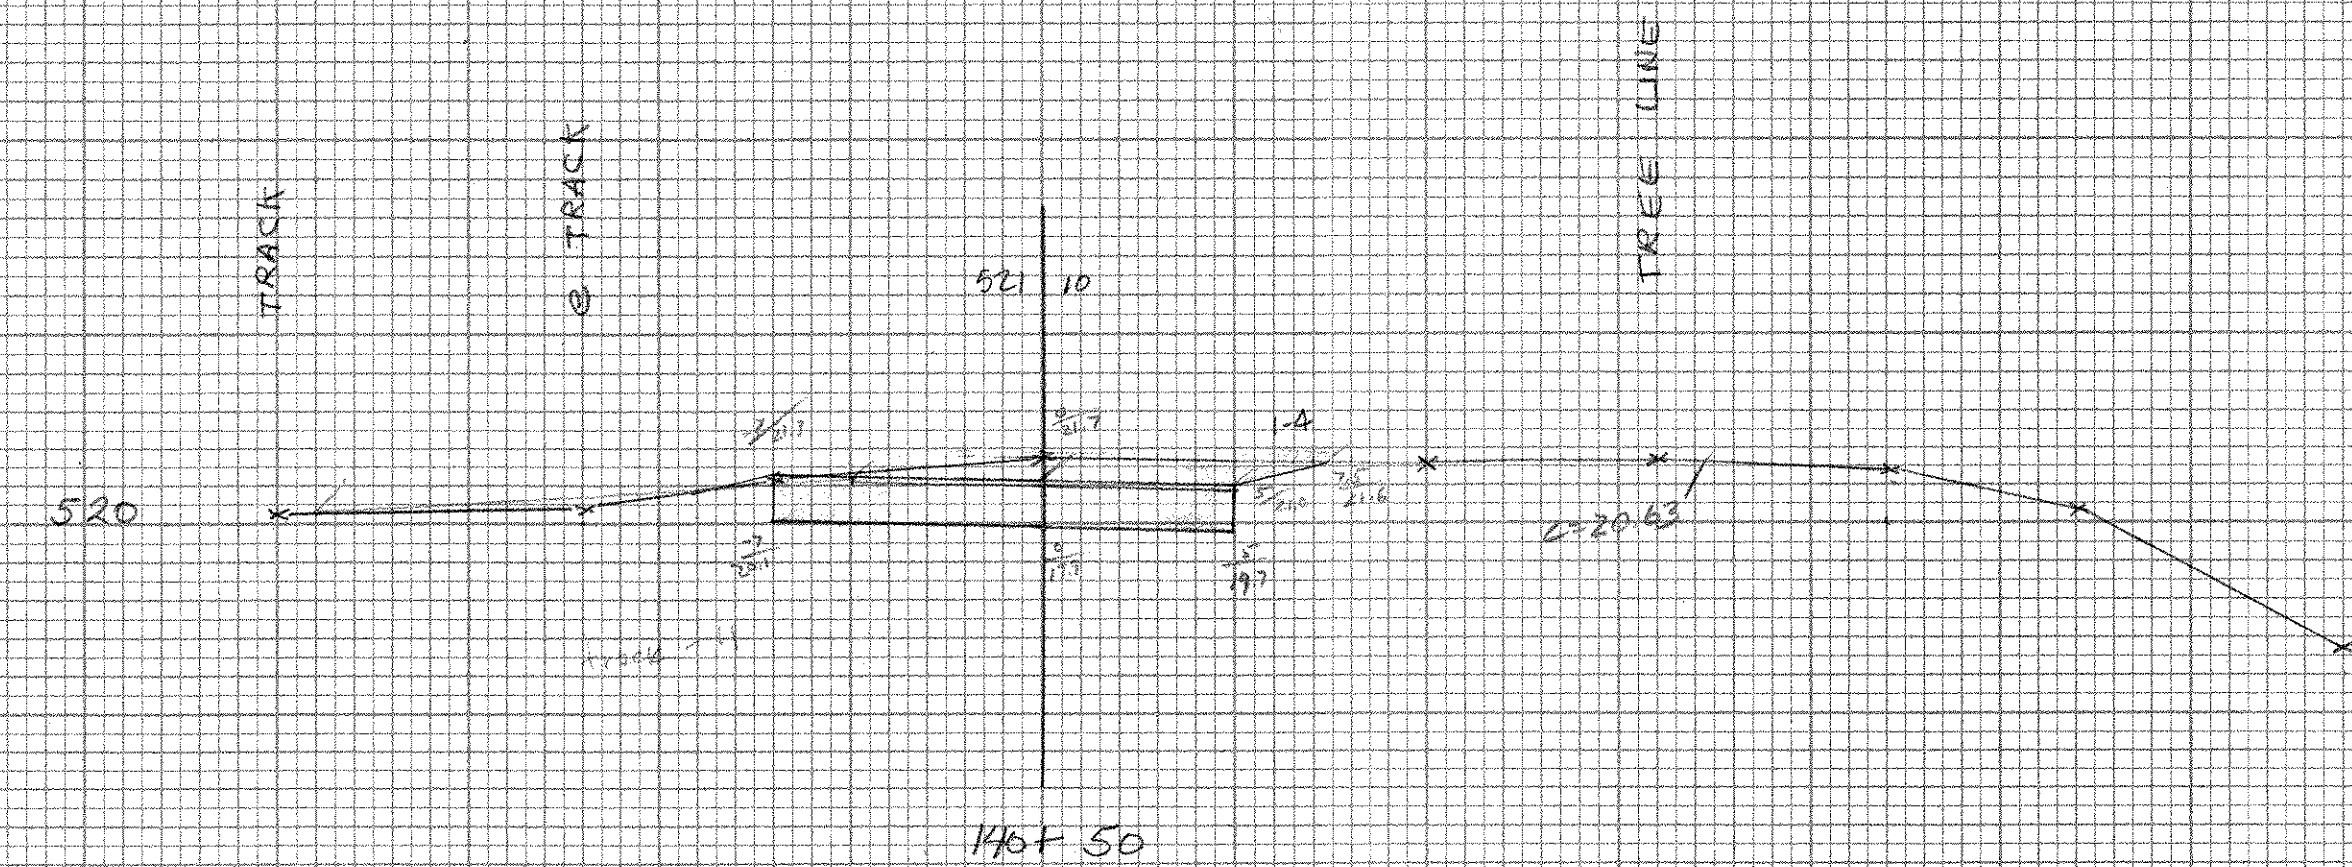
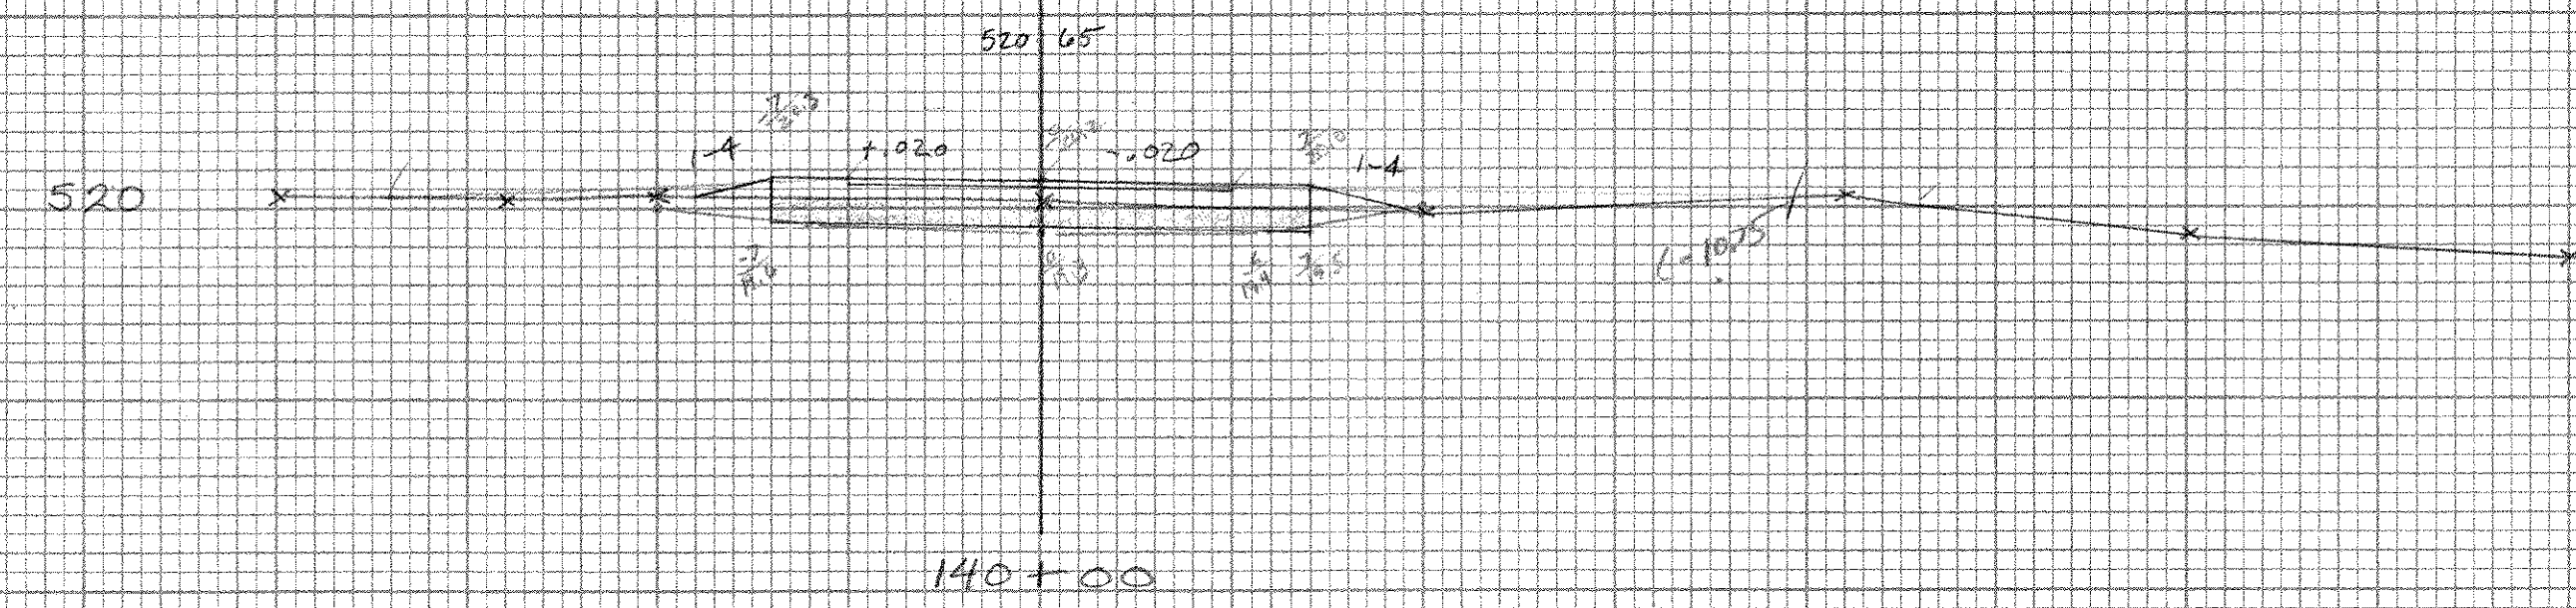
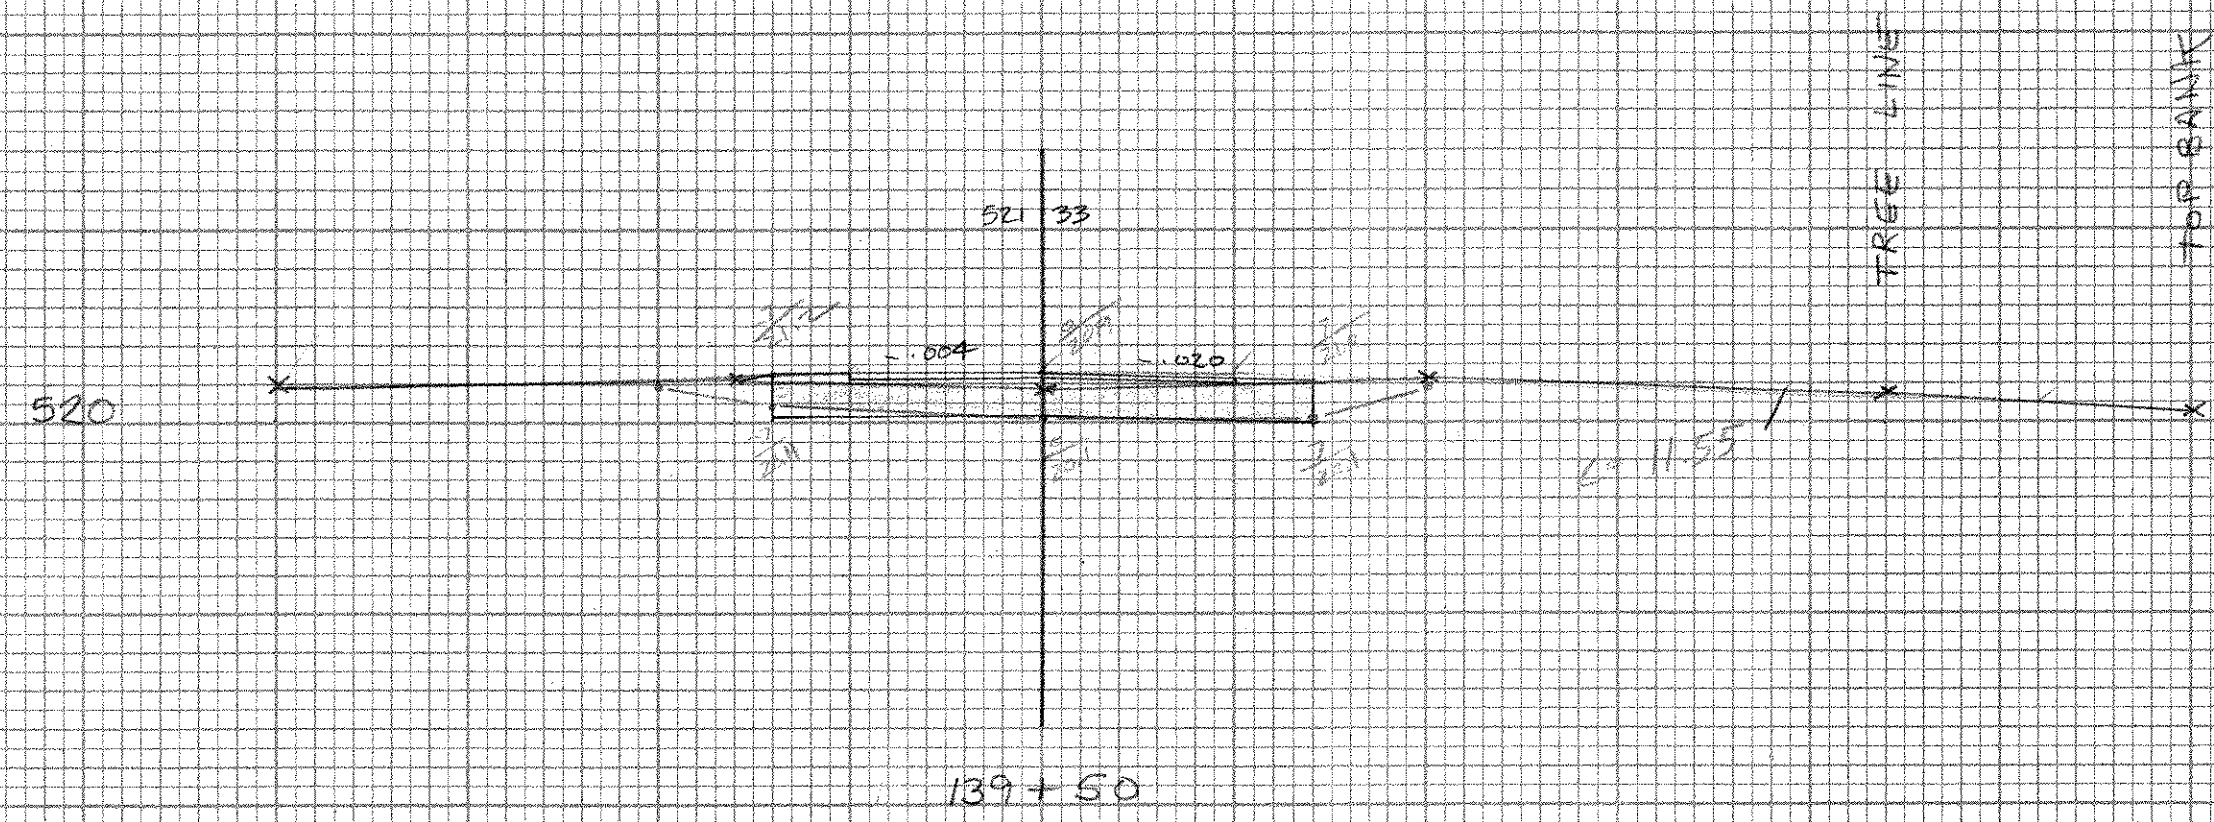
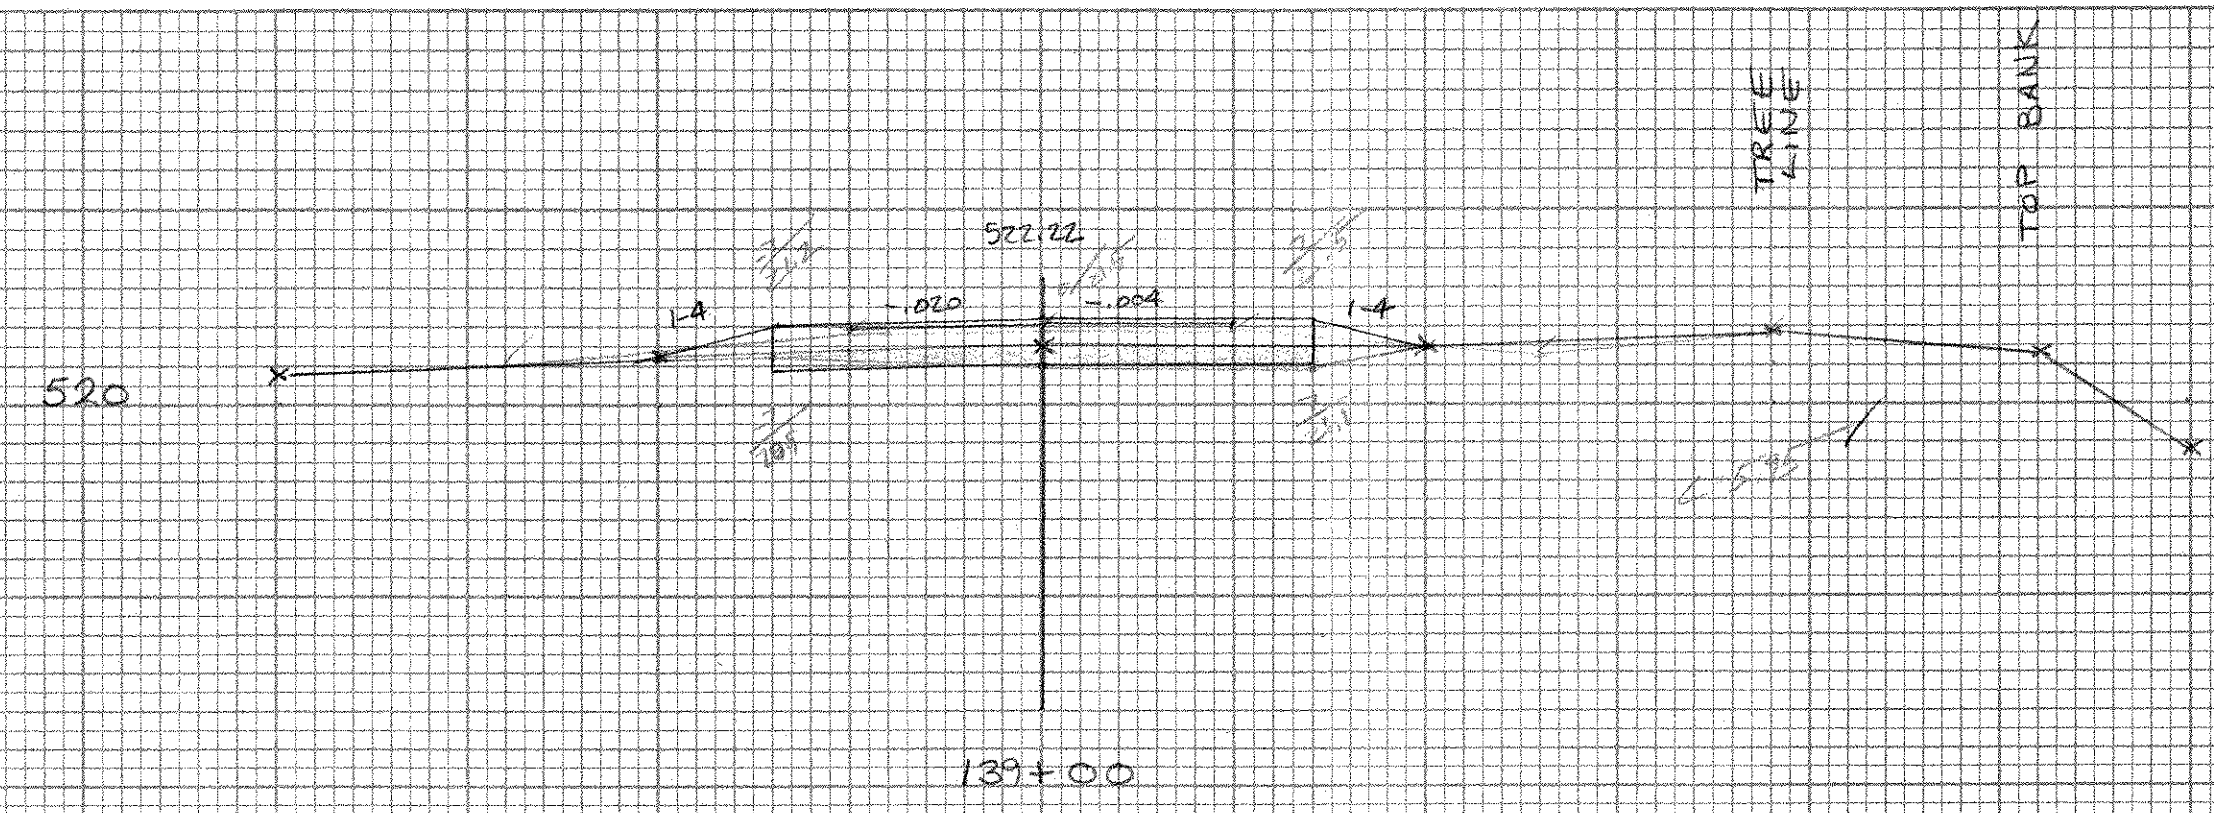
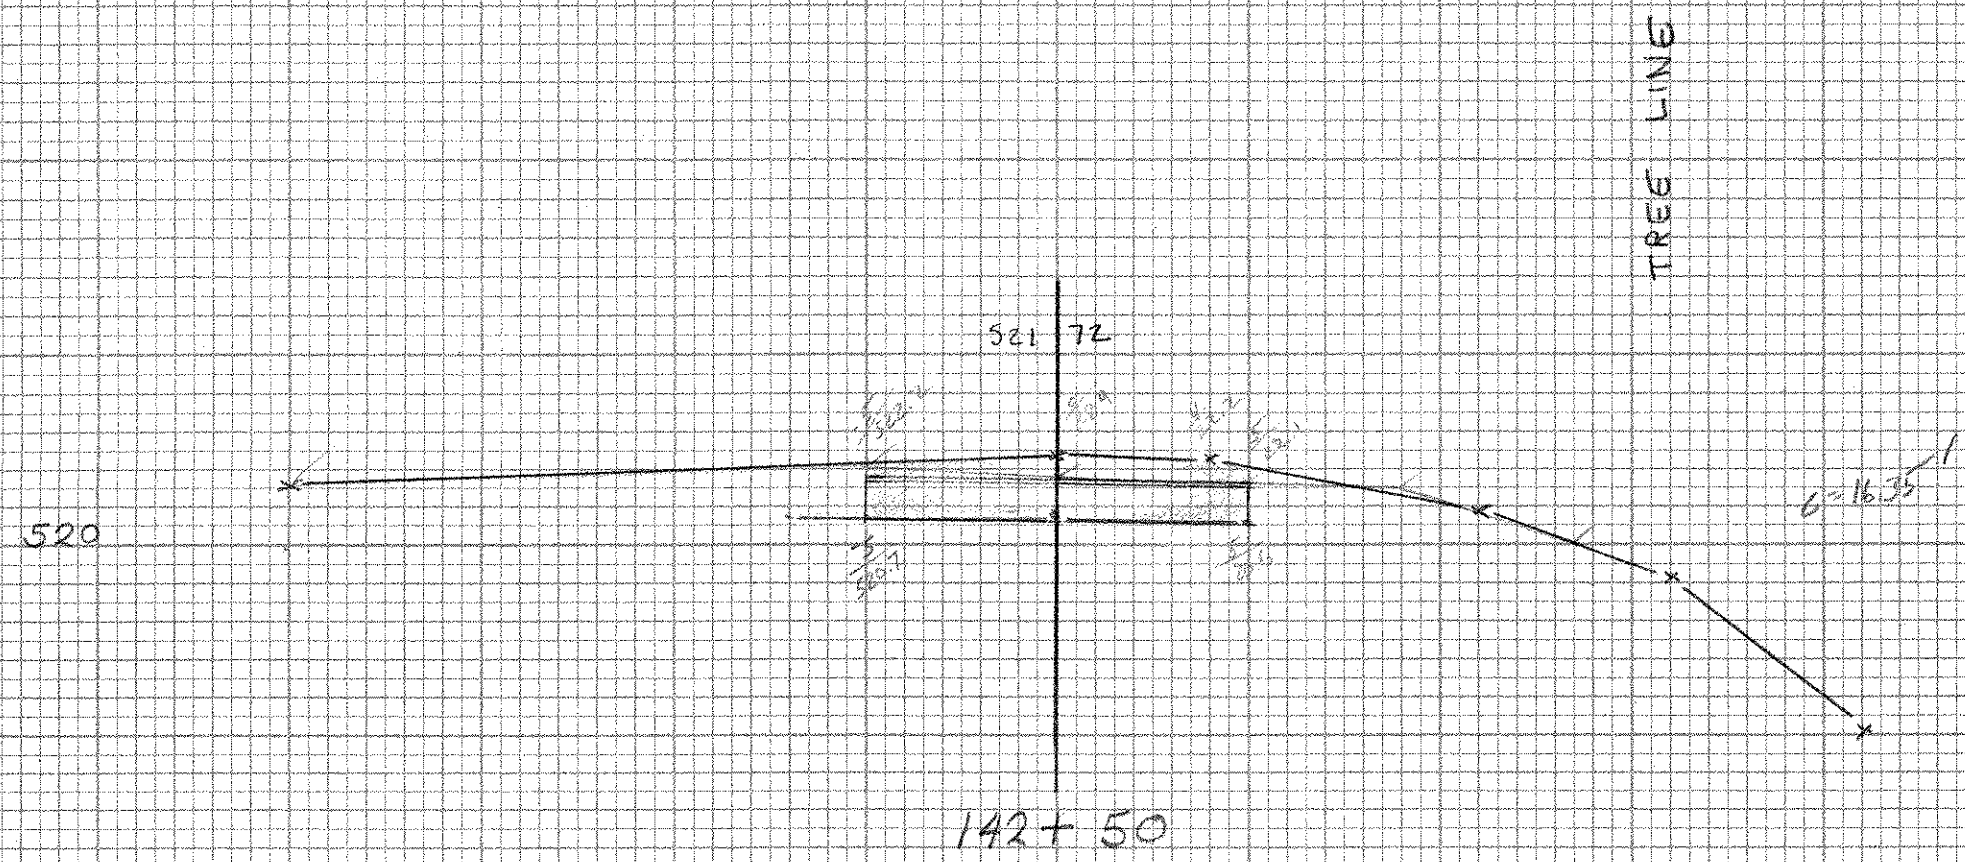
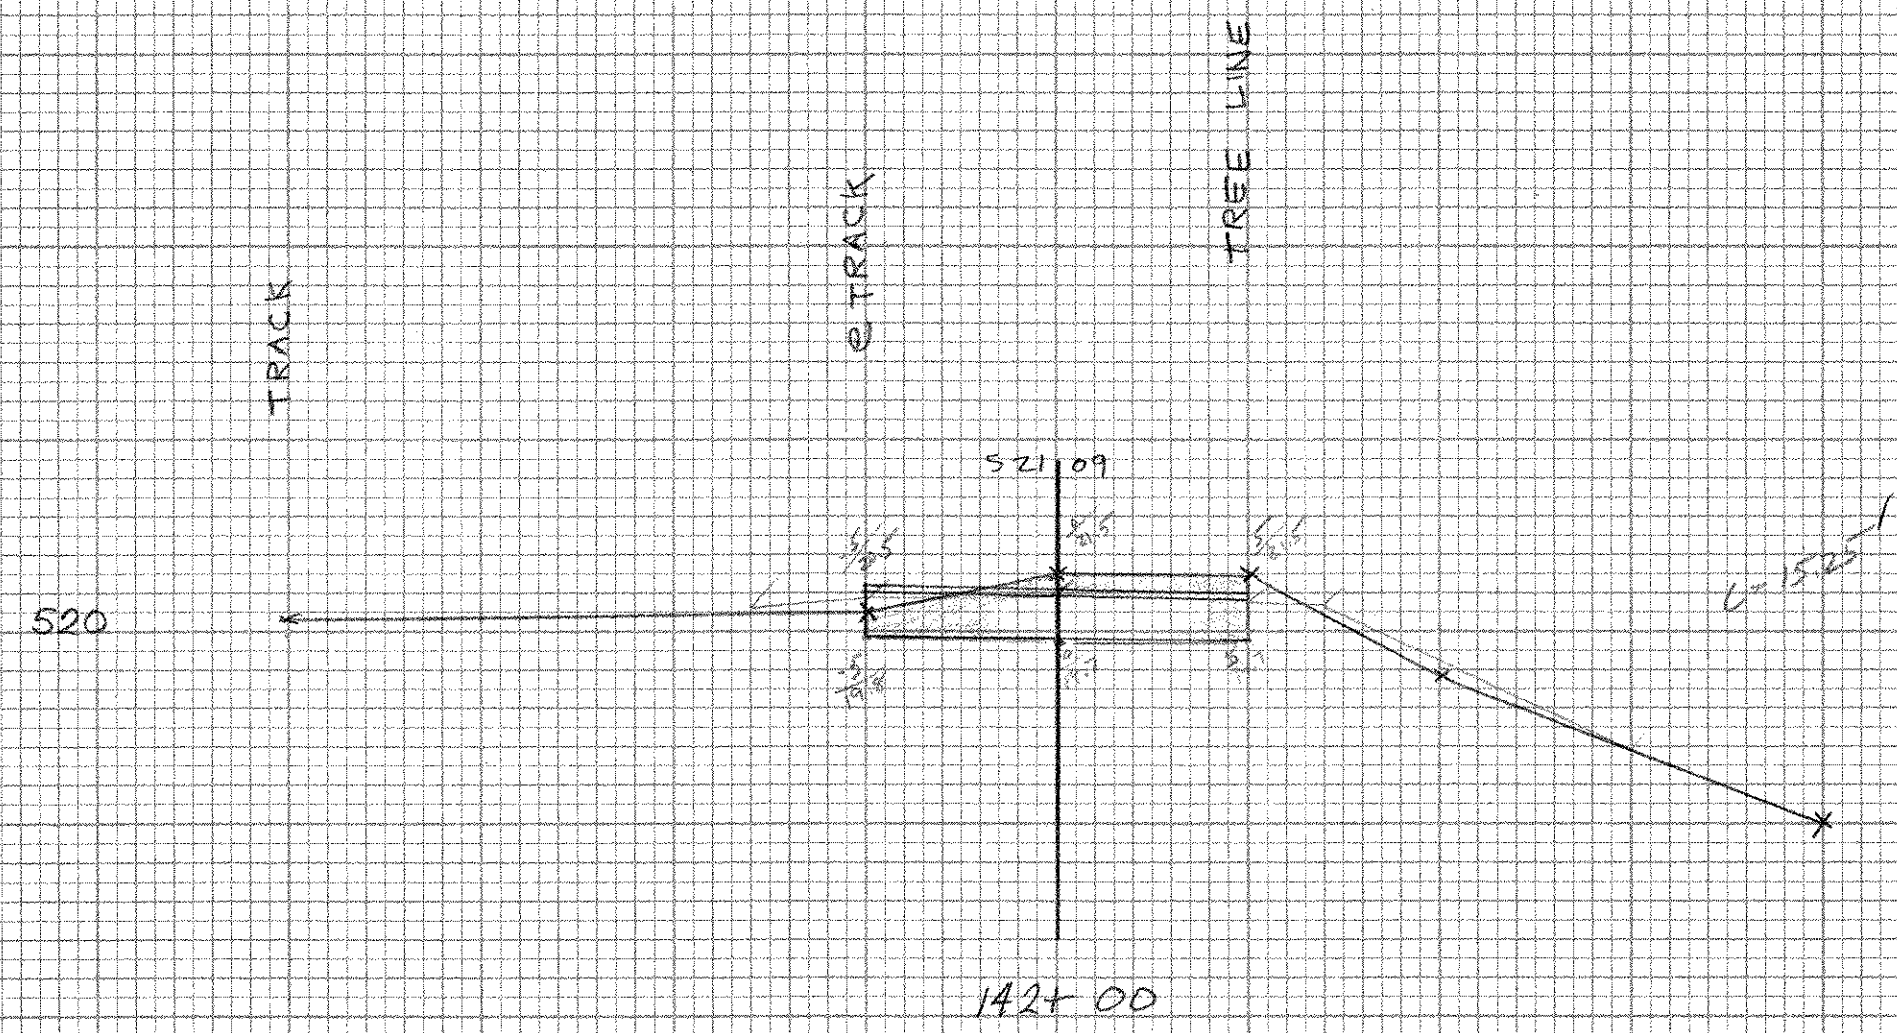


Montpelier
Burrill
Alameda
Tipton

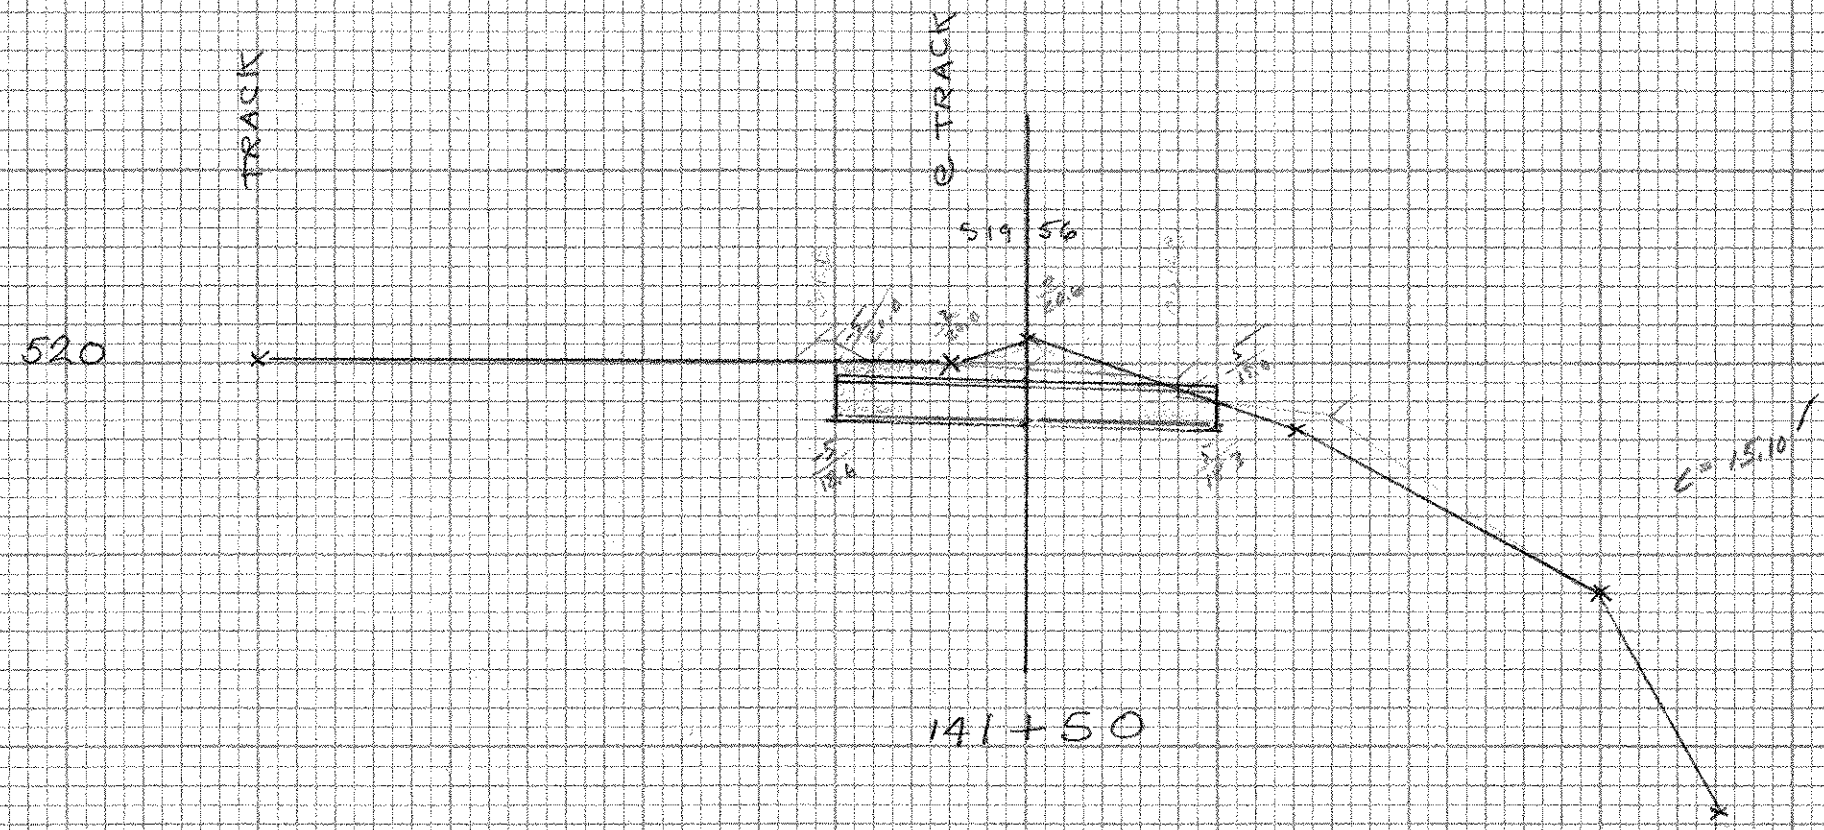

MONTPELIER BWM-BIKE (A) S
REV. X-SECTION S
142+50 ~ 139+00

SCALE 1 INCH = 5 FEET

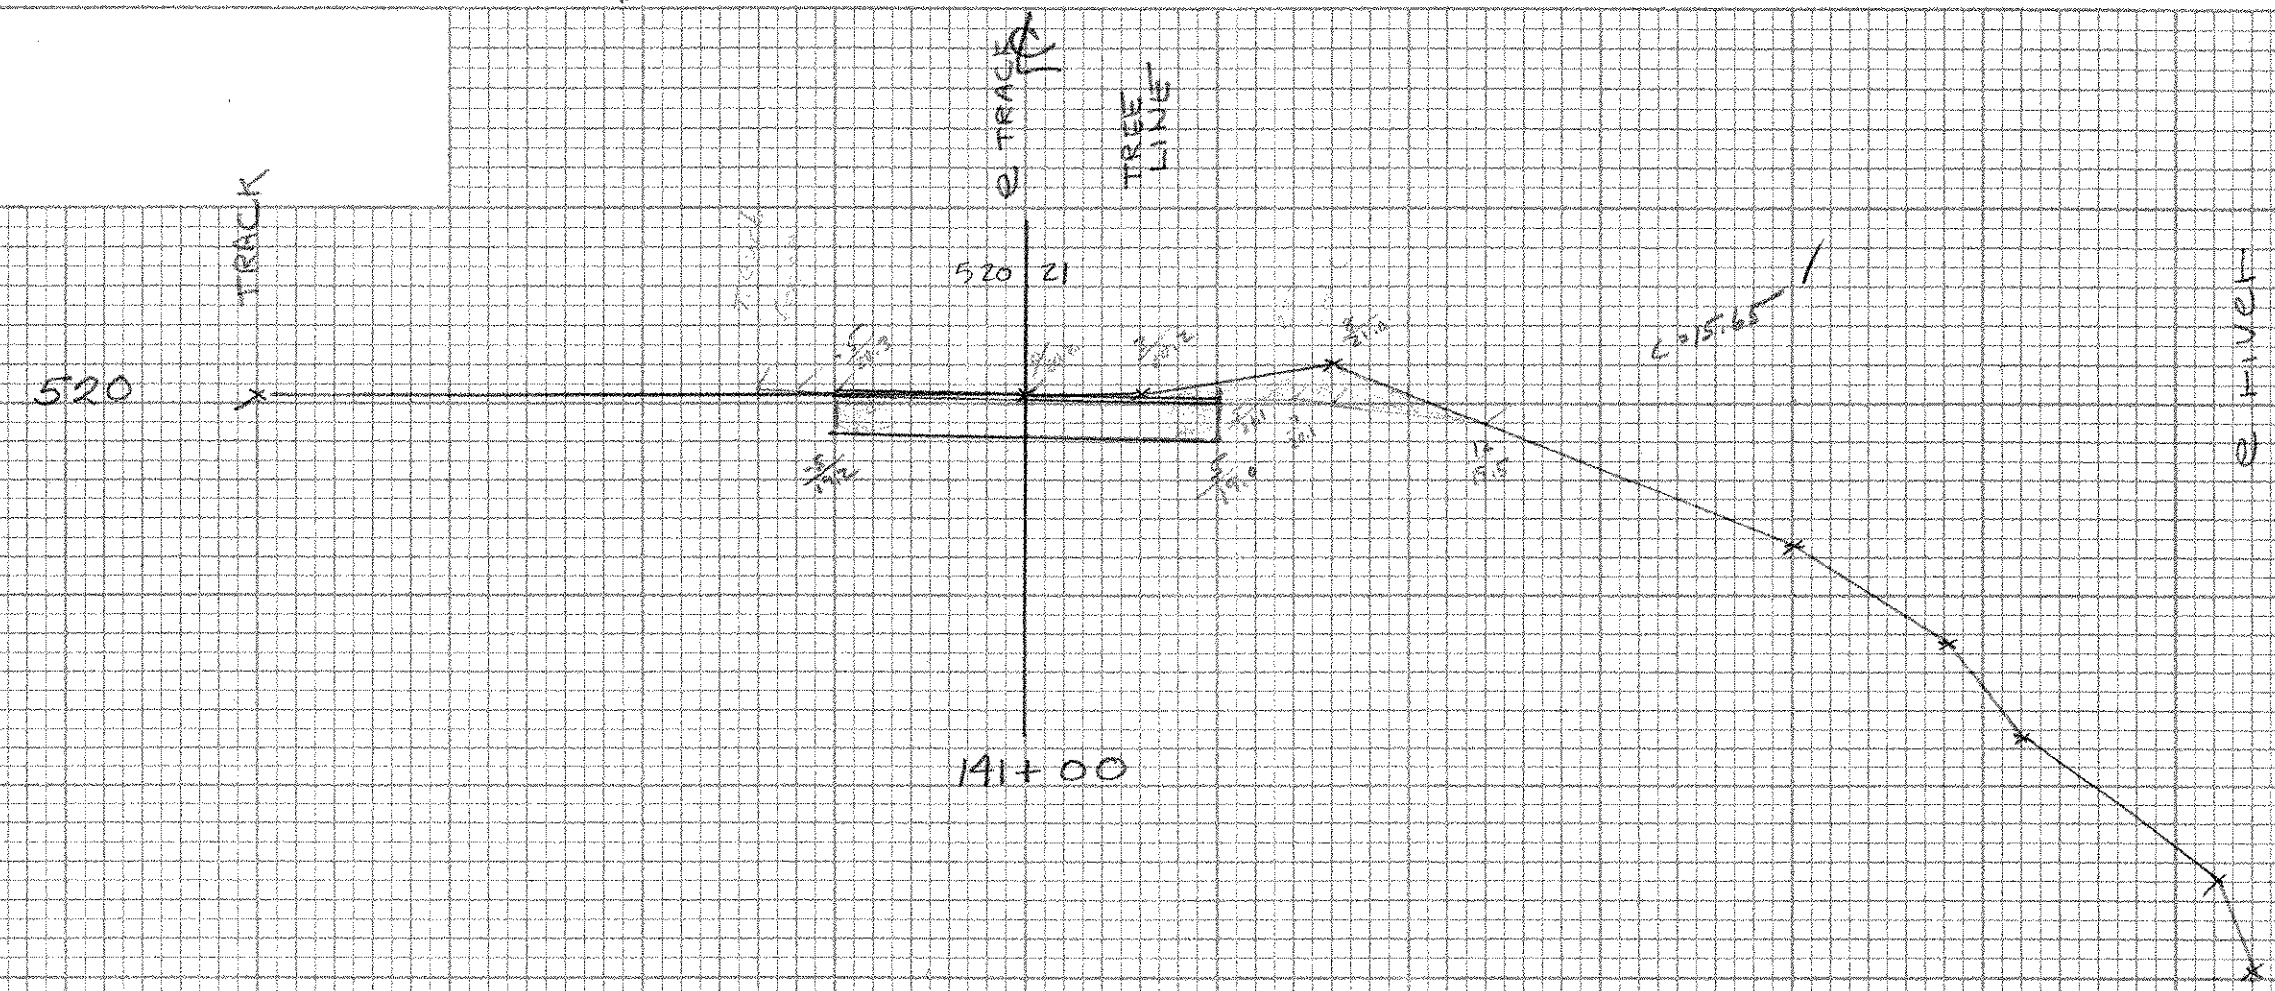

25 20 15 10 5 0 5 10 15 20 25

25 20 15 10 5 0 5 10 15 20 25

NO.	HECK CHECKED	DATE
1	HECK	
2	HECK	
3	HECK	
4	HECK	
5	HECK	
6	HECK	
7	HECK	
8	HECK	
9	HECK	
10	HECK	

NO.	HECK CHECKED	DATE
1	HECK	
2	HECK	
3	HECK	
4	HECK	
5	HECK	
6	HECK	
7	HECK	
8	HECK	
9	HECK	
10	HECK	