
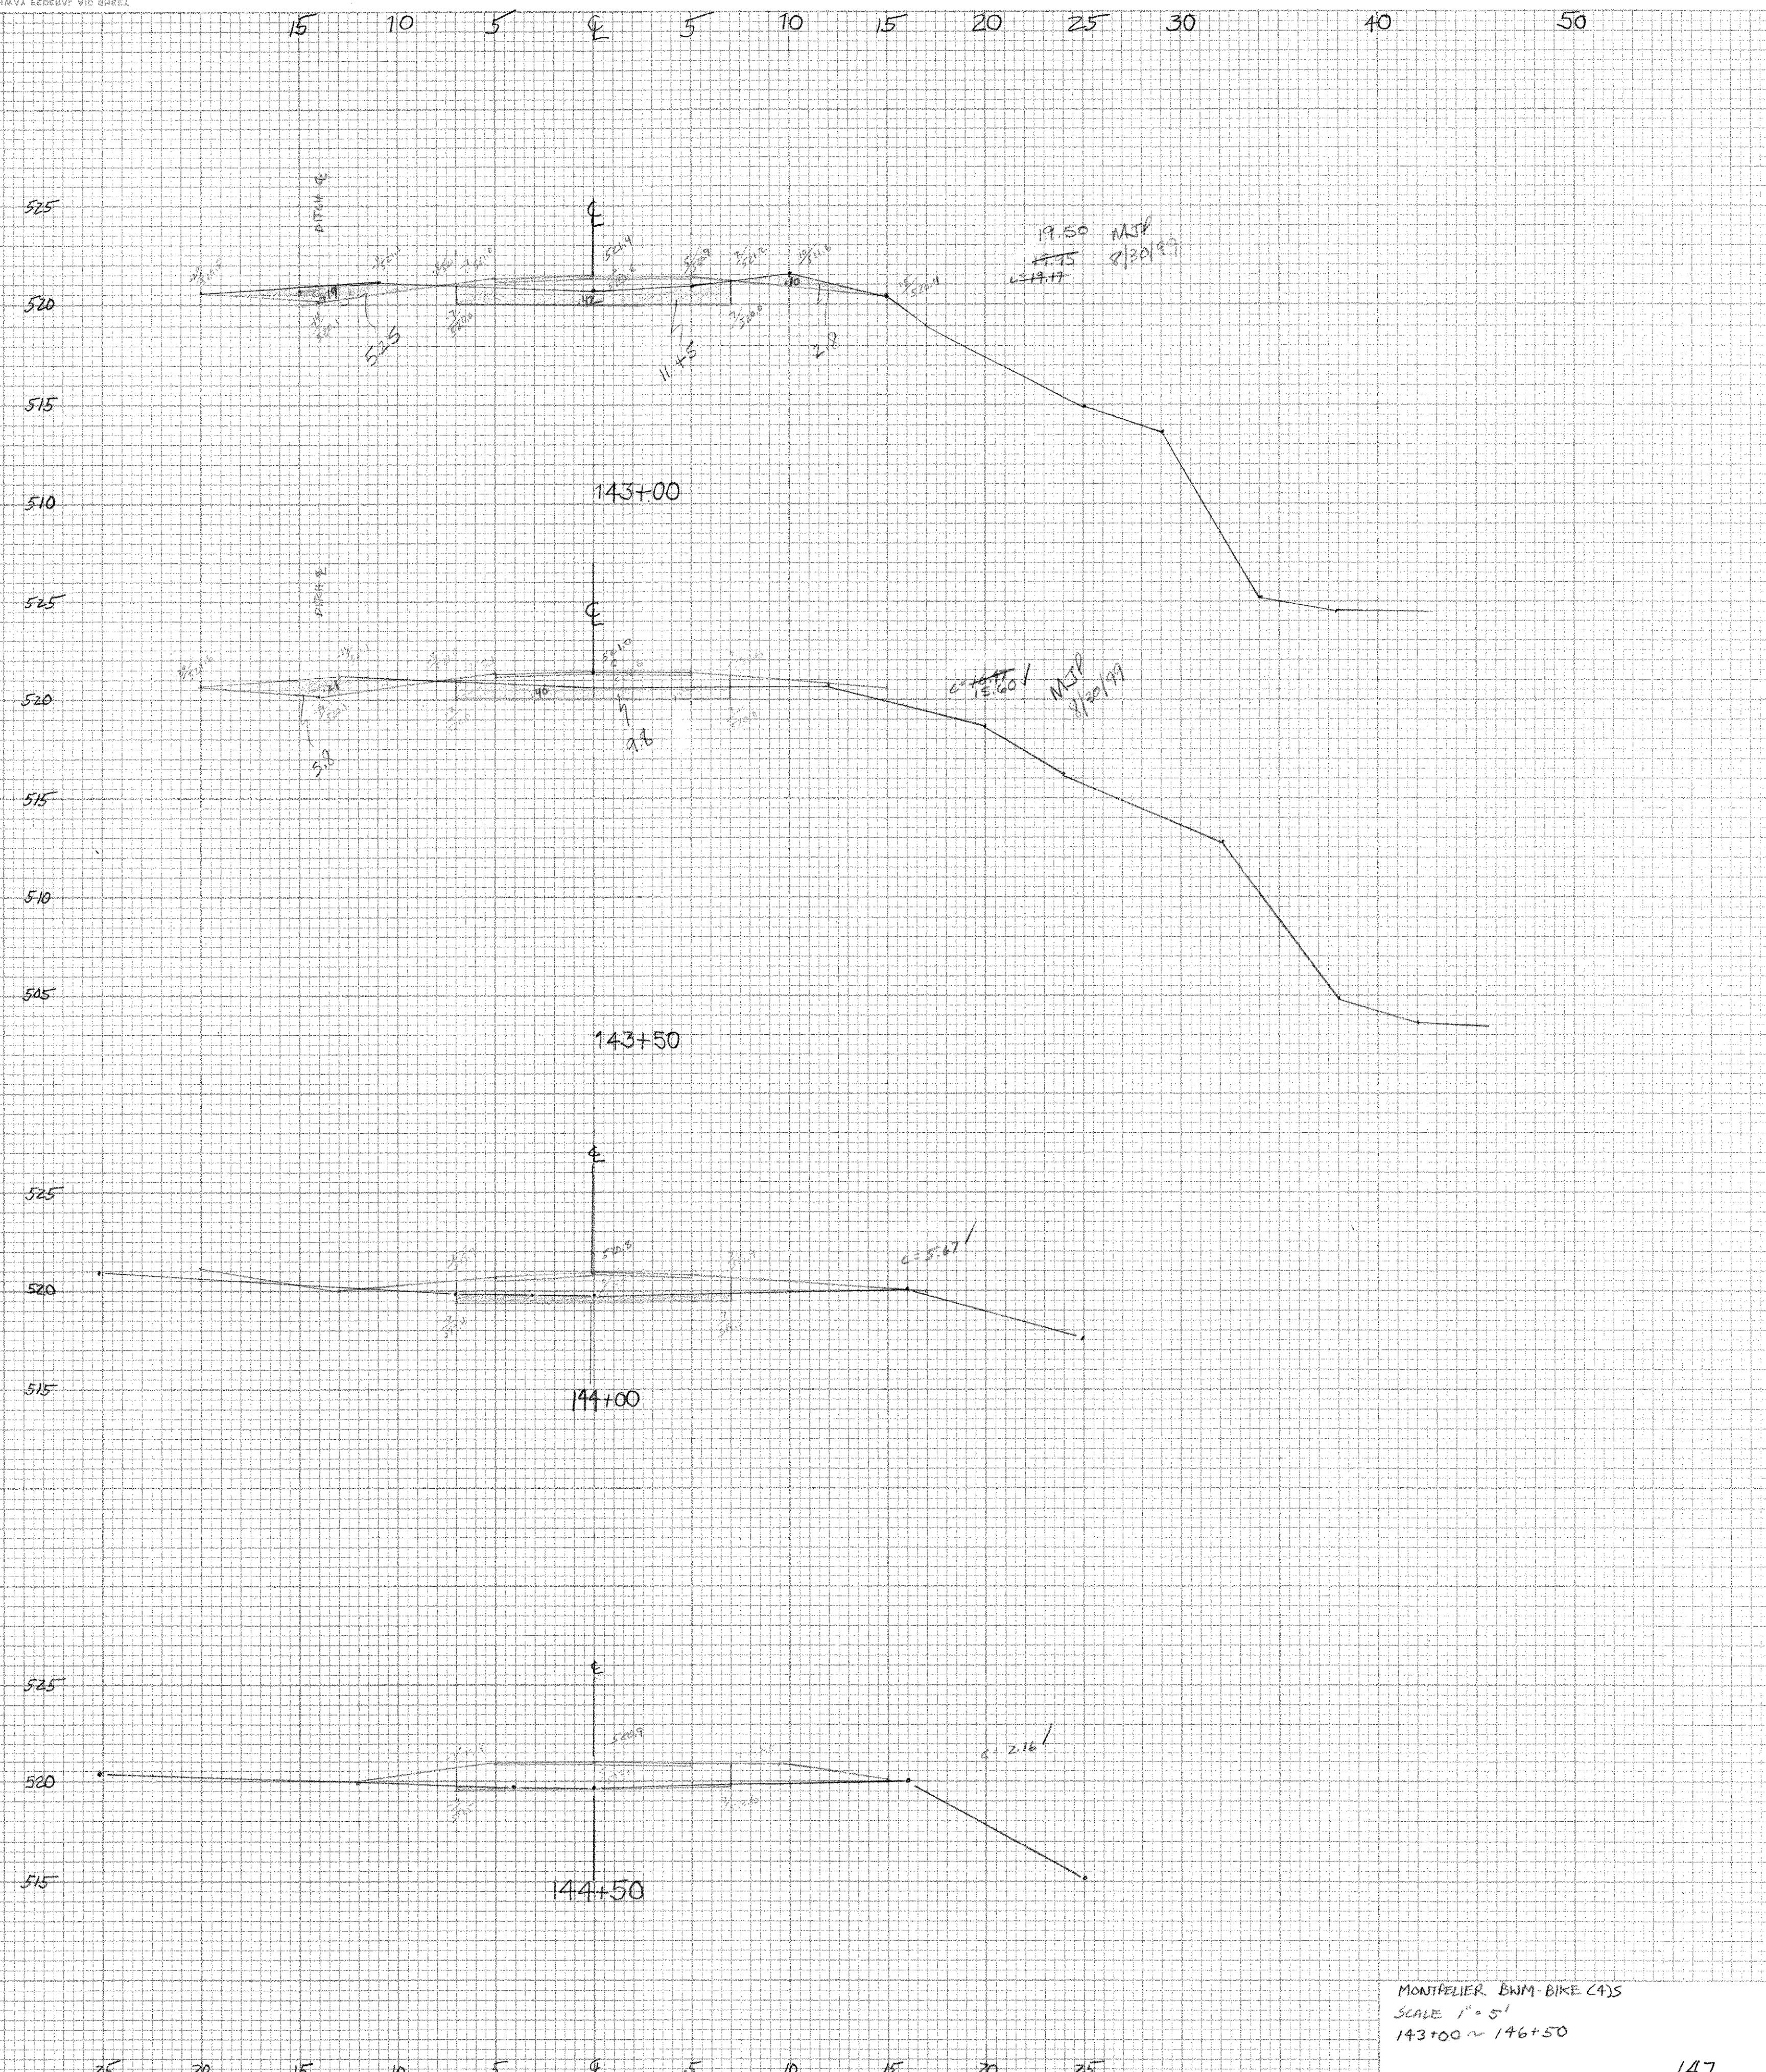


NO. 101
 DATE
 DRAWN BY
 CHECKED BY
 PROJECT NO.
 SHEET NO.

NO. 101
 DATE
 DRAWN BY
 CHECKED BY
 PROJECT NO.
 SHEET NO.

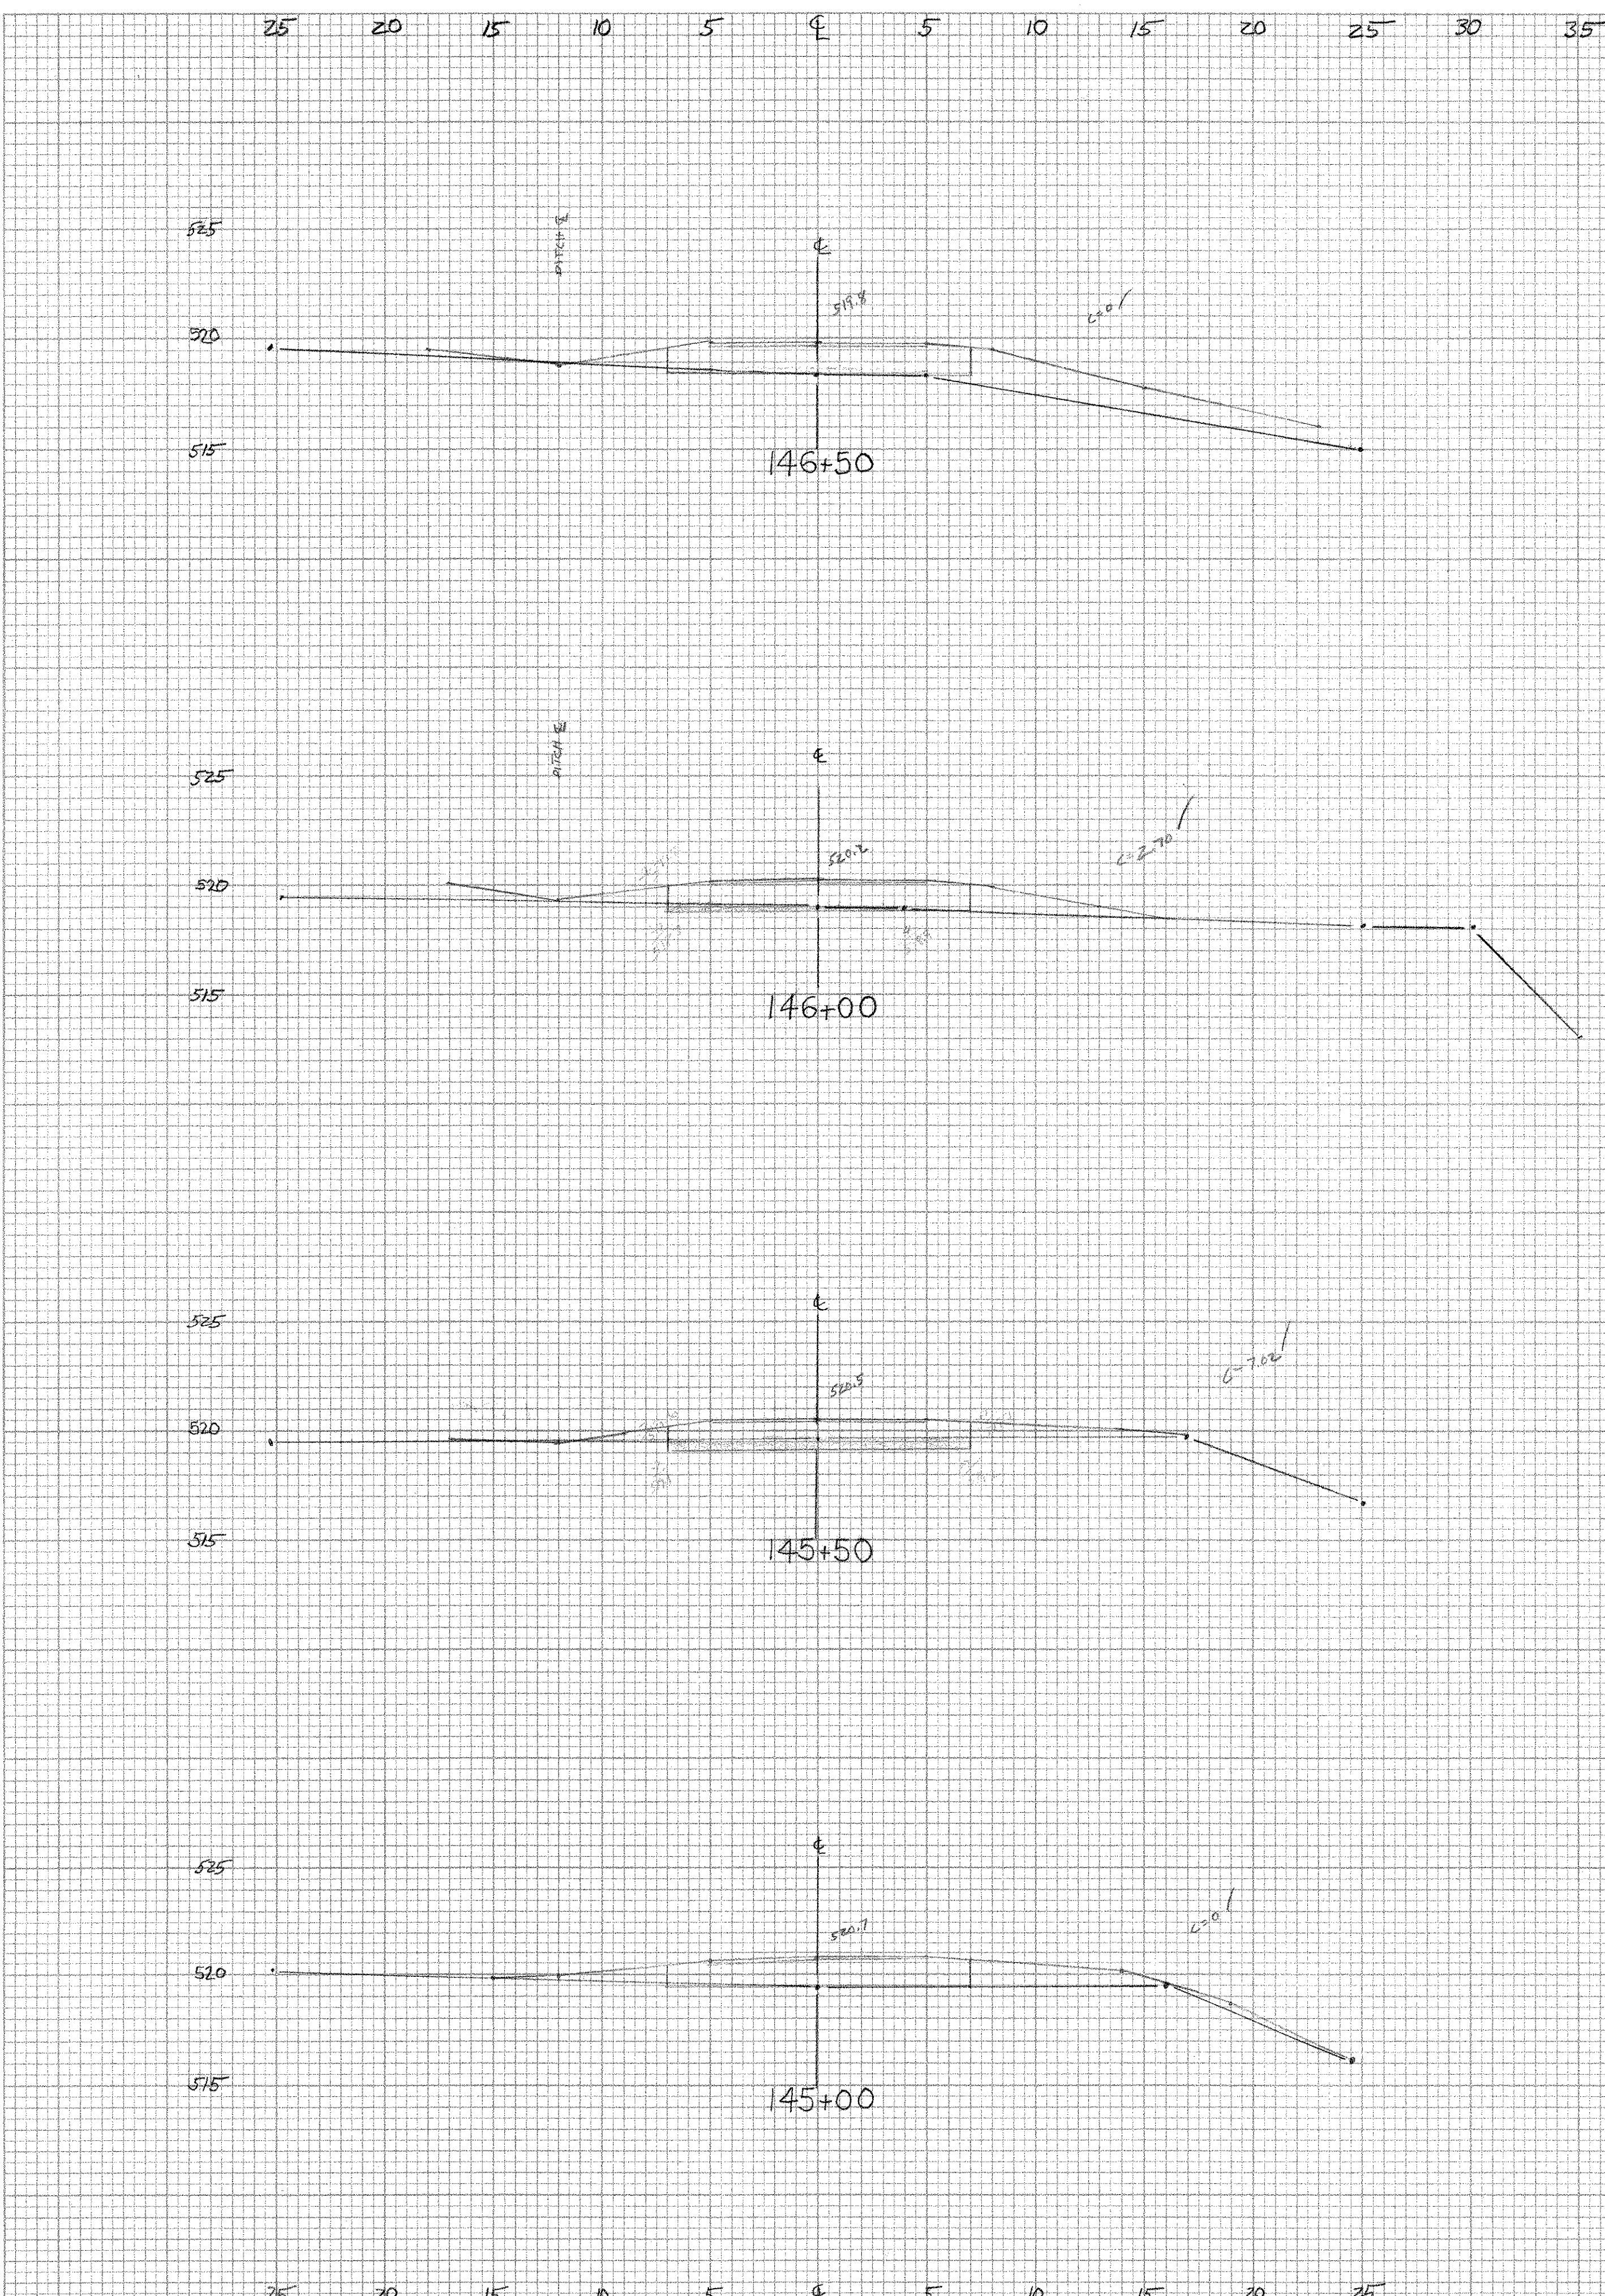

MONTPELIER BMW BIKE C95
 SCALE 1" = 5'
 143+00 ~ 146+50