



NOTE: BAR MARKS SHOWN ABOVE ARE FOR PIERS 1&2 WITH PIER 3 MARKS SHOWN IN PARENTHESIS.

PLAN NOTES:

1. WINGWALLS ARE SYMMETRICAL ABOUT THE CENTERLINE OF THE BRIDGE.

LEGEND

NF = NEAR FACE
FF = FAR FACE
O.C. = ON CENTER

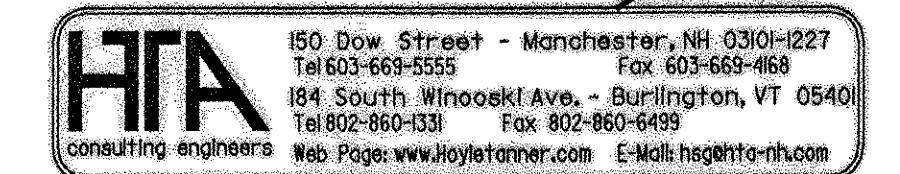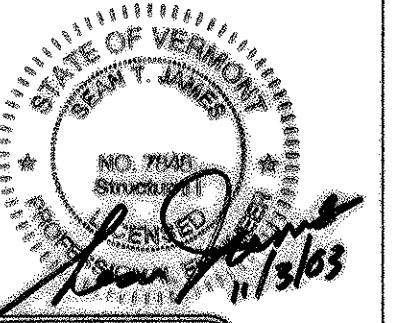

Town Of	BRIGHTON	Bridge No.	
Highway No.		Log Sta.	
		Surv. Sta.	
BRIGHTON PEDESTRIAN BRIDGE			
SUBSTRUCTURE DETAILS (2 OF 2)			
Designed By	S.T. JAMES	Drawn By	W. DRUDING
Checked By	R.H. DURFEE	Date	MAY. 2002
PROJECT	BRIGHTON	PROJECT NO.	STP BIKE (14)S
I.G.C. Info.	Z9068CF2.dgn		
Bridge Sheet No.	6	Sheet	6 of 14